


SECTION

TOWNSHIP 5 S , RANGE 3 W , W. M.

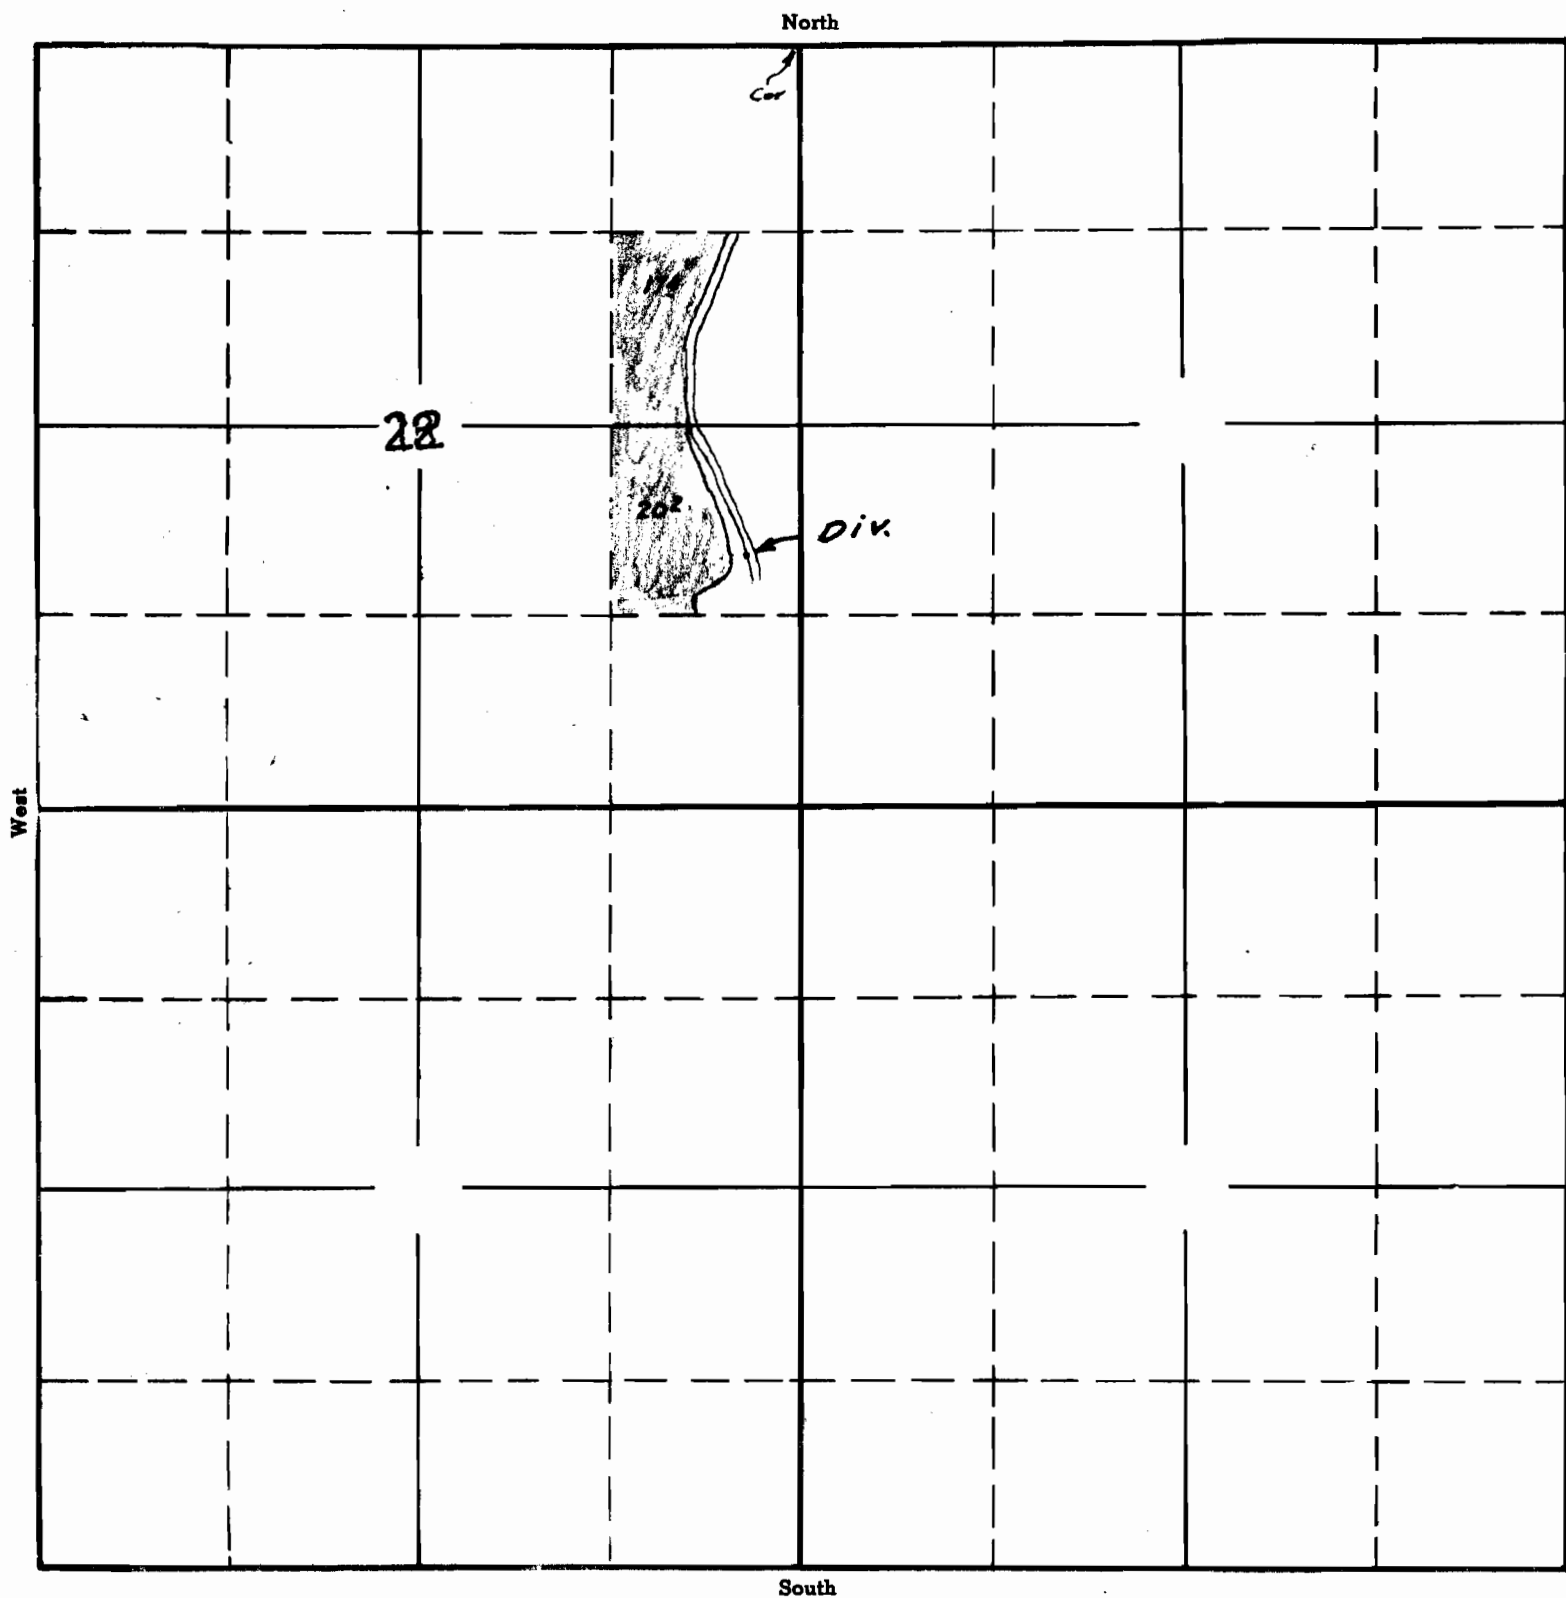

APPLICATION No. 16454
PERMIT No. 12251