
SECTION

.....

TOWNSHIP 35, RANGE 41, W. M.

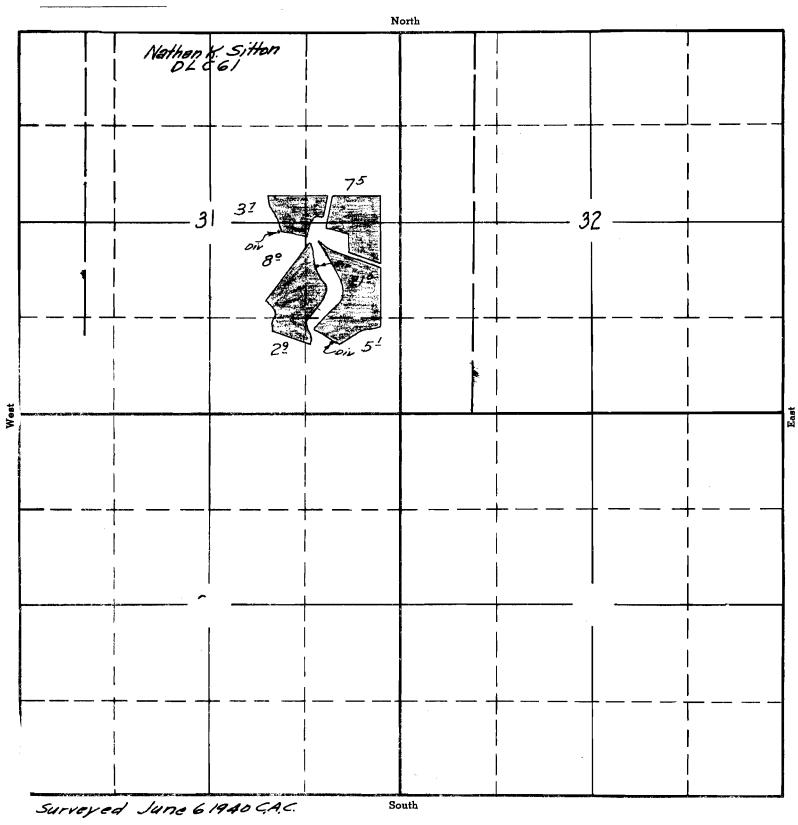

APPLICATION No. /66/3 PERMIT No. /2396

1