


TOWNSHIP 35, RANGE 9E, W. M.

North

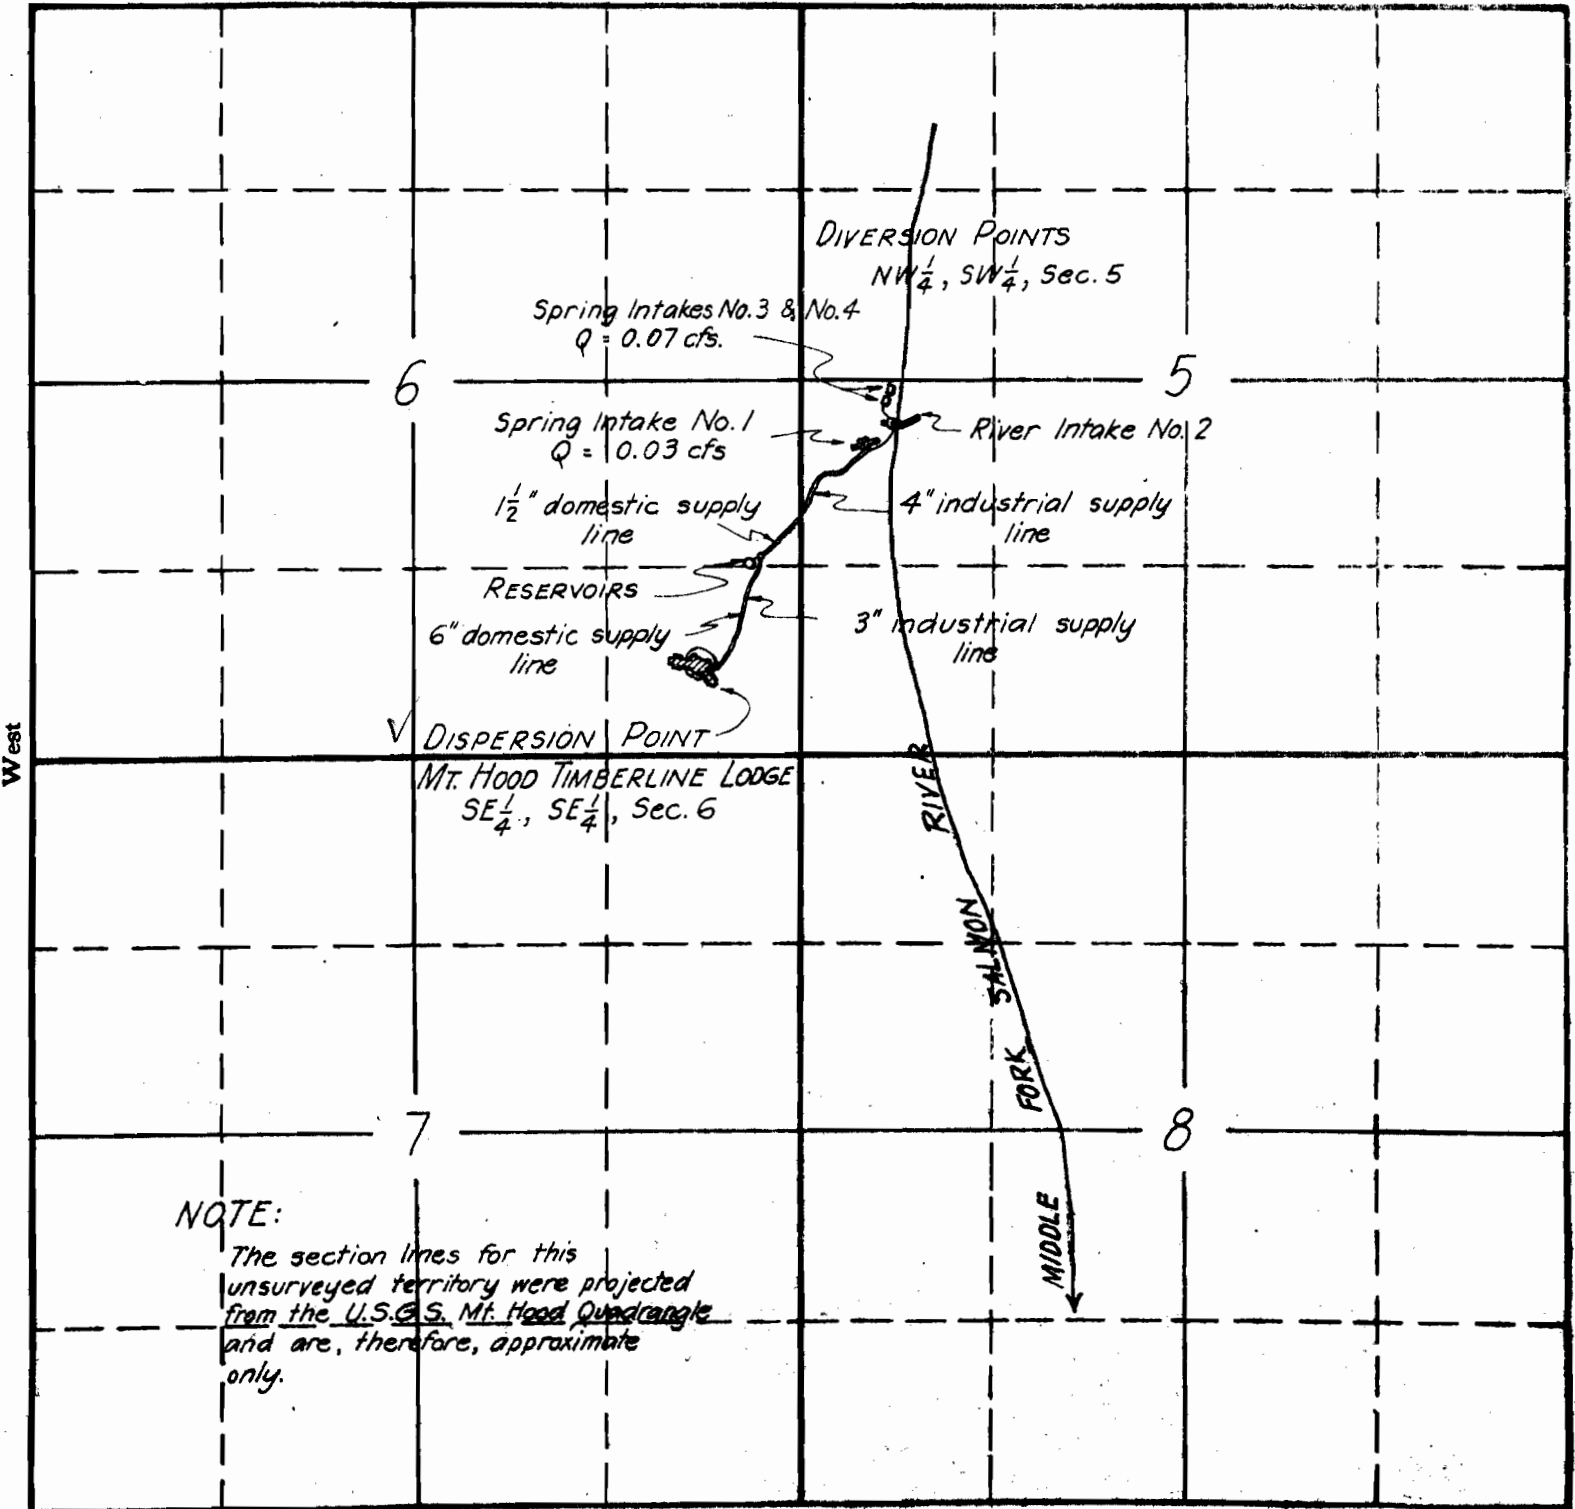

NOTE:

The section lines for this unsurveyed territory were projected from the U.S.G.S. Mt. Hood Quadrangle and are, therefore, approximate only.


South

3-14 ok
APPLICATION No. 16355
PERMIT No. 12461

SECTION

TOWNSHIP 35, RANGE 9E, W. M.

North

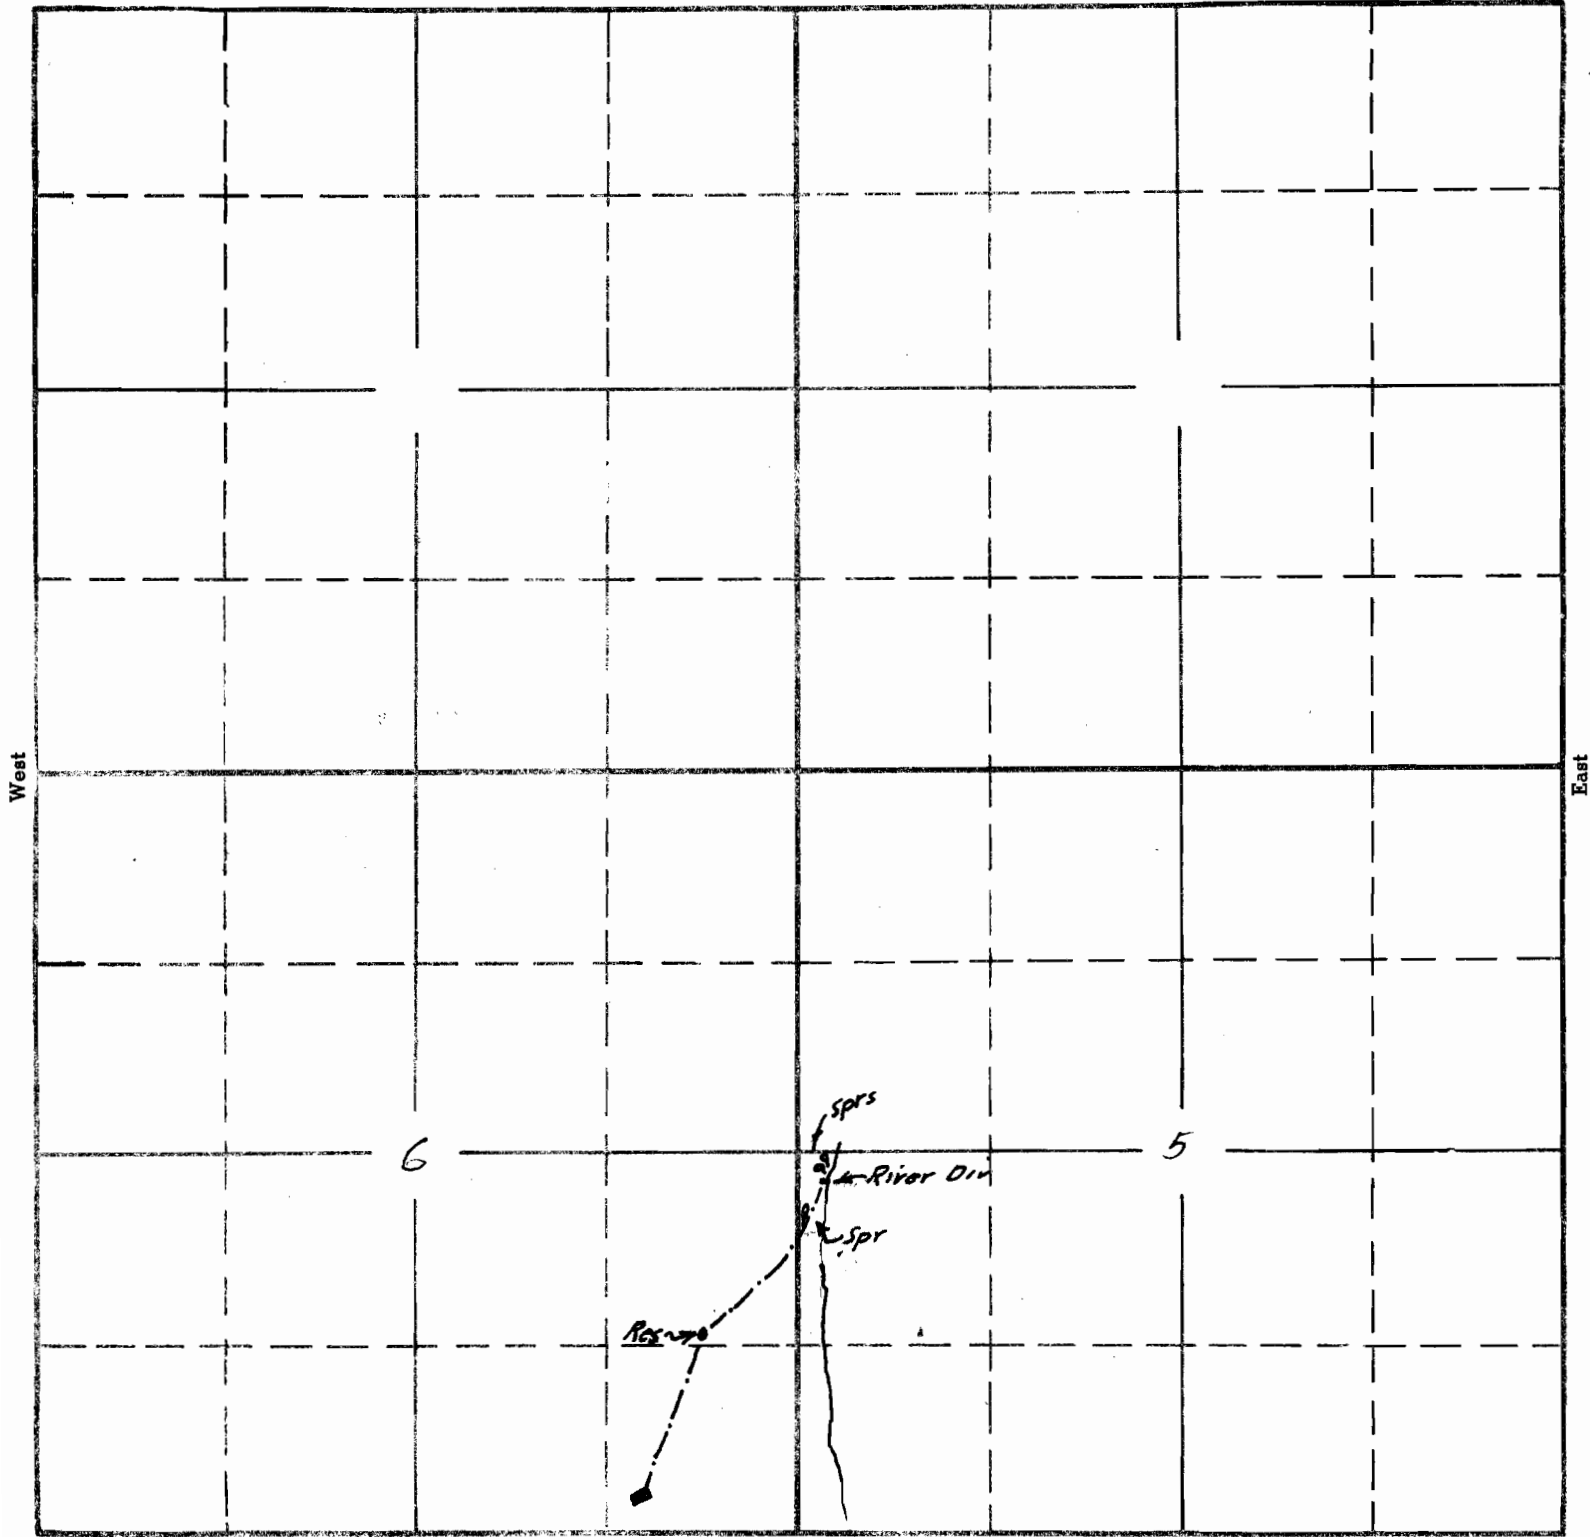

West

East

6

5

Sprs

River Div

Spr

Reservoir

South

Surveyed Sept 9 1940

APPLICATION No. 16355

PERMIT No. 12461