



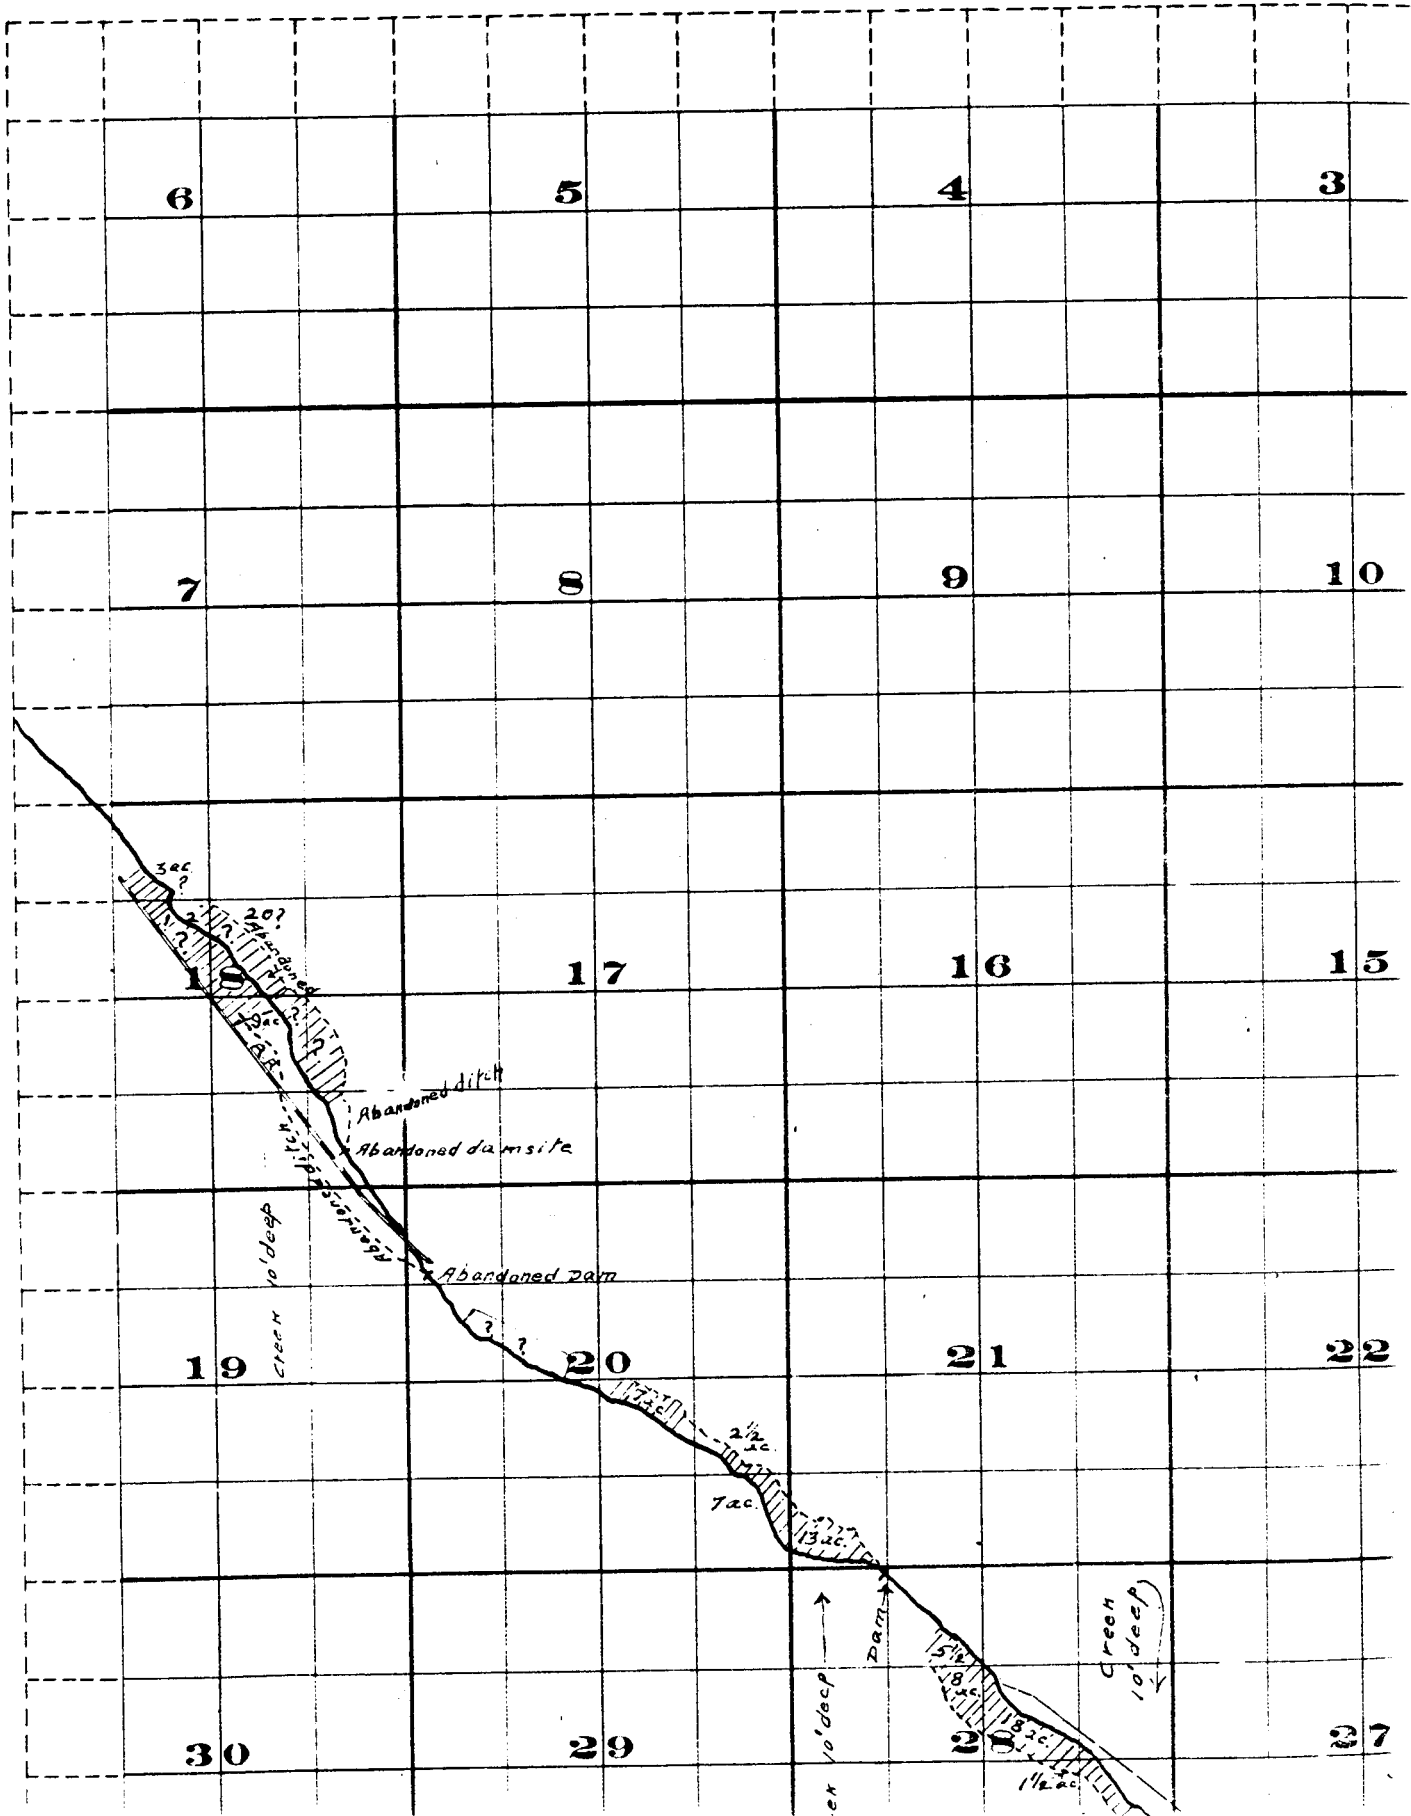


Township 15. , R:

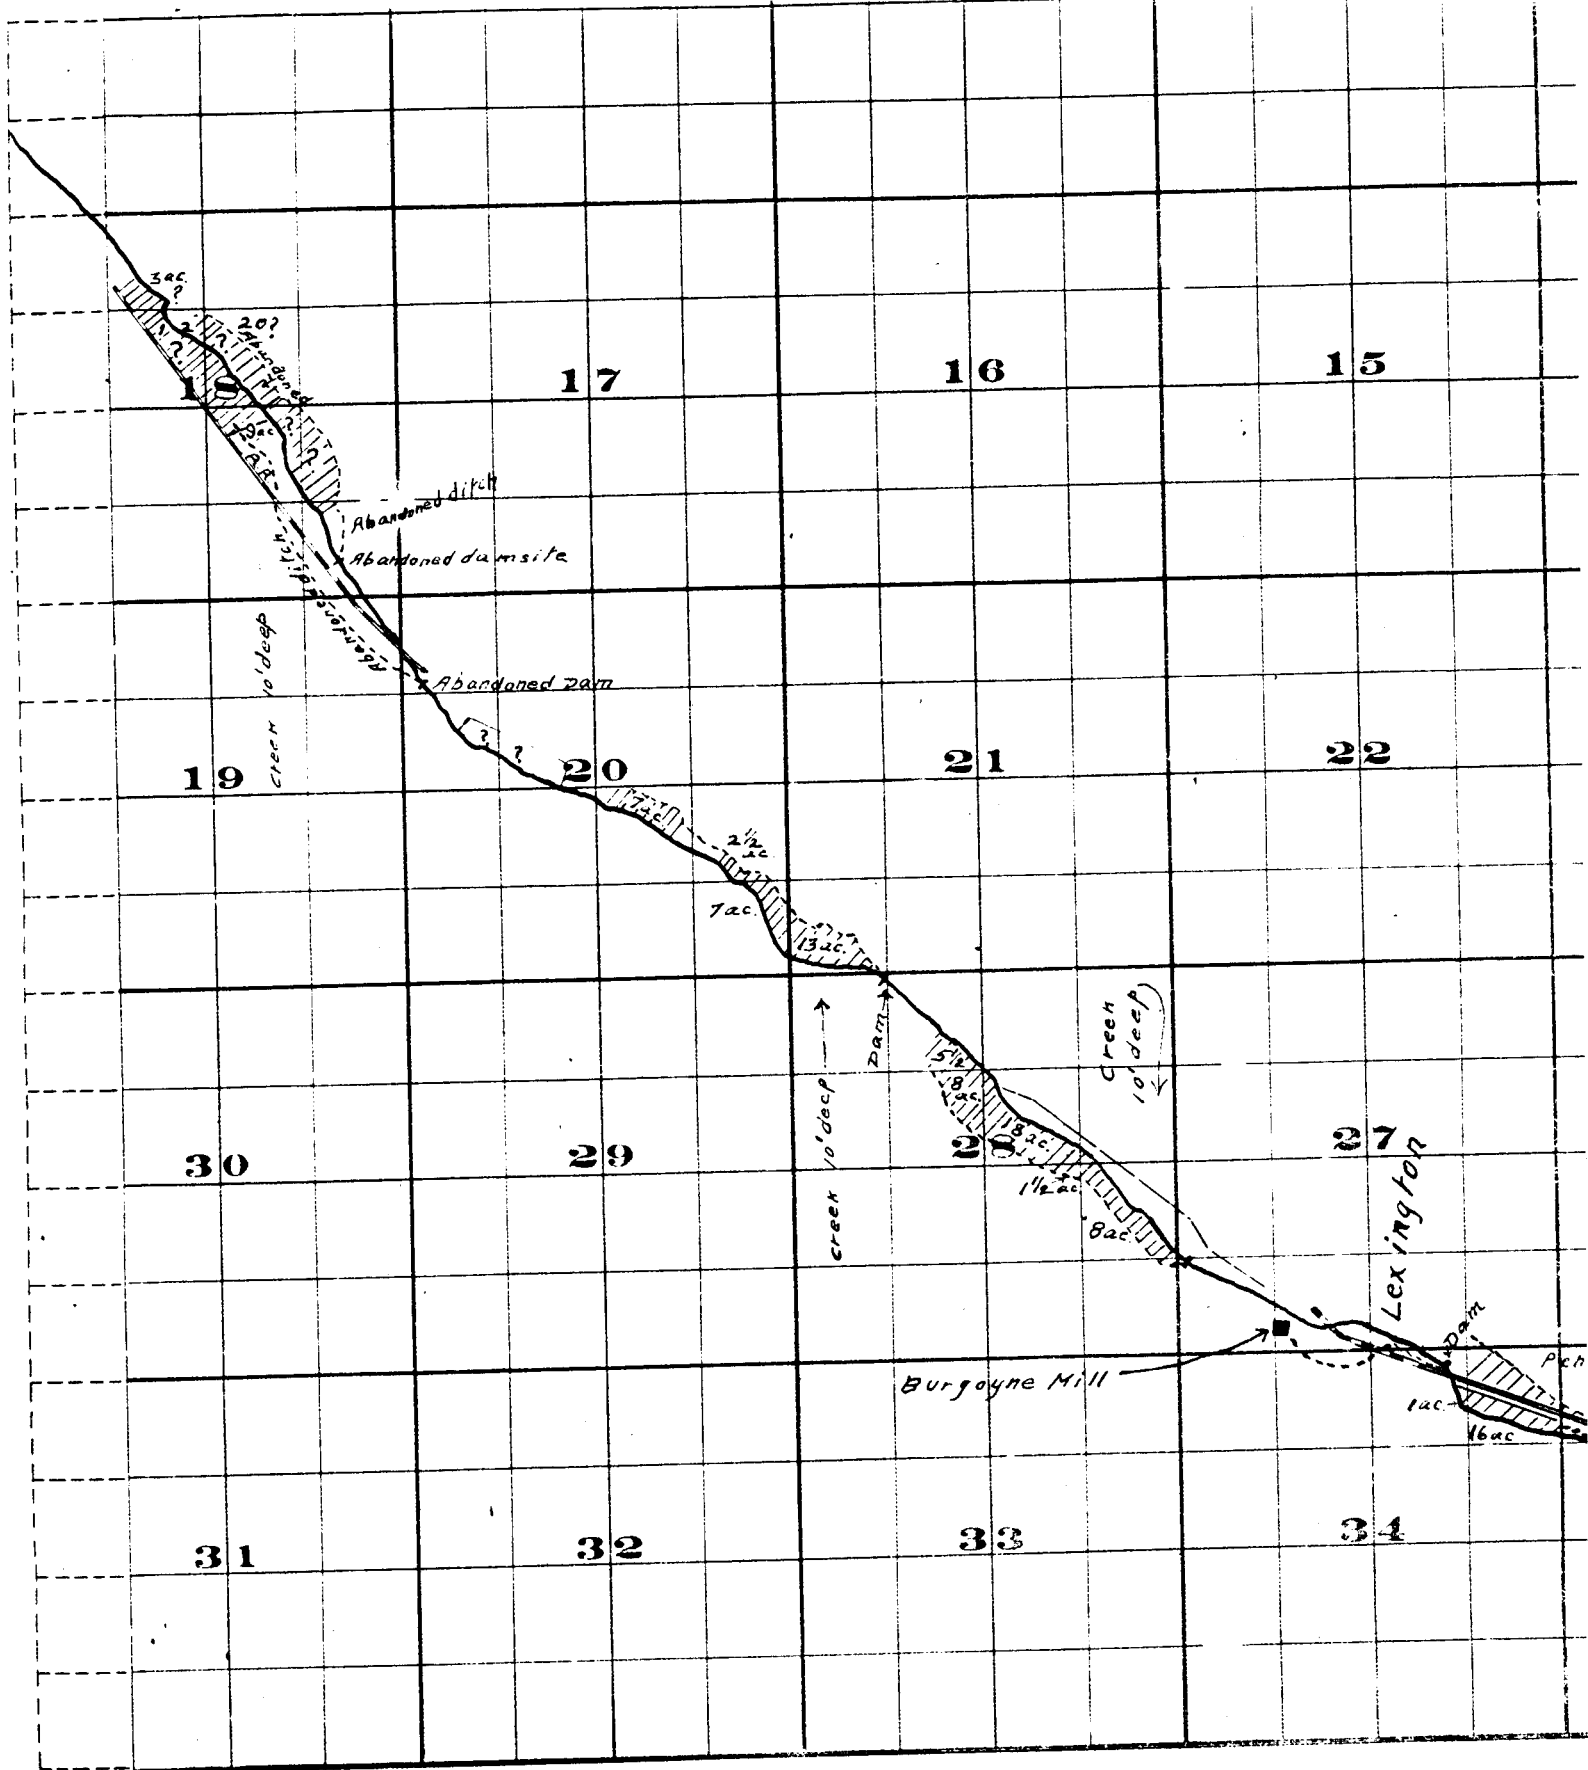



THE W. H. HUSTON CO. PRINTERS & BOUNDERS 111 N. 3rd St. W.

Surveyed by R.D. Gooper - July 1909  
 John H. Lewis - State Engineer  
 Examined July 14, 1909.

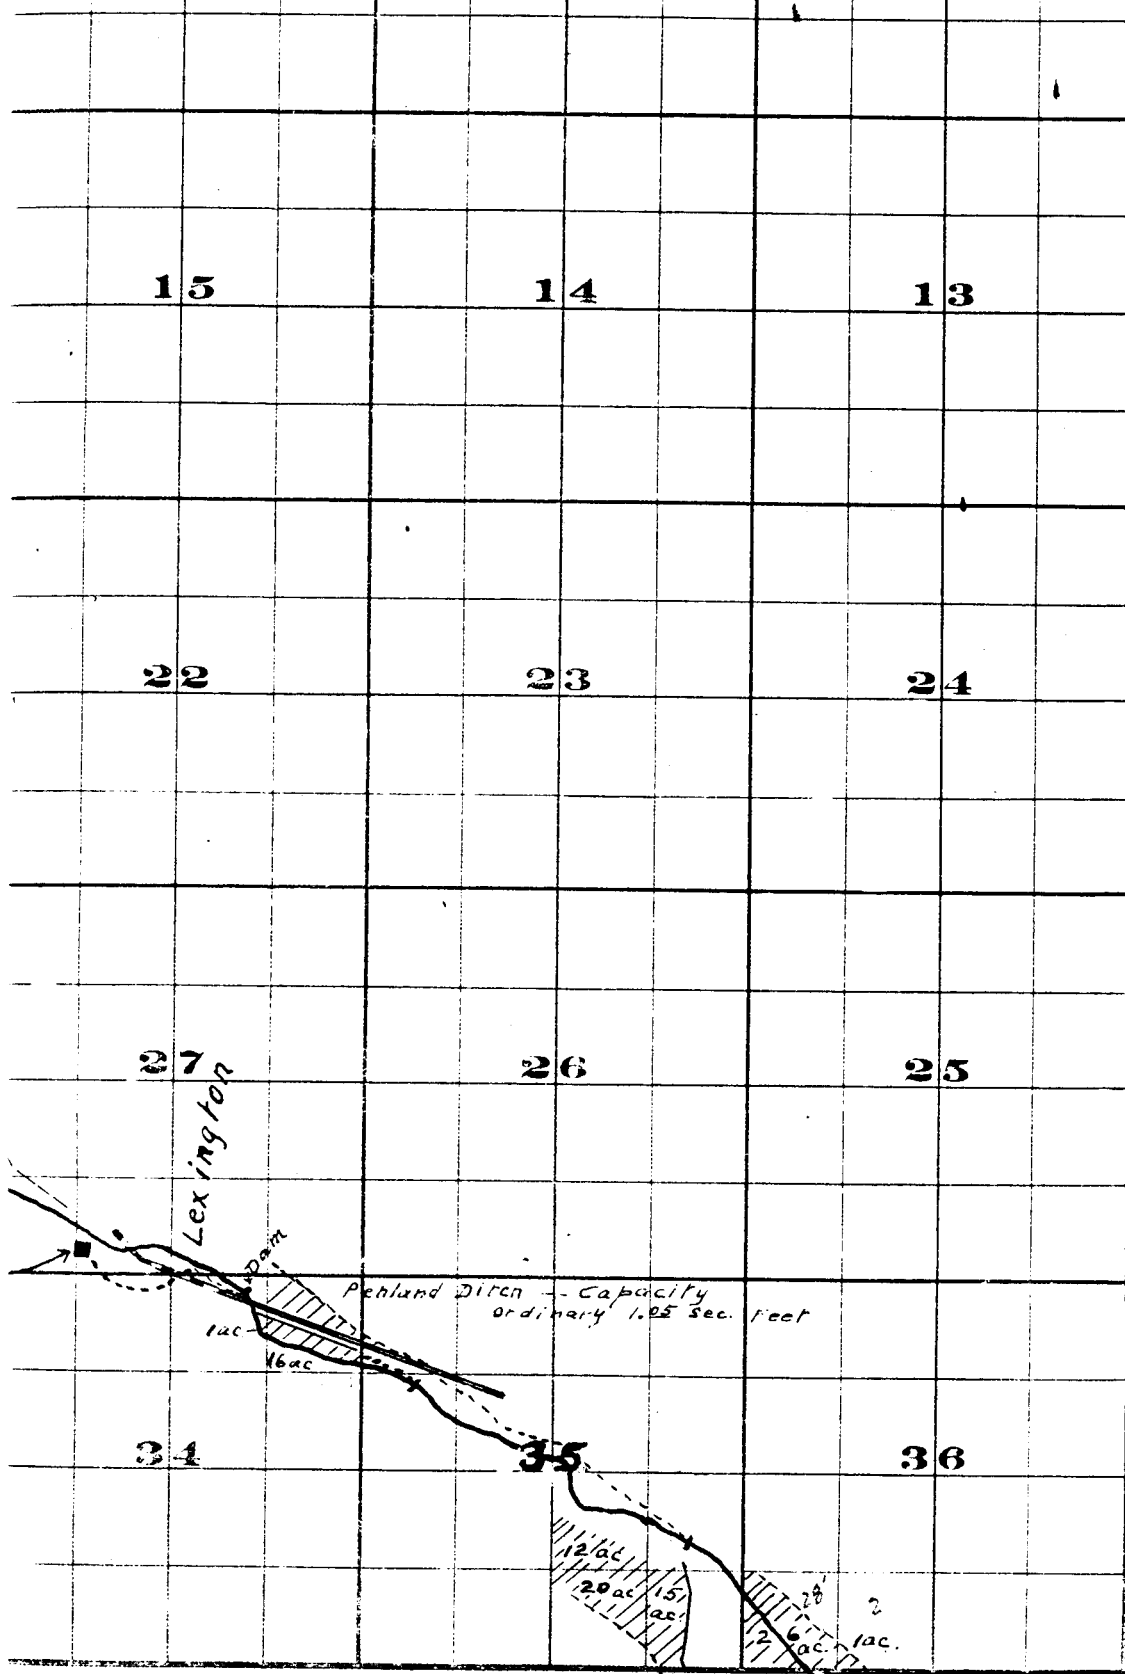

FROM OFFICE OF THE STATE ENGINEER, SALEM, OREGON

*Willow Creek Adjudication.*