


33

34

T4 S. R. 28 E
T5 S. R. 28 E

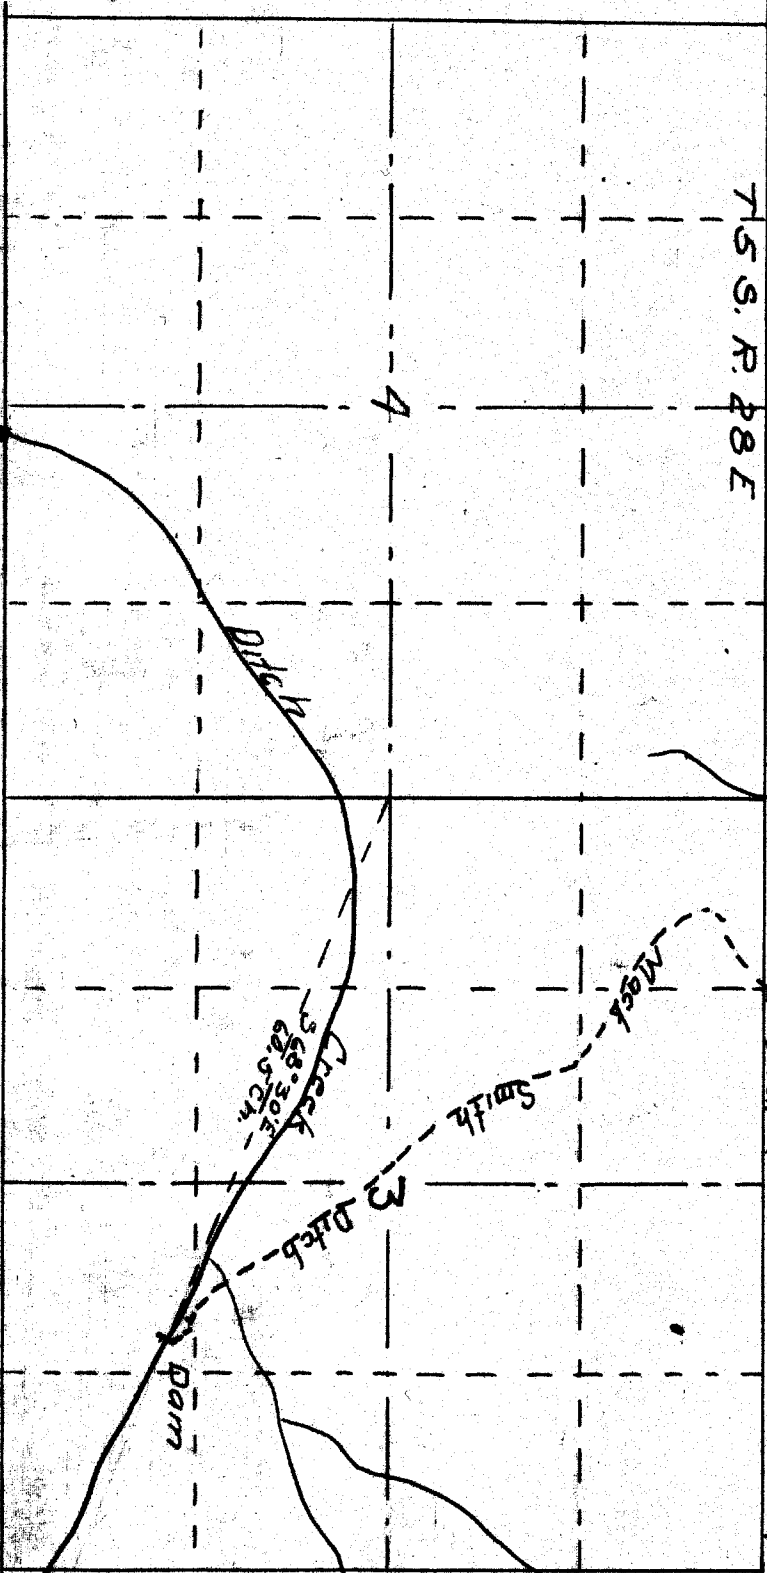

App. No. 18262
Gen. No. 14006

DITCH CREEK DIVERSION

Scale 4 in = 1 mi.

I, H. Tamblyn of Heppner, Ore, do hereby certify that this map was made from notes taken during an actual survey made by me on Aug. 17, 1939, and that it correctly represents the works described in the accompanying application together with the location of streams in the immediate vicinity.

H. Tamblyn
Reg. Prof. Engr.
Registered Jun. 1, 1920.
Oregon No. 1033.

