


RECEIVED

SEP 30 1939

STATE ENGINEER

Township 27 South Range 11 West

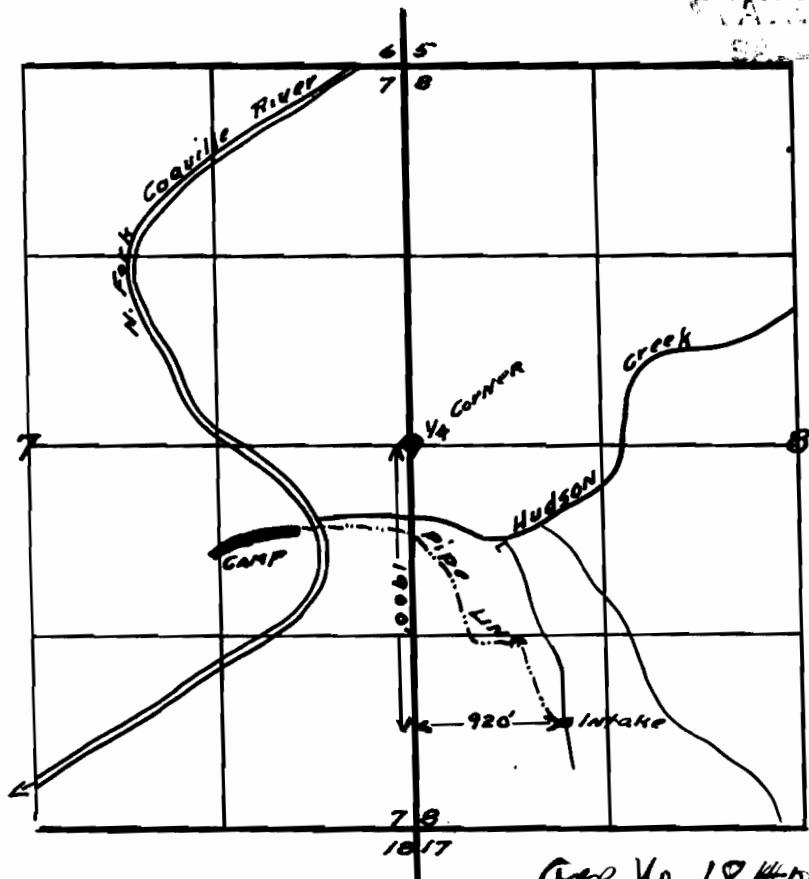

1235 ft. of 2½" pipe
1400 ft of 2" pipe
Scale 4 inches = 1 Mile

App. No 18407 EX


17-21

Per. No. 14044

SECTION

TOWNSHIP 27S, RANGE 11W, W. M.

North

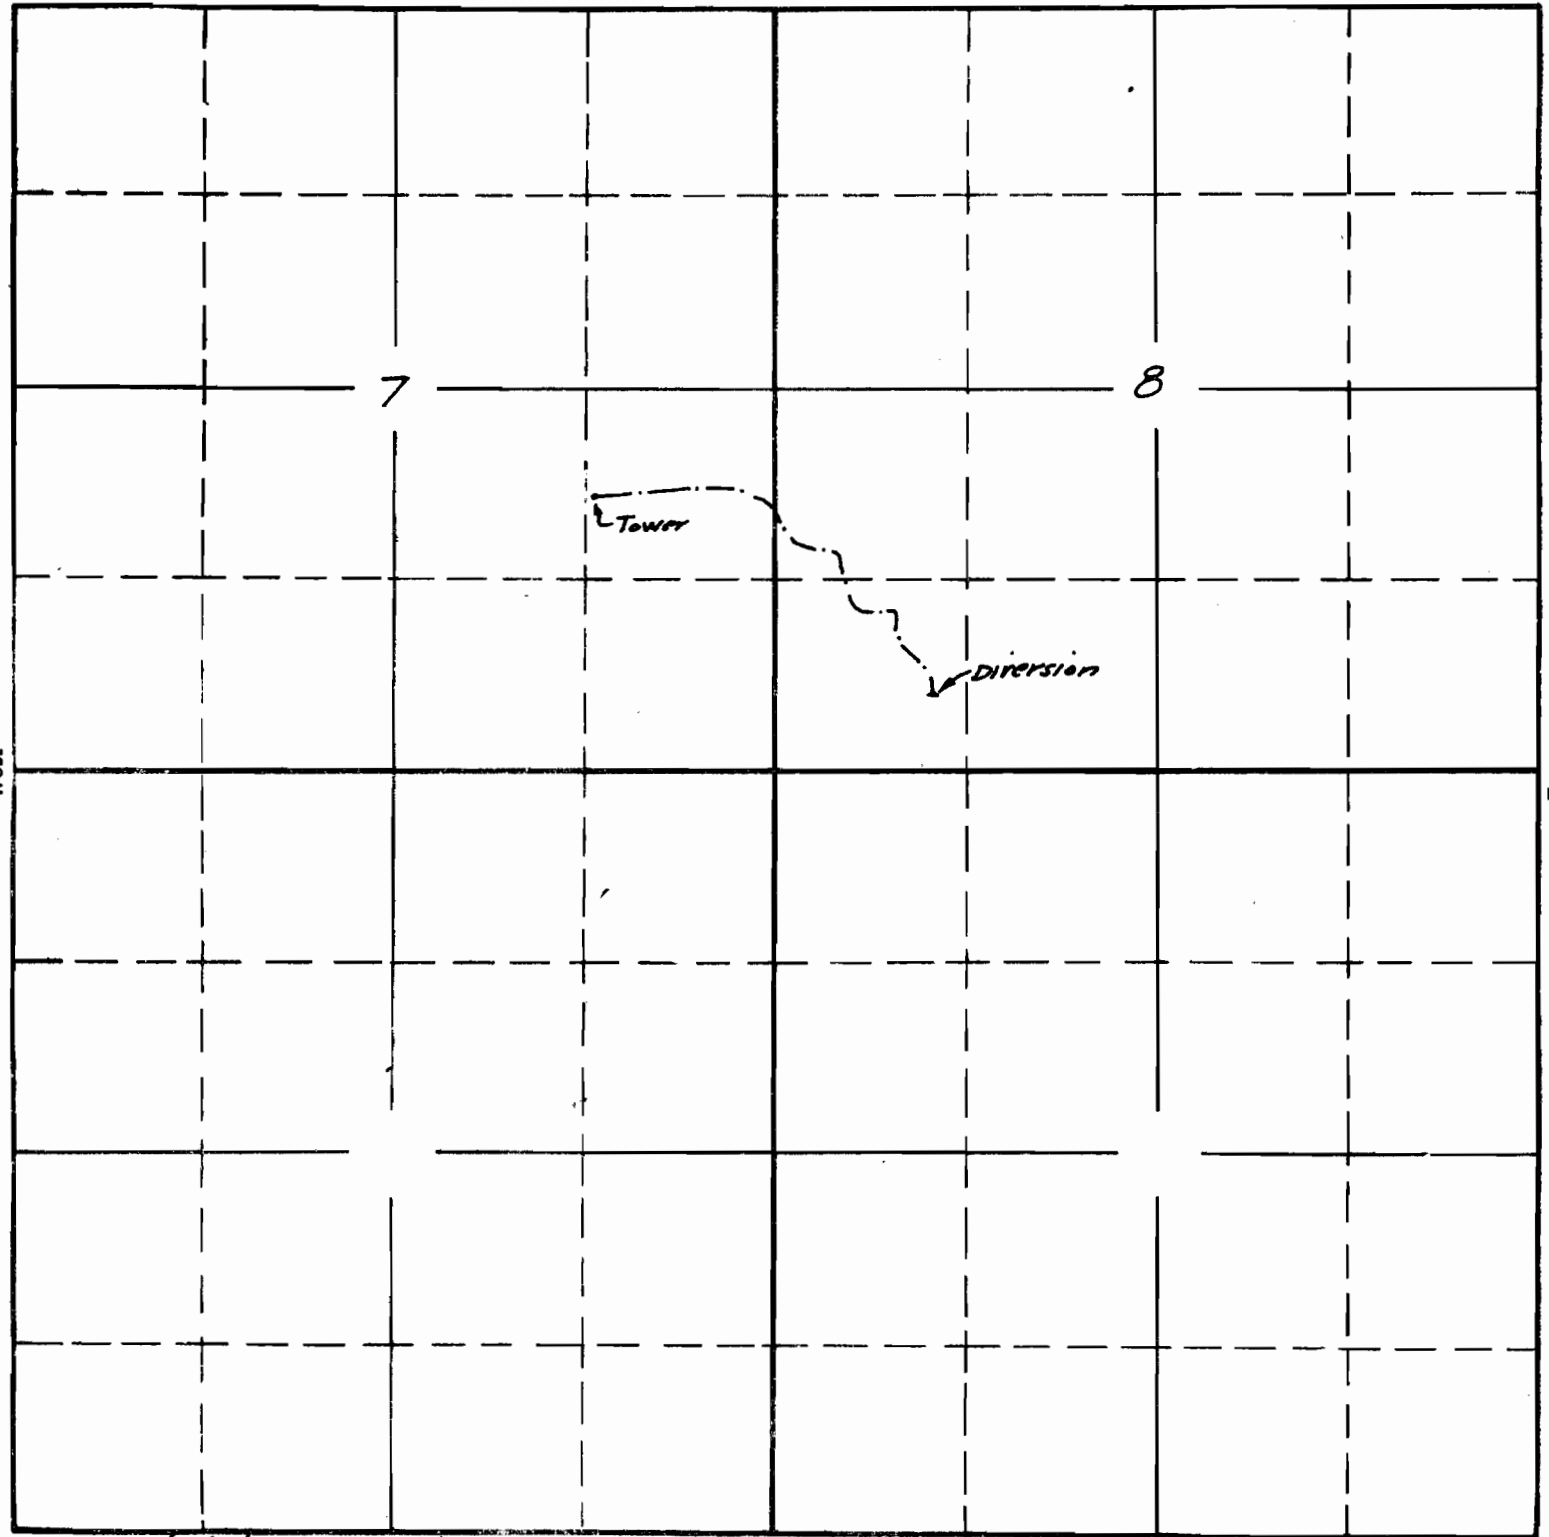

surveyed July 2, 1940 C.B.C.

South

APPLICATION No. 18407
PERMIT No. 14044