


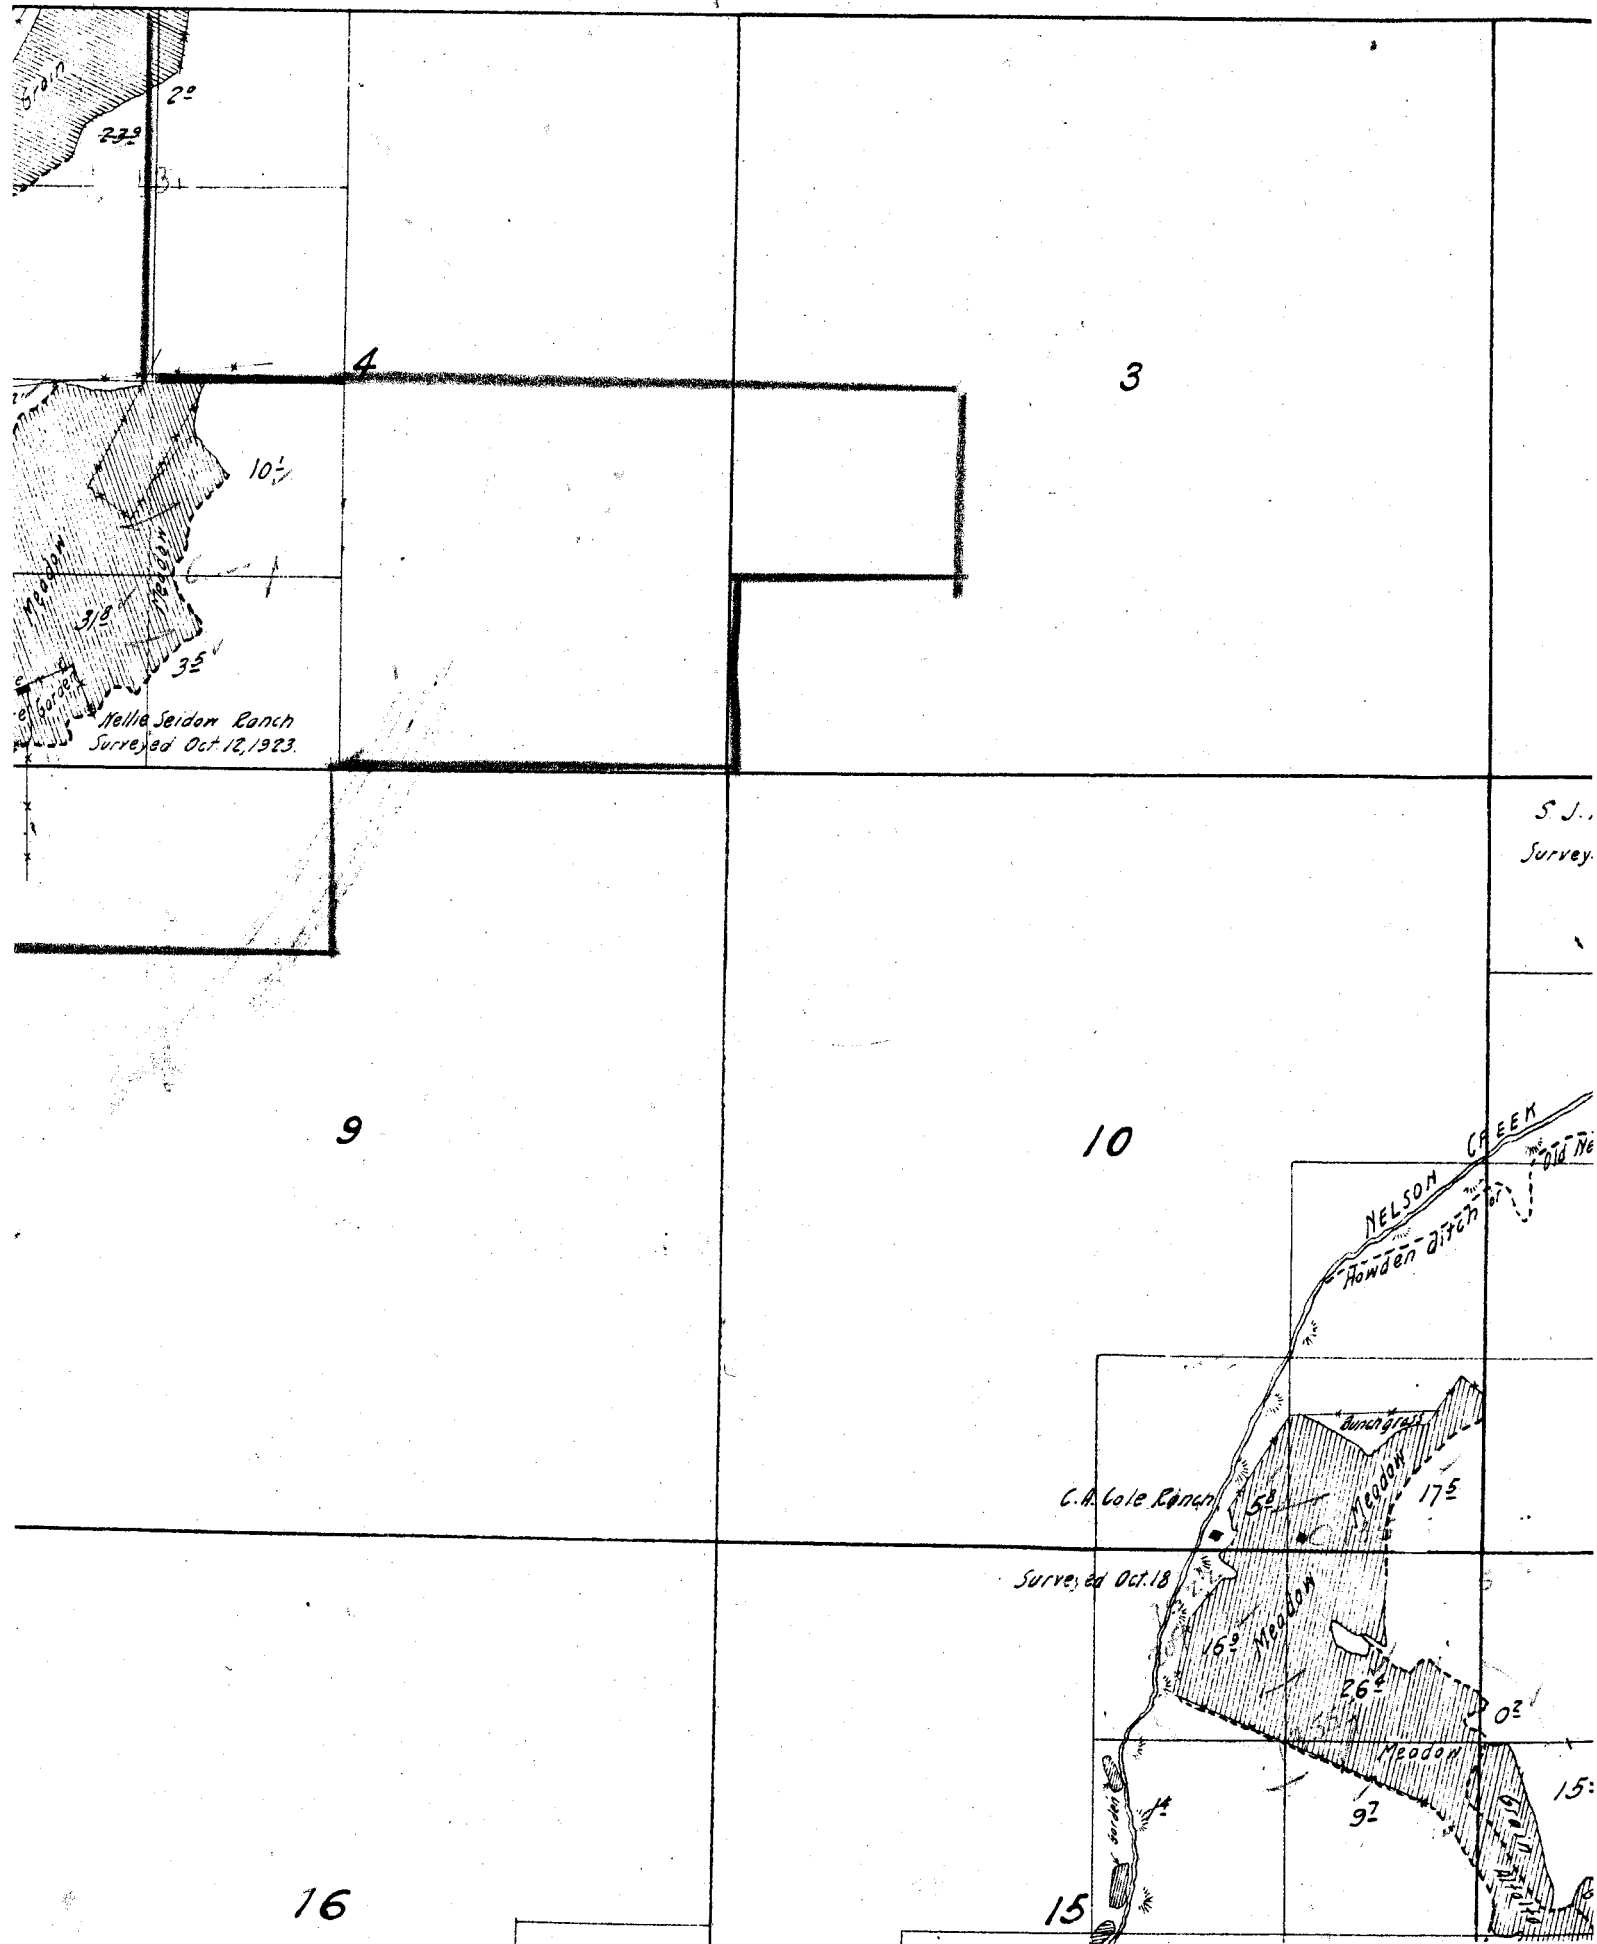

65'

Med

Chas. Payne Ranch

Surveyed Oct 27, 1923.

John W. Brackett
Surveyed May 22, 24

55'

42'

72'

62'














Township

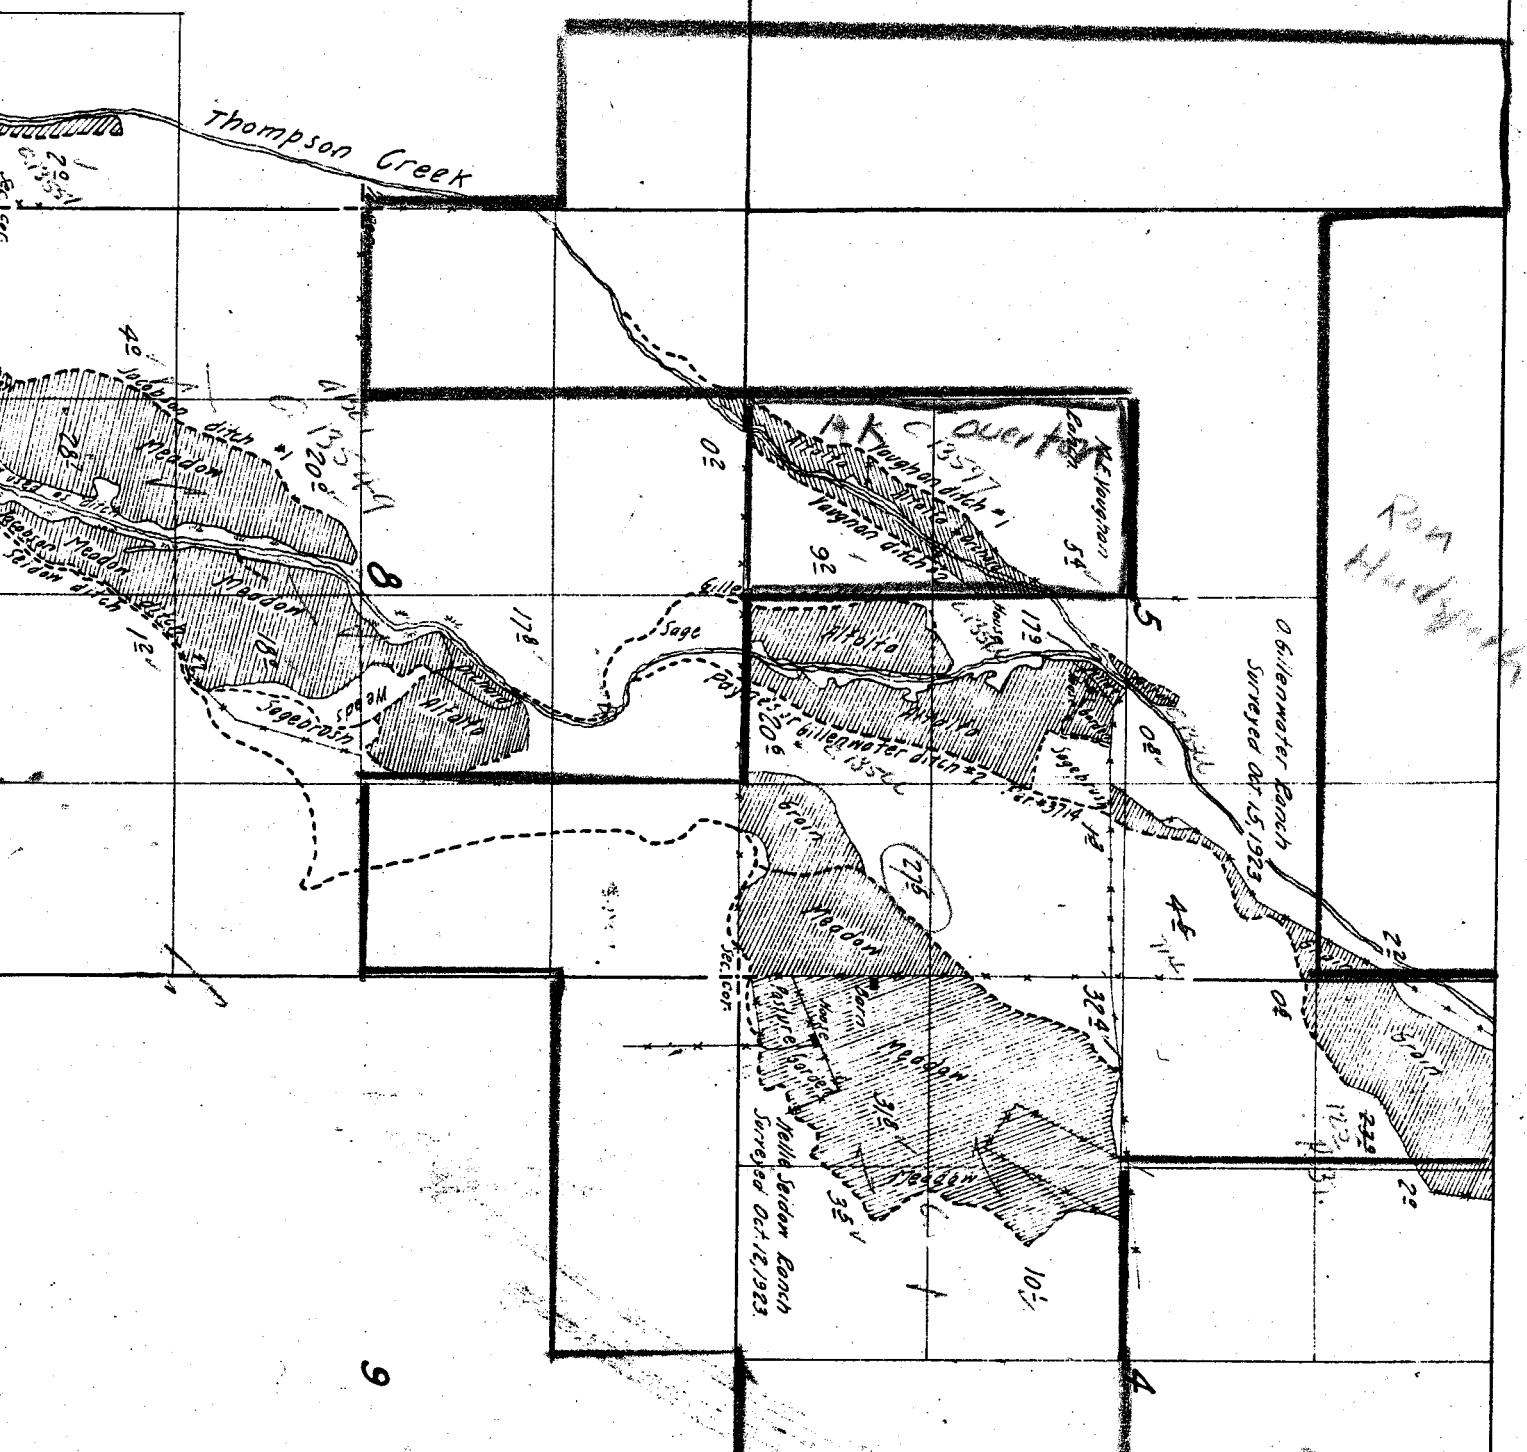

123,24.

16

21

22

1/4 Sec




Nelson and Campbell
Hatch
Surveyed Oct 19, 1873

Gr. Nelson ditch
Per. #4375



Cole Bros.

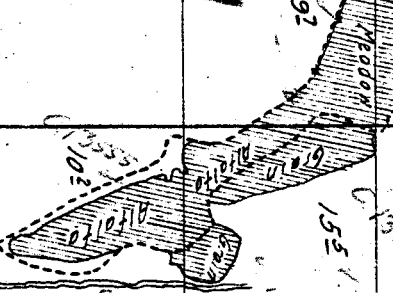

Maxwell Ditch Per. #209

Surveyed Oct 18

Meador

G.H. Nelson Reservoir
Per #462


28


27


33

34

Maxwell Creek

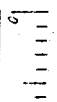

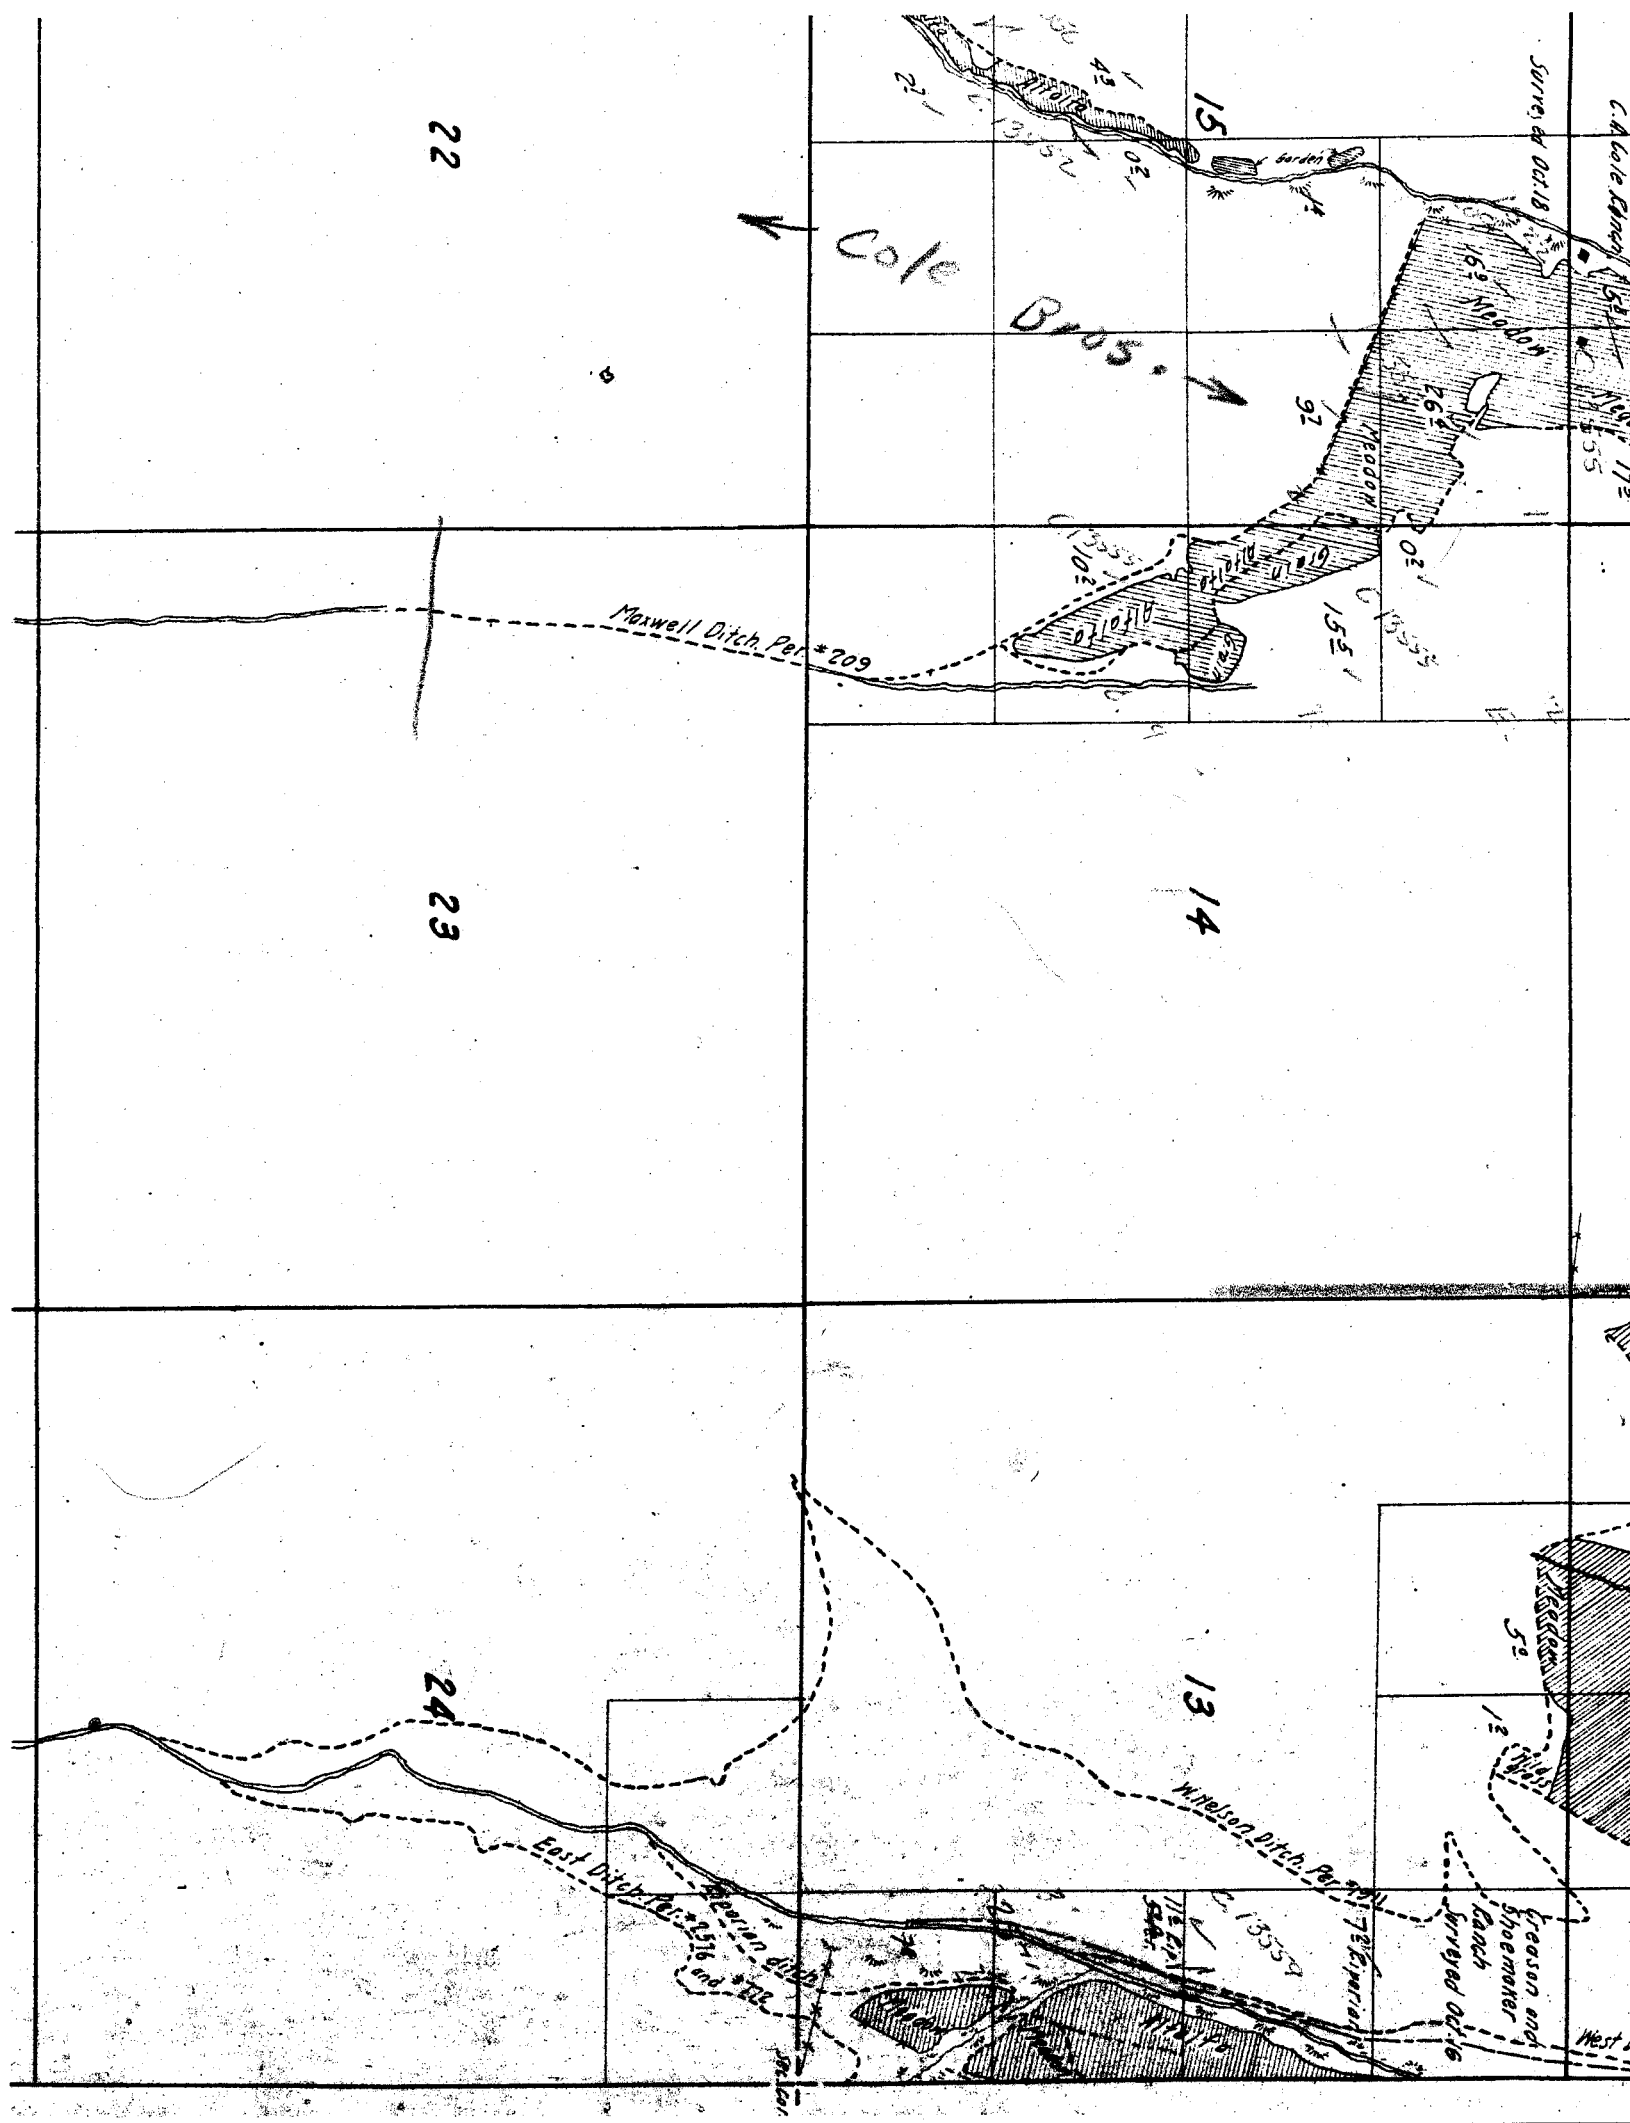

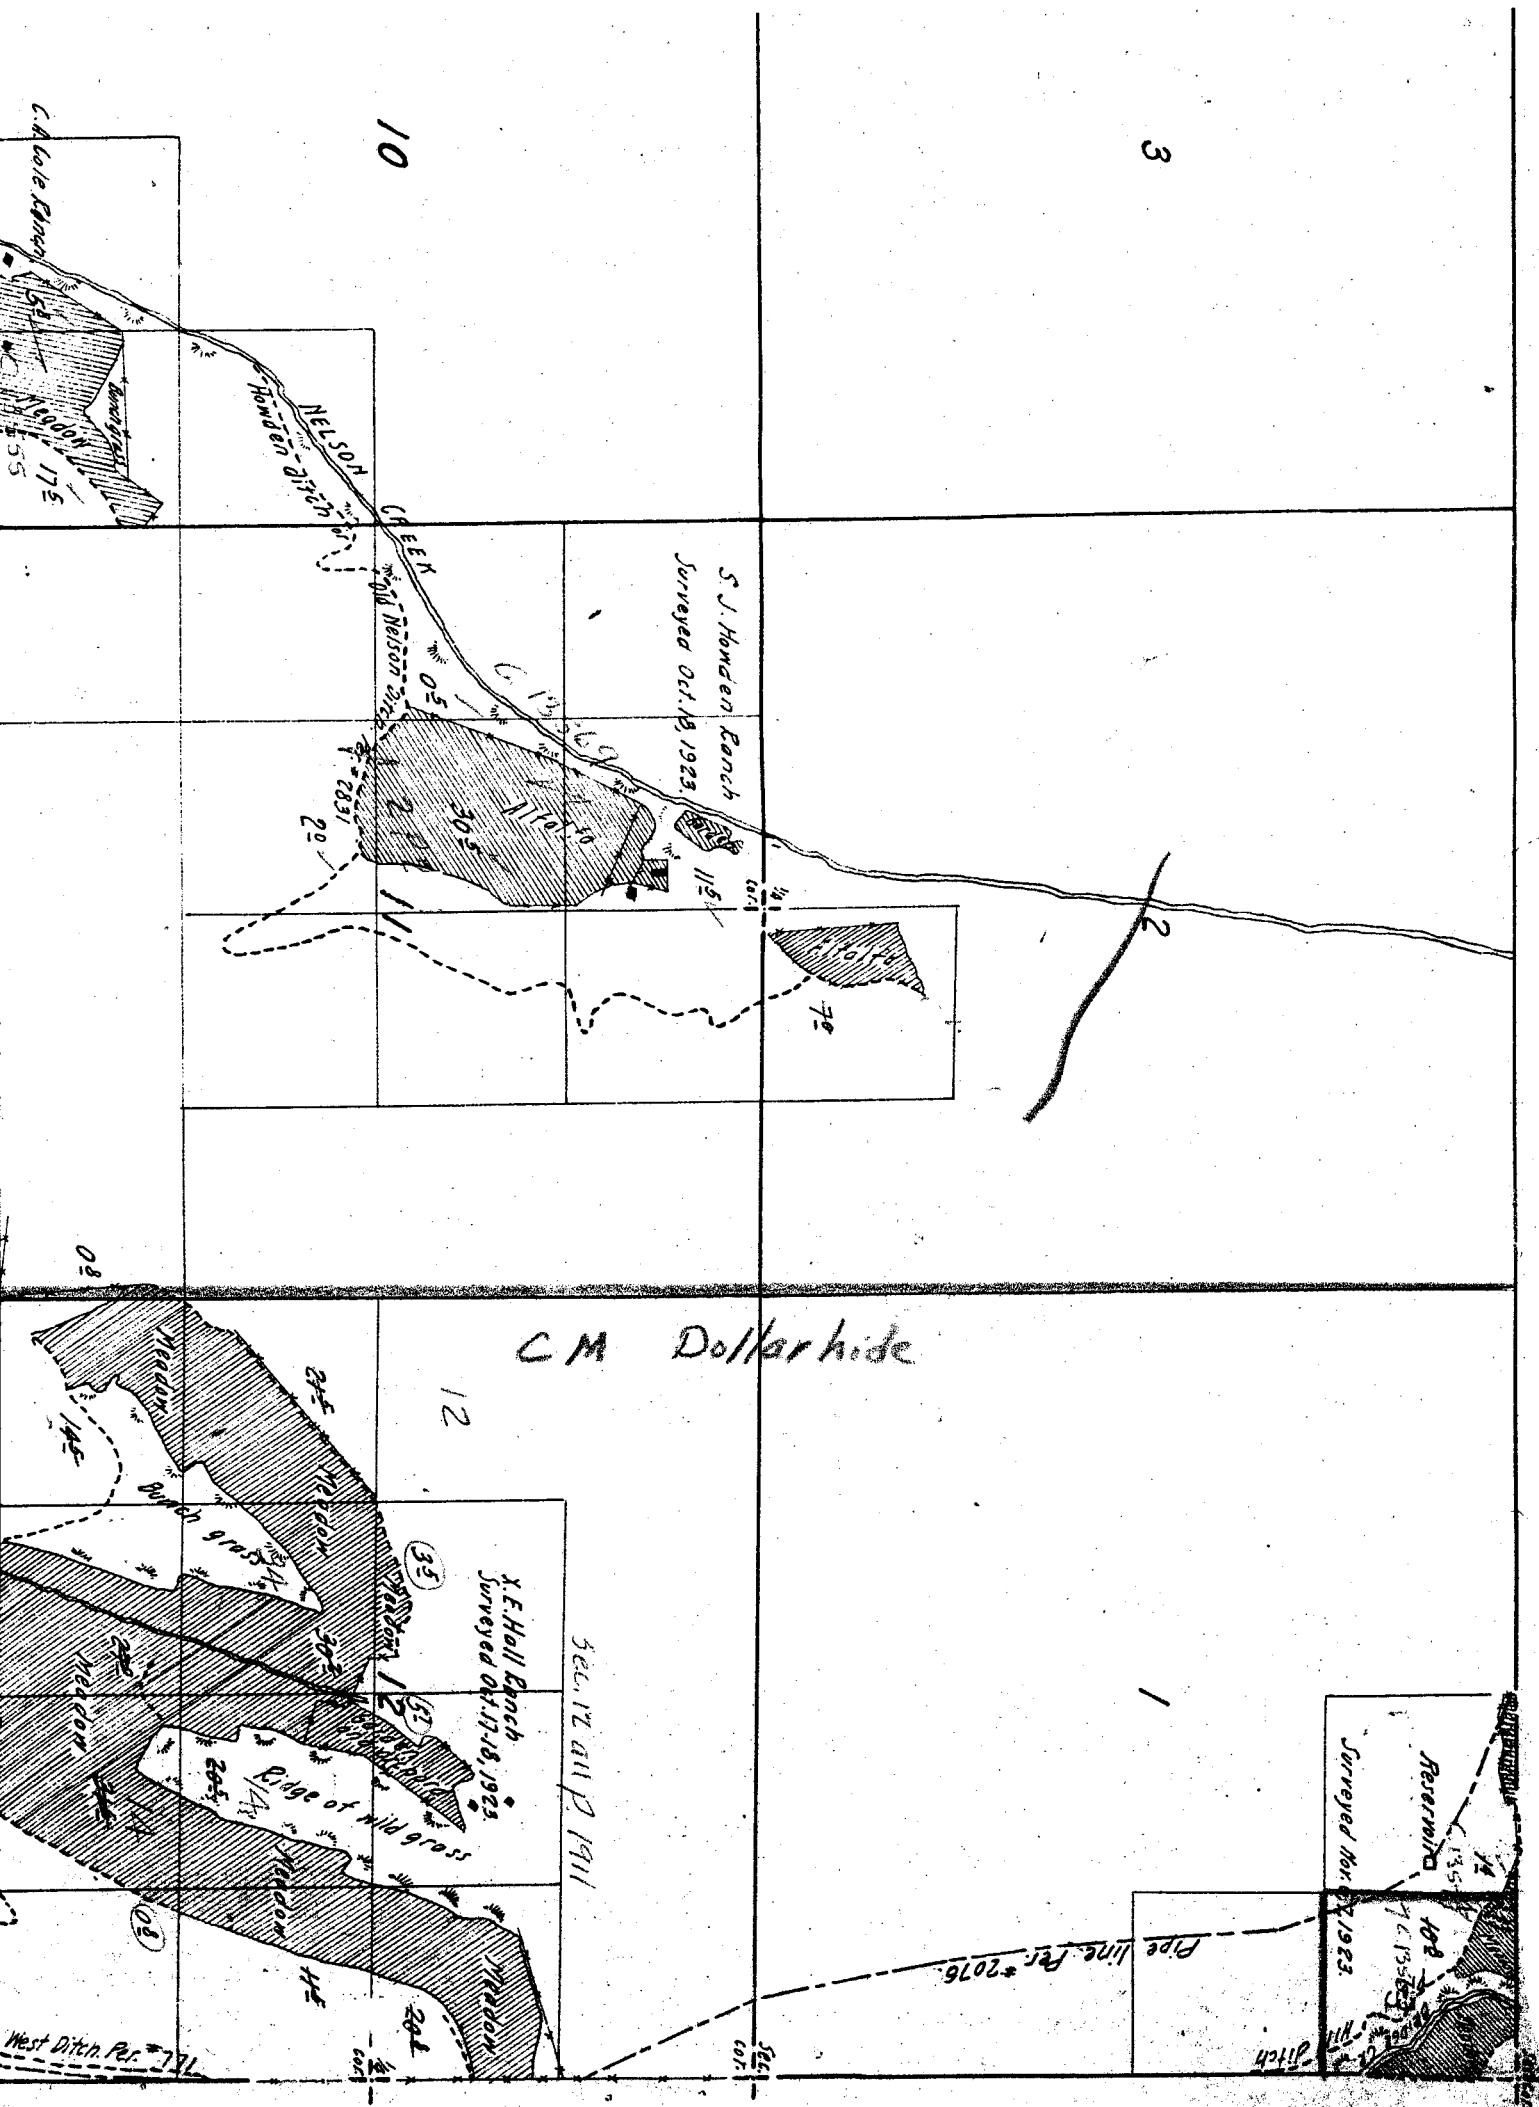

23

24

26

25

MILL CREEK

35

36

Note: - Creeks sketched in approximate location
from U.S. Township plats or from Forest Service
map except in vicinity of irrigated areas.
Permit ditches plotted in approximate location
from permit maps except in vicinity of irriga-
ted areas.

0 1000 2000 3000 4000 5000 6000 7000 8000

Scale of Feet.

19

20

Leach Creek

30

29

31

32