

Township

4

5

6

Marvin and
Carr Survey
125-13554


9

R.D. Cannon &
B.P.

8

May E. Stephenson Ranch
79 Surveyed Nov 2, 1923.

Note: Location of
creek and irriga-
ted areas somewhat
approximate.

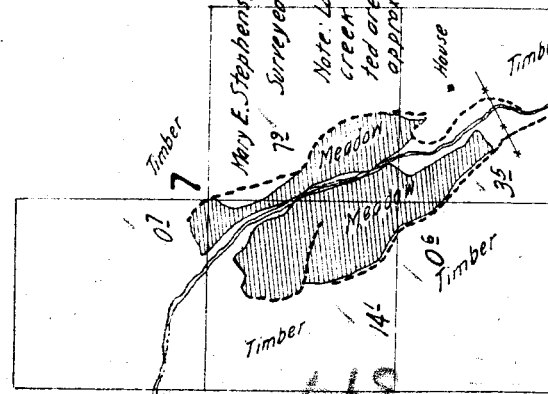

Stephenson

12


16

65

17

61

18

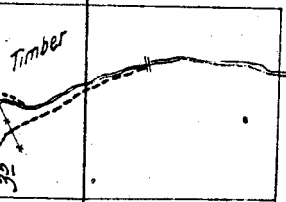

HEFLIN CREEK

23

24

THOMPSON


26

25


Note: - Greys sketched in approximate location from U.S. Township plat, U.S. Forest Service map, and permit maps, except in vicinity of irrigated areas.

35

36

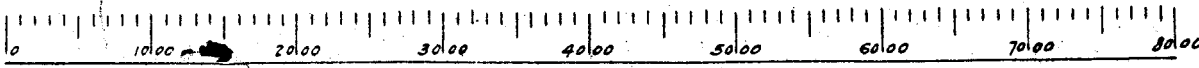


Scale of Feet.

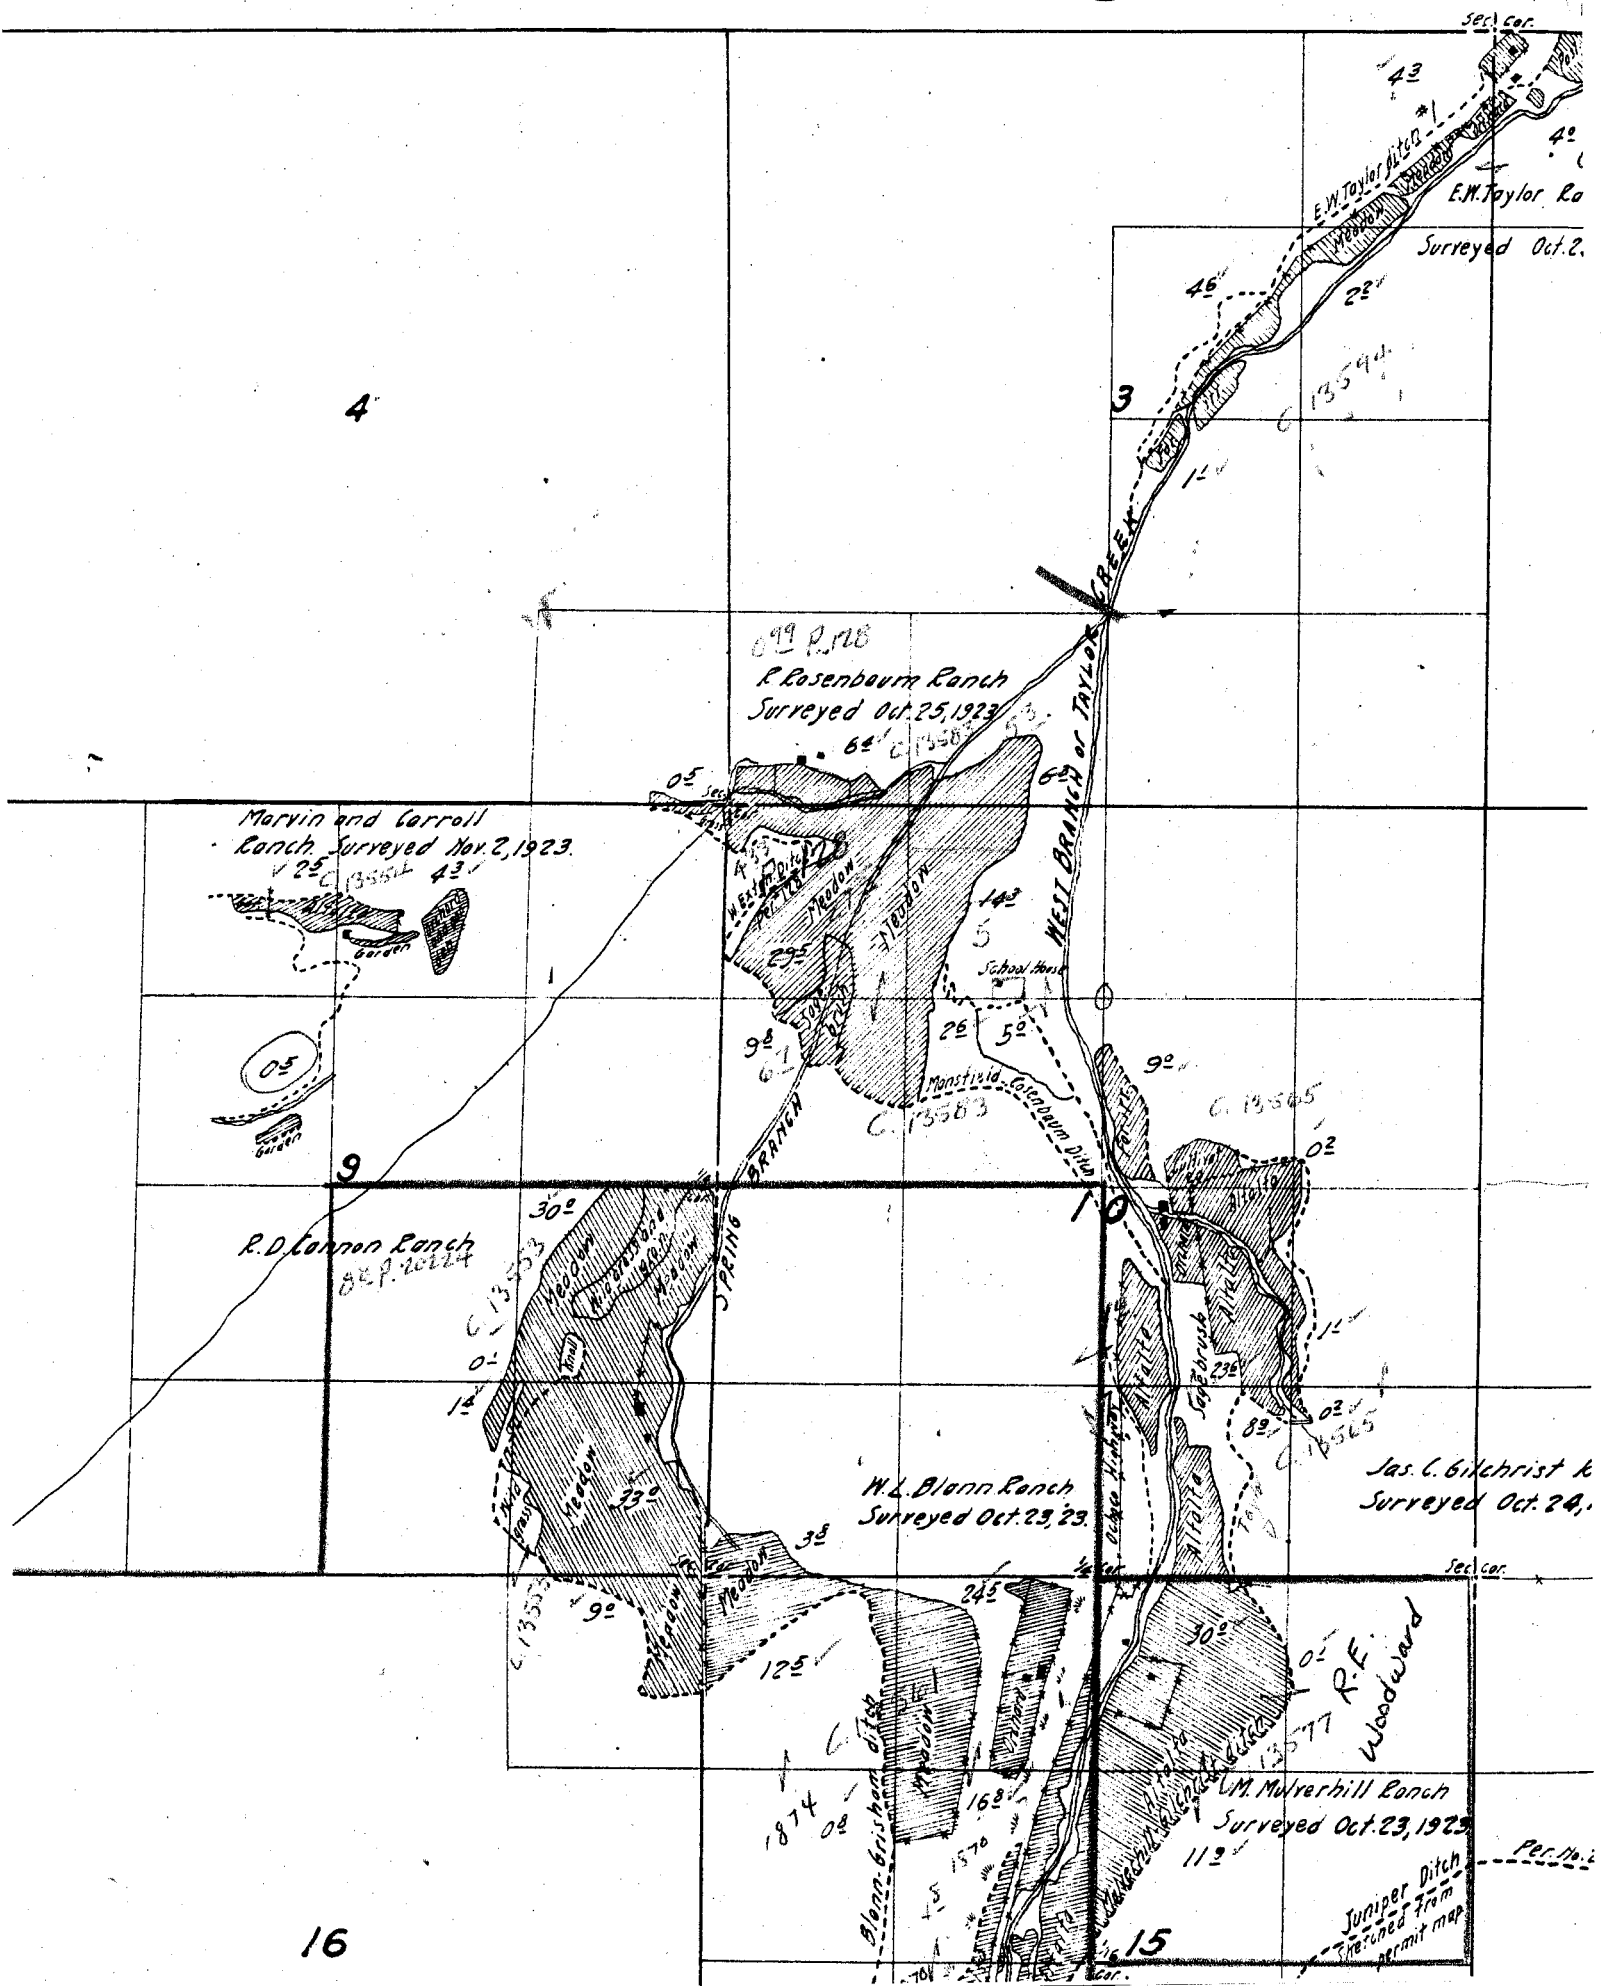

ge 20 E.

9-1-1

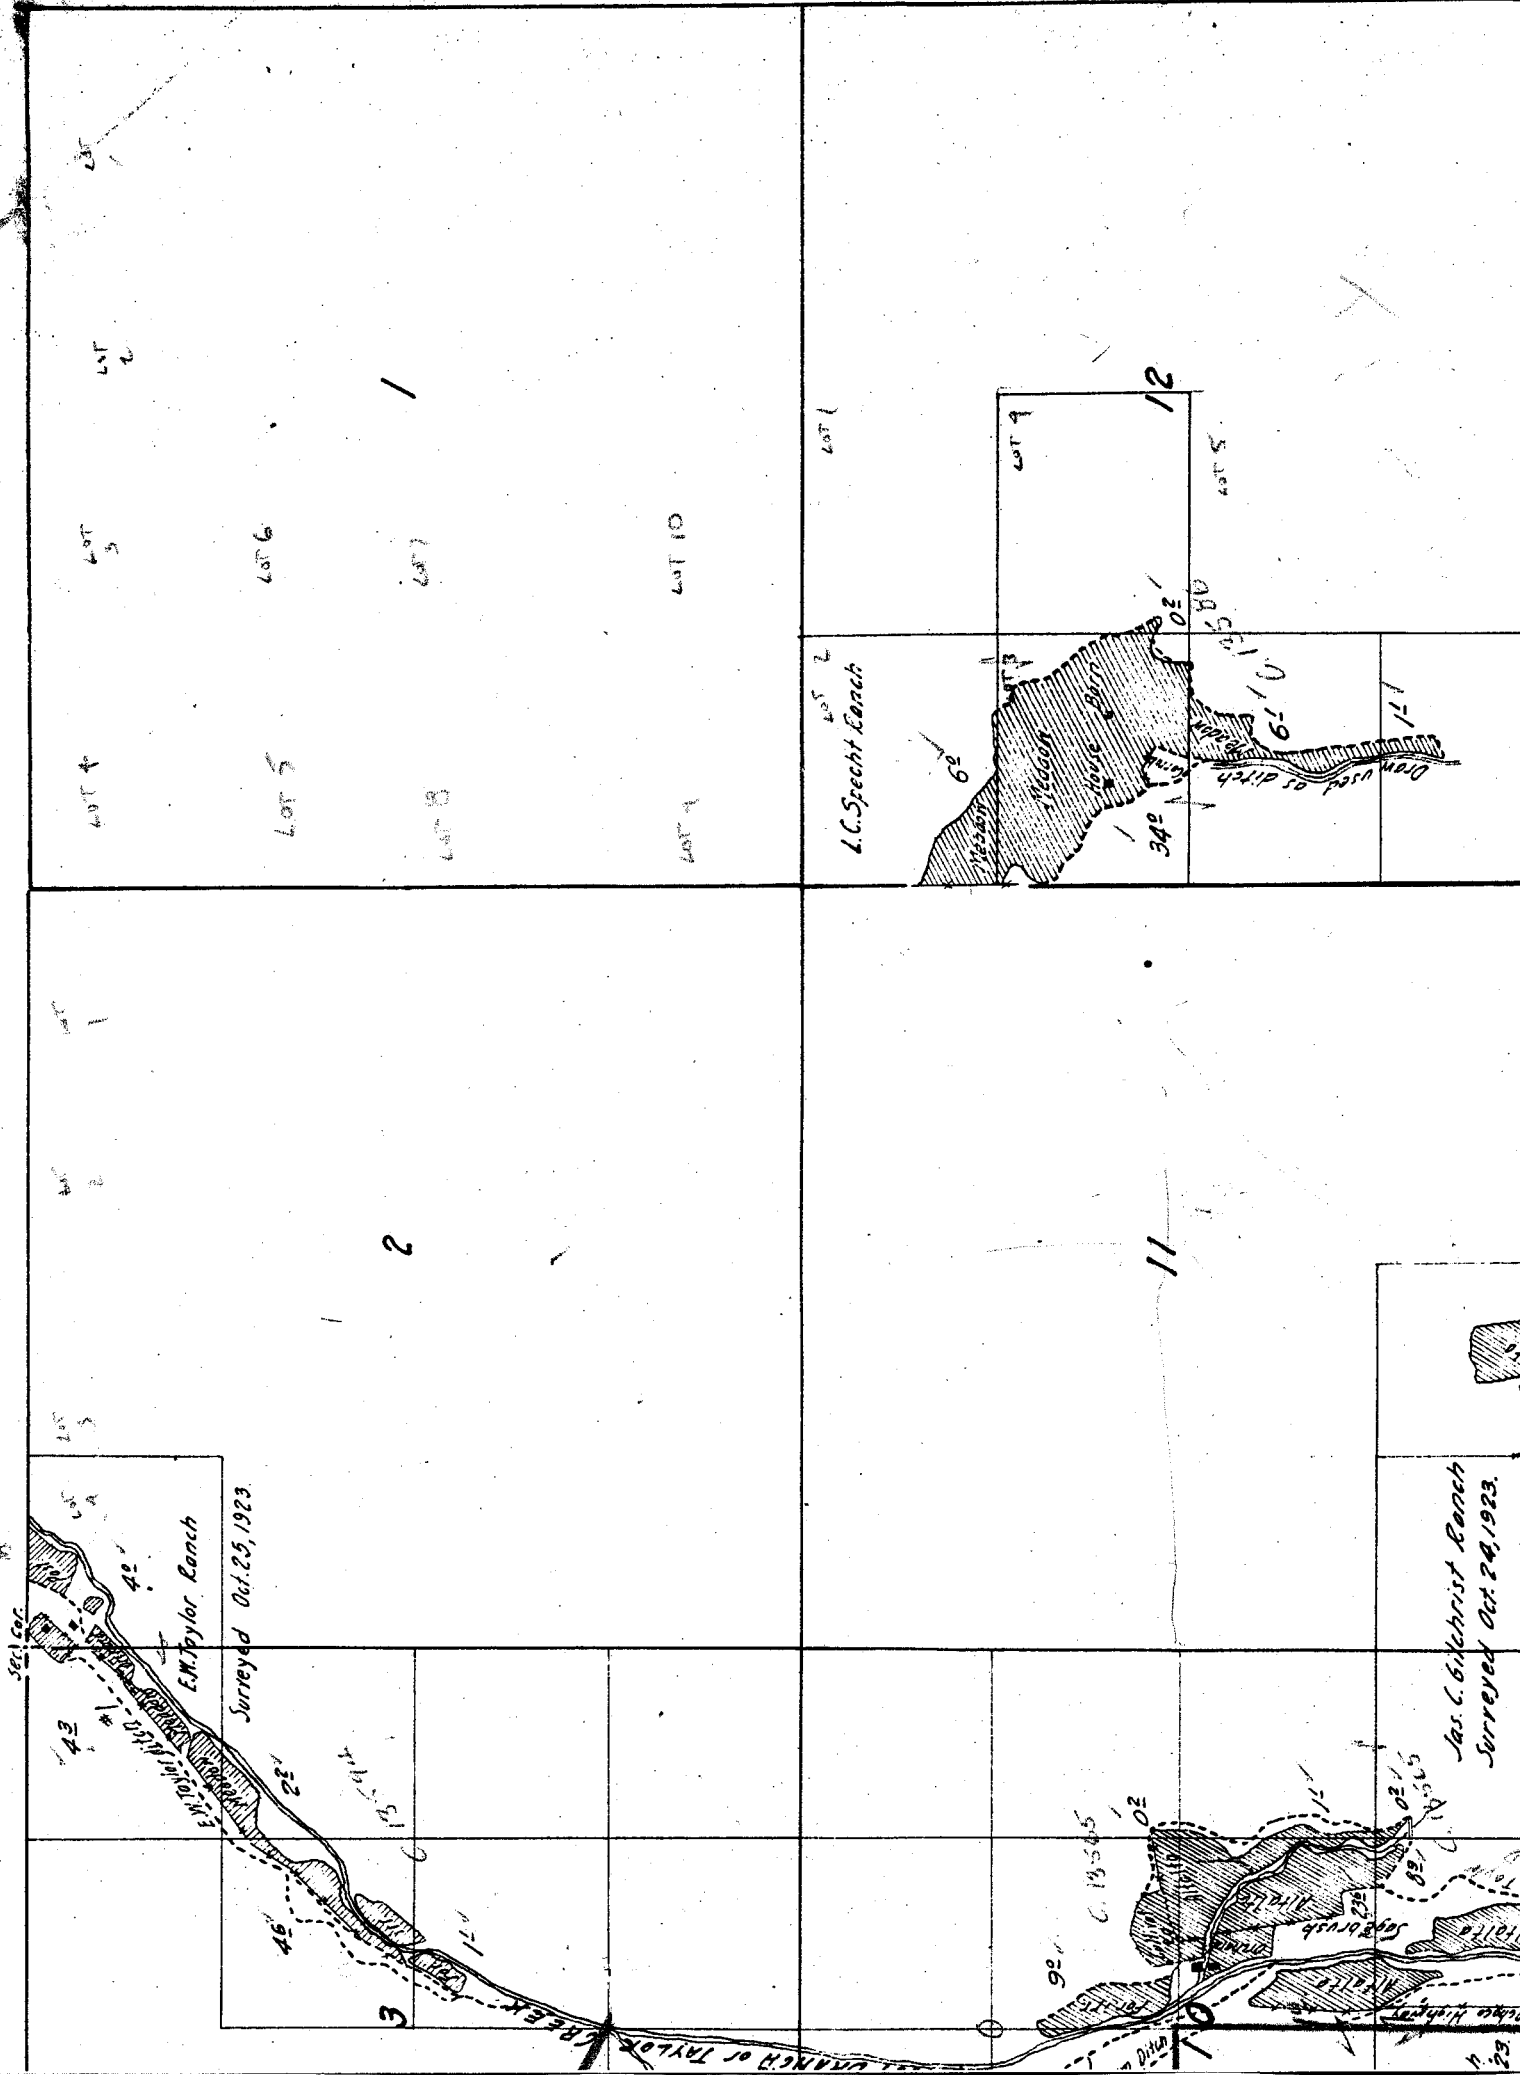

Surveyed Oct. 27, 1923.

Lot 1

Lot 2

Lot 3

Lot 4

Lot 5

Lot 6

Lot 7

Lot 8

T.M. Dove Ranch

Two-way division box

Specht ditch

Note: Dove Specht Ditch heads in spring at head of Thompson Creek.

Thompson Creek

24

13

Surveyed Oct. 24, 1923.

Section

14

R.F. Woodward

M. M. Mulvihill Ranch

Surveyed Oct. 23, 1923.

15

C. G. Flemis Ranch

Surveyed Oct. 22, 1923.

23

Rail Creek

White tree

13573

98

95

113

102

101






































































28

33

Beaver Ranger
Station.
Surveyed Oct. 22.
2 P. L. 46


Hand-drawn map of a ranch area. A shaded, irregular shape represents a field. Inside this shape, the text "Meadow irrigated by furrow ditches and sub-moisture" is written. To the left of the shaded area, the number "321" is written vertically. Below the shaded area, the number "163" is written. To the right of the shaded area, the text "John Boyd Ranch" is written. Further to the right, the number "8" is written vertically. At the bottom center, the text "42 P." is written.

WEST BRANCH OF TAY

27


Slide Creek

34

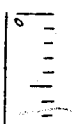

16

21

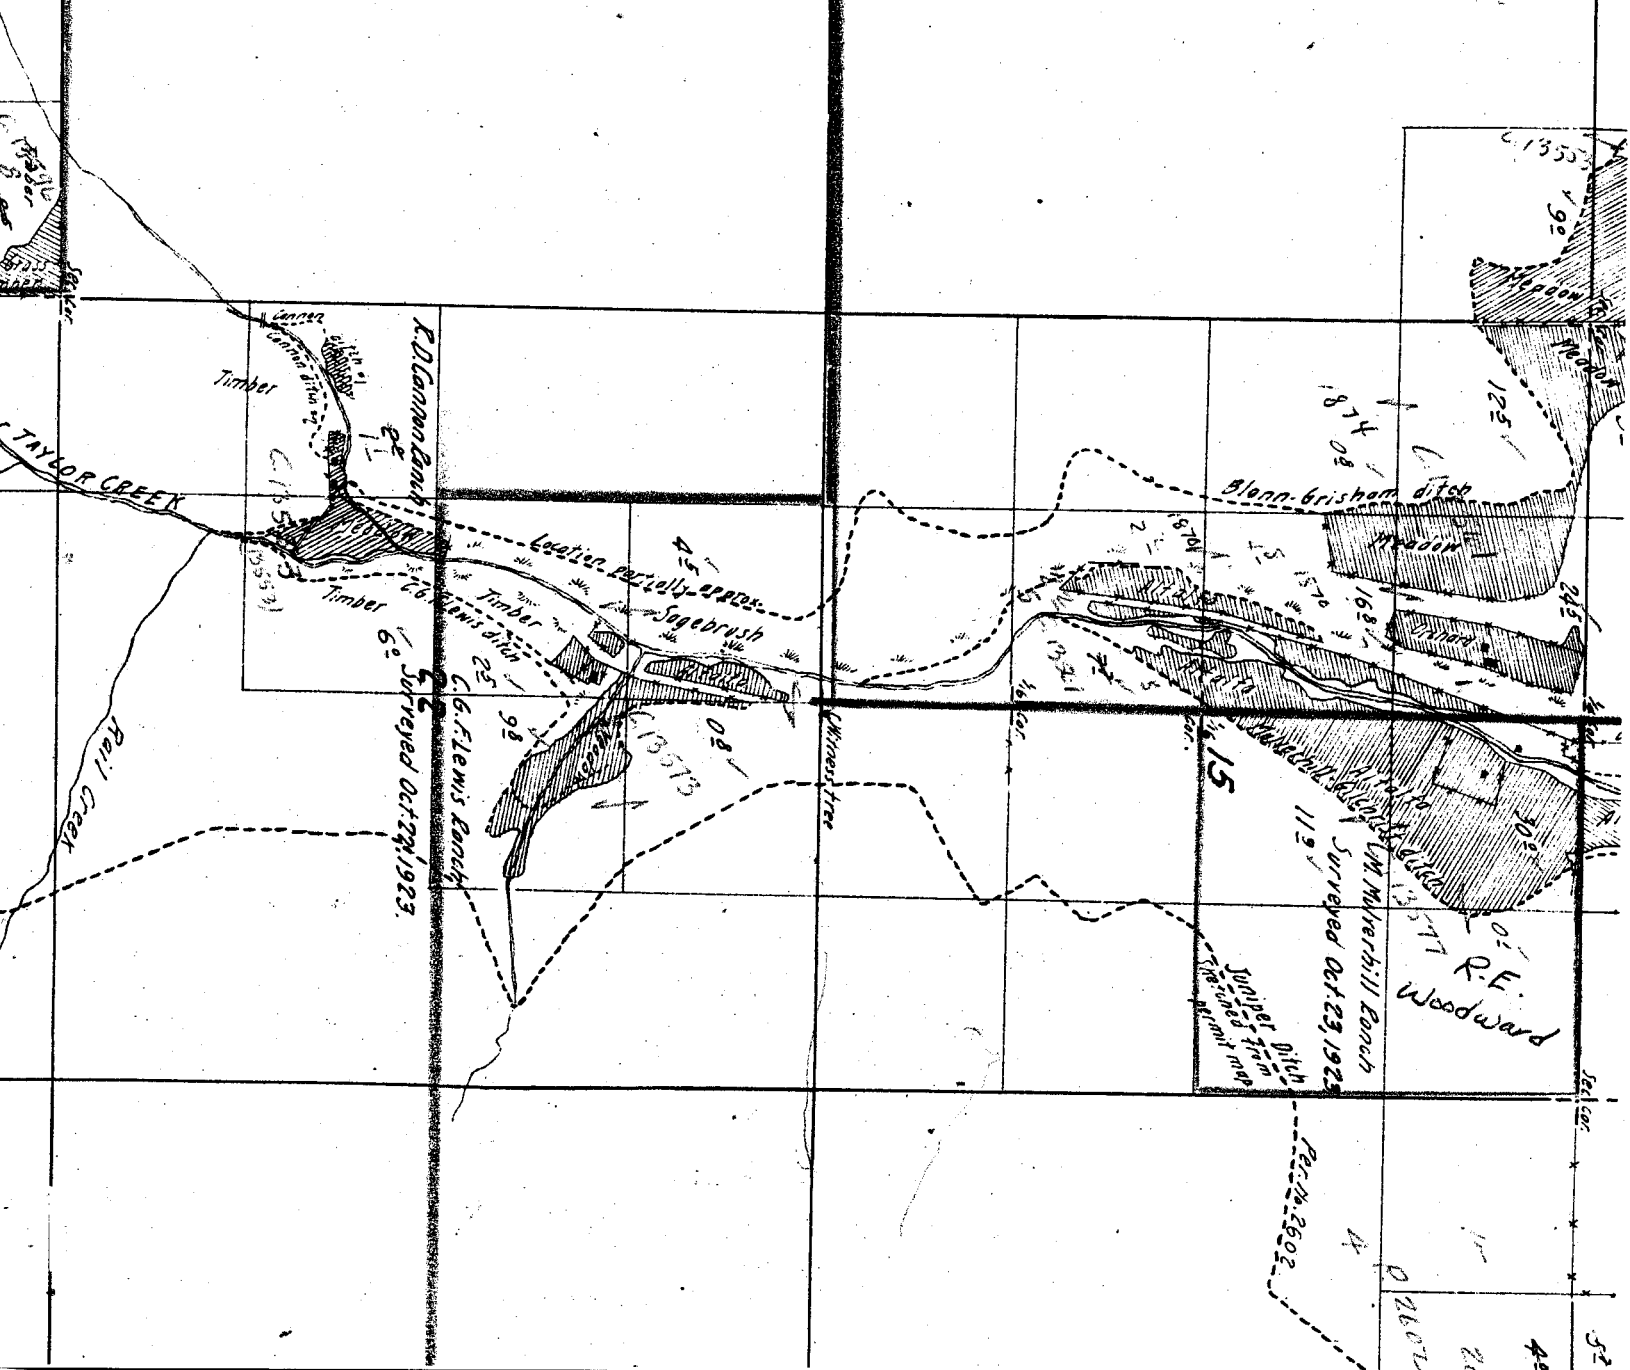

19

20

30

29

31

32