

19


20

30


29

31

32

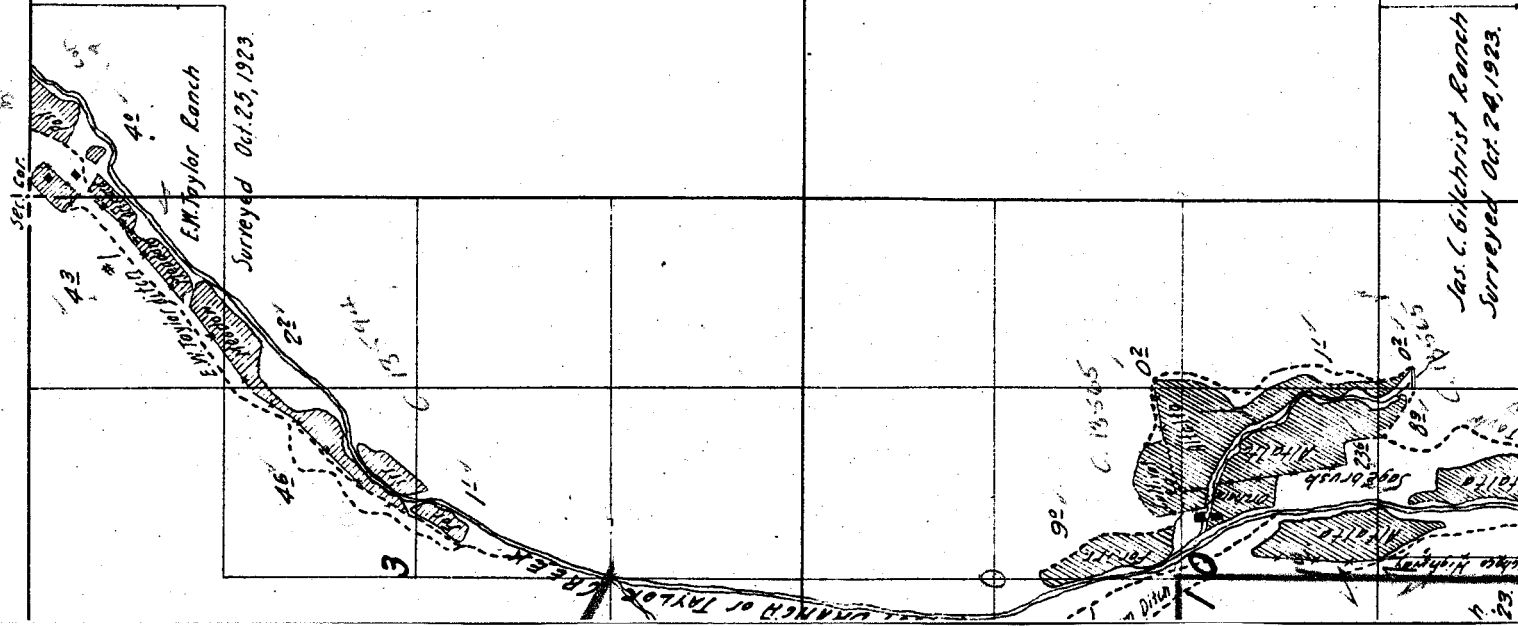

Surveyed Oct 24, 1923.

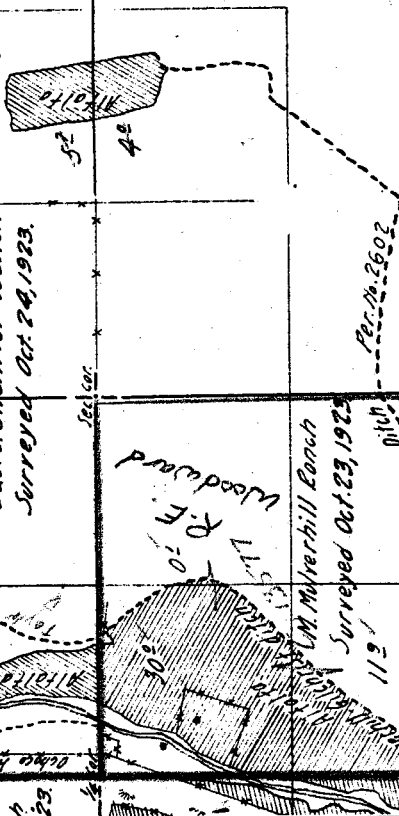

14

15

Sec. 14

LOT 2

LOT 3

Surveyed Oct. 23, 1923.

13

LOT 6

T.M. Dove Ranch

Two-way division box

Specht ditch

LOT 7

LOT 8

41' 7" 43' 56" 123'

Two-way division box

Note: Byrd-Dove Specht Ditch heads in spring at head of Thompson Creek.

THOMPSON CREEK

24

23

C.G. Lewis Ranch

Surveyed Oct 24, 1923.

Rail Creek

USA  
28

33

Boyer Ranger Station  
Surveyed Aug 22  
1938  
21.1.10.16  
1938  
0.5.10.16


Wetland irrigated by  
farrow ditches and sub-  
meisfure  
John Boyd Ranch  
163  
32.1.10.16

WEST BRANCH OF TAY  
68.1.10.16  
1938

27


Slide Creek


34

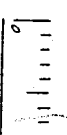

16

21

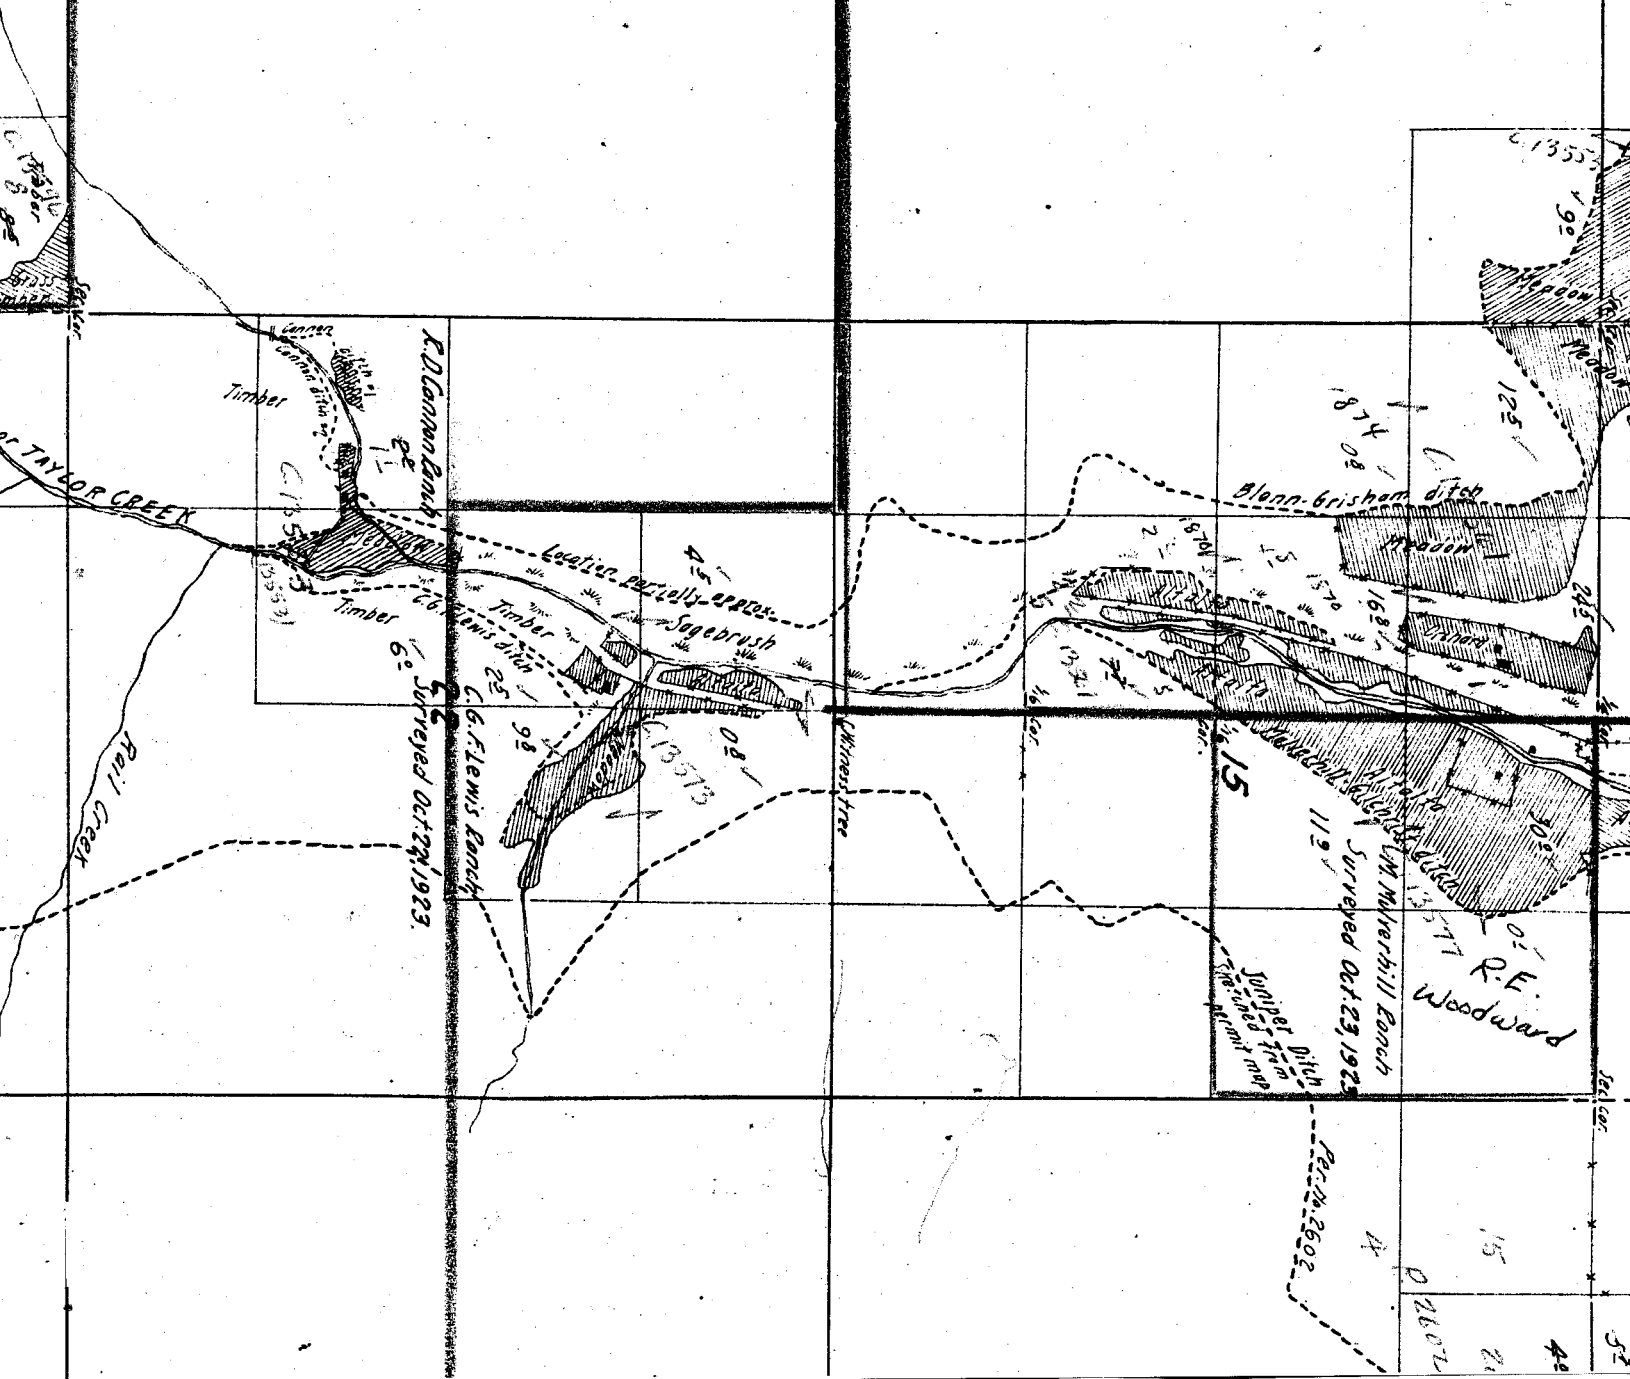

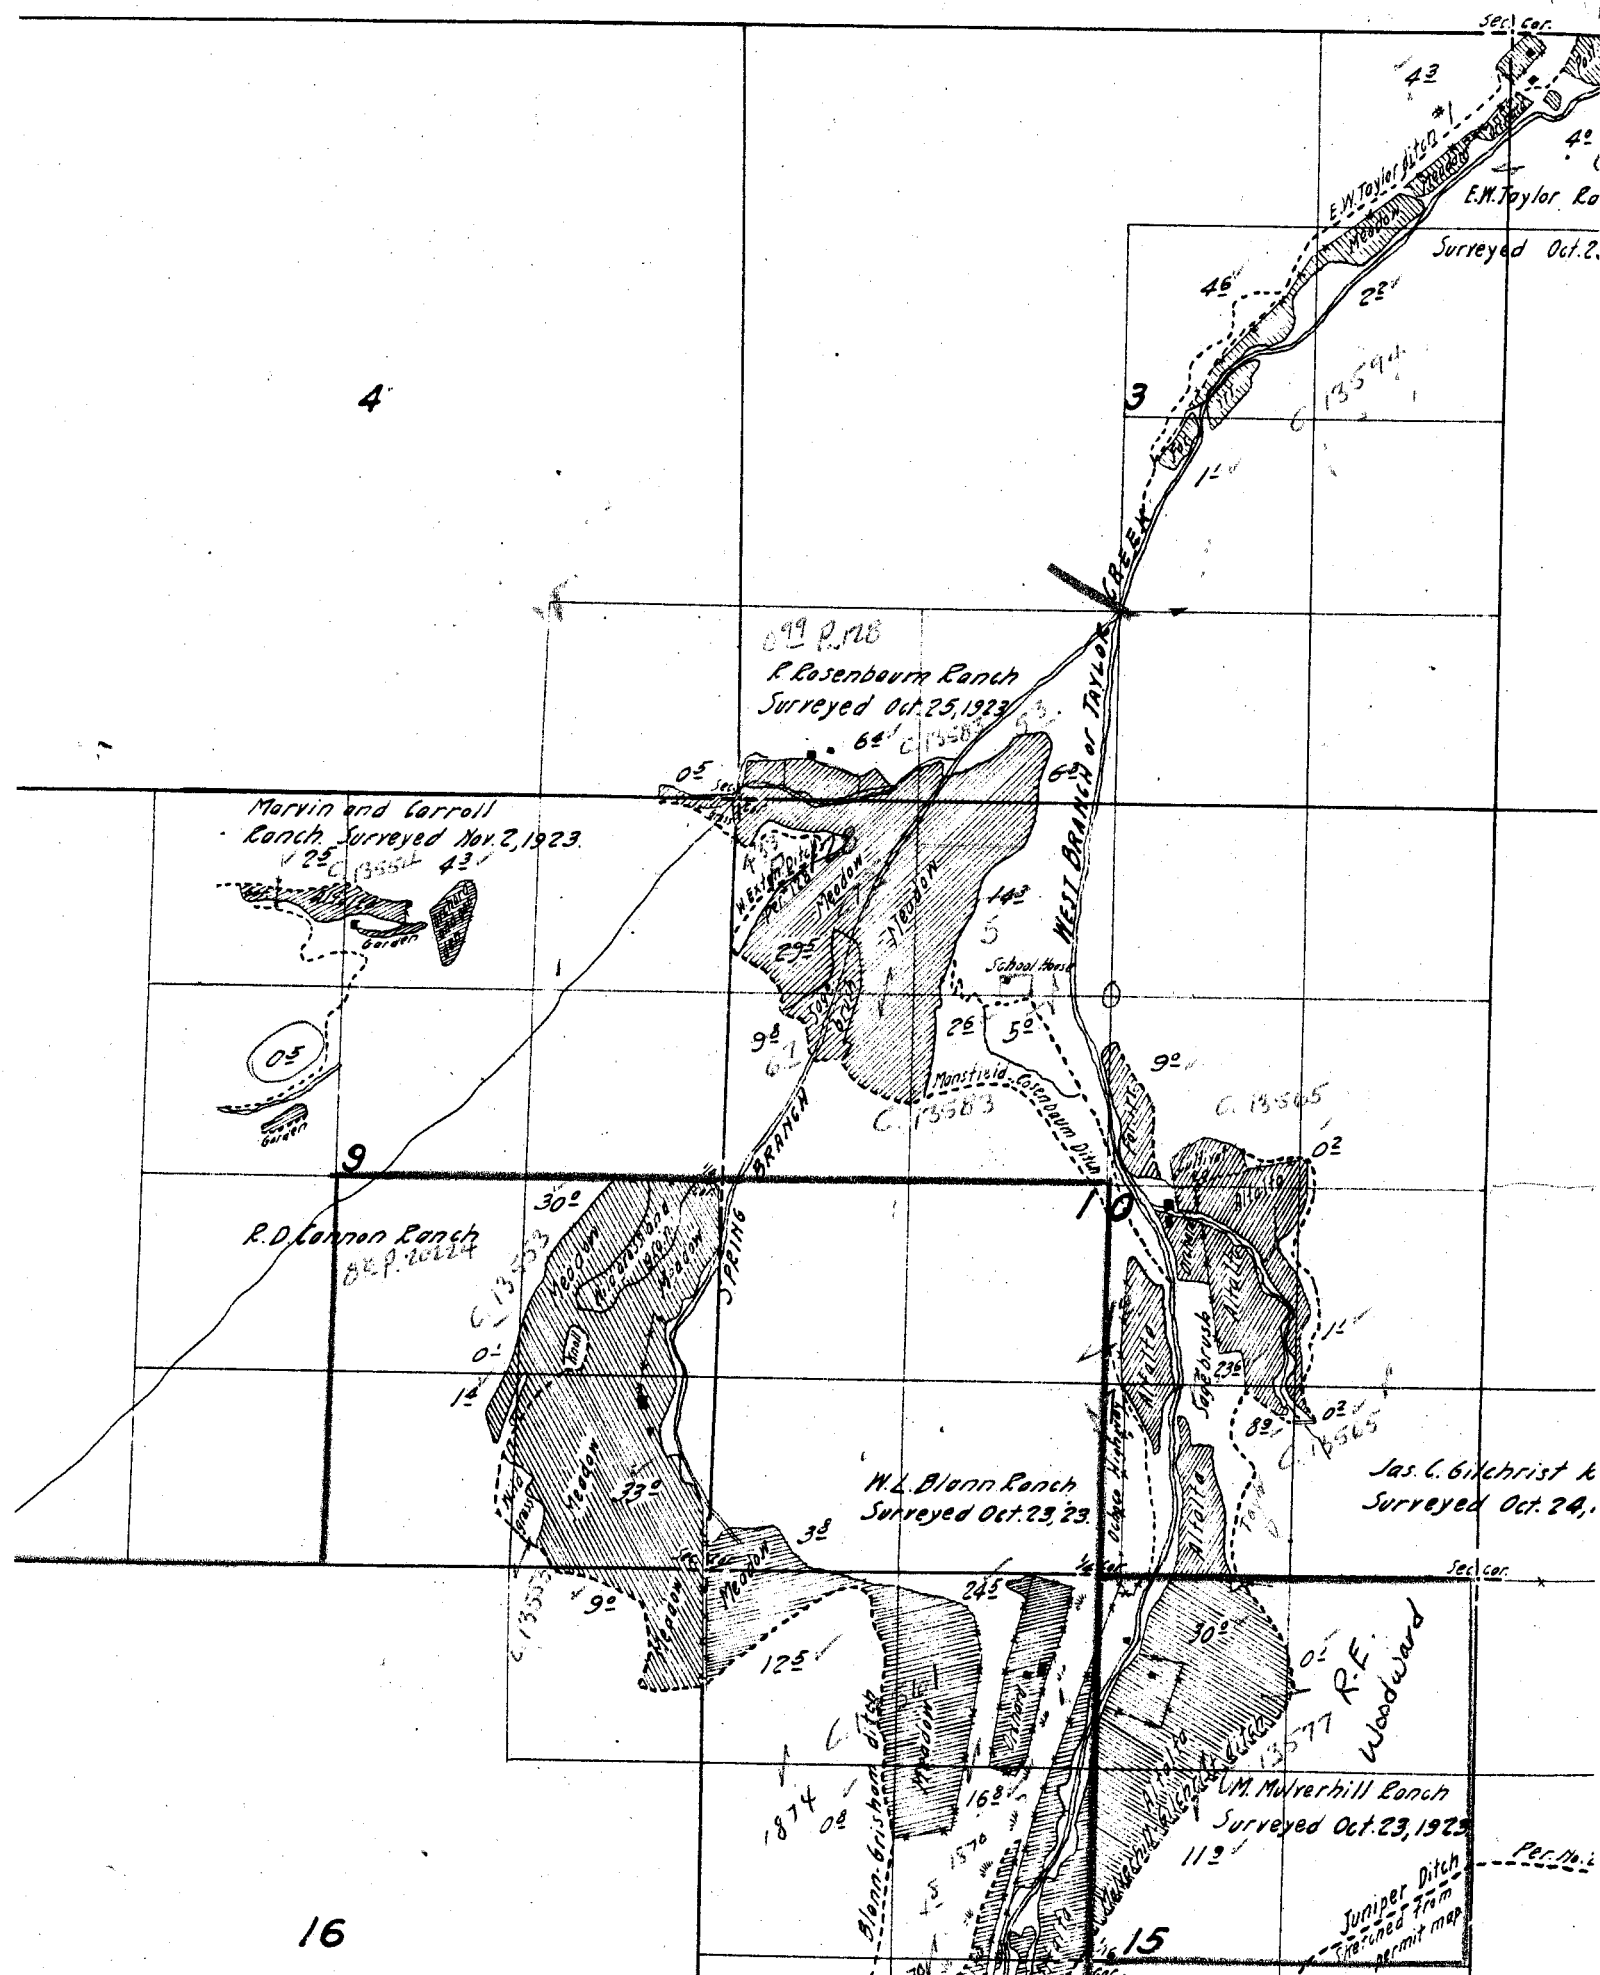

23

24

THOMPSON

26

25

*Note: - Creeks sketched in approximate location from U.S. Township plat, U.S. Forest Service map, and permit maps, except in vicinity of irrigated areas.*

35

36



*Scale of Feet.*

# Township

4

5

8

Marvin and  
Ranch Survey  
125-  
13554

9

R.D. Simpson &  
S.P.

Stephenson

Mary E. Stephenson Ranch  
Surveyed Nov 2, 1923.

Note: Location of  
creek and irriga-  
tion ditches somewhat  
approximate.

Timber 07' 7"

Timber 14'

Timber 10'

House

Timber 35'

16


12

17

65

18

61

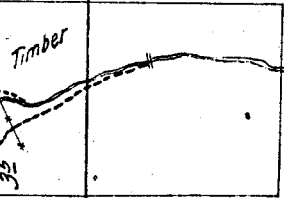

HEFLIN CREEK