


ownship

12 S,

Range

21 E.

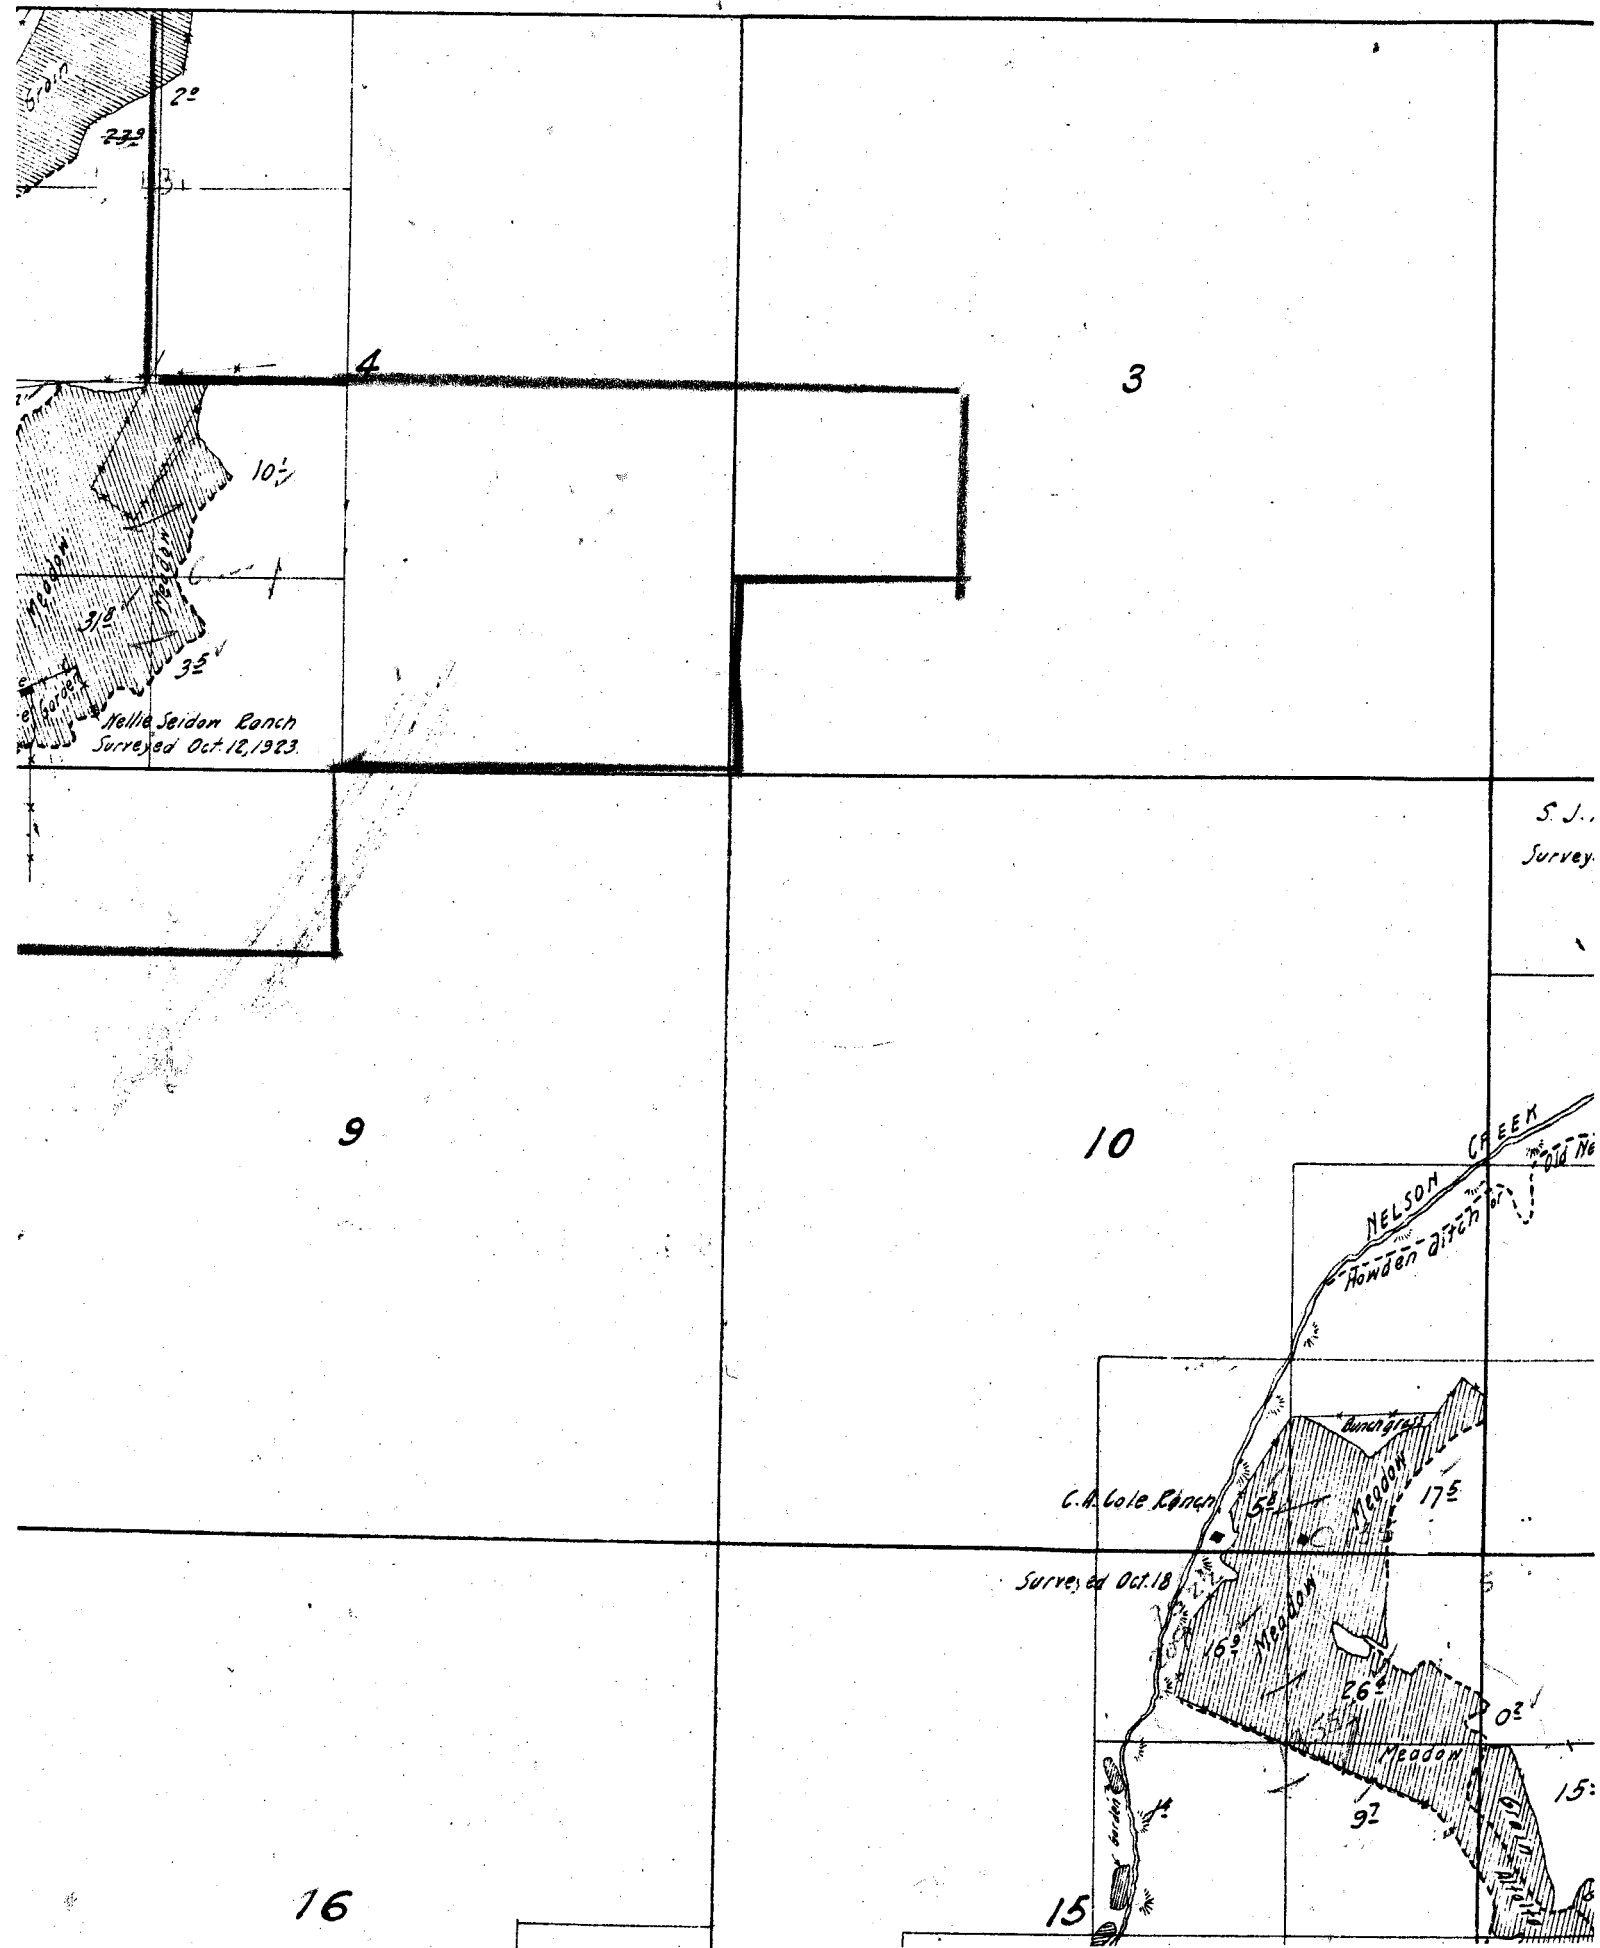

3

10

C M Dollarhide

S. J. Horden Ranch
Surveyed Oct. 19, 1923.


X. E. Hall Ranch
Surveyed Oct. 17-18, 1923


Reservoir
Surveyed Nov. 27, 1923.

Pipe line. Per. #2076.


NE 1/4 Sec. 10
Horden Ranch


C. A. Cole Ranch

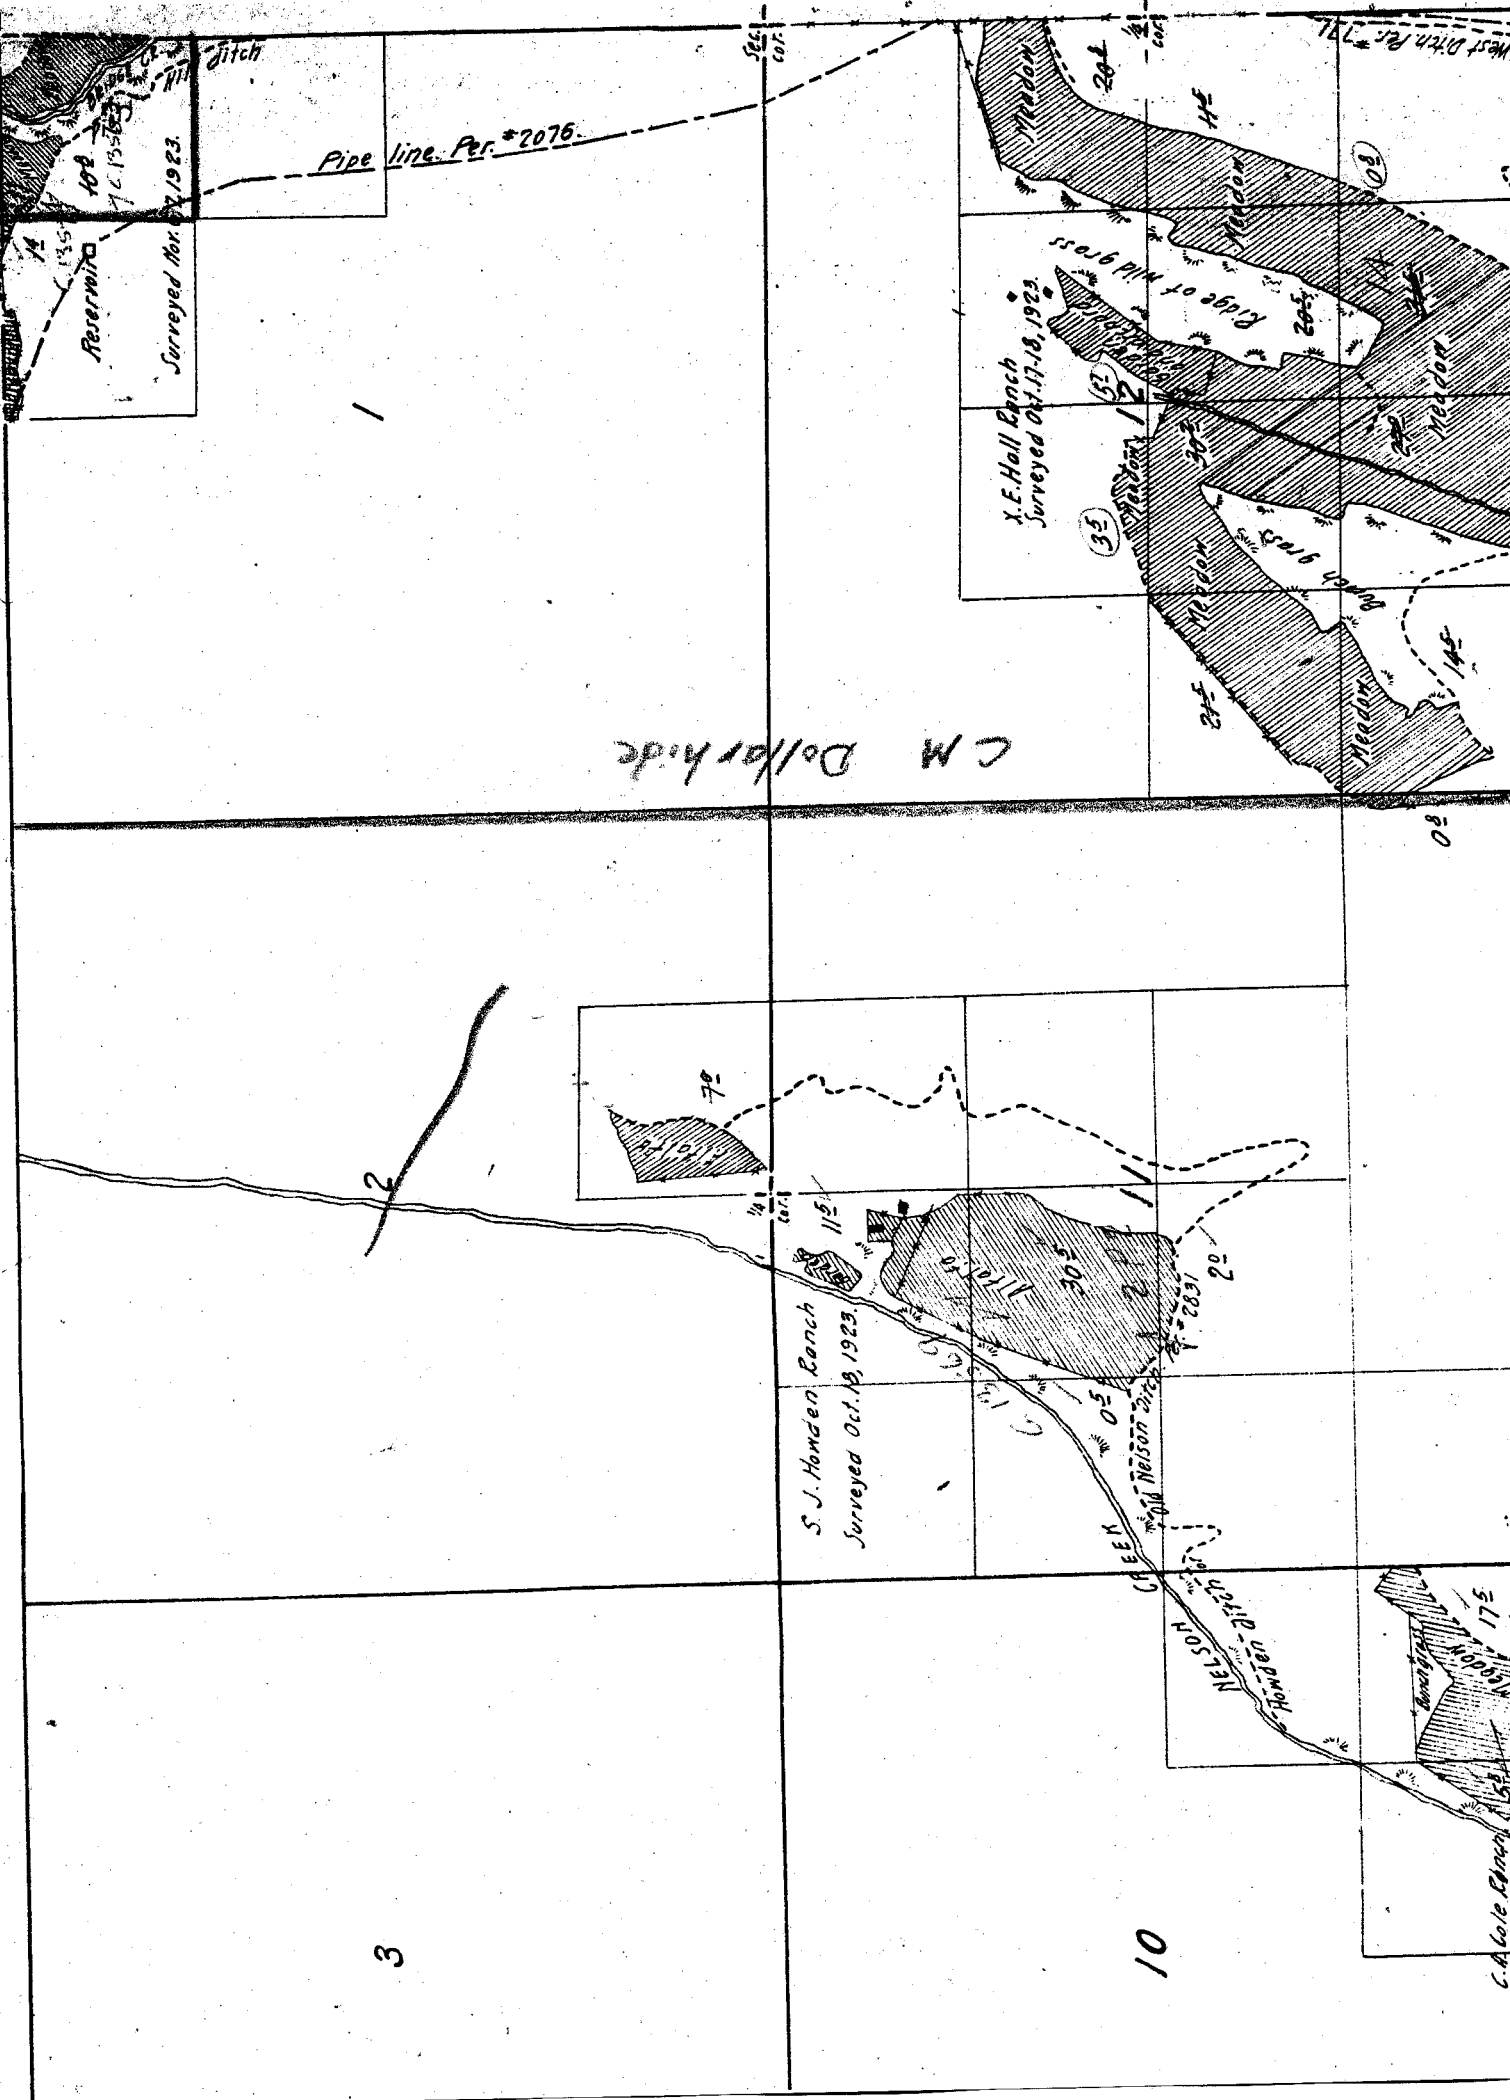

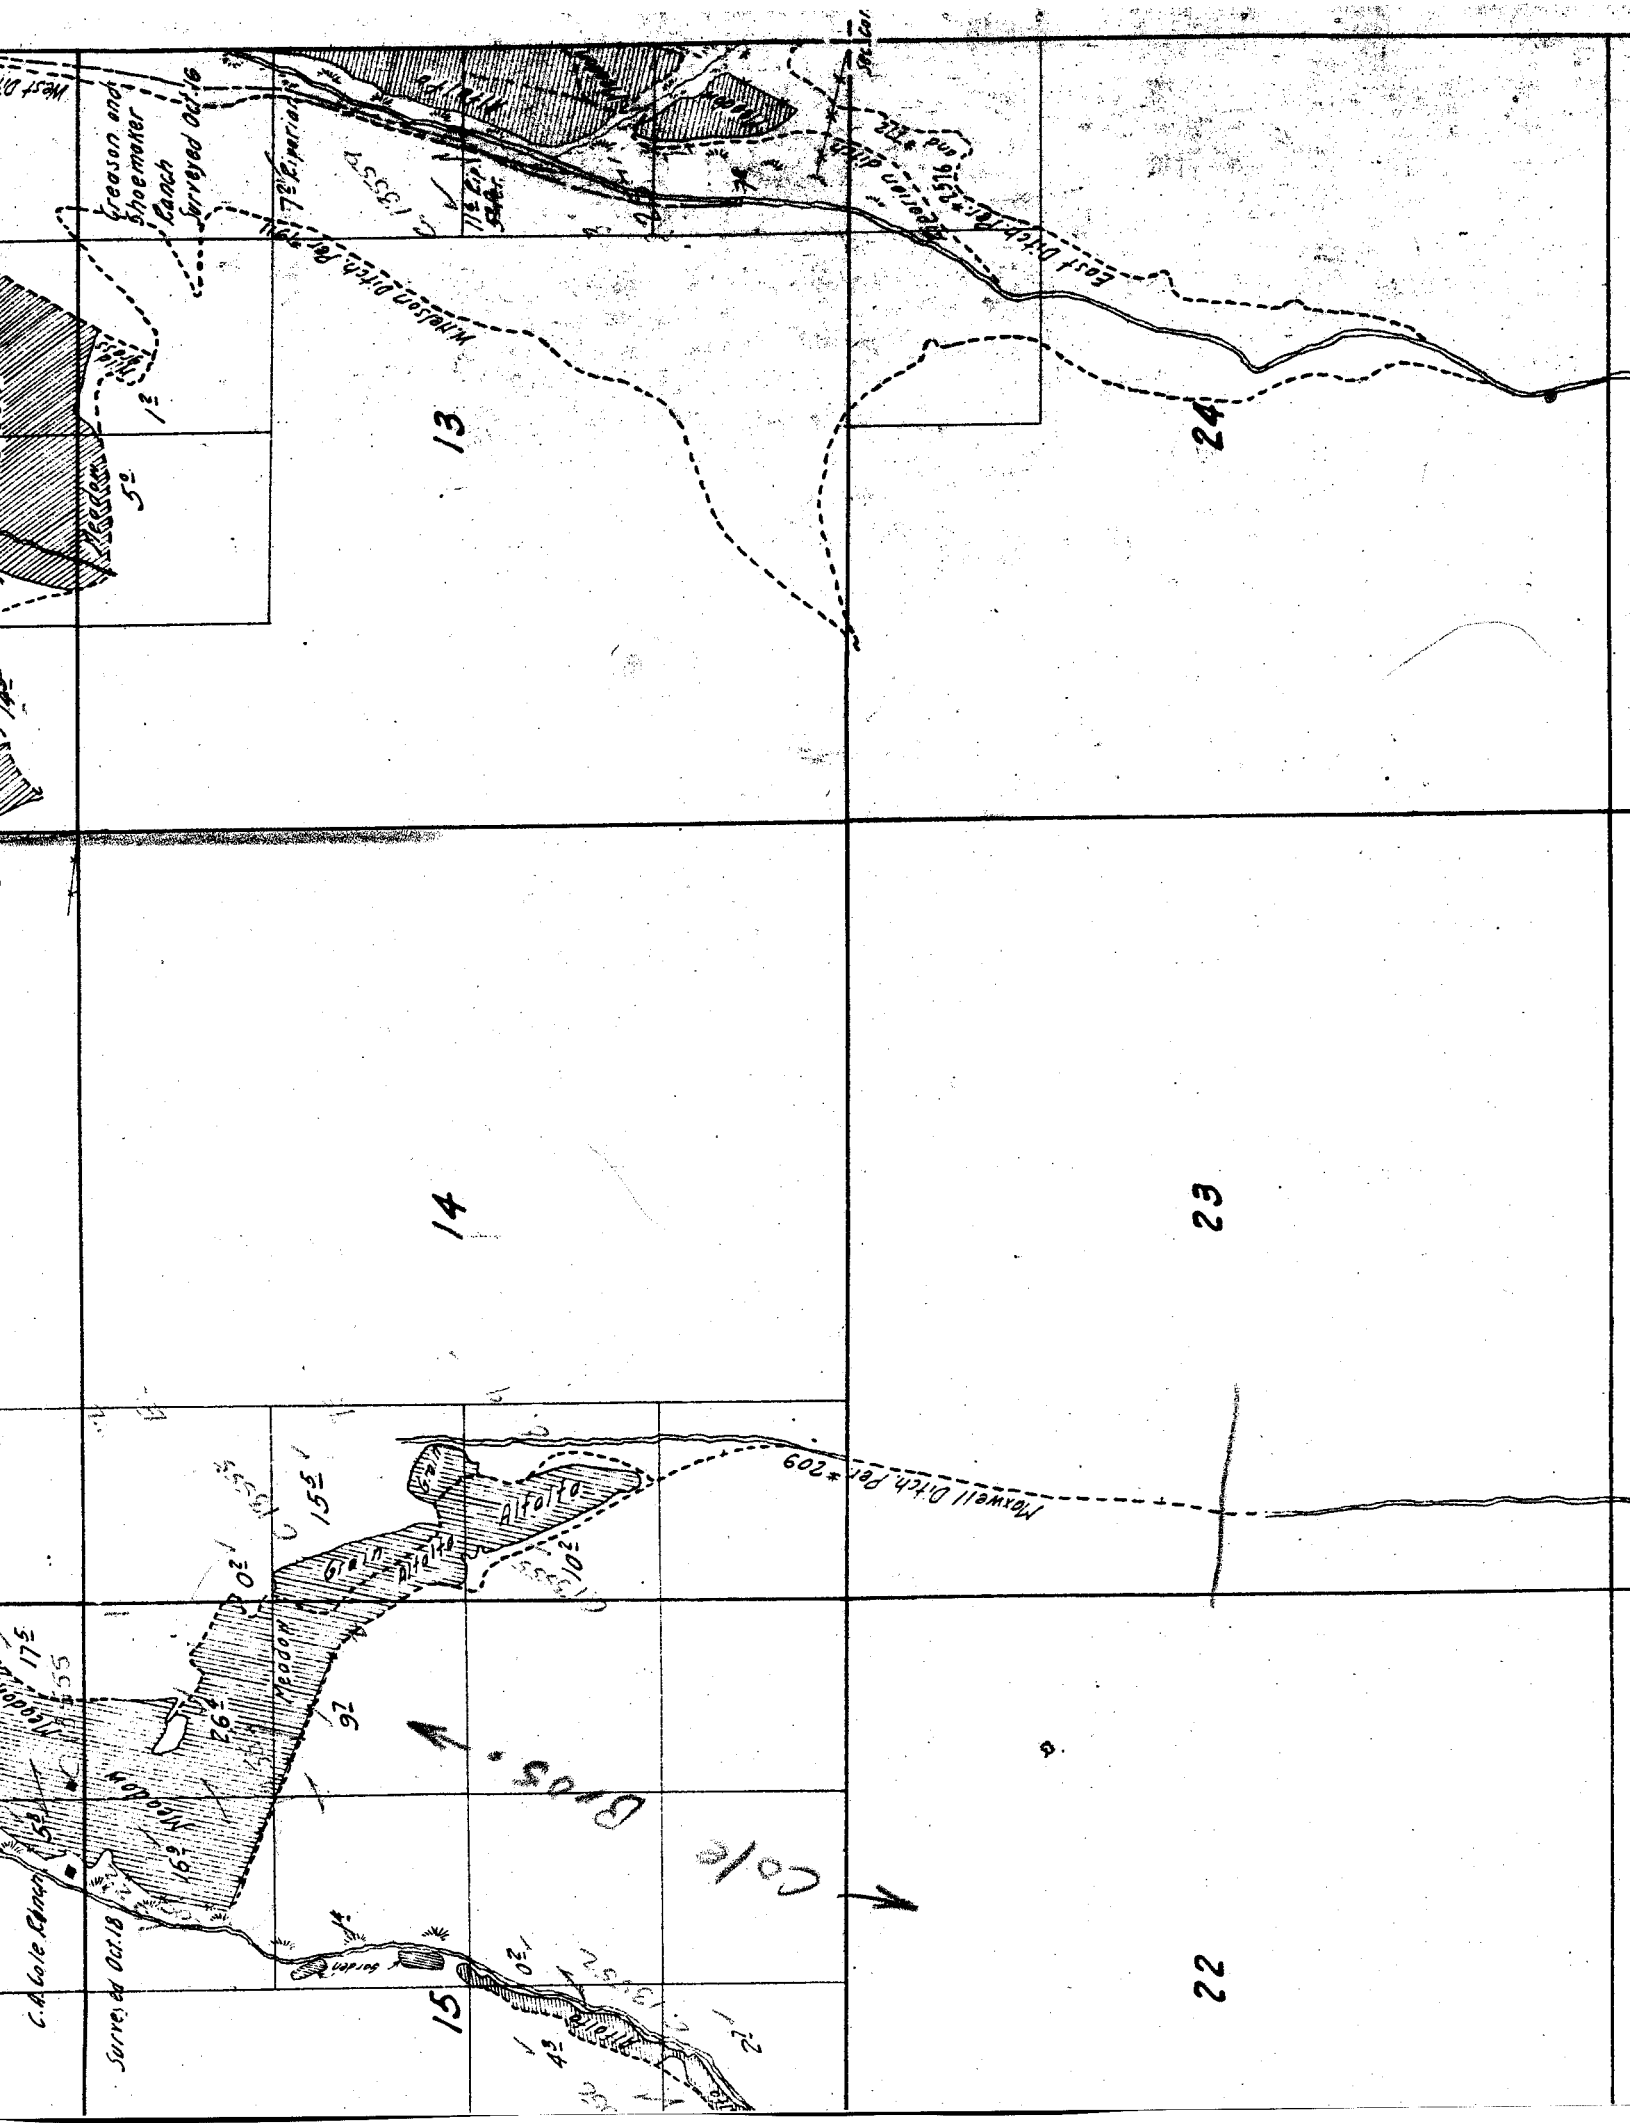

Township

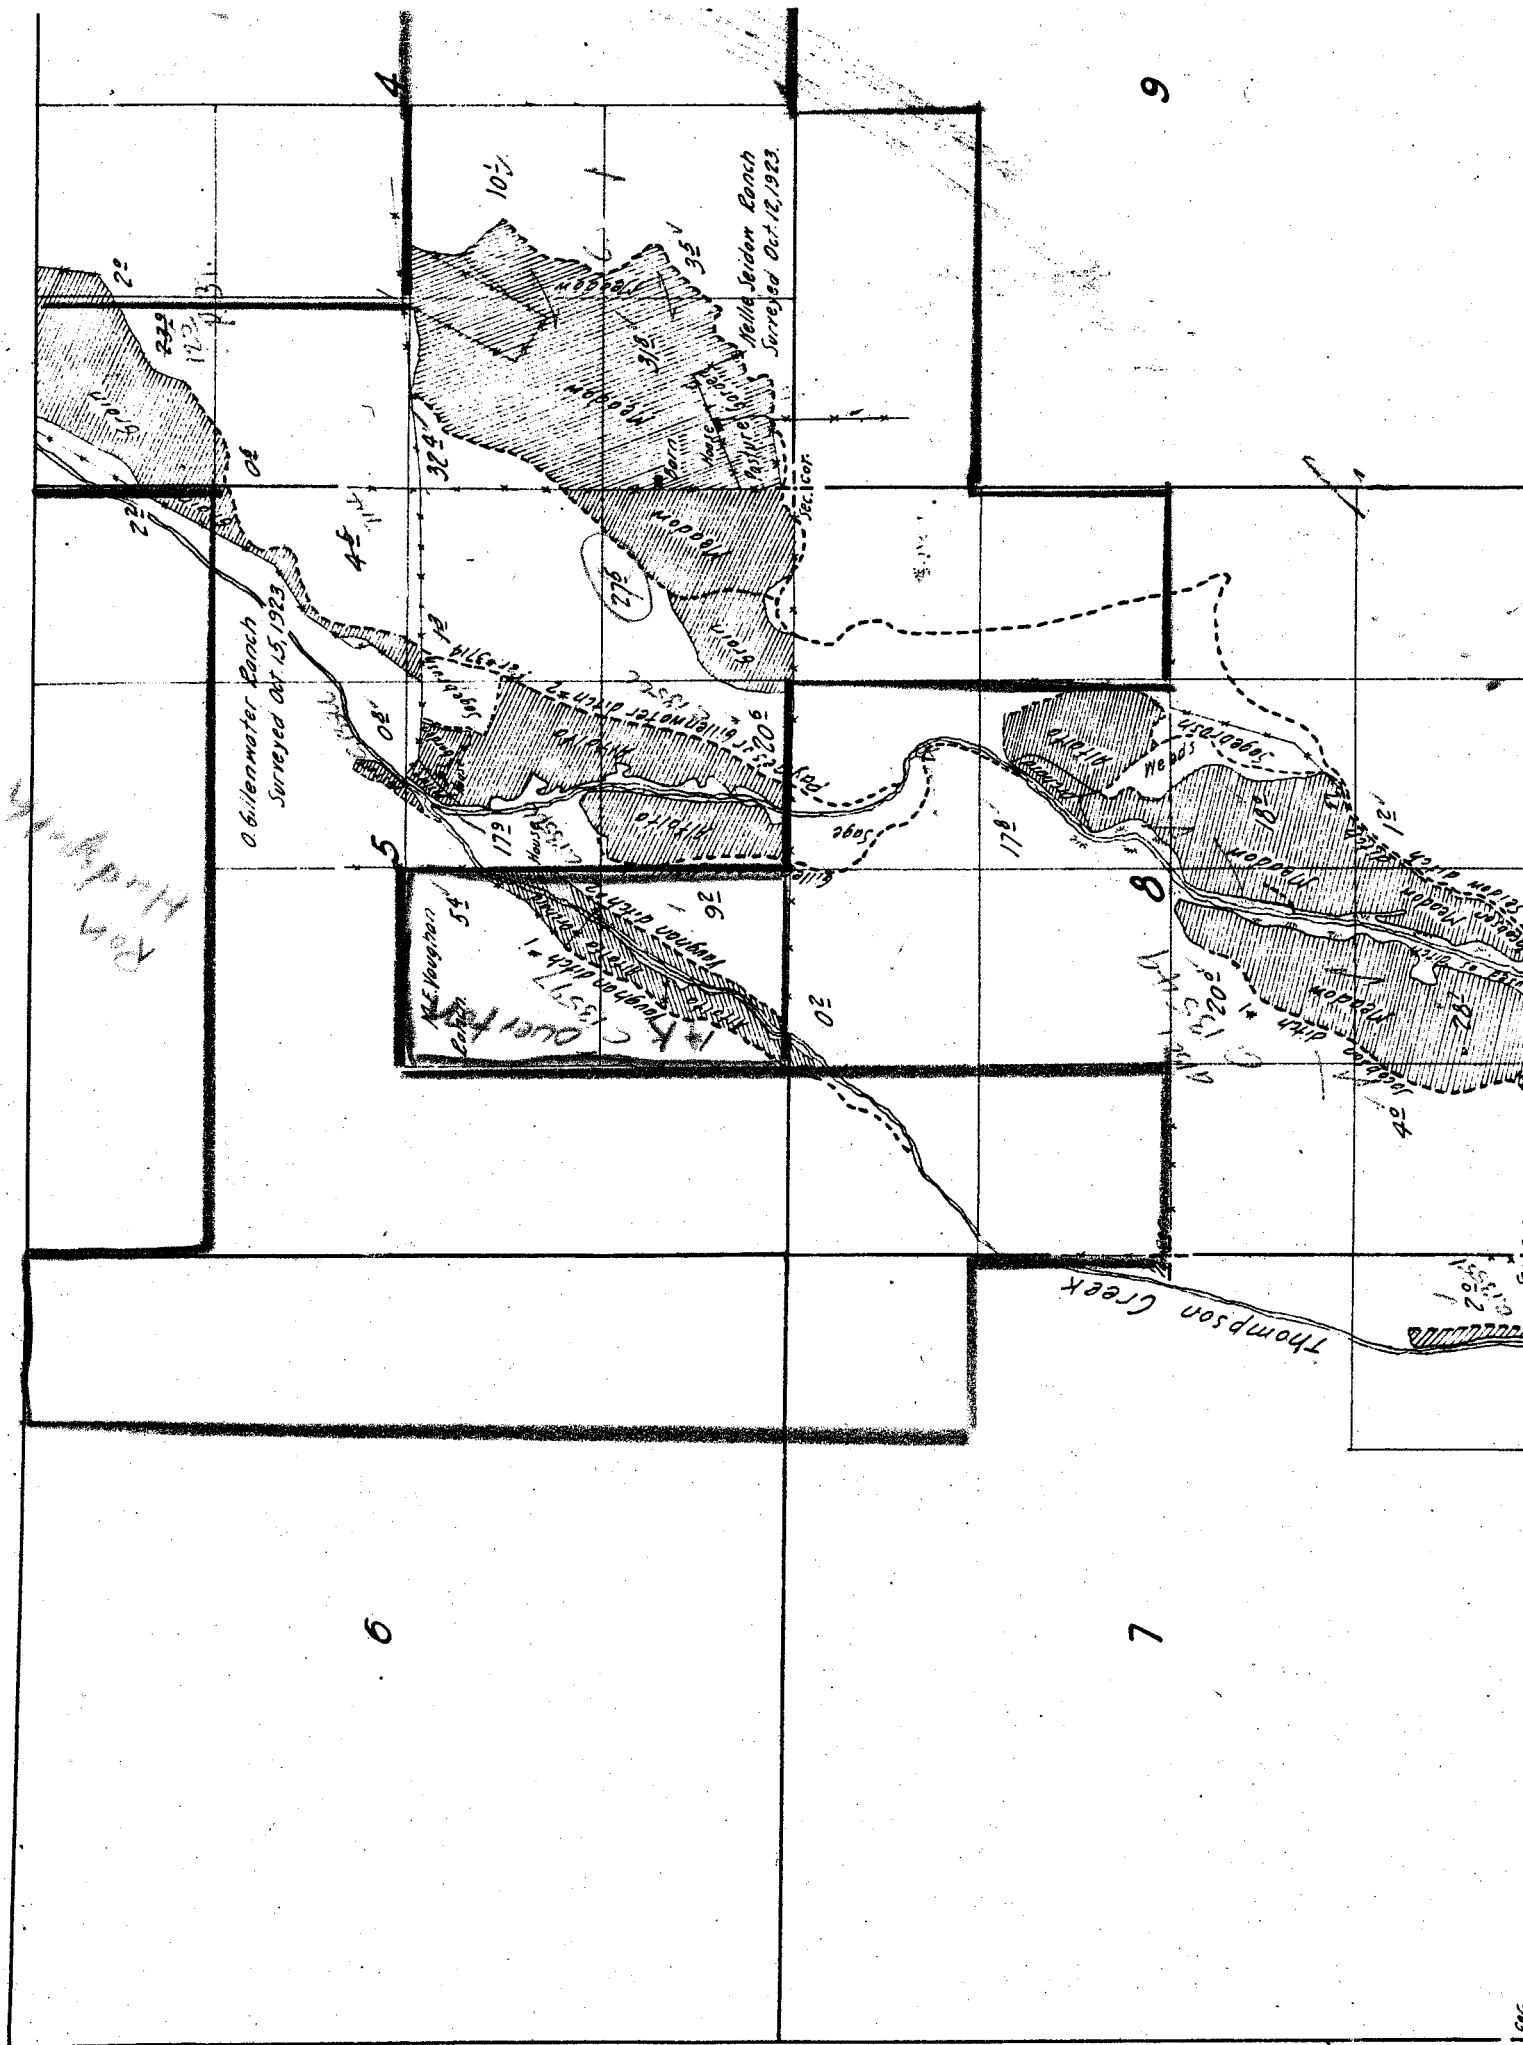

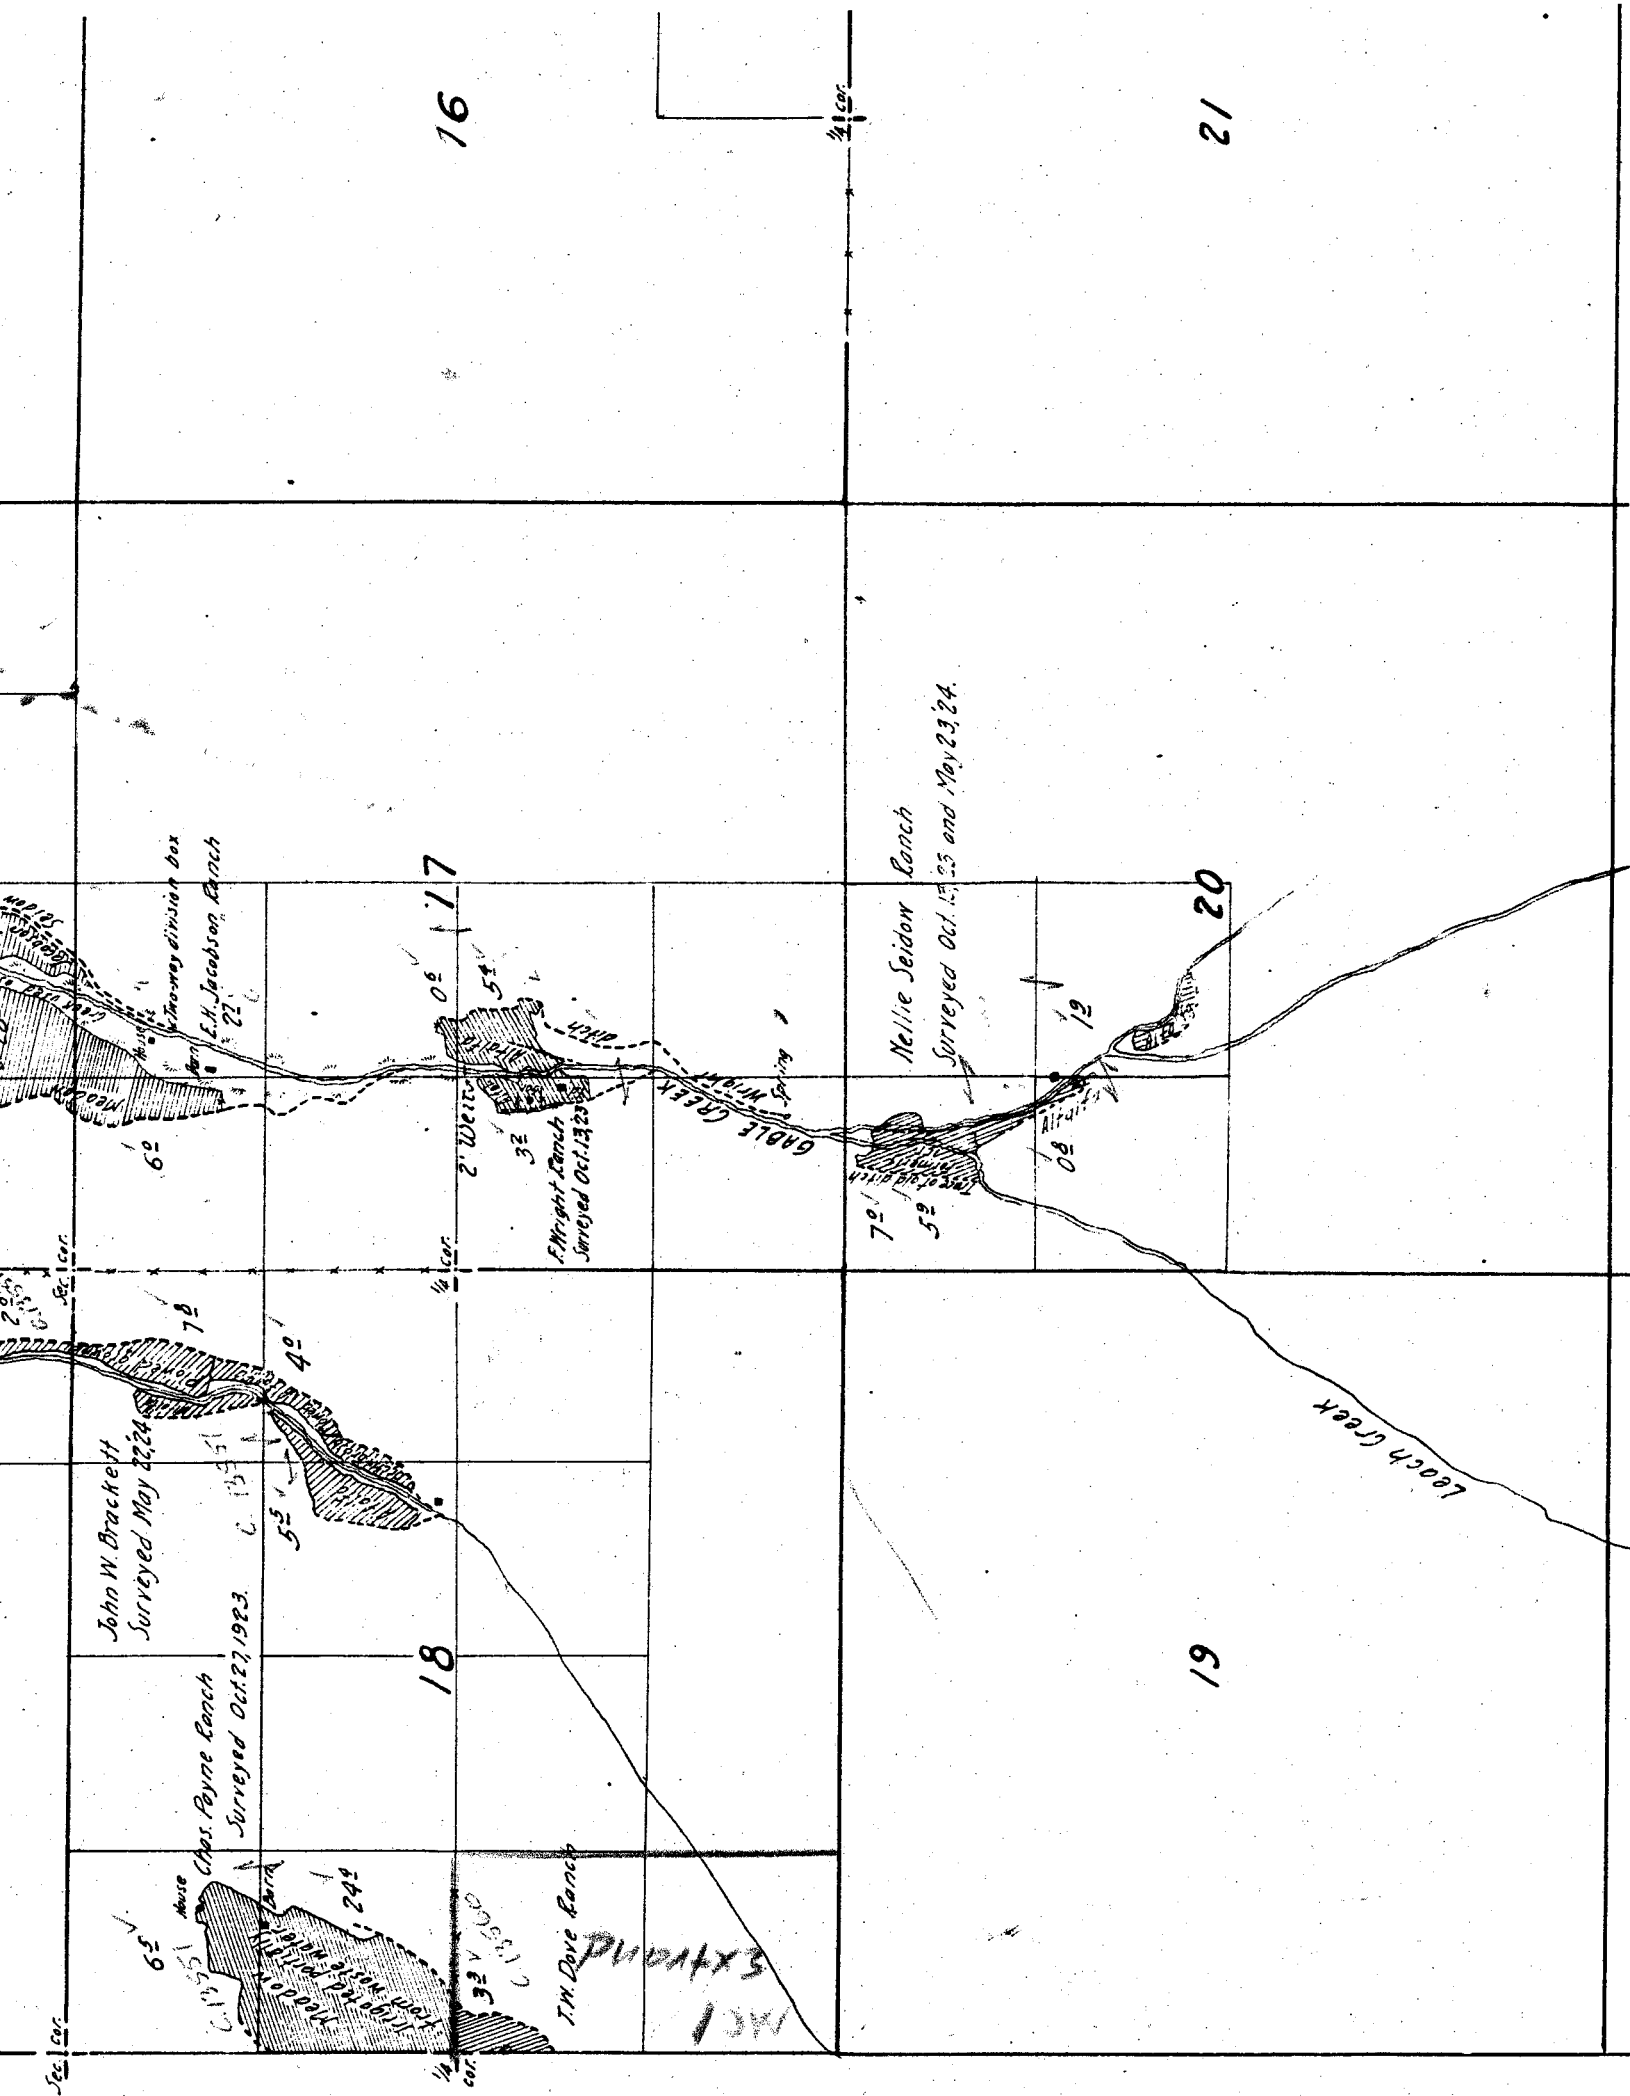

19

20


Leach Creek

30

29

31

32

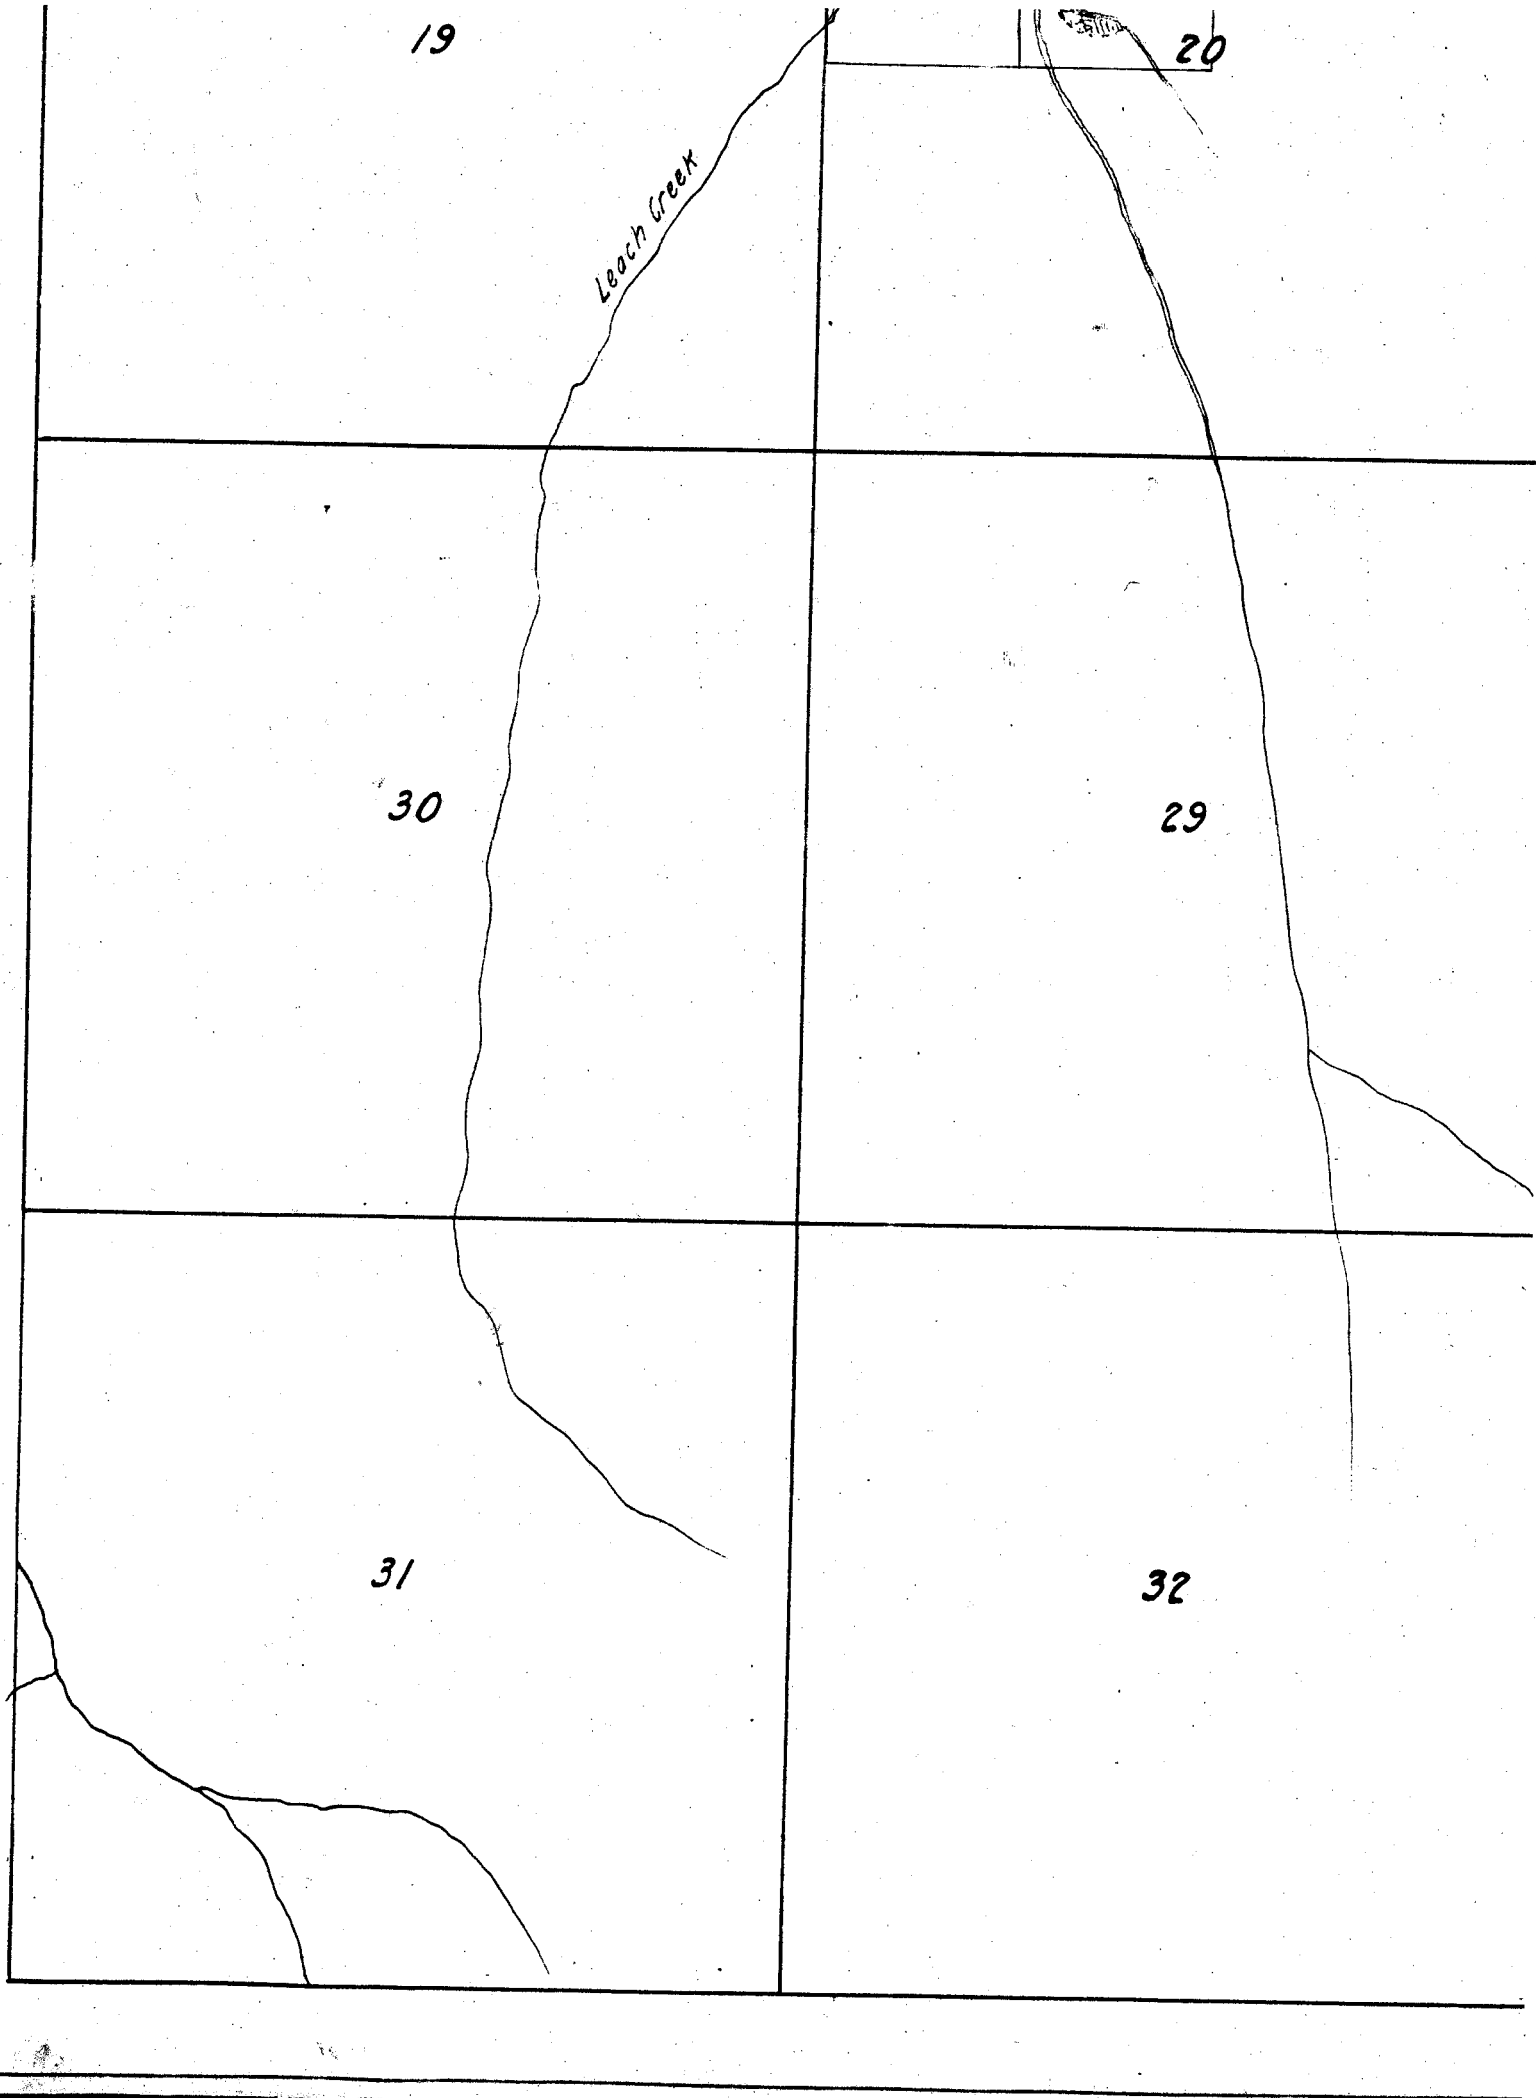

23

24

26

25

MILL CREEK

35

36

NOTE: - Creeks sketched in approximate location
from U.S. Township plats or from Forest Service
map except in vicinity of irrigated areas.
Permit ditches plotted in approximate location
from permit maps except in vicinity of irriga-
ted areas.

0 1000 2000 3000 4000 5000 6000 7000 8000

Scale of Feet.

6 M. Nelson Reservoir
Per # 462


28

27

33

34

Maxwell Creek

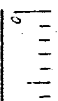


123,24

16

21

22

1/4 Cor.

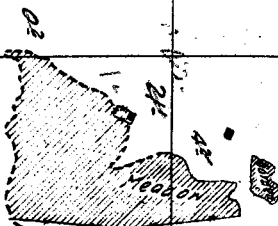


Nelson and Campbell
Bench
Surveyed Oct. 19, 1923

6 ft. Nelson ditch
Per. #4325

Cole Bros.

Surveyed Oct. 18

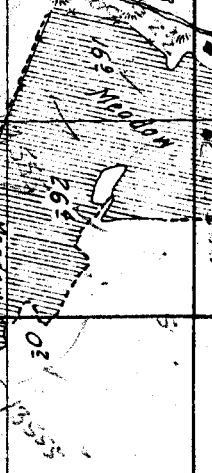

Maxwell Ditch Per. #209