


JOHN DAY RIVER

54 2000 04 53 172
From John Day 127 01

32
P 24769

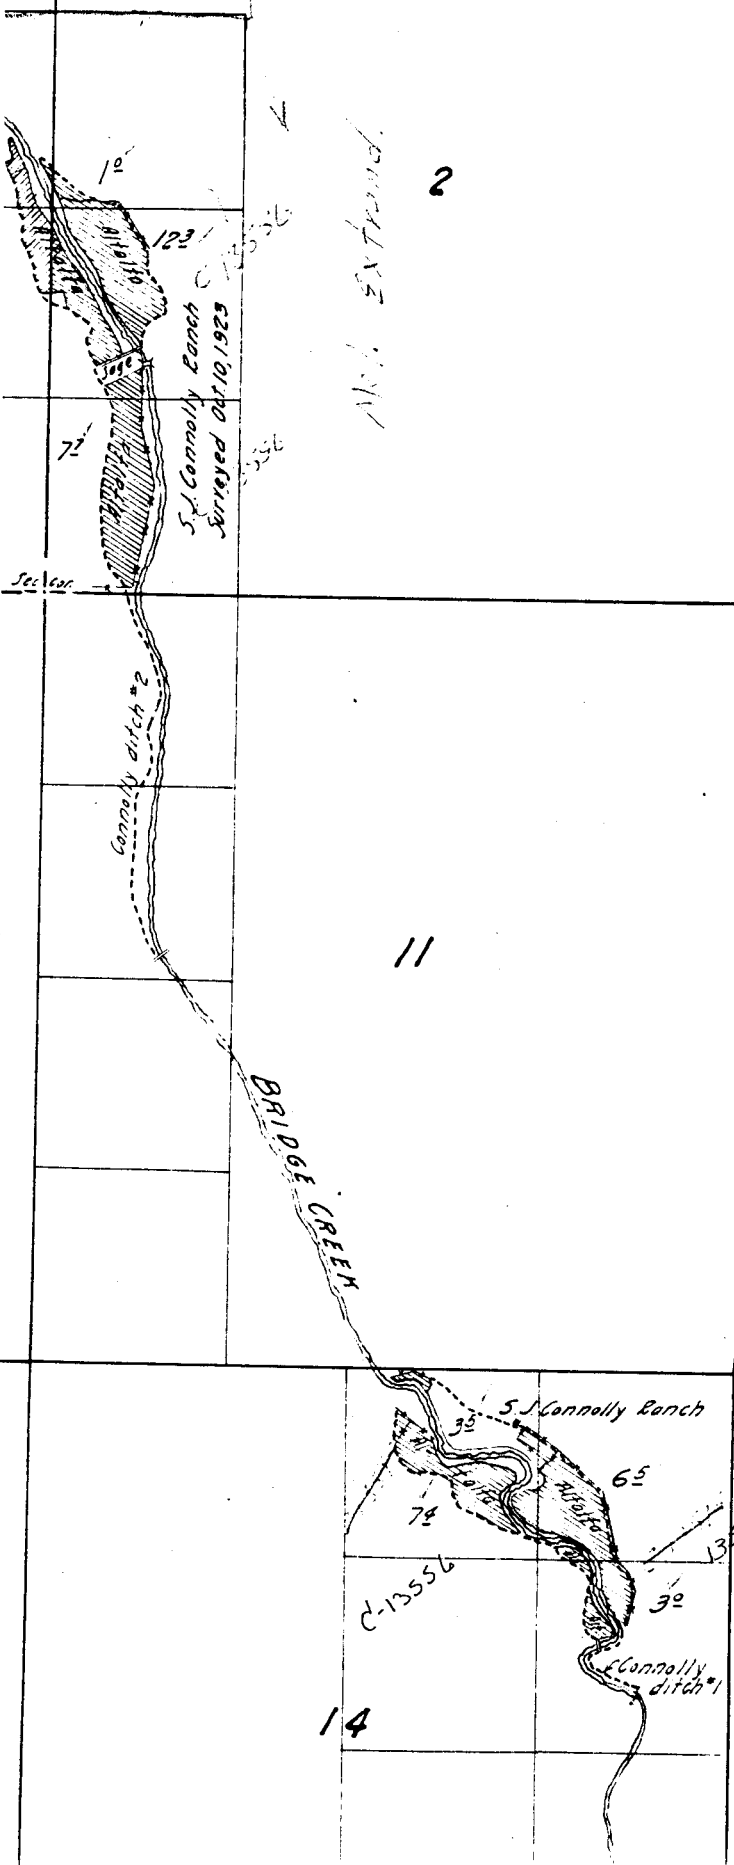

2

1

11

12

14

13


W. EXTEND.

Township


10 S,

Range

20 E.

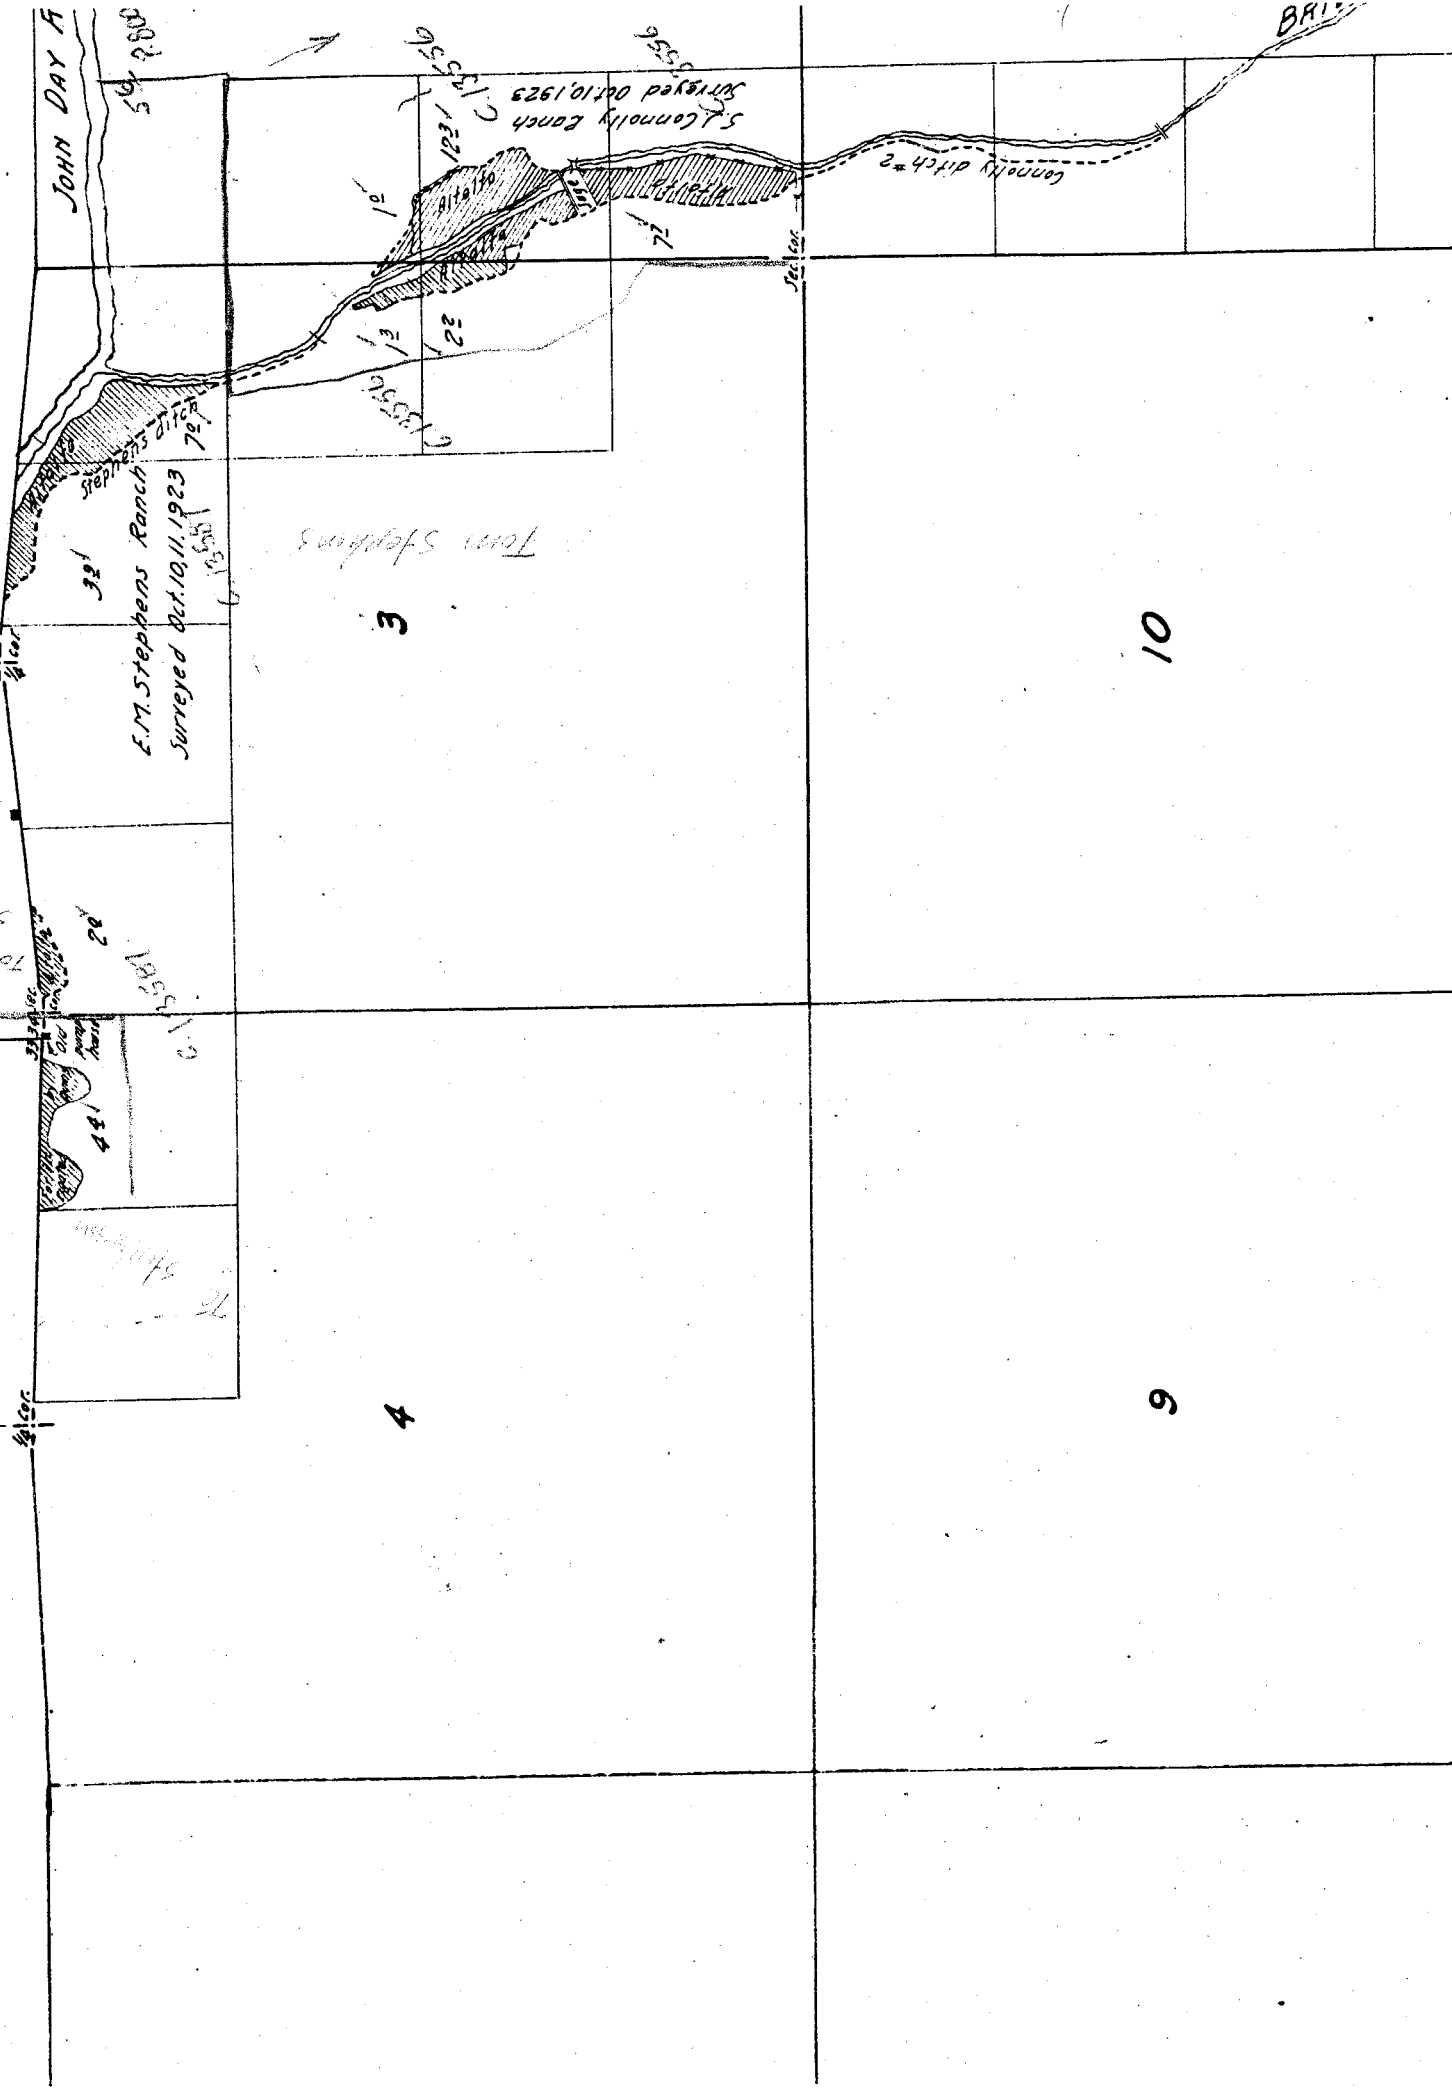

Township

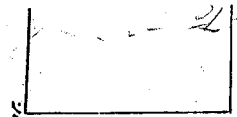

1/4 Sec

4

9

5

8

6

7

16


12

17

20

18

61

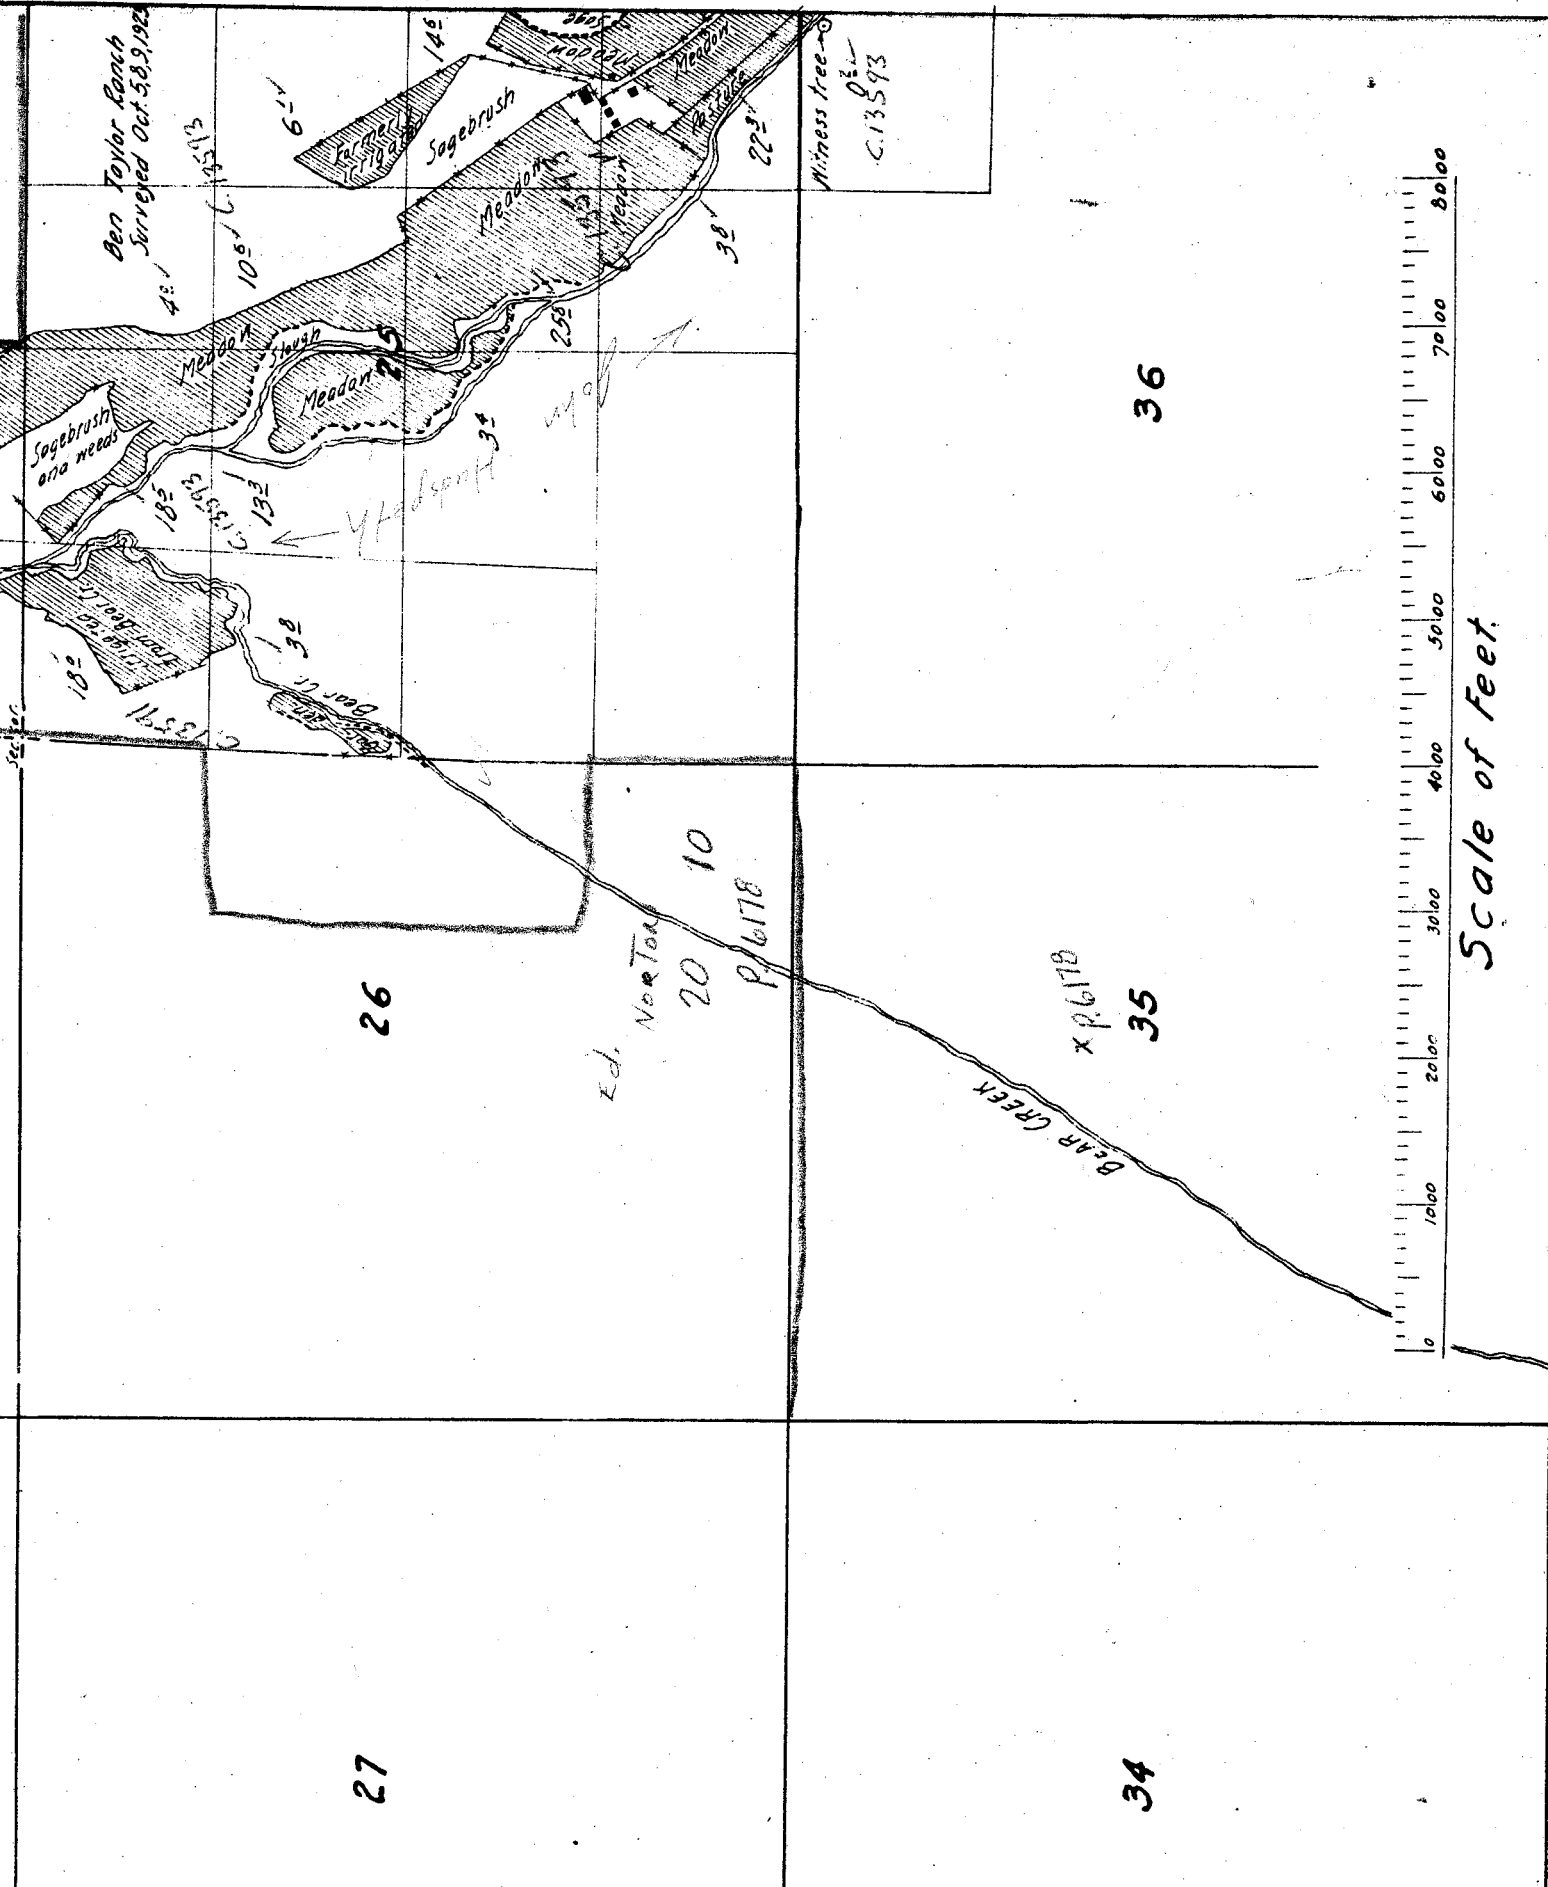

27

26

34

35

36

13

Mei
EXTRON

24

23

22

5. Cannolly Ranch

65

C-13556

14

15

Cannolly ditch

C-13575

69

C-13575

John Manning Ranch
Surveyed Oct. 9, 1929. 1929


C-13575

Sagebrush
Meadow

C-13575

C-13575

Section

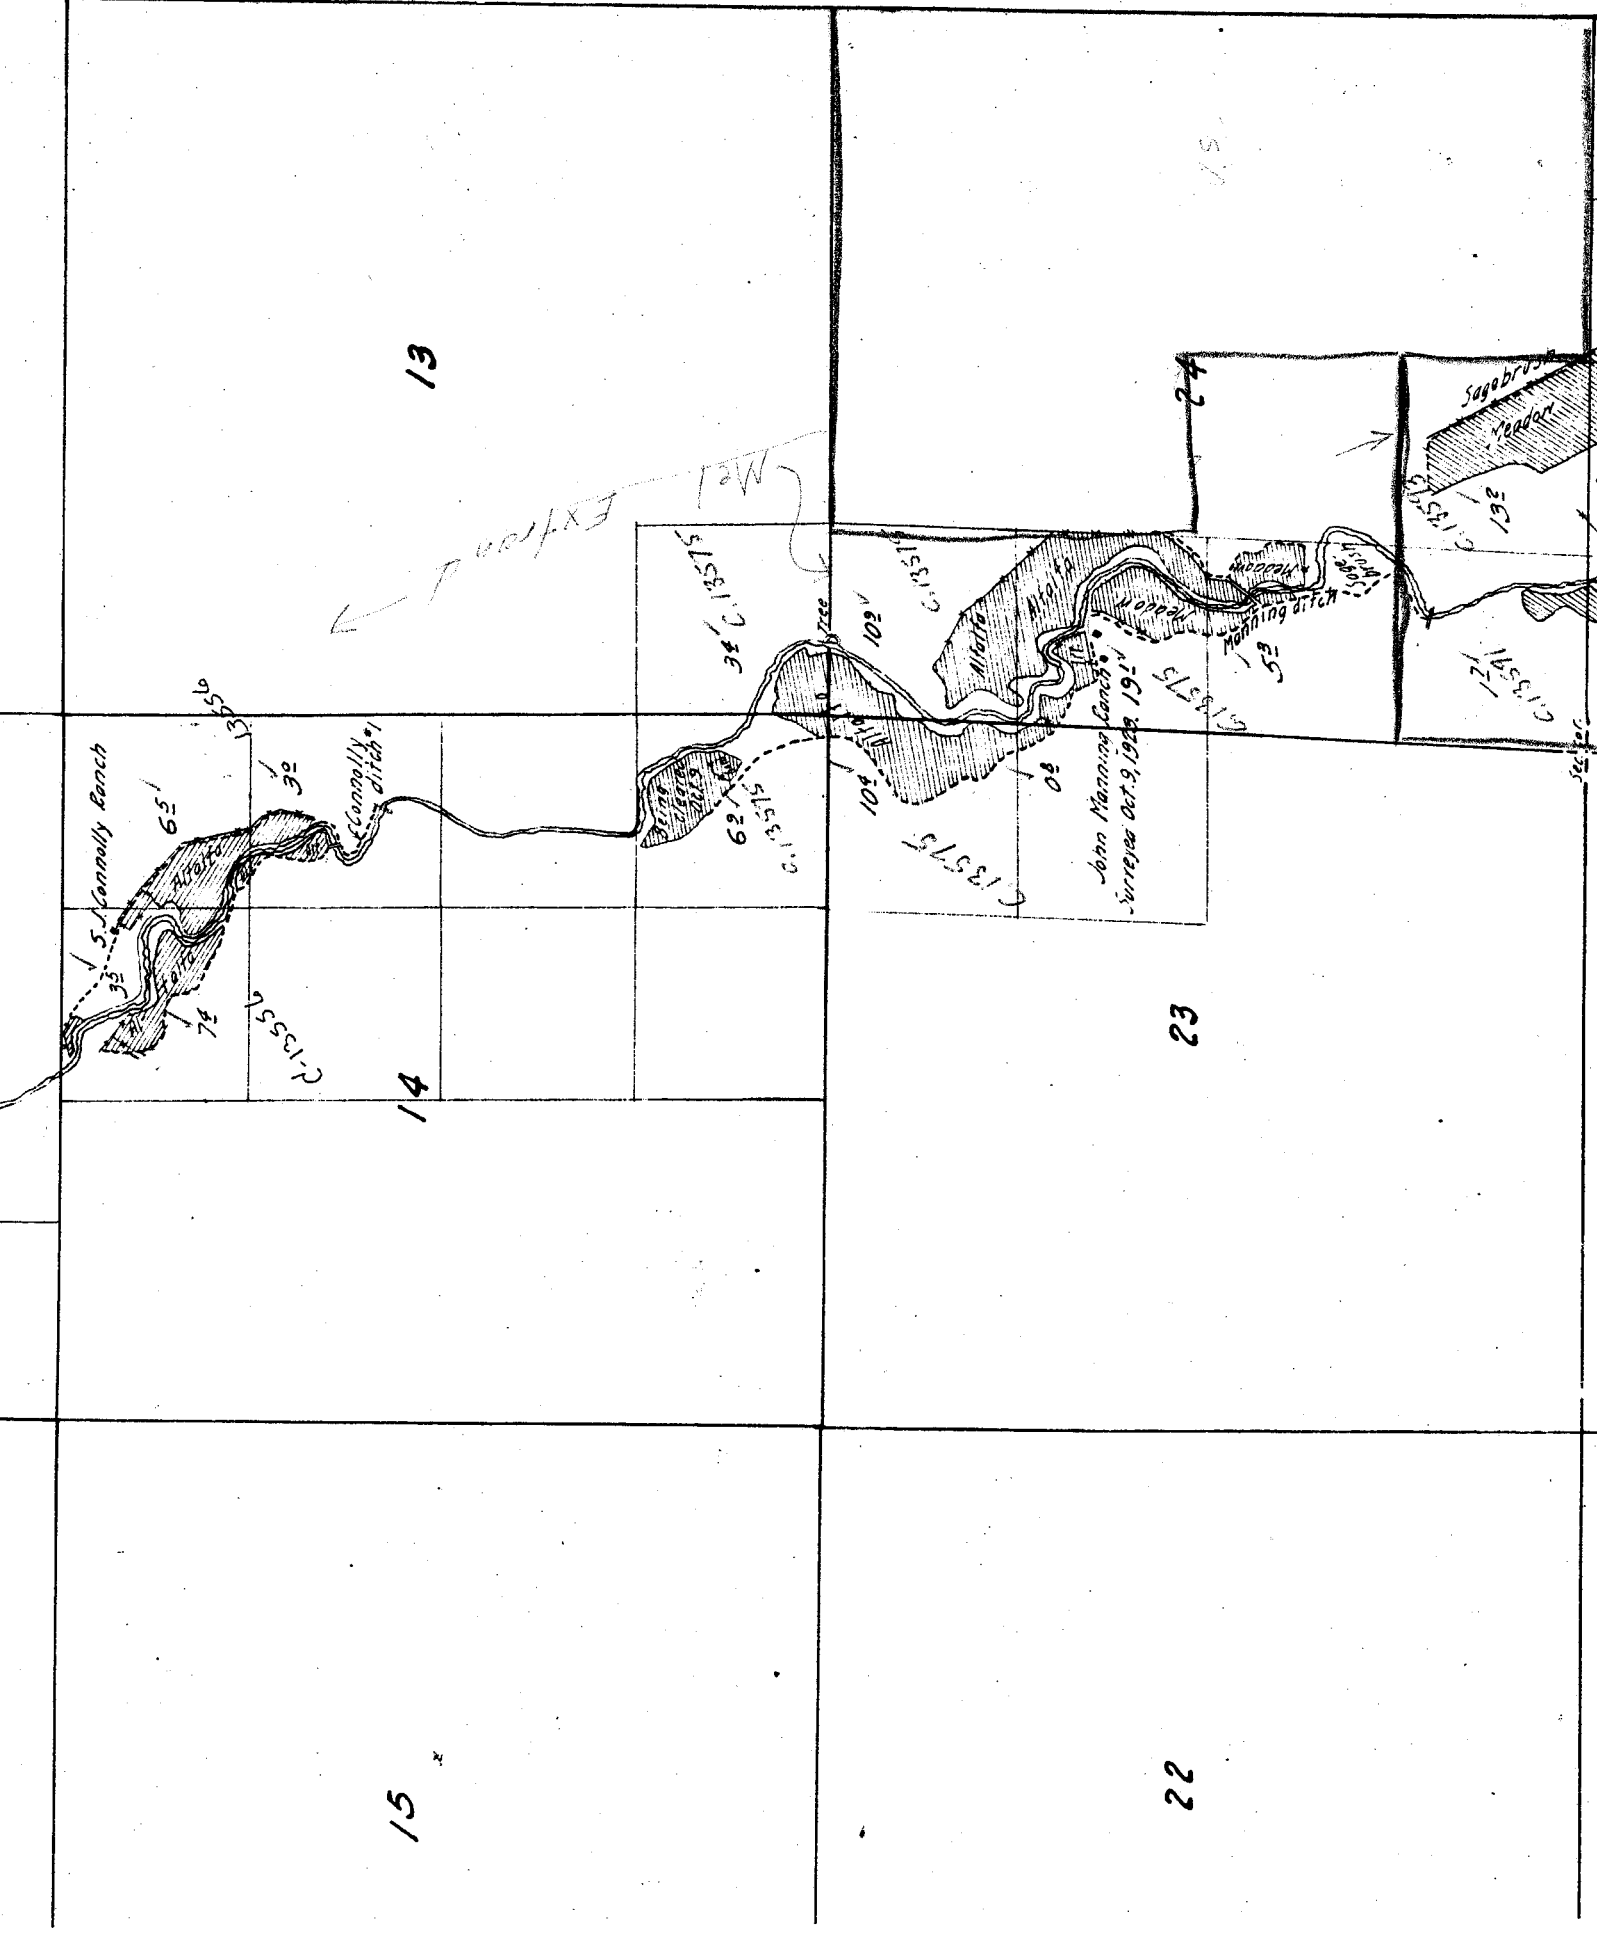

30

29

28

31

32

33

16

15

21

22

28

27

33

34

