

23


24

26

25

35

36

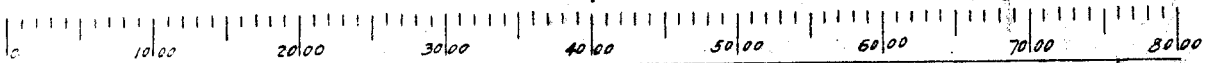

Scale of Feet.

26" x 27"

Cr. on Quad maps

Johnson

CREEK

HIDGE

URRO

STEAD








Greason and Shoemaker Ranch

Surveyed Oct. 16, 17, 20

05

18

17

16

4-

230

85

15

15

15

15

11

11

15

15

15

15

1555

0-1

1-1



















Surveyed Oct. 20, 1923.

12

12

1555

15

15

1555

15

15

20

61

1555

15

15

21

WOOD CAMP CREEK

19

20

30


29

31

32

ownship 12 S, Range 22 E.

12
613558
Shoemaker Ranch

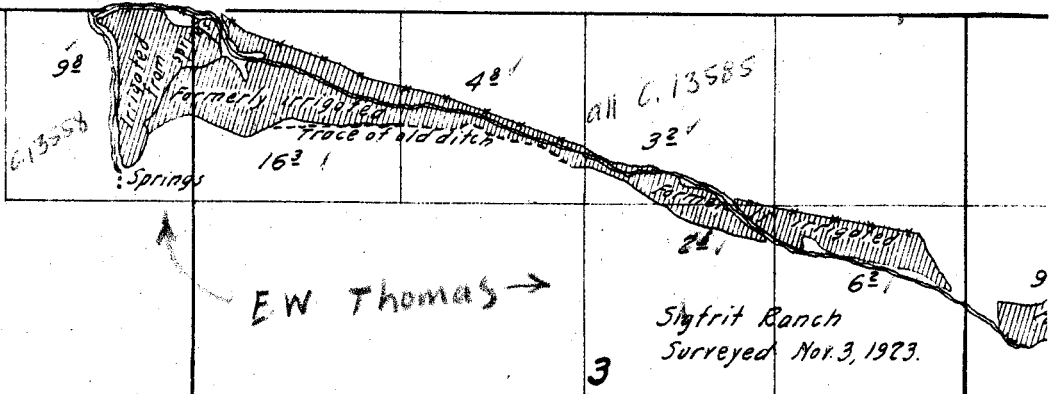

E.W. Thomas →

4

9

10

16

15

15


14

13

22

23

24

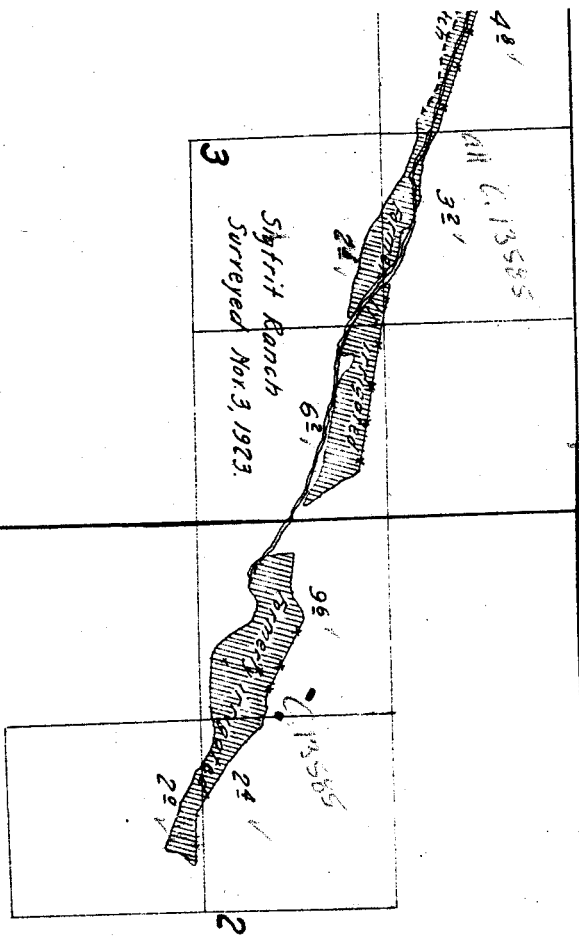


28

27

33


34

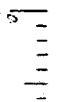

16

15

Surveyed Oct 20, 1923.

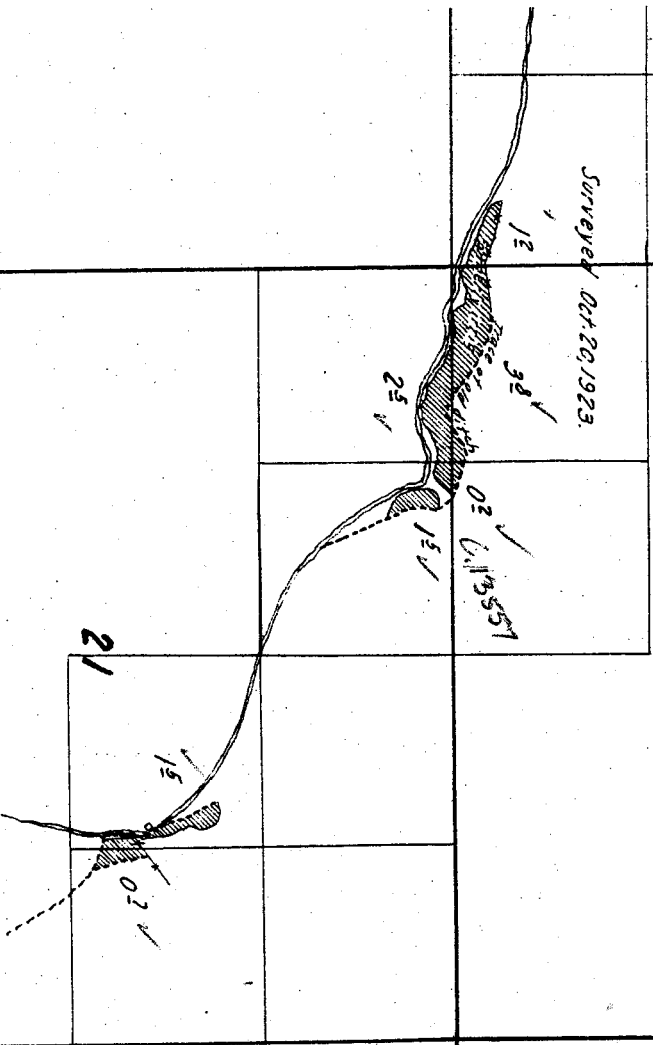

22