

Cr. on Quad maps

Johnson
CRIDGE
CREEK



Greason and Shoemaker Ranch
 Surveyed Oct. 16, 17, 20
 05
 06
East Side Ditch

16

17

18

Surveyed Oct. 20, 1923.


WOOD CAMP CREEK

12

20

61

Township 1

Creason and Shoemaker Ranch

4

5


8

9

6

7

X.E. Hall Ranch
Surveyed Nov. 6, 1923.

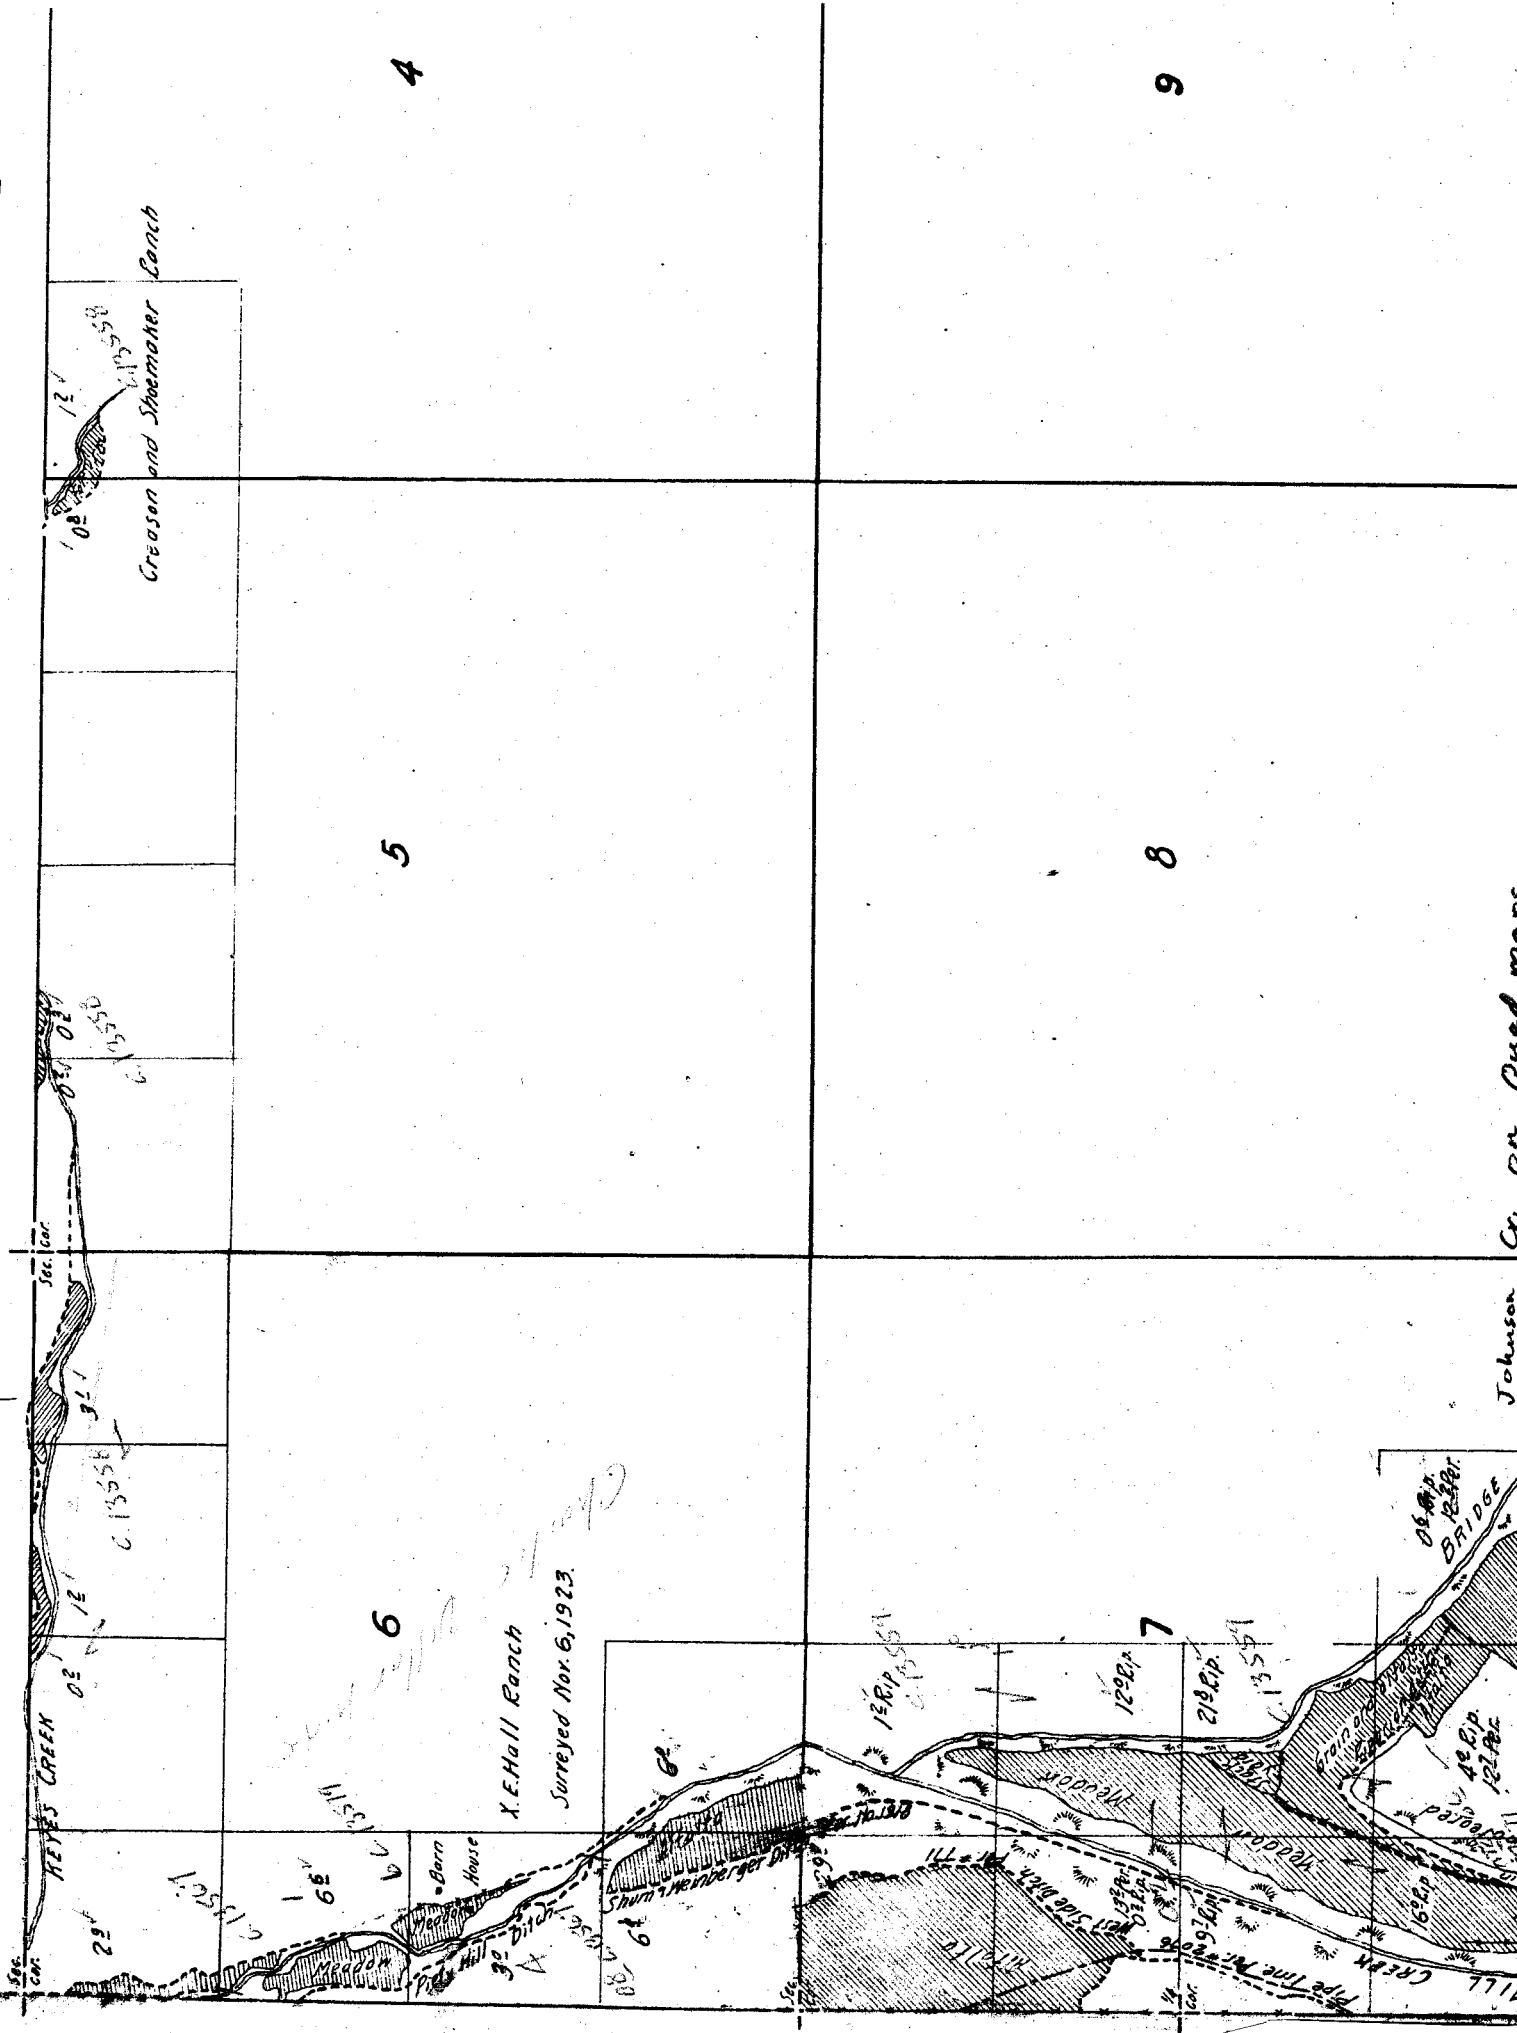

Johnson

MILL CREEK
FIRE TIME CREEK
MEADOW
BRIDGE
OLD BRIDGE

28

27

33

34




16

15


22

21

Surveyed Oct 20, 1923.

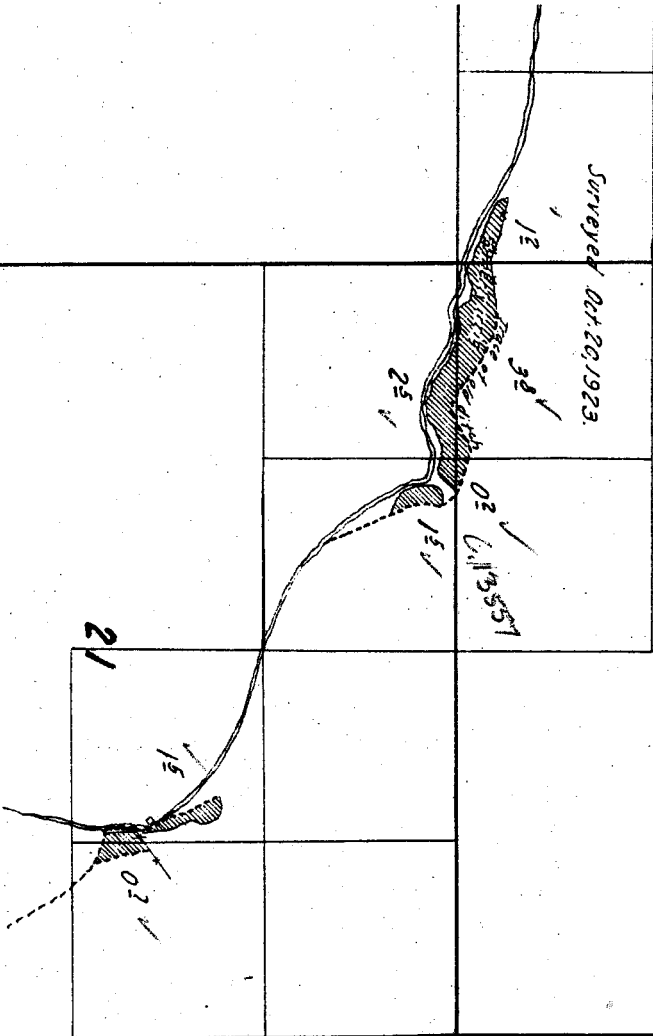

Range 22 E. 11-1-1

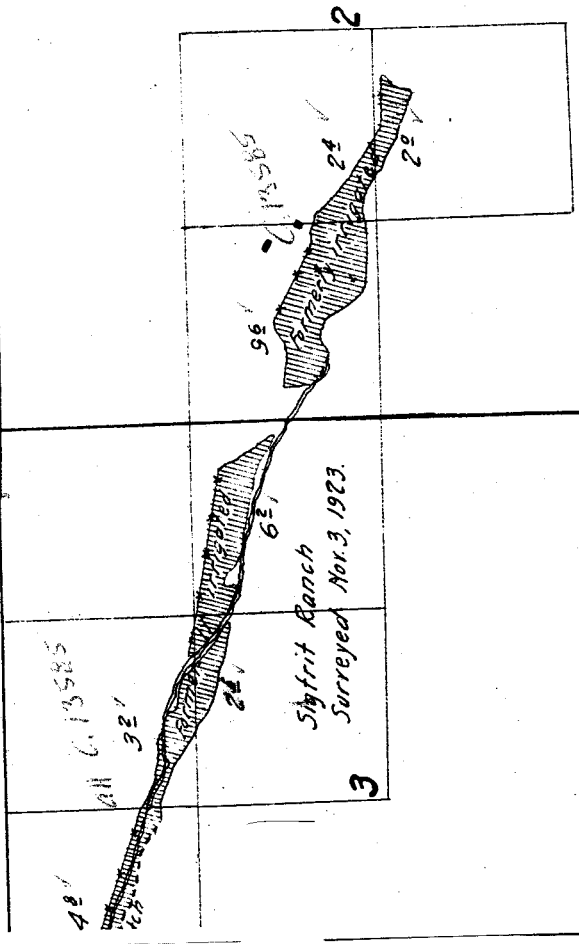

12

11

10

13

24


14

23

15

22

12
C. 13558
Shoemaker Ranch

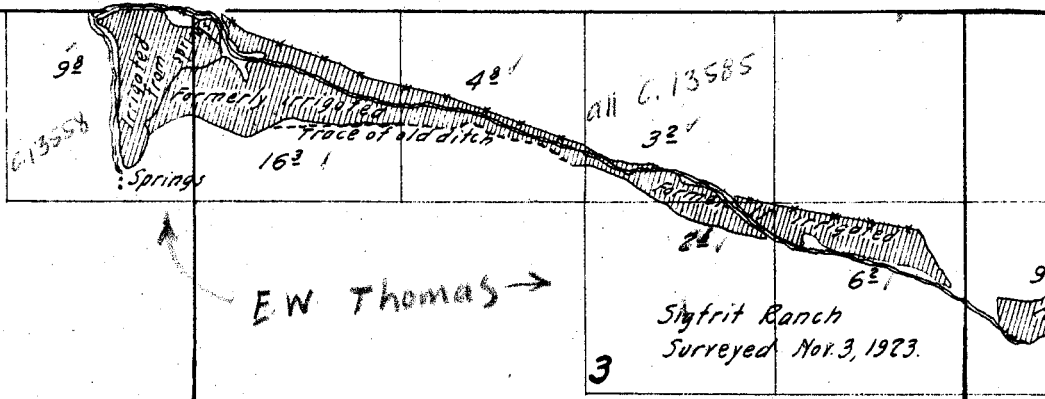

Styfrut Ranch
Surreyed Nov. 3, 1923.

4

3

9

10

16

15

19

20

30

29

31

32

23


24

26

25

35

36

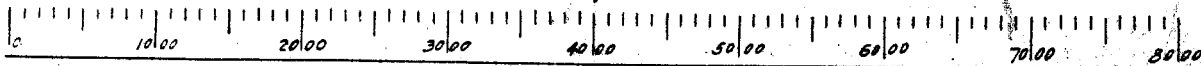

Scale of Feet.

26" x 27"

GM Nelson Reservoir
Pat 462

28

27

33

34

Maxwell Creek




12324

21

16

1/4 cor

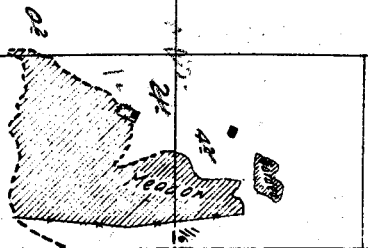

Nelson and Campbell Ranch Surveyed Oct 19, 1923


22

15

Cole Bros.


MEADOW

Survey of Oct 18

MEADOW

Maxwell Ditch Pat. #209

155

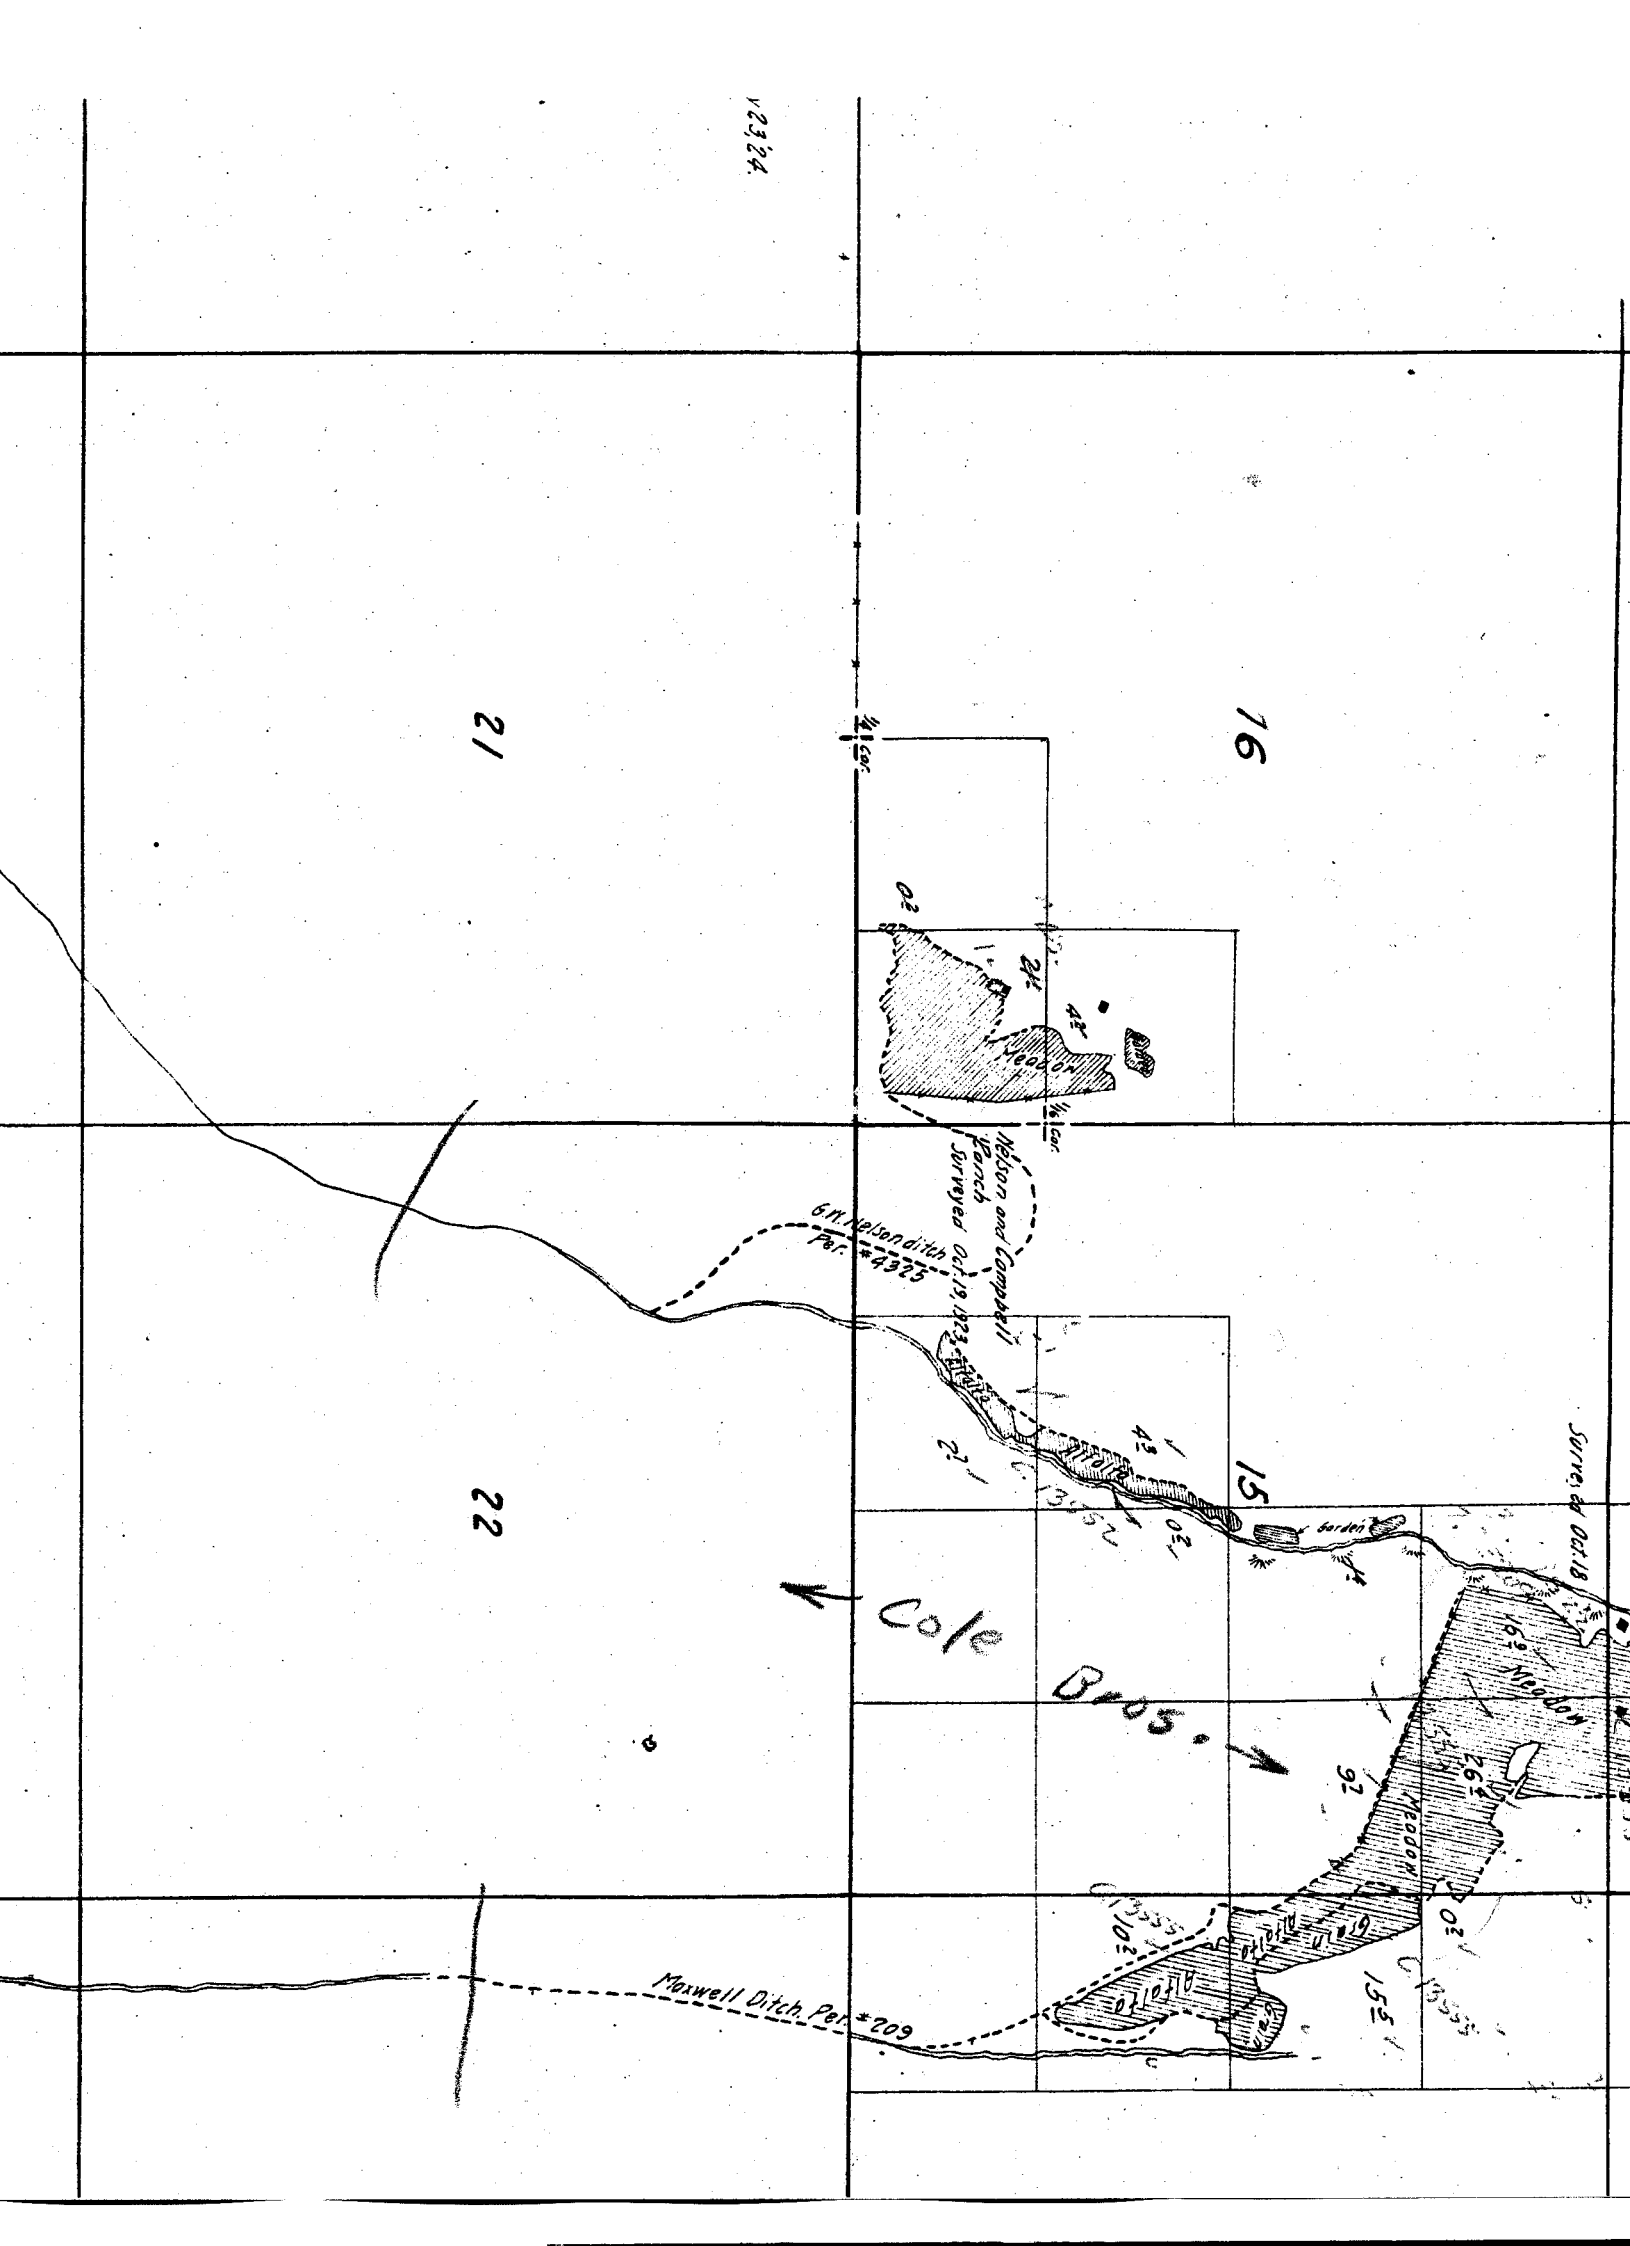

23

24

26


25

MILL CREEK

35

36

NOTE: - Creeks sketched in approximate location from U.S. Township plats or from Forest Service map except in vicinity of irrigated areas. Permit ditches plotted in approximate location from permit maps except in vicinity of irrigated areas.

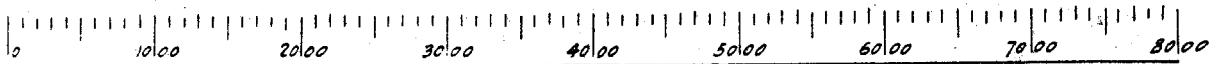

Scale of Feet.

19

20


Leach Creek

30


29

31

32

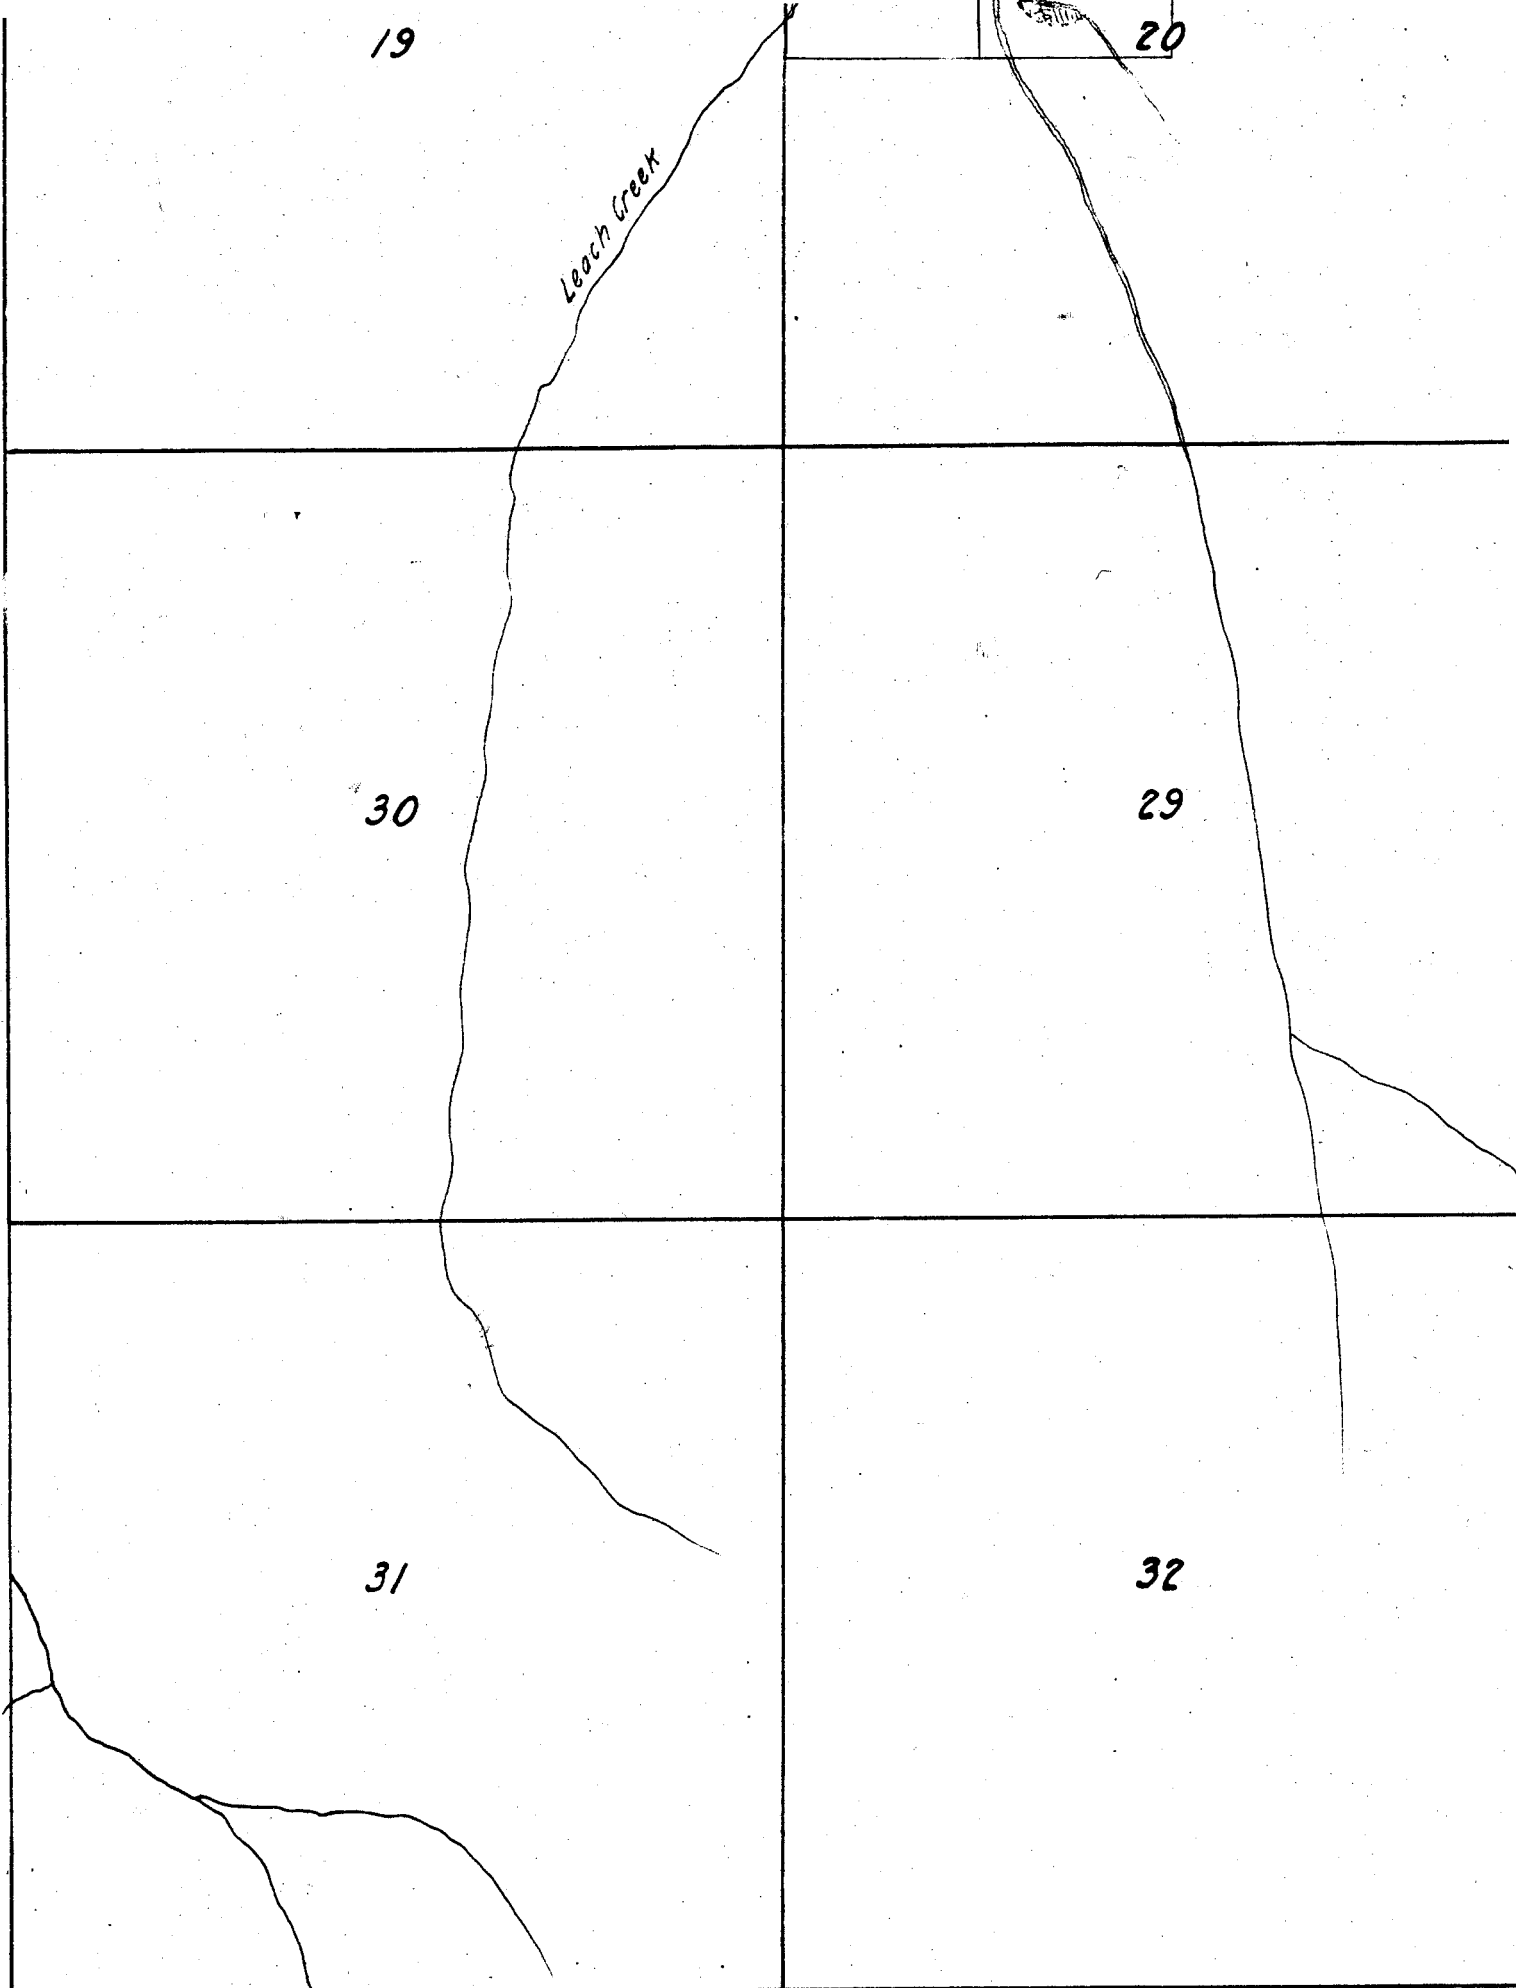

Township

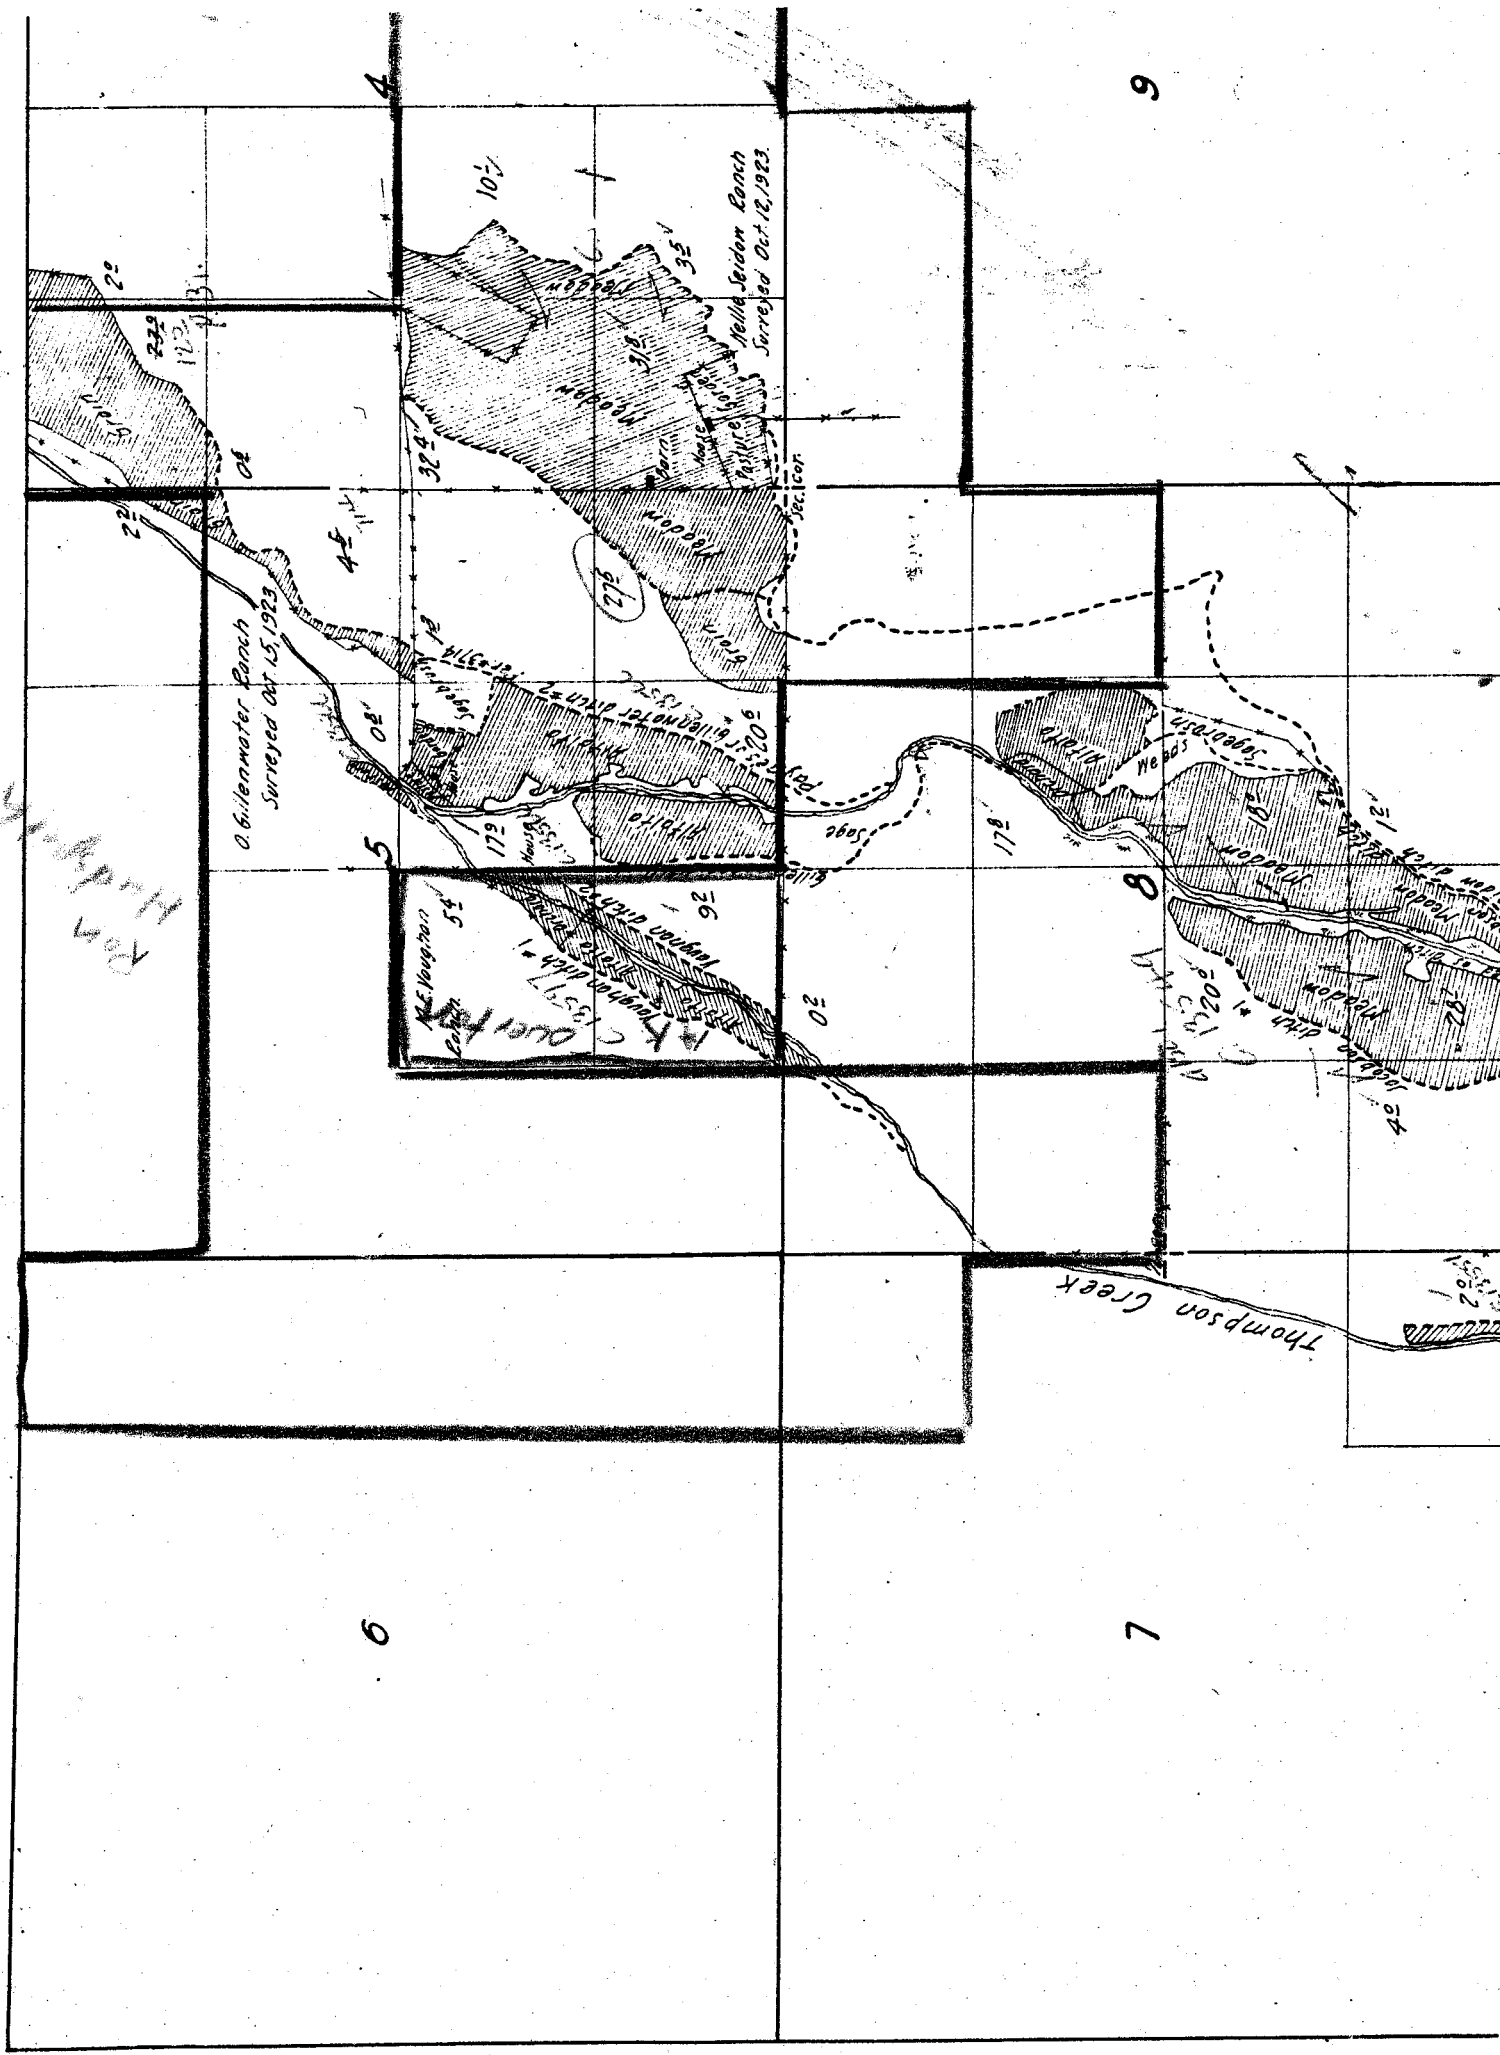

9

6

7

0.611enwater Ranch
Surveyed Oct 15, 1923

Surveyed Oct 12, 1923

Thompson Creek


M.E. Vaughan
54
1937
17

RAV
HILLMAN

Sec. cor.

Sec. cor.

1/4 cor.

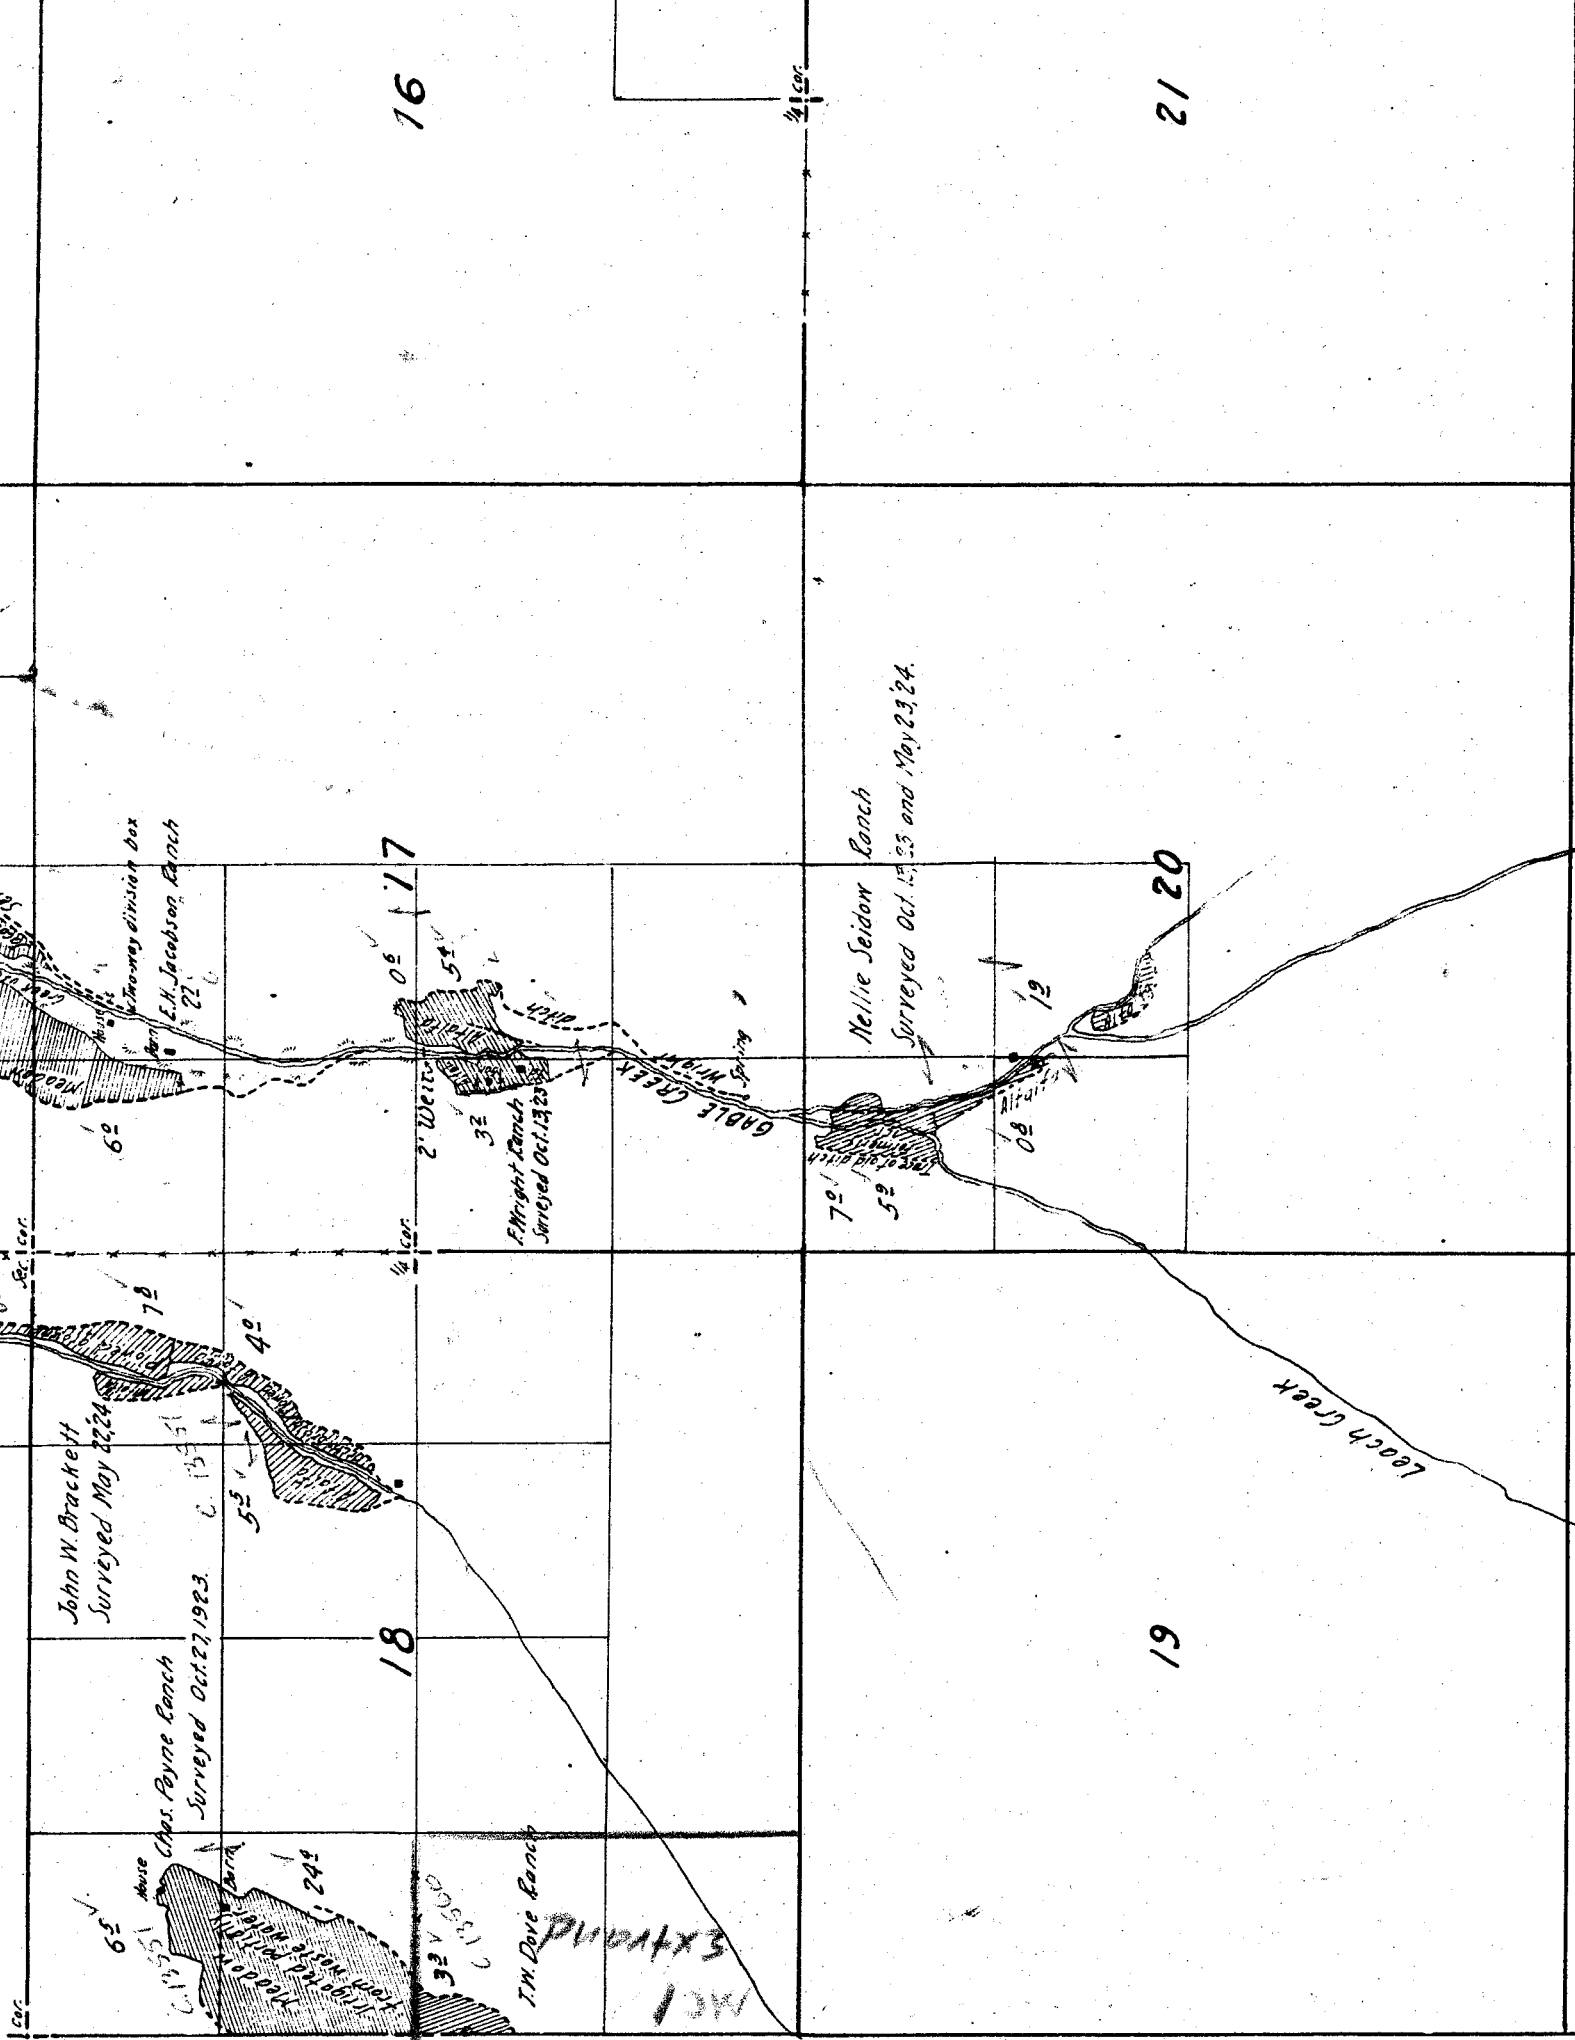

16

21

17

20

18

19


Range 21 E.

10-1-1

3

10

CM Dollarhide

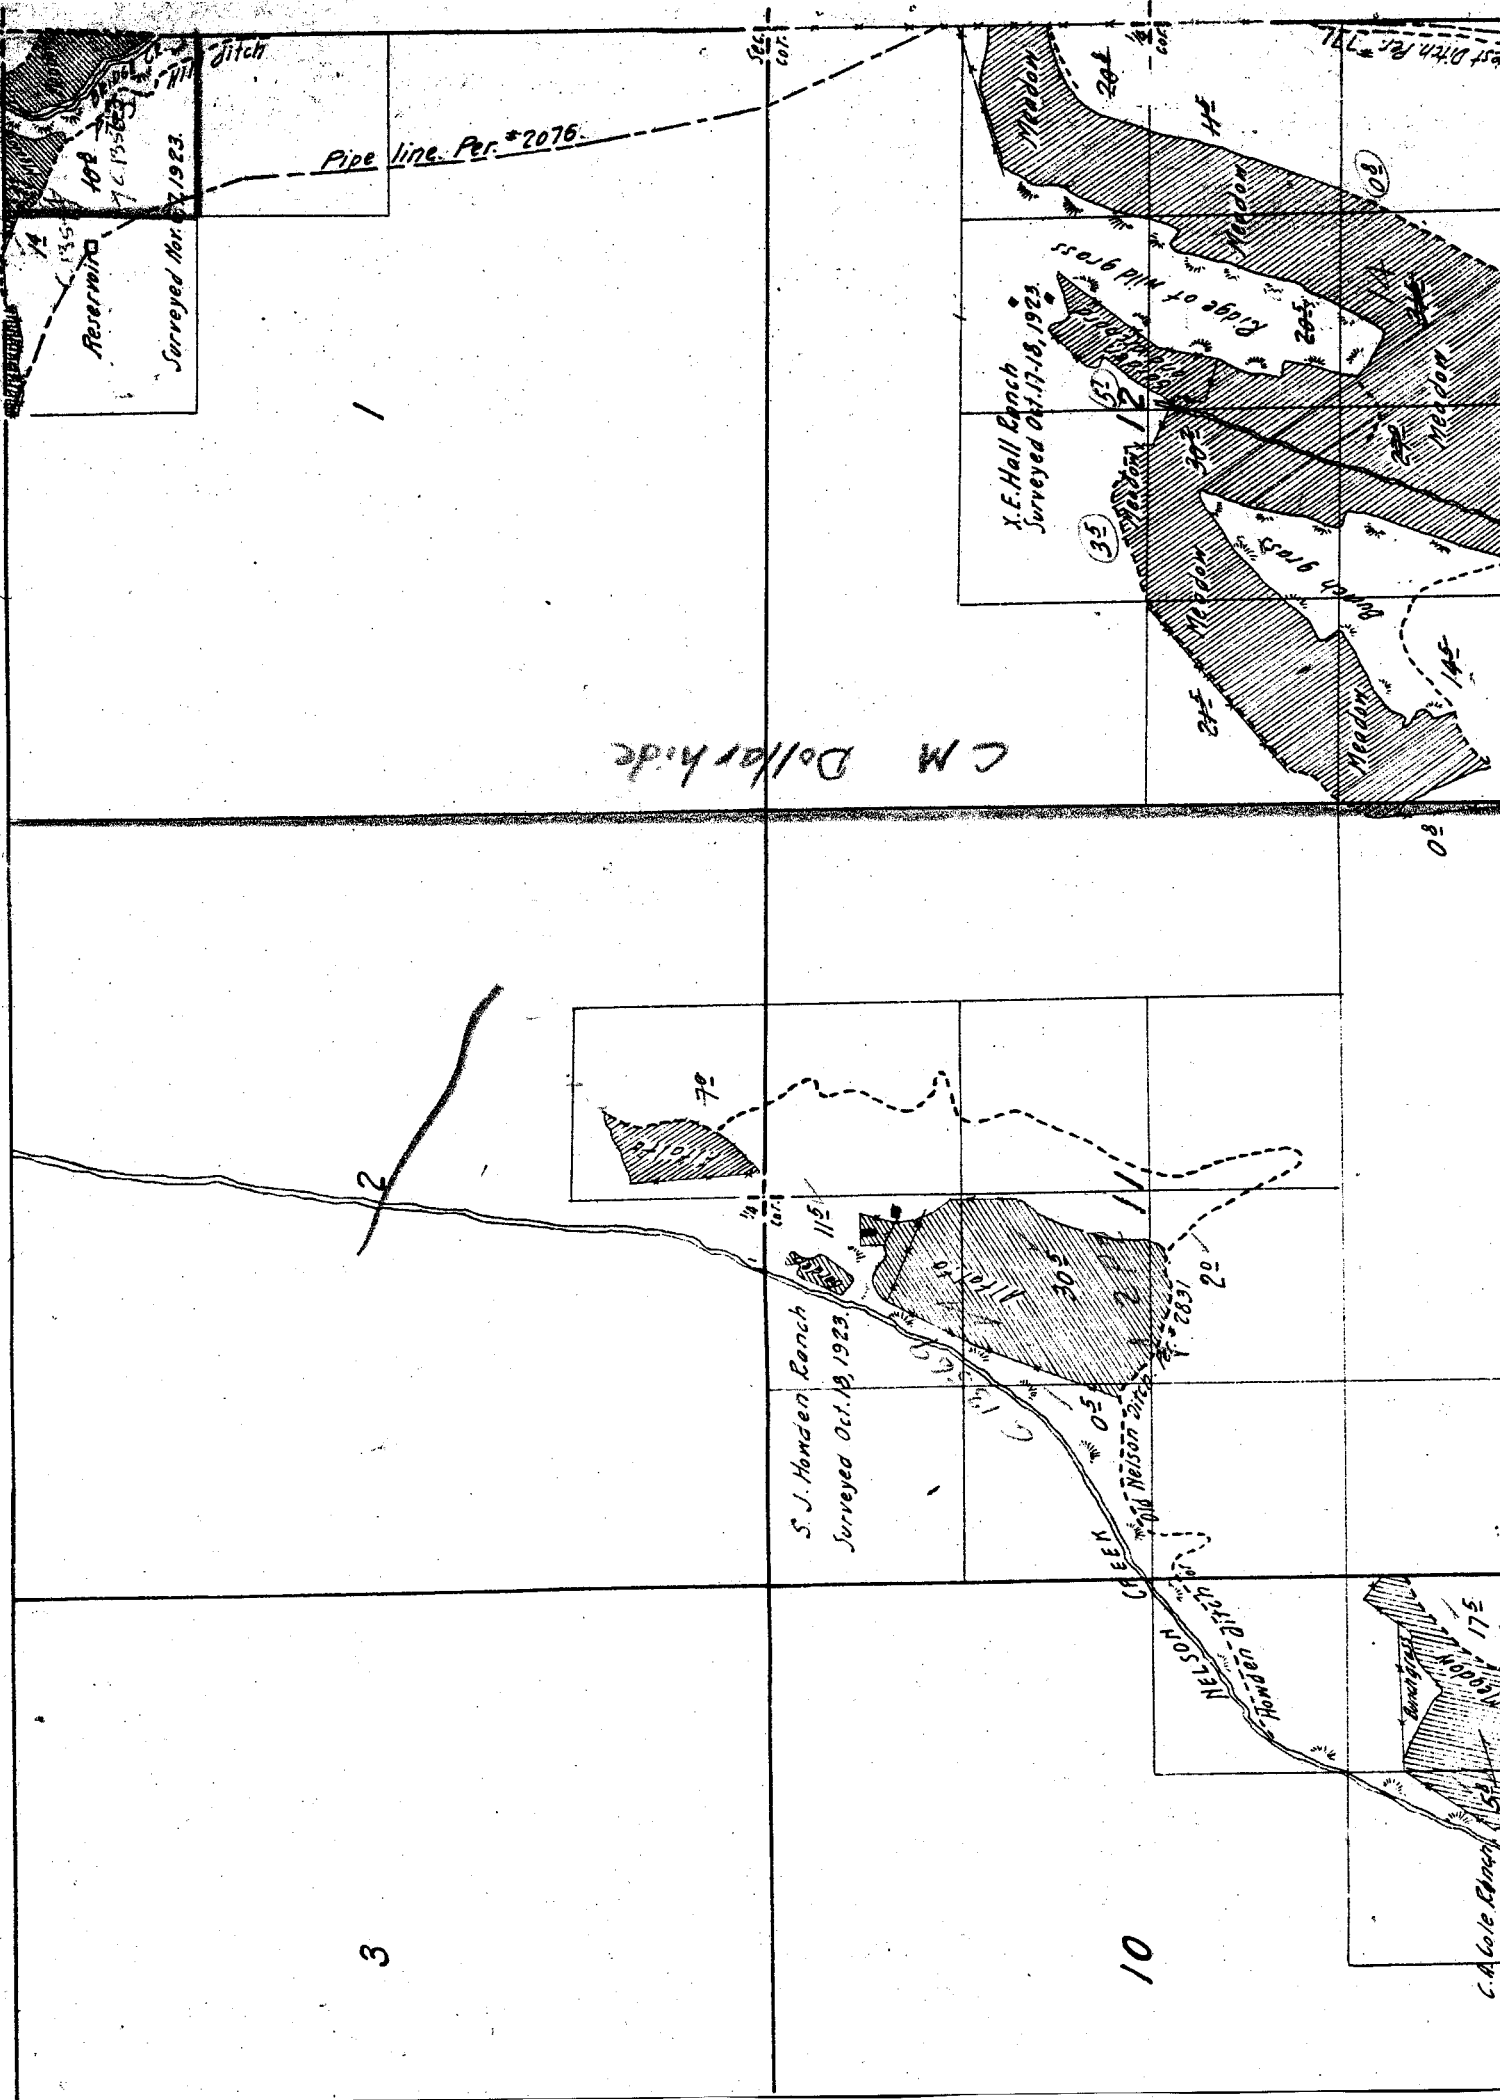

Reservoir No. 108
Surveyed Nov. 27, 1923.

Pipe line Per. #2076.

X. E. Hall Ranch
Surveyed Oct. 17-18, 1923.

S. J. Horden Ranch
Surveyed Oct. 18, 1923.


NELSON

MEADOW

MEADOW

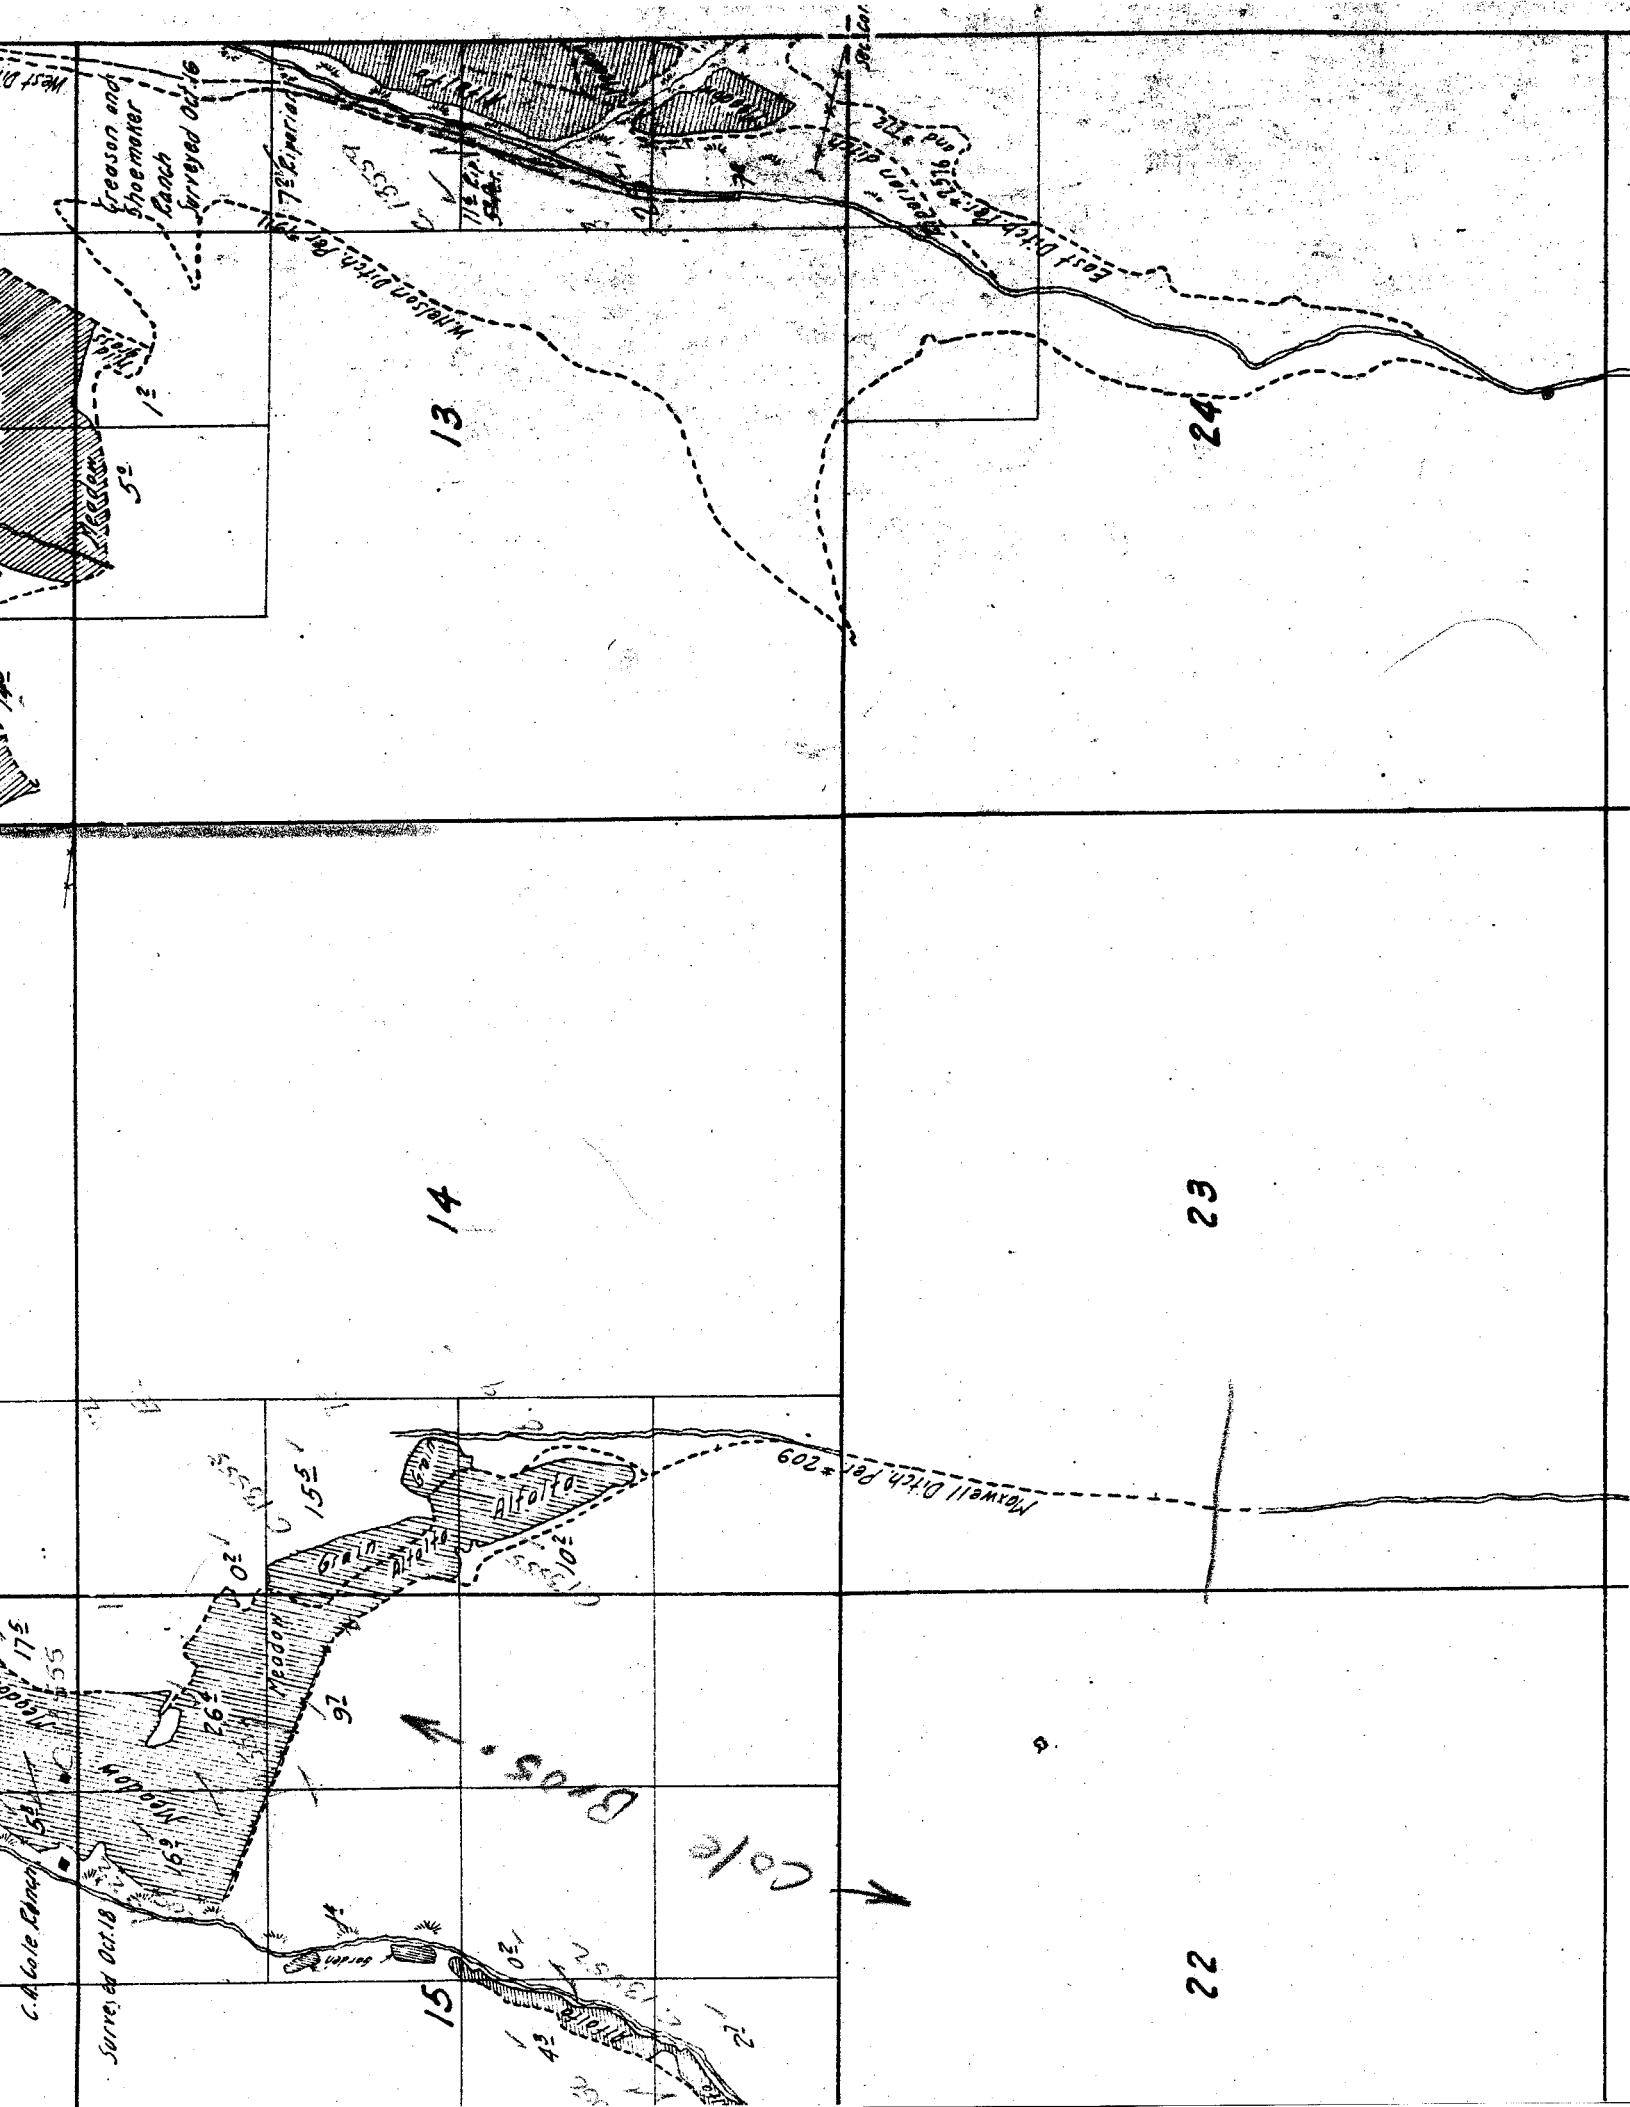

Gresson and Shoemaker Ranch Surveyed Oct. 16

C.A. Cole Ranch Surveyed Oct. 18



Coke

Bloss

13

14

15

24

23

22

50

130

155

170

180

Township 12 S, Range 21 E.

