


Township

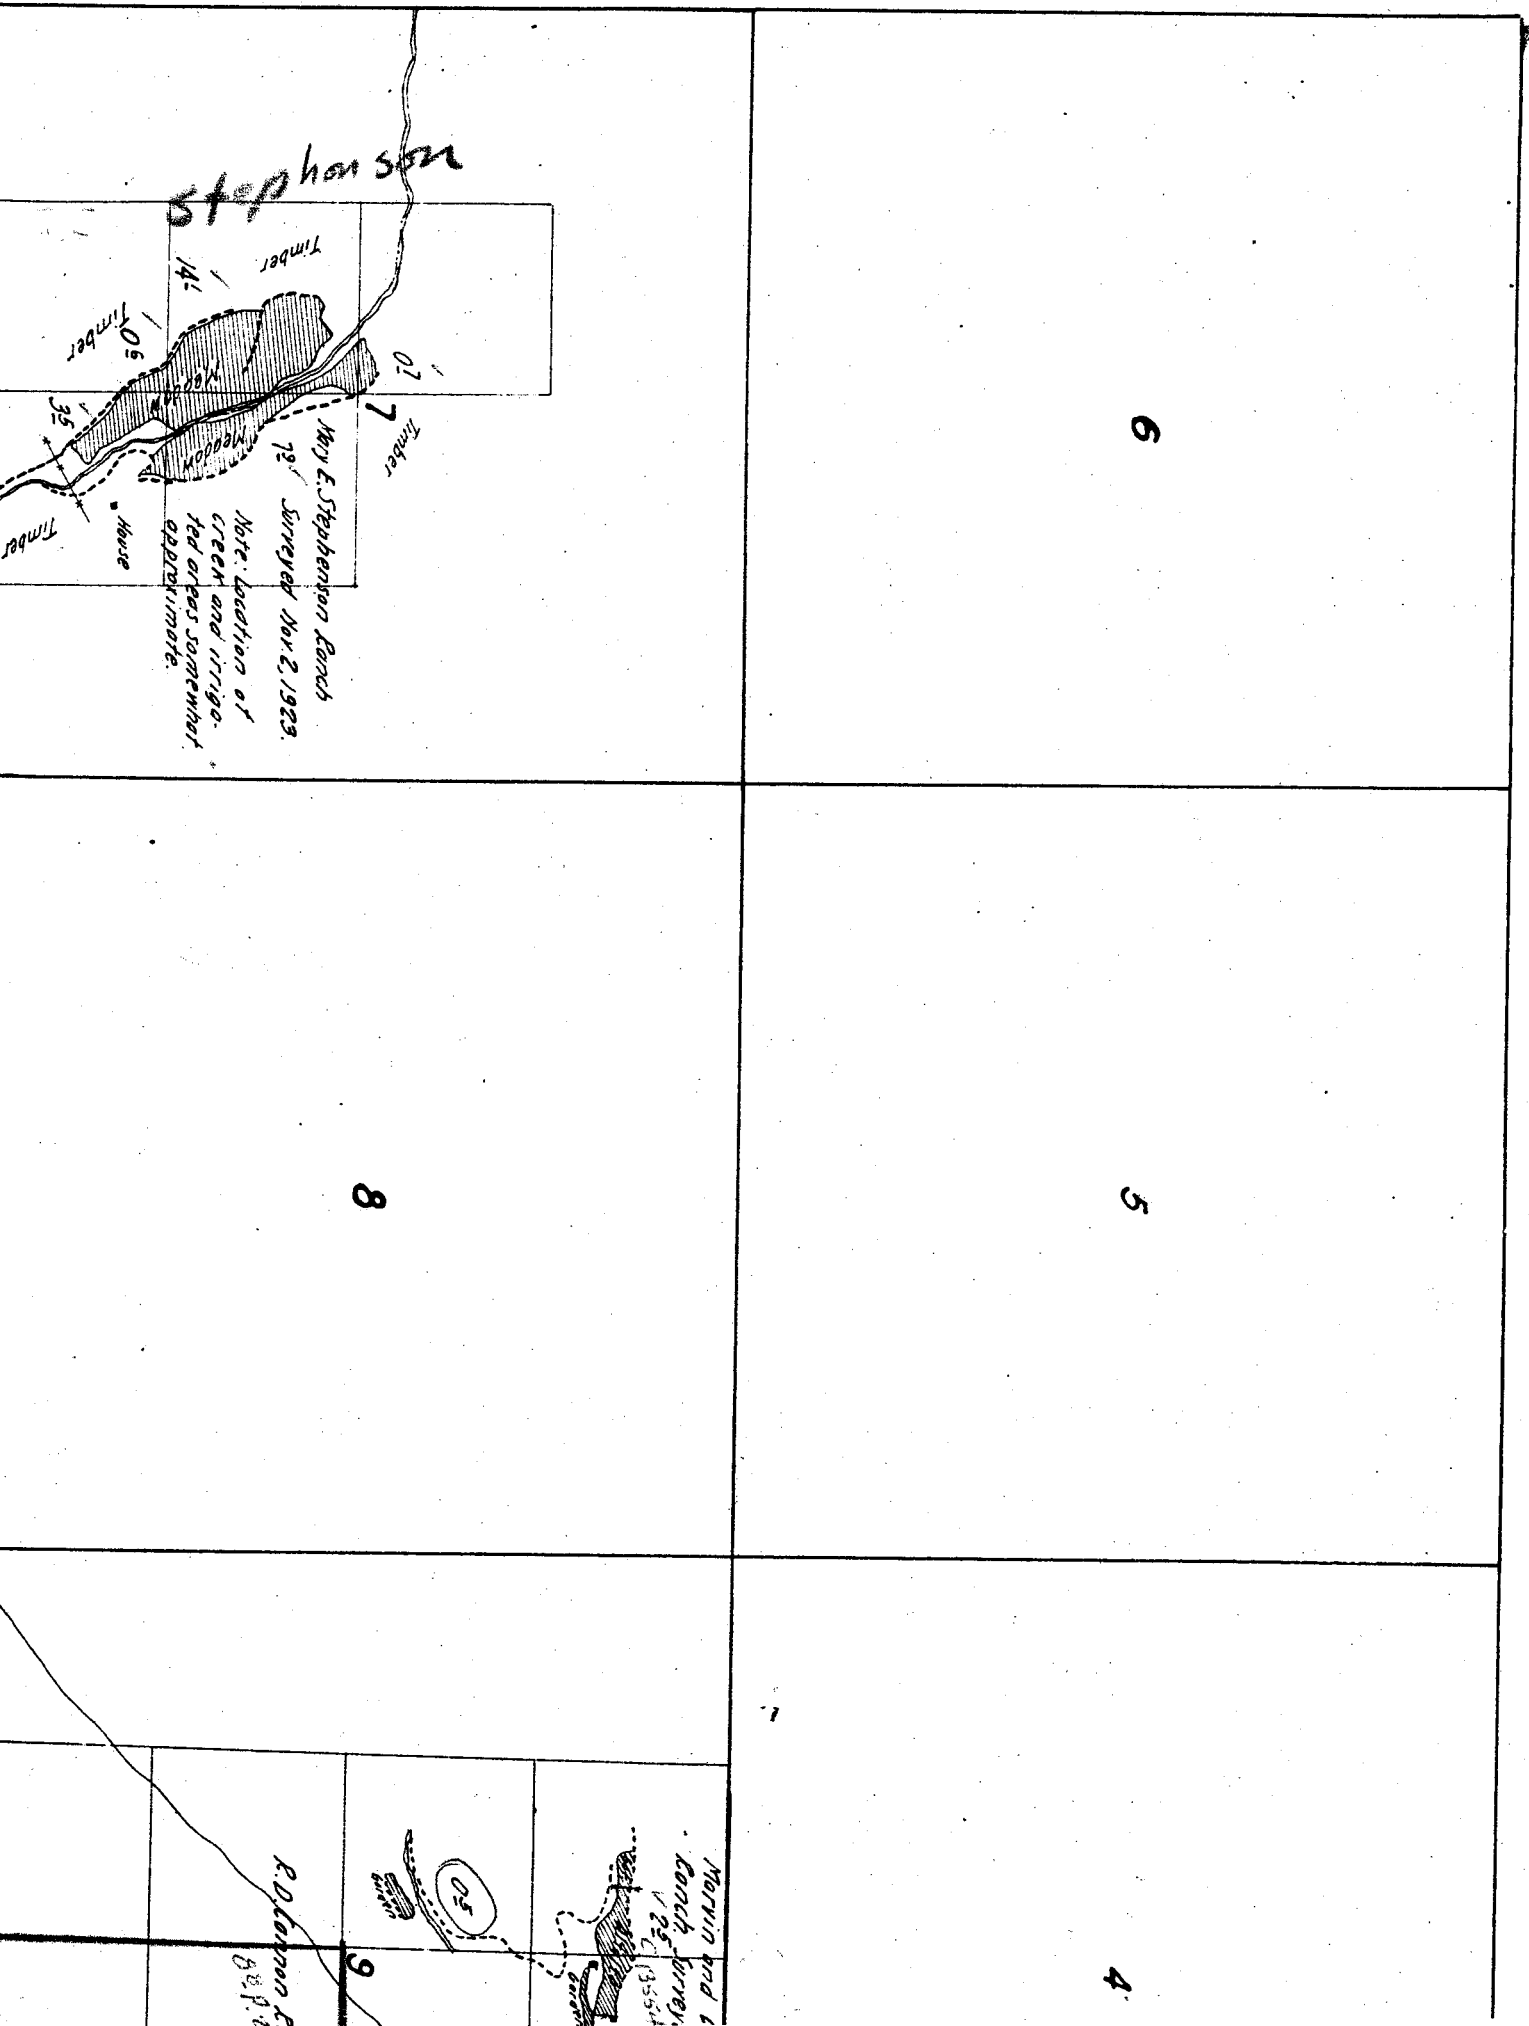

Timber

HEFLIN CREEK

18

19


17

20


16

21


32
 40
 21
 15
 0 2607
 4
 Per. No. 2602

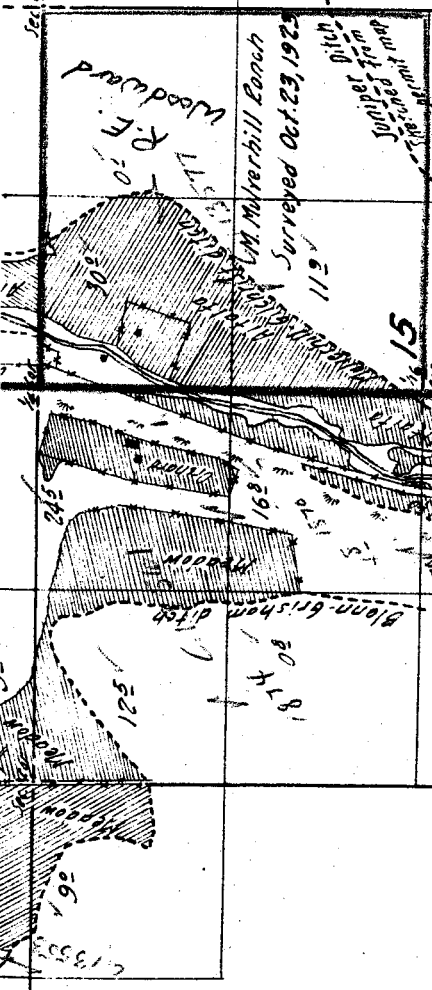

16

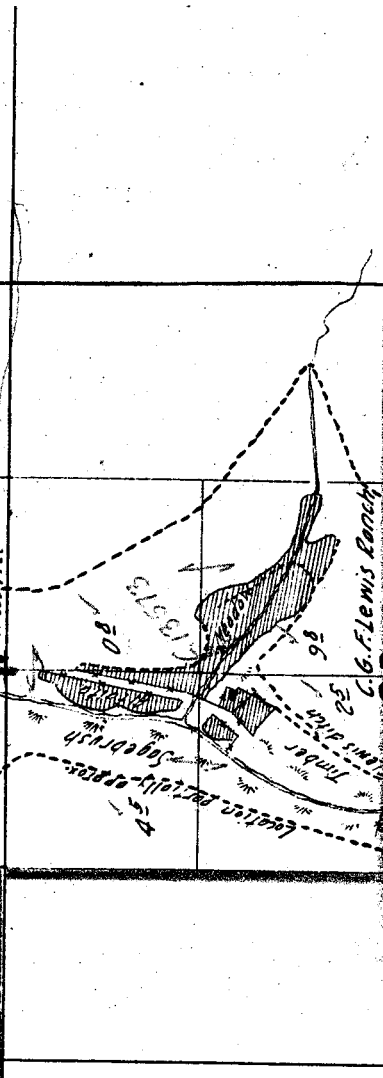

116

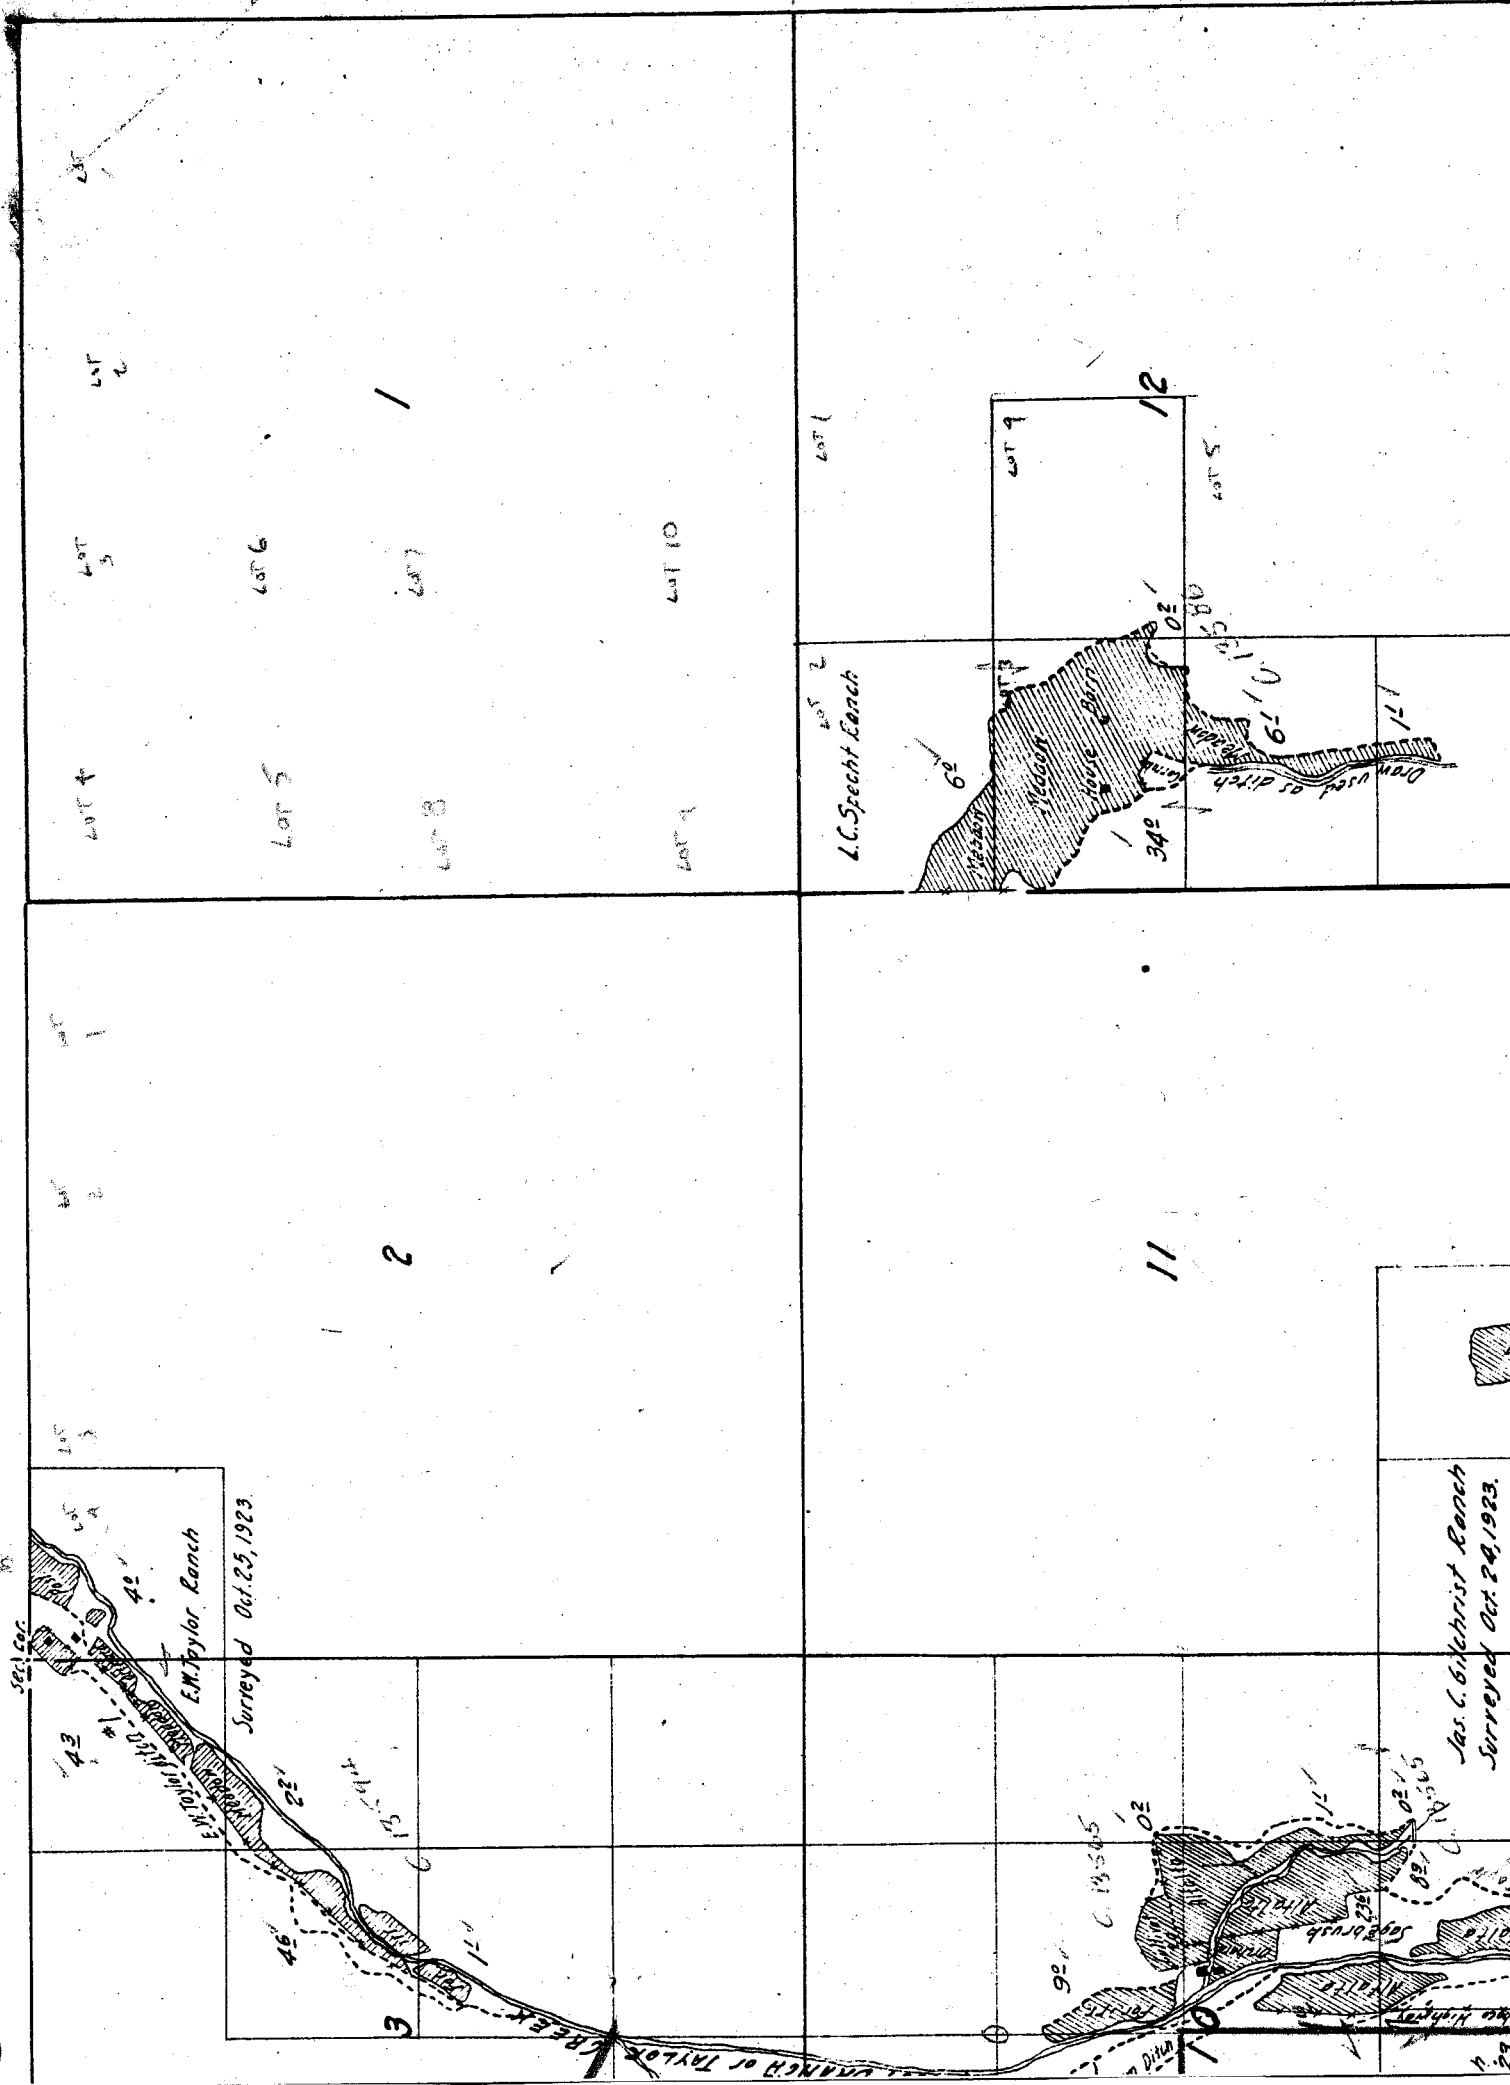

23

24

THOMPSON

26

25

Note:- Creeks sketched in approximate location from U.S. Township plat, U.S. Forest Service map, and permit maps, except in vicinity of irrigated areas.

35

36



Scale of Feet.

32


31

29

30

20

19

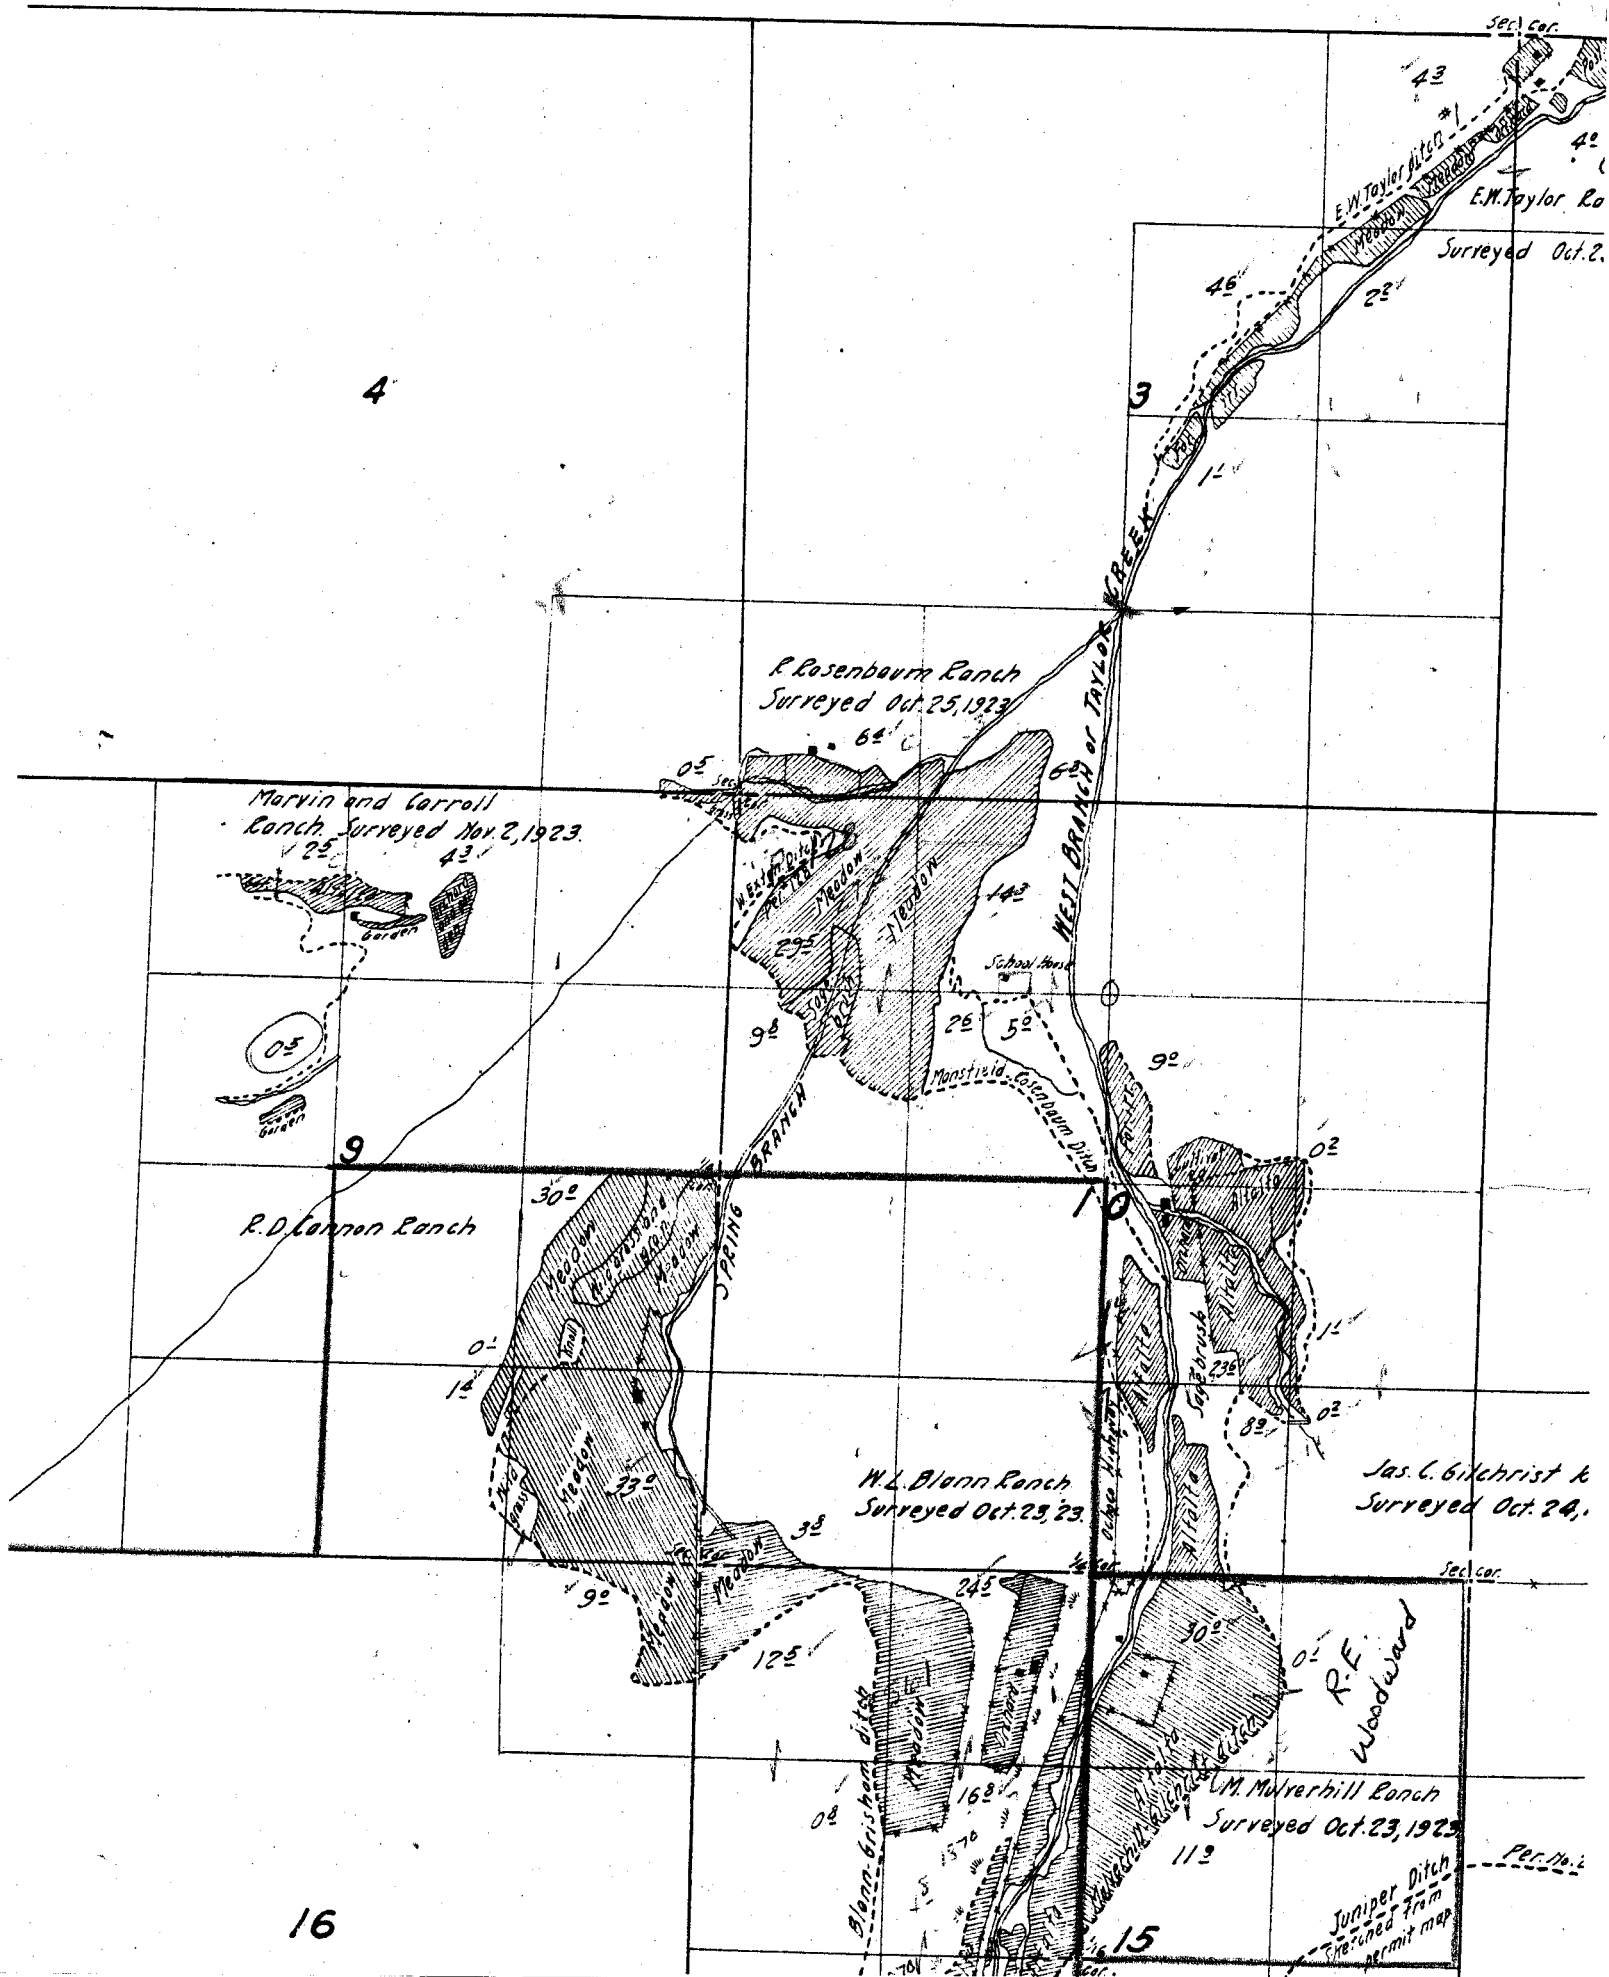

32

31

29

30

20

19