


Surveyed Oct. 31, 1923

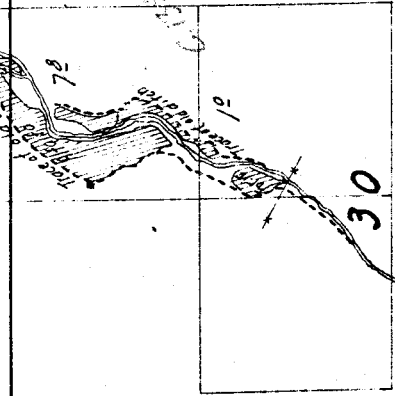

28


29

30


33

32

31

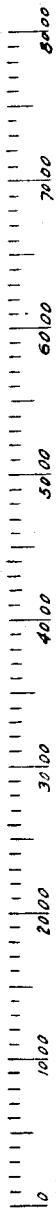


Scale of Feet

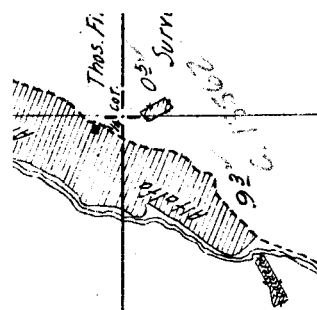


9/

12

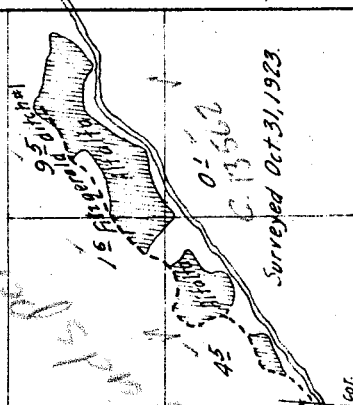

17

20

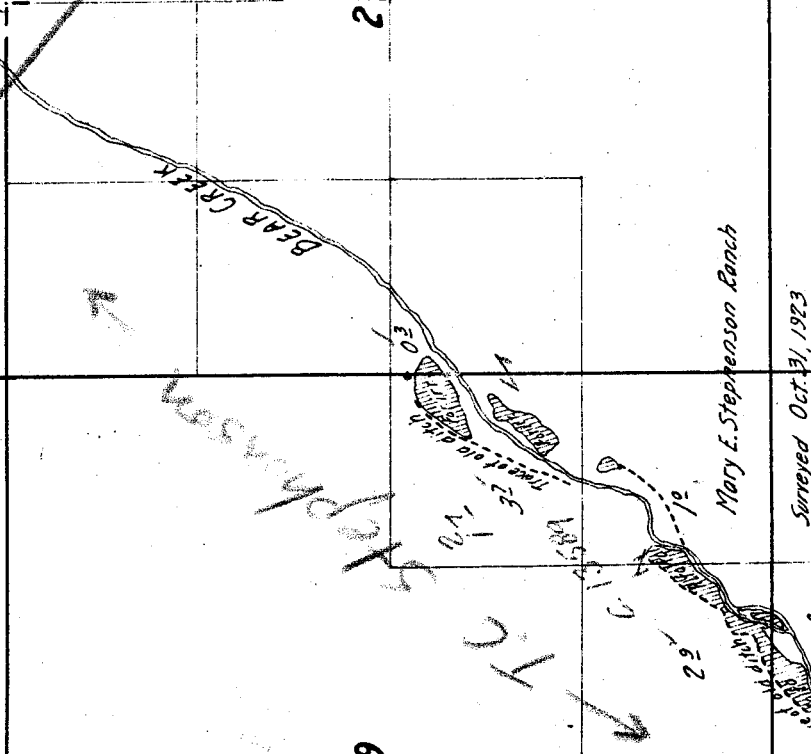

18

61

Surveyed Oct. 31, 1923.

Township

11 S,

Range


20 E.


4

3

*Note: Bear Creek partly sketched
in approximate location from
U.S. Township plat.*

10

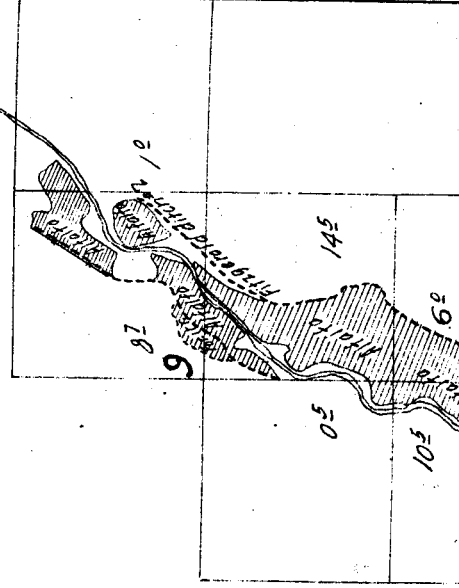

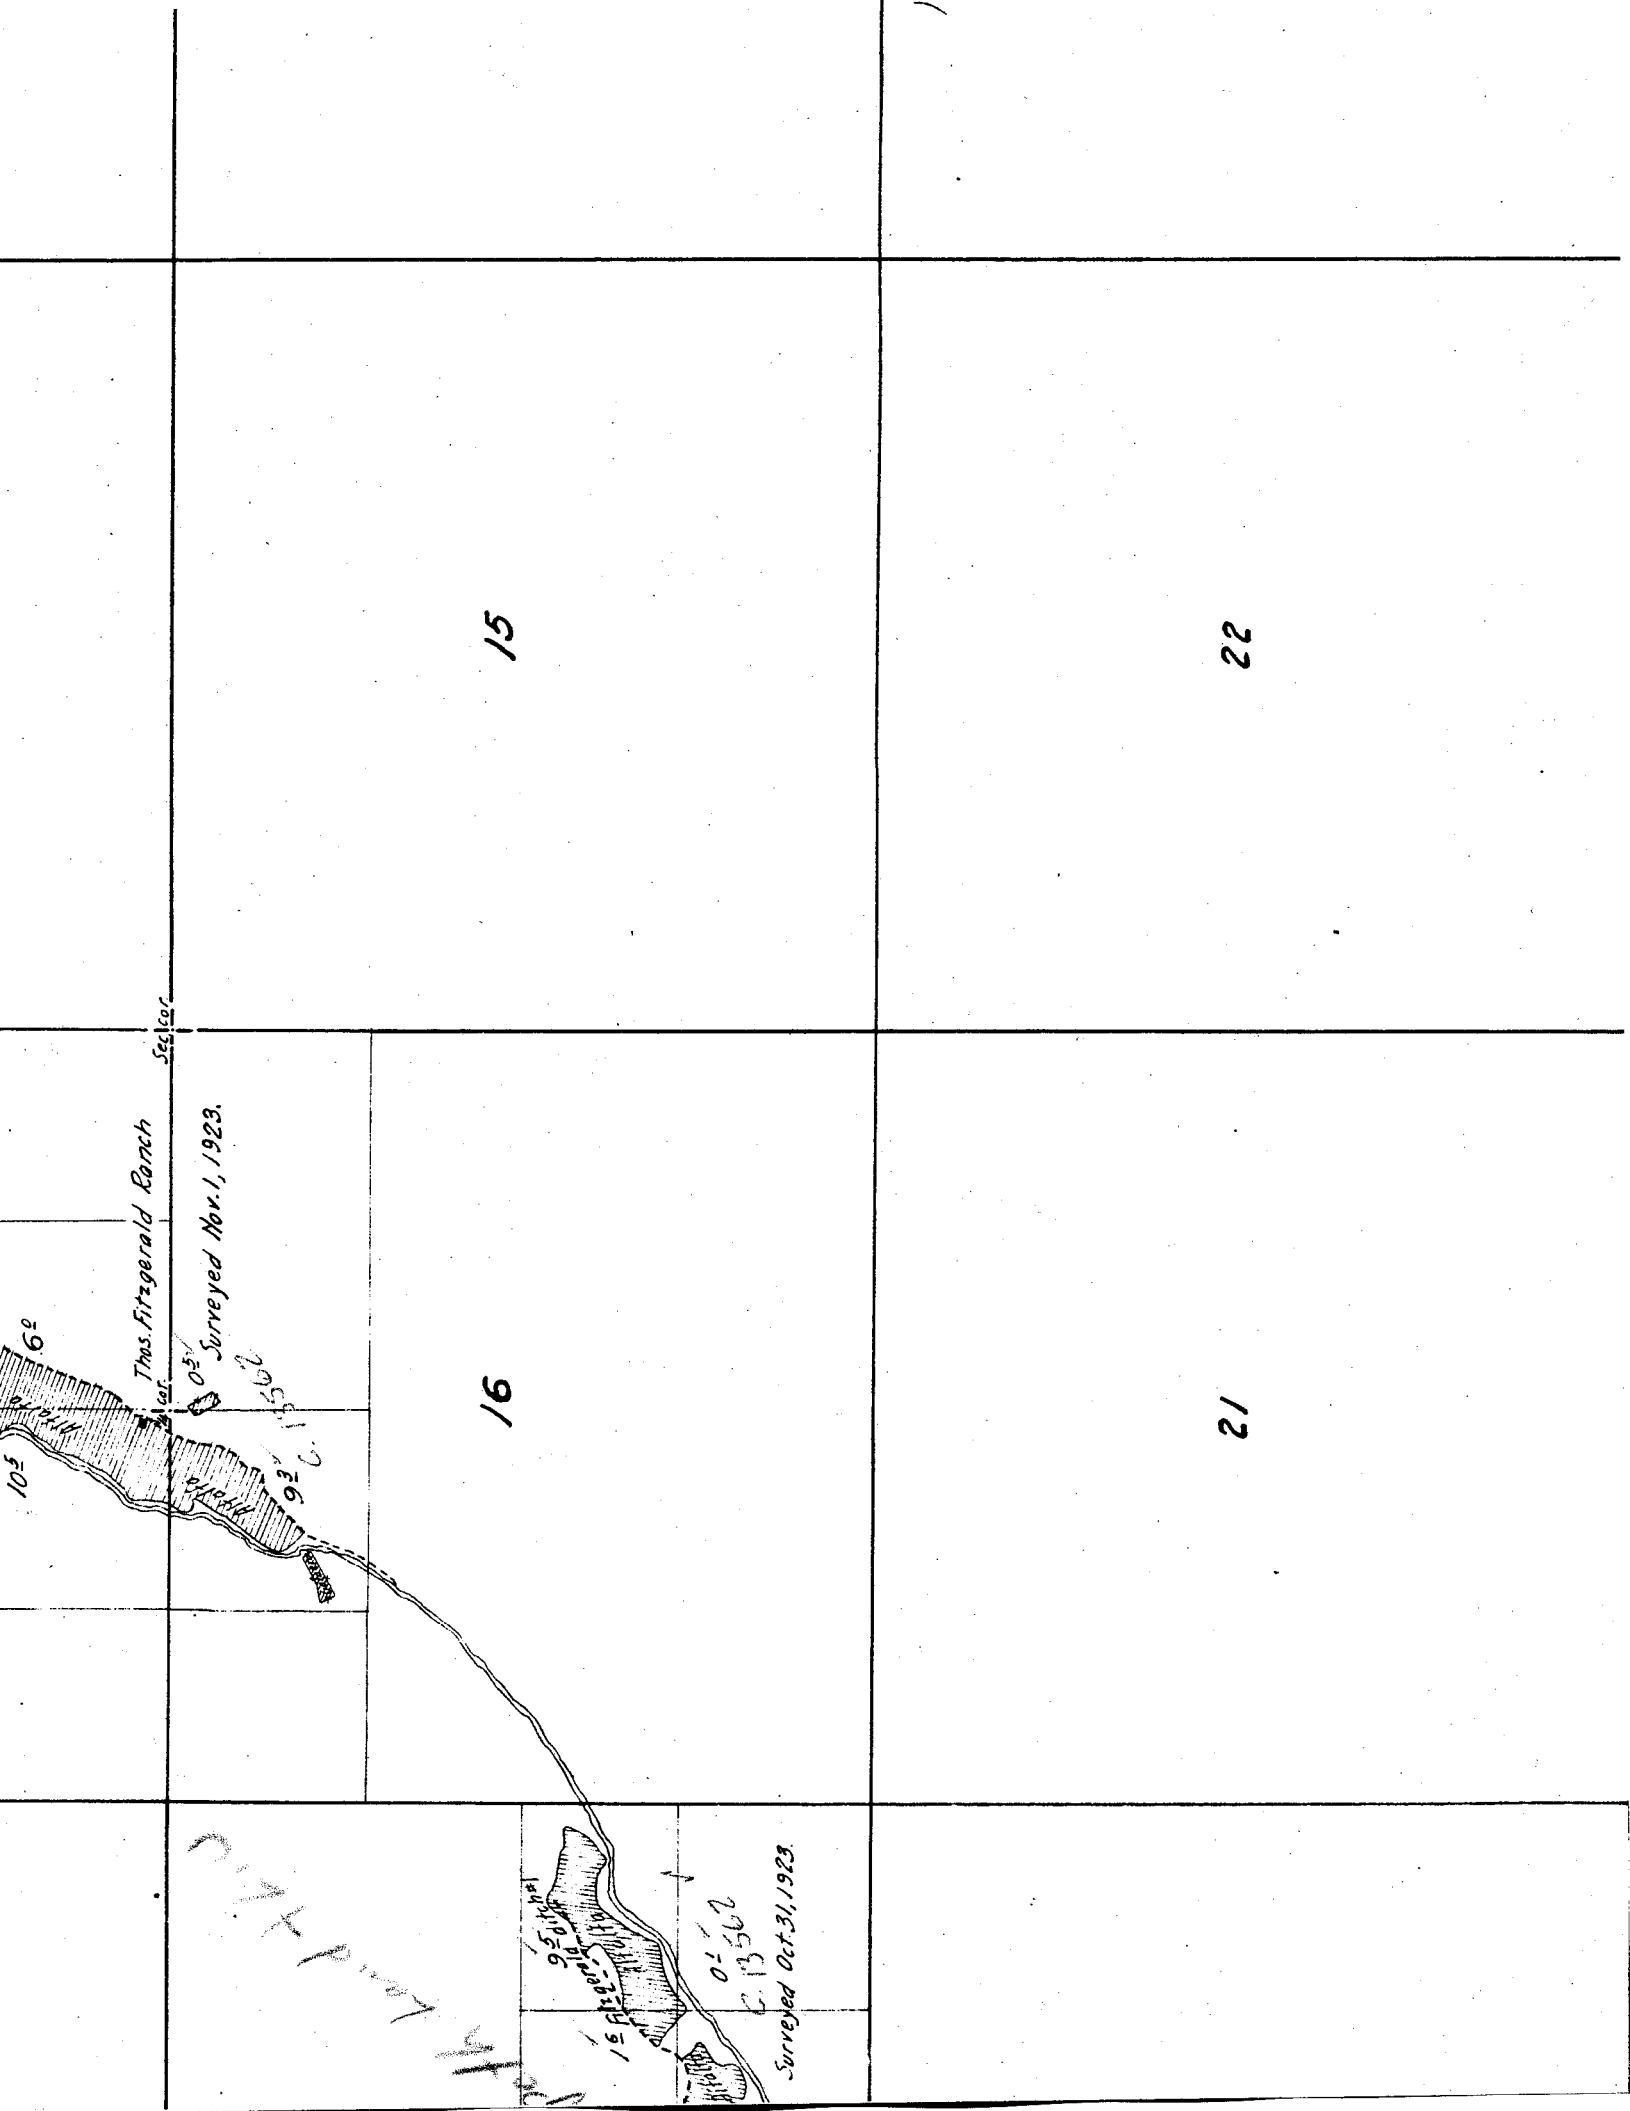

15

22

16

12

Thomas Fitzgerald Ranch

Surveyed Nov. 1, 1923.

Surveyed Oct. 31, 1923.

Handwritten notes and signatures in the bottom left corner.

13

14

21

11

1

2

124 110 56

151 4700 1000 17

18

8

7

5

6

34

33

27

28

22


21

13

24

14

23

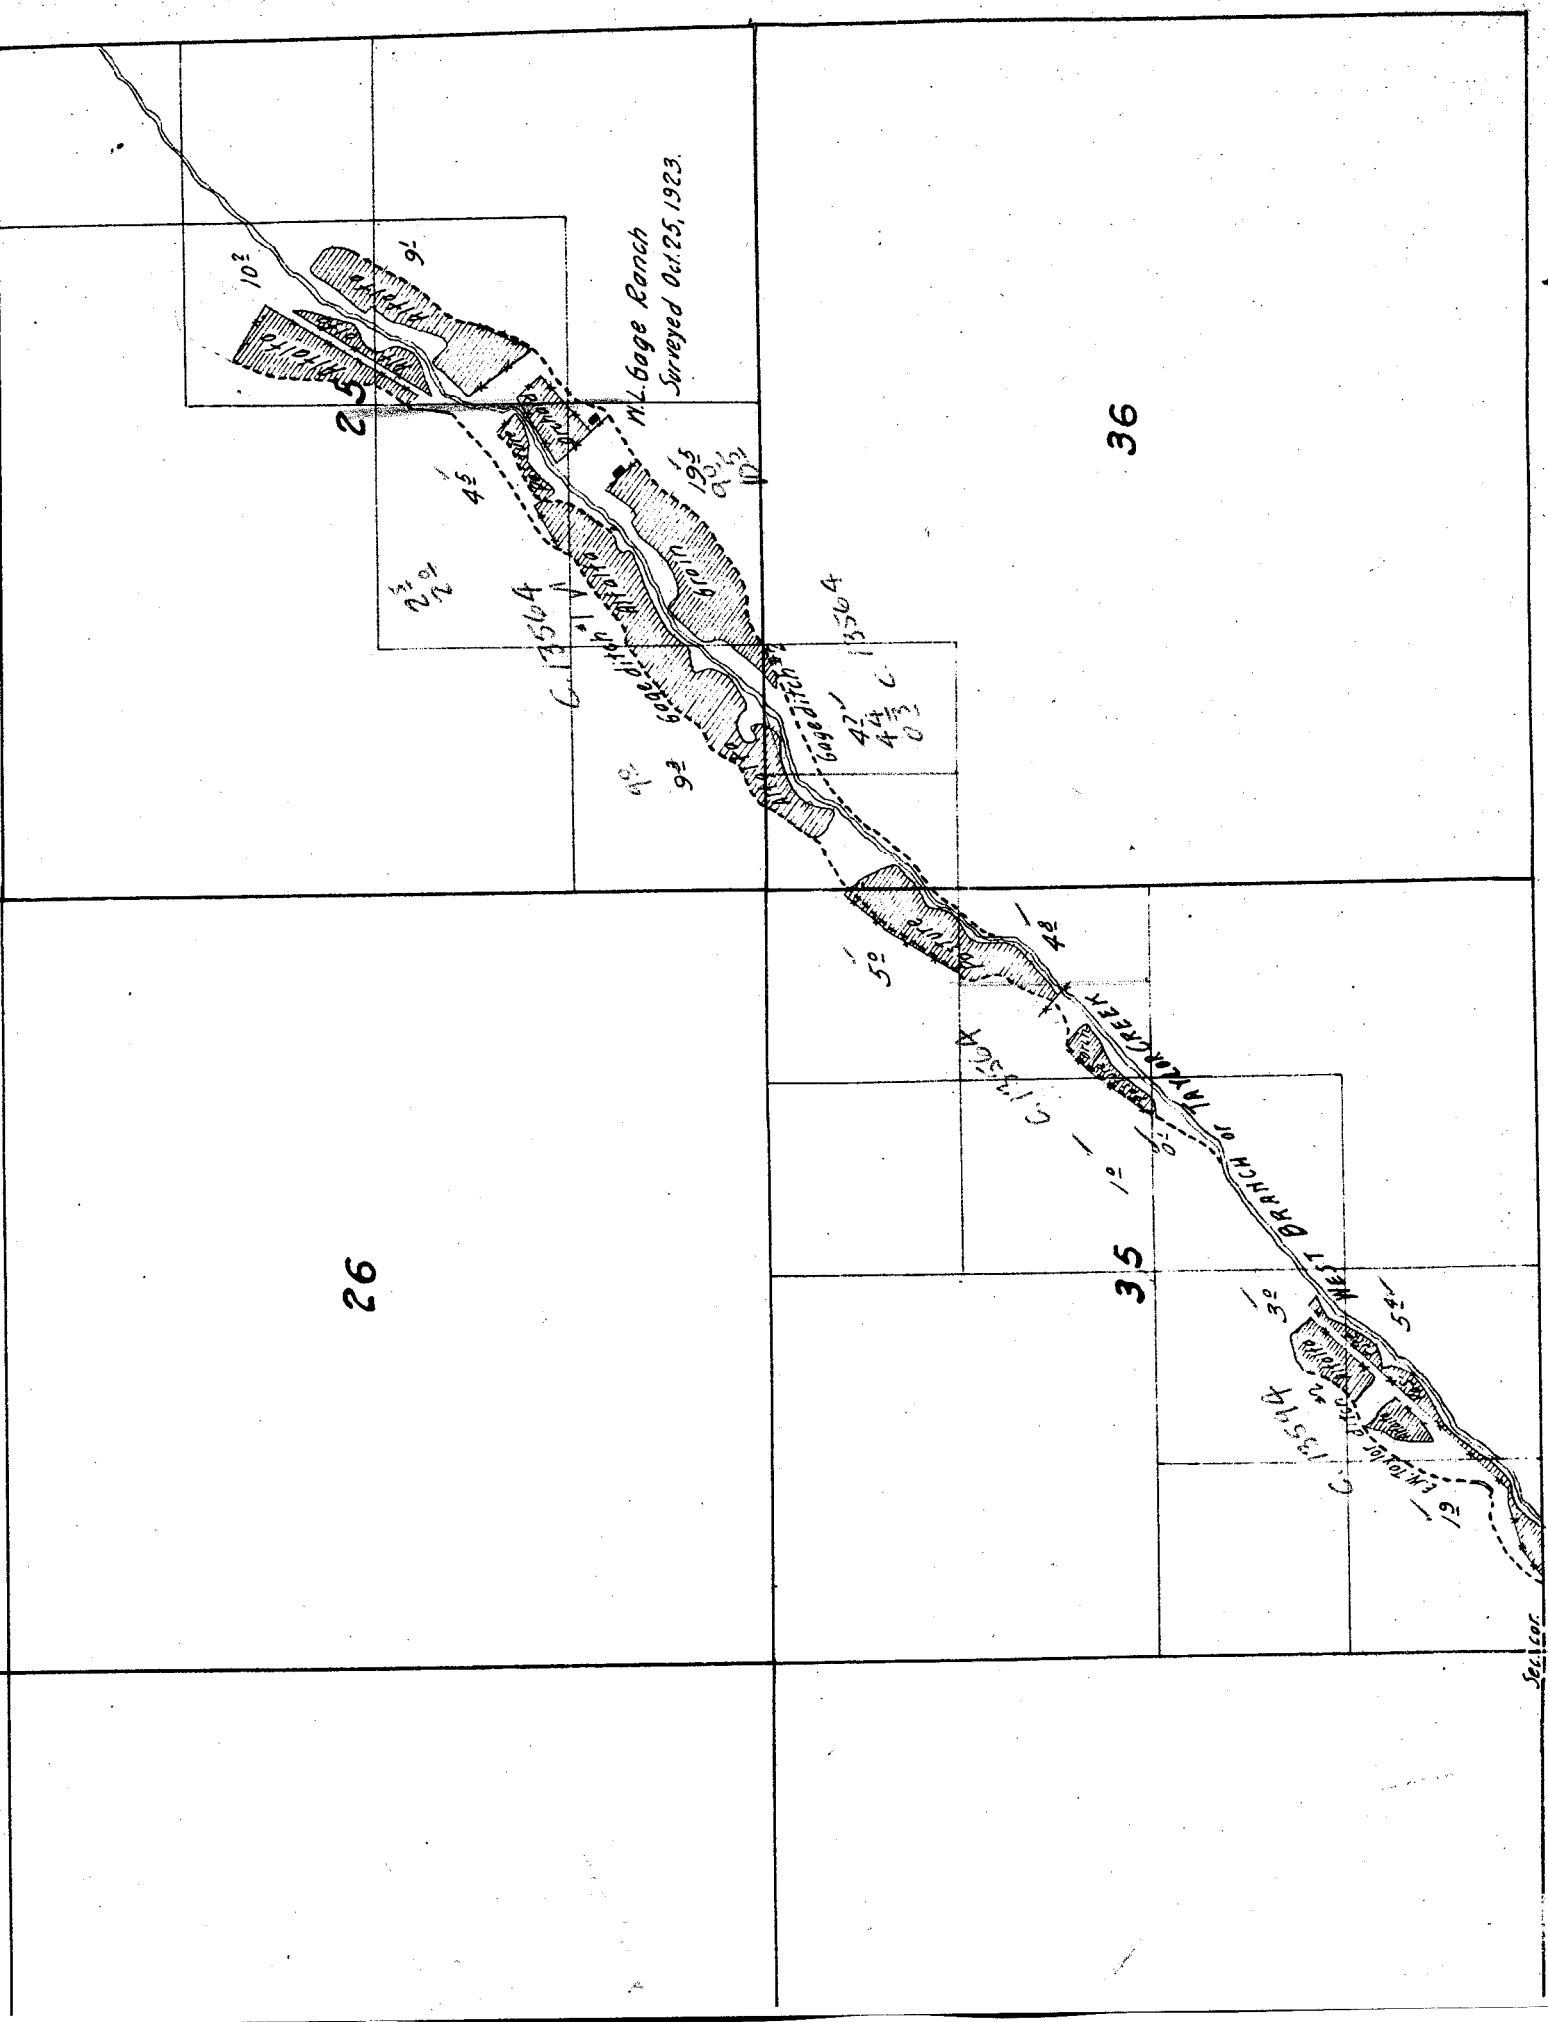

8021 100