


Township

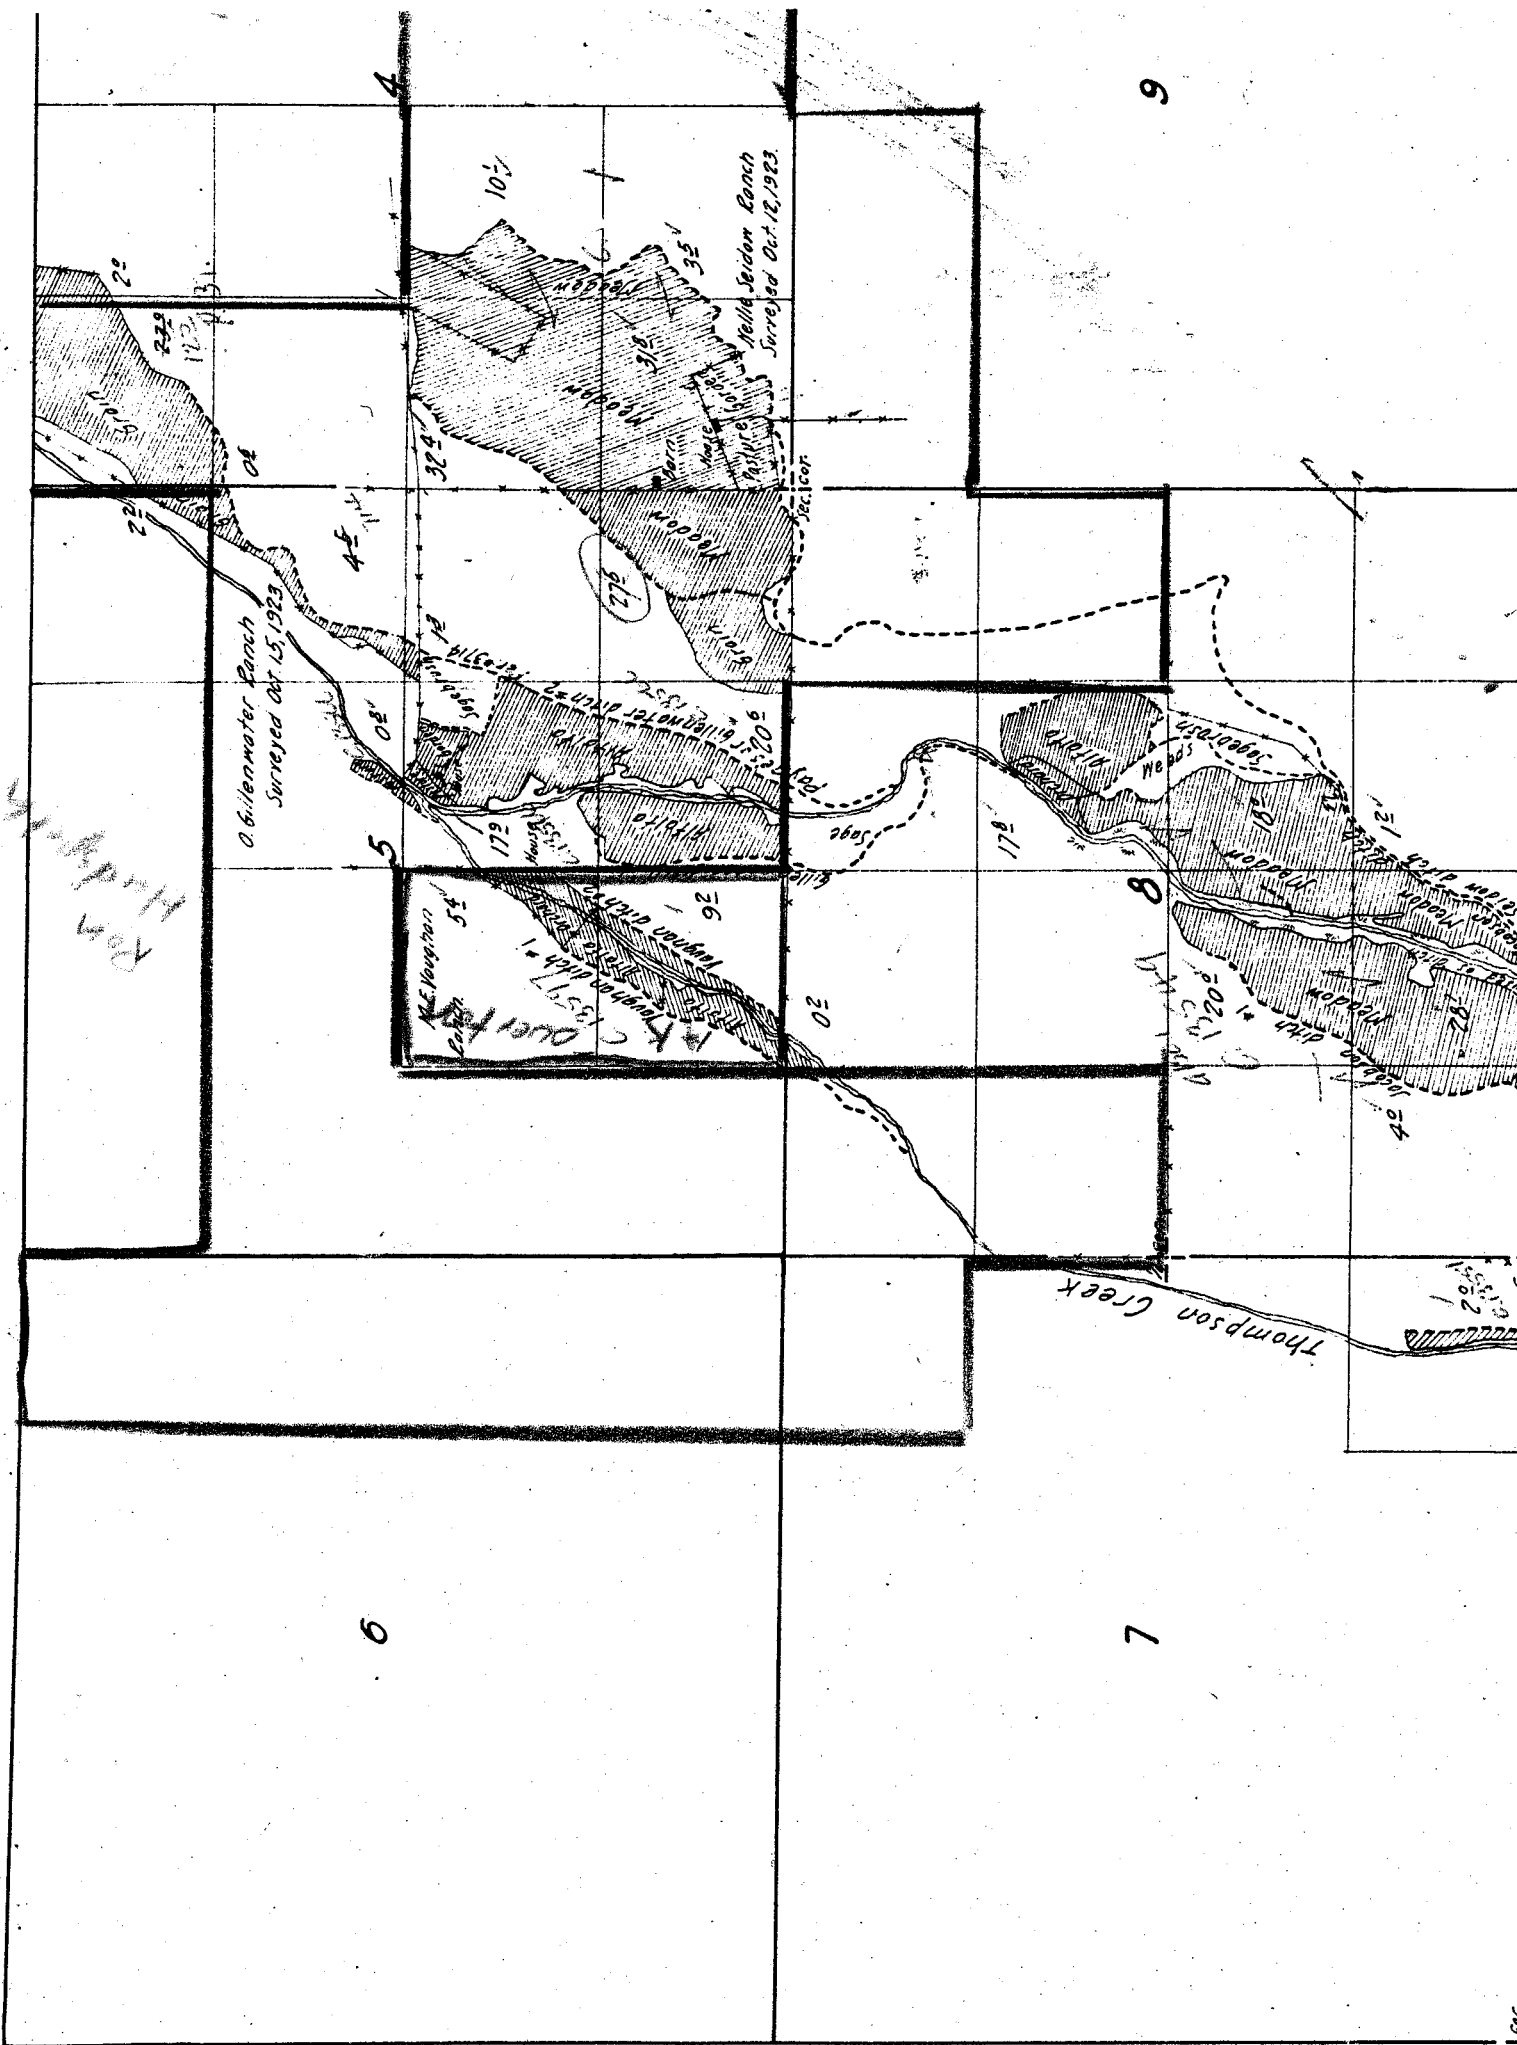

16

17

18

19

Sec. cor.

1/4 cor.

1/4 cor.

1/4 cor.

1/4 cor.

John W. Brackett
Surveyed May 22, 24

Chas. Payne Ranch
Surveyed Oct. 27, 1923


T.M. Dove Ranch

Elmright Ranch
Surveyed Oct. 13, 23

Mellie Seidow Ranch
Surveyed Oct. 15, 23 and May 23, 24

E.H. Jacobson Ranch

EXTRAD
MCI

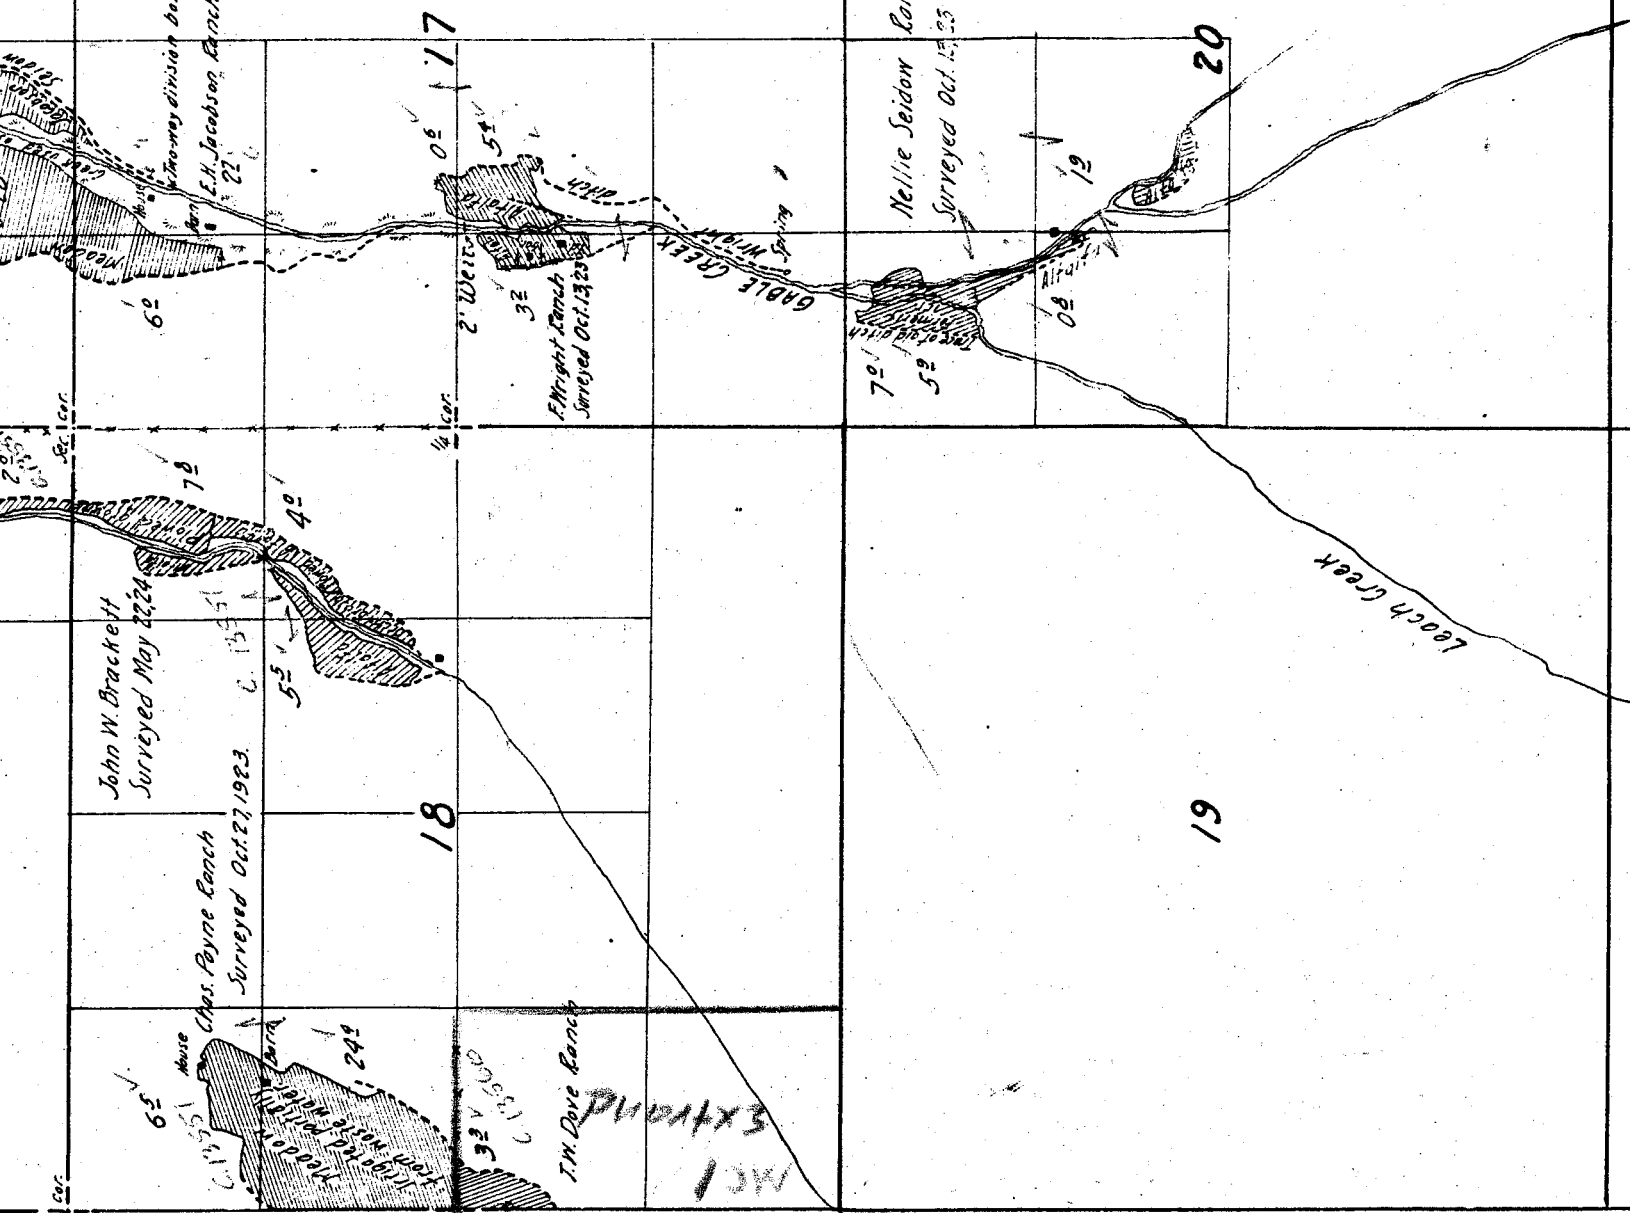

19

20


Leach Creek

30

29

31

32

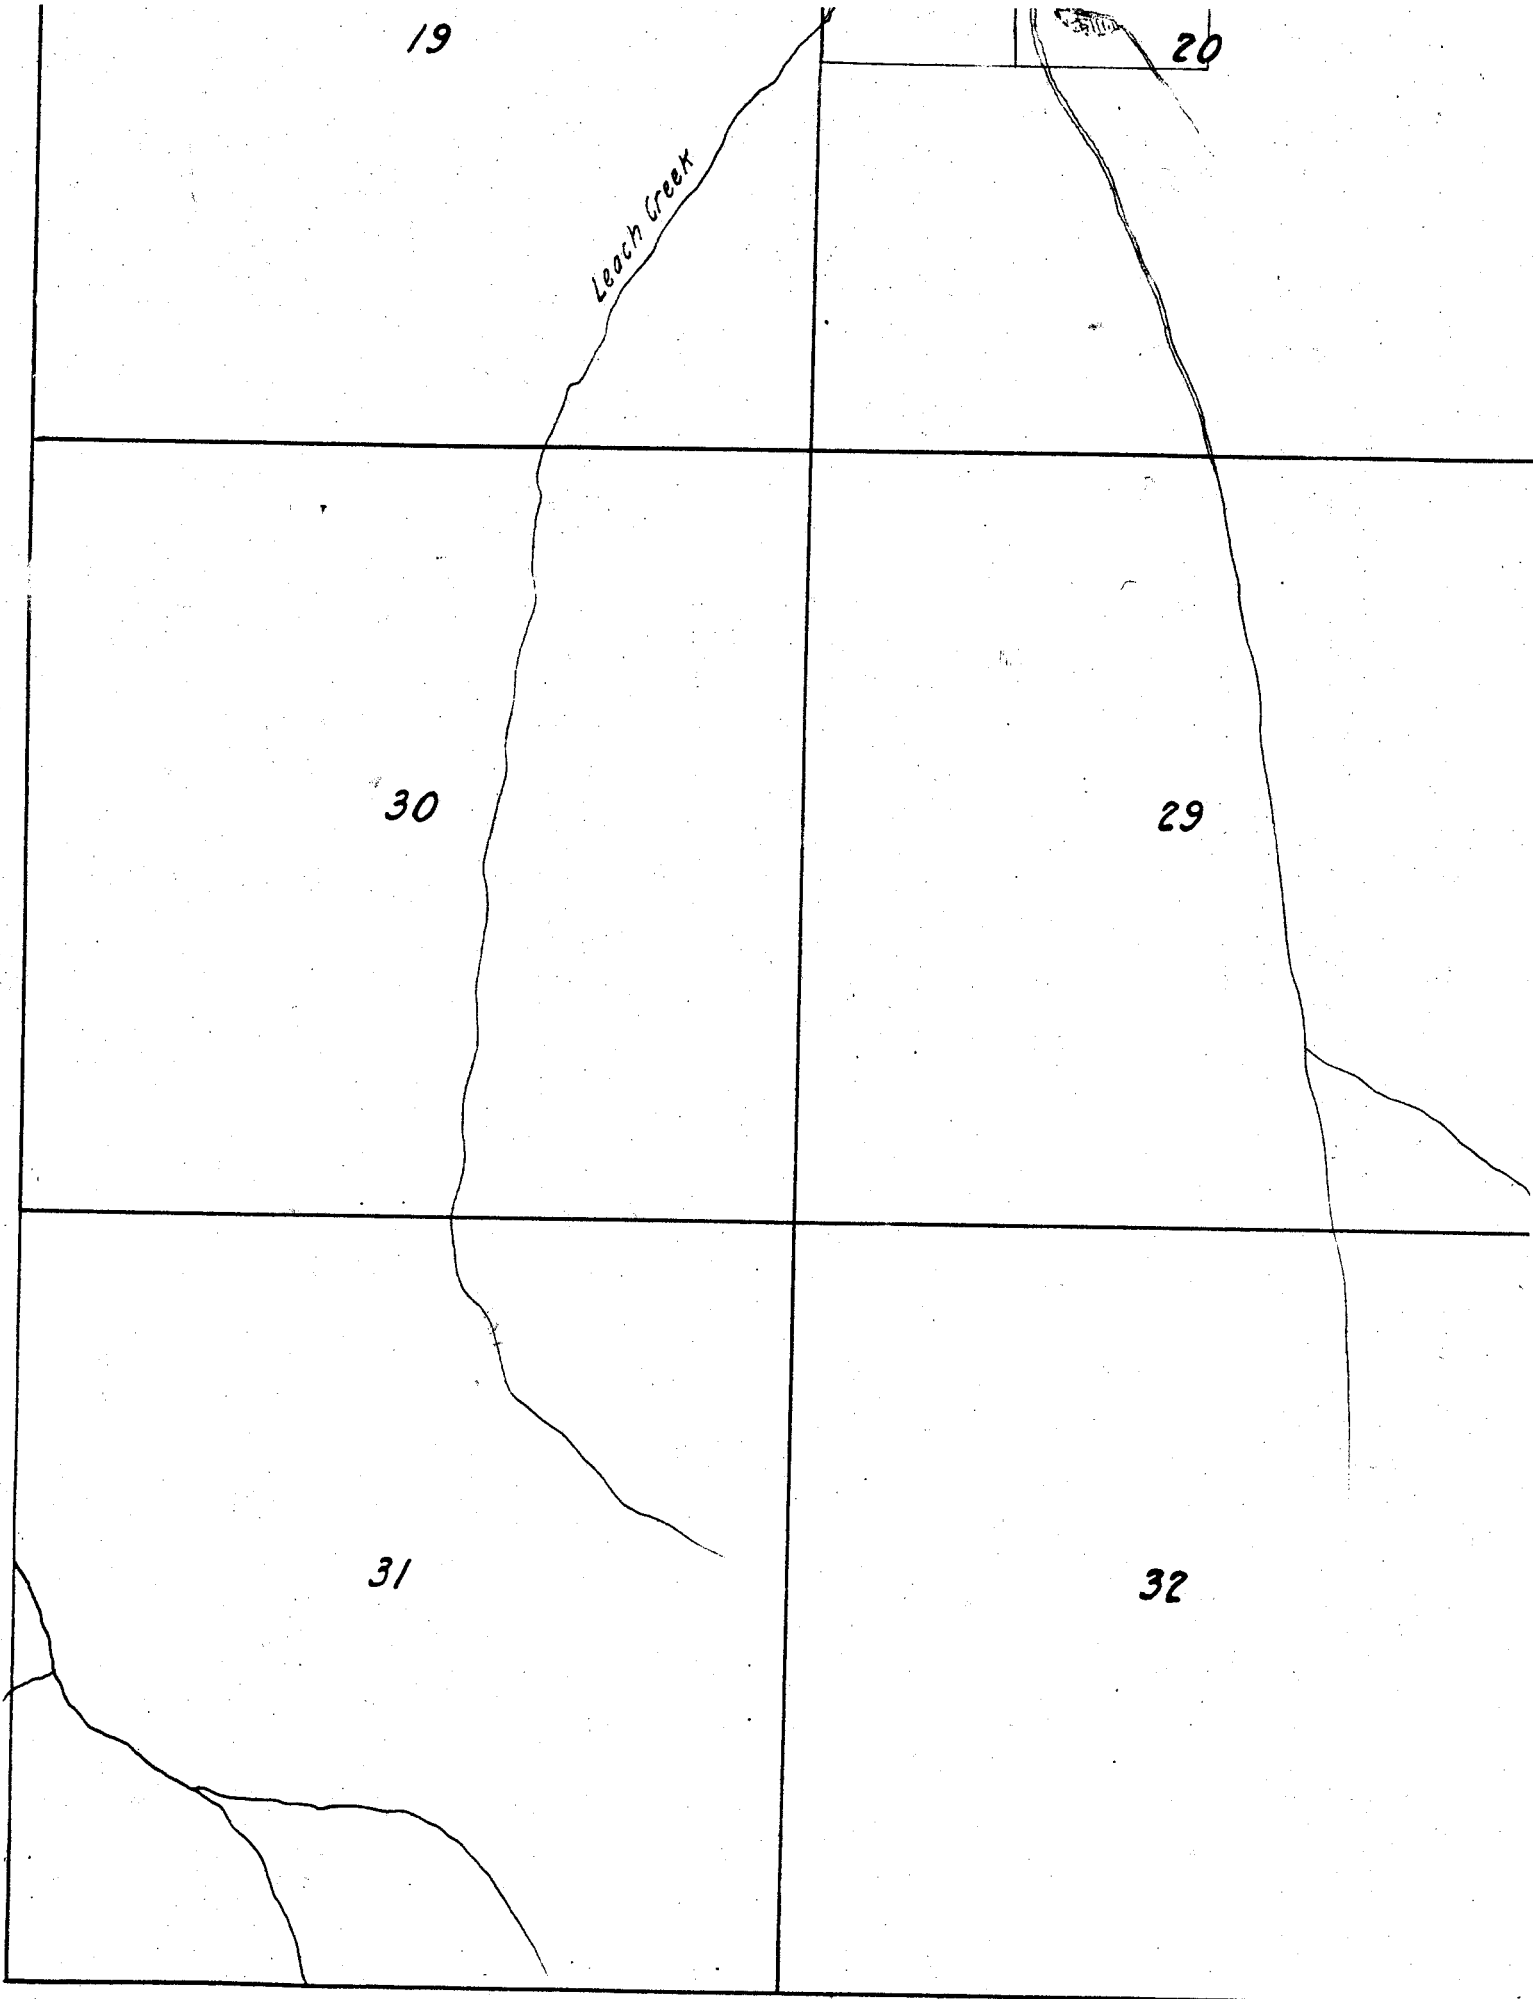

23

24

26

25

MILL CREEK

35

36

Note: - Creeks sketched in approximate location from U.S. Township plats or from Forest Service map except in vicinity of irrigated areas. Permit ditches plotted in approximate location from permit maps except in vicinity of irrigated areas.



Scale of Feet.

614 Nelson Reservoir
Per 462


28

27

33

34

Maxwell Creek

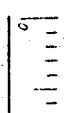


12324

16


21

22

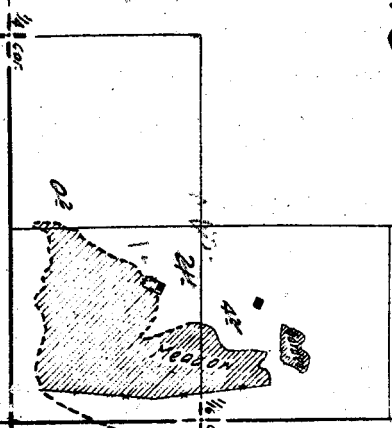


Hobson and Campbell
Porch
Surveyed Oct. 19, 1893
Per. #4325

6 M. Nelson ditch
Per. #4325

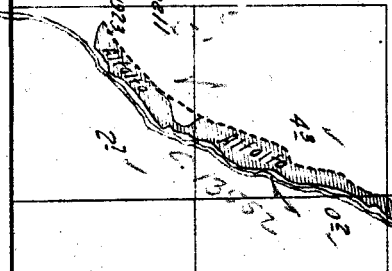

Cole Bros.

Surveyed Oct. 18

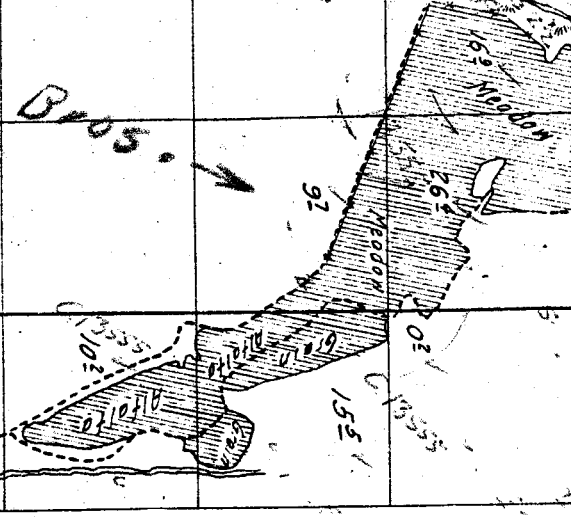

Maxwell Ditch Per. #209