



16

15

22

21

Surveyed Oct 20, 1923.

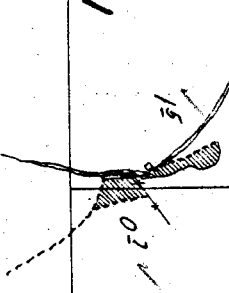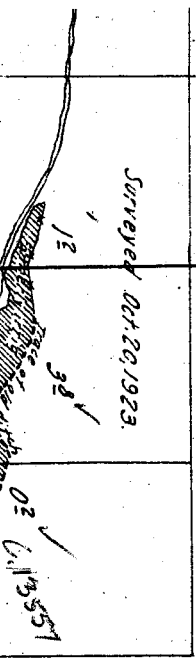

28

27

33

34



15


14

13

22

23

24

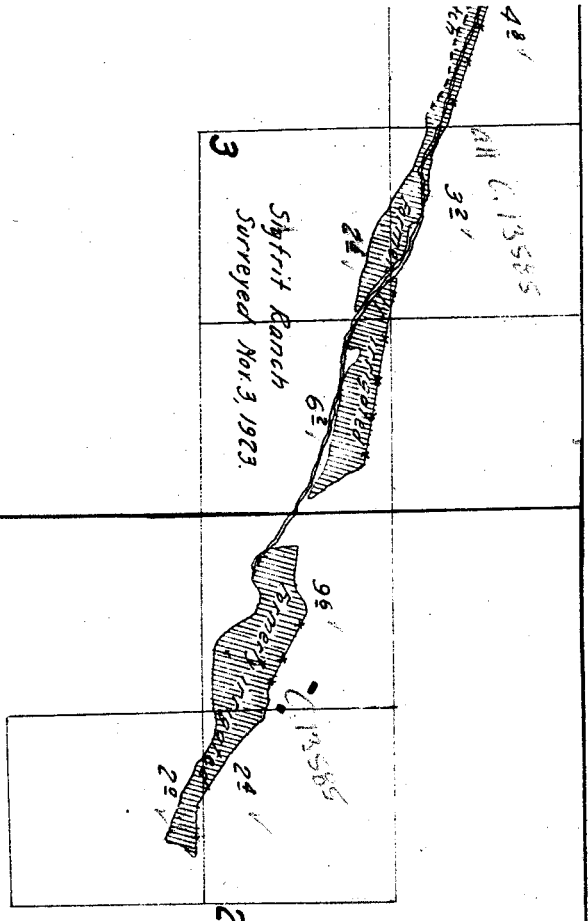

10

11


12

Township

12 S,

Range

22 E.

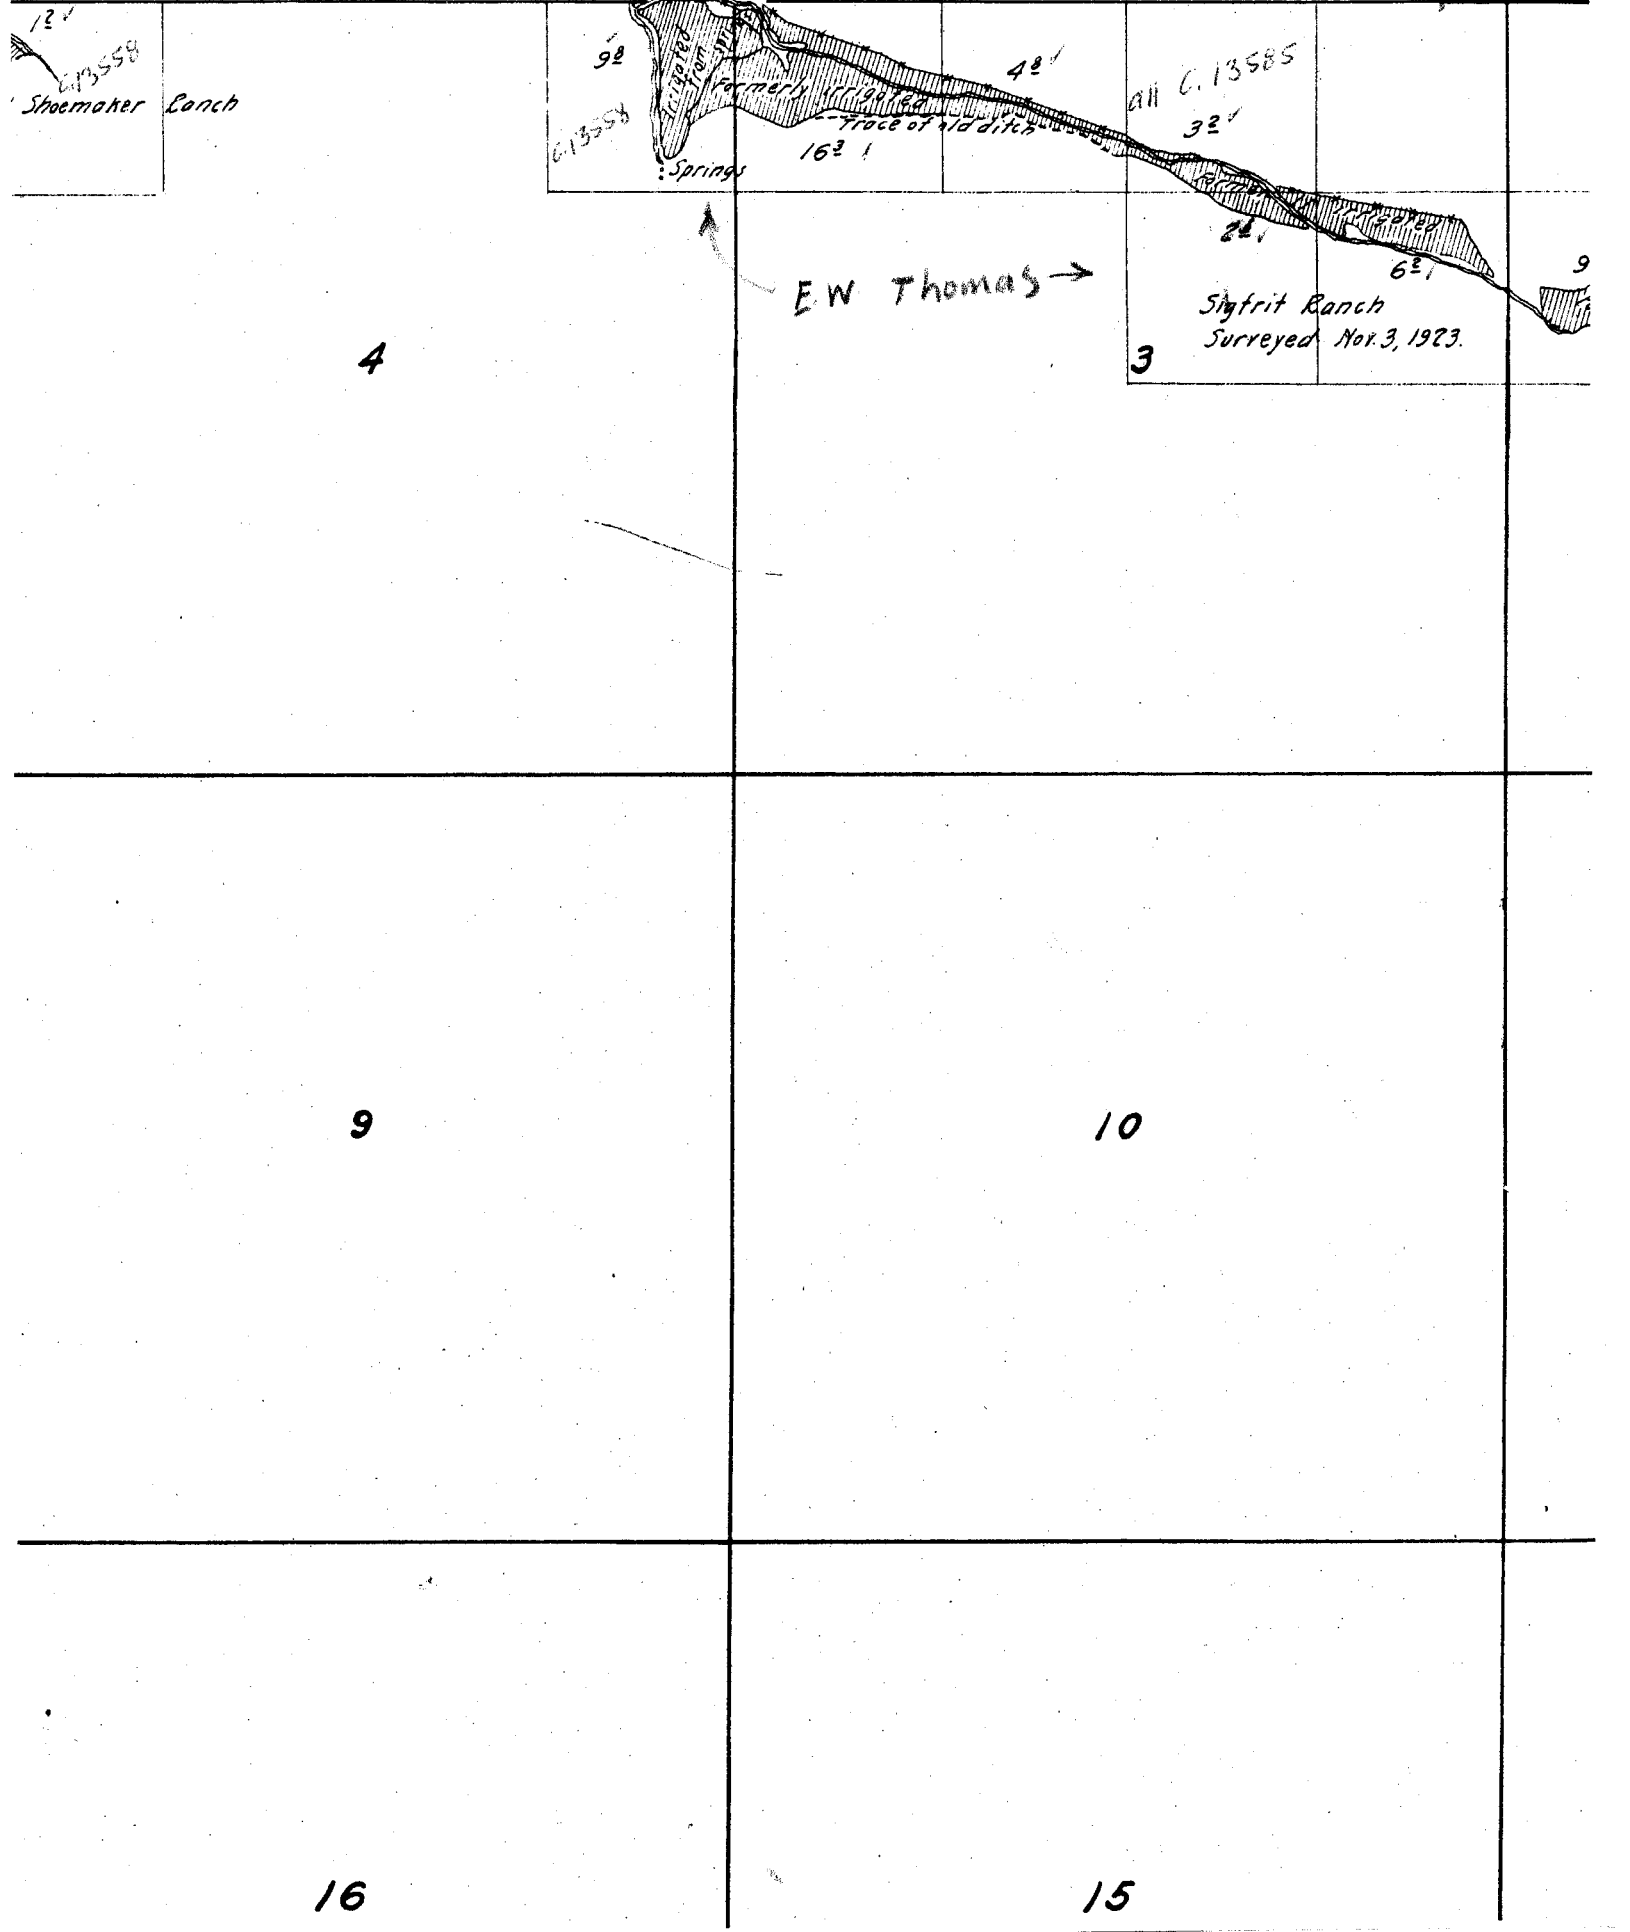

19

20


30

29

31

32

# Township 1

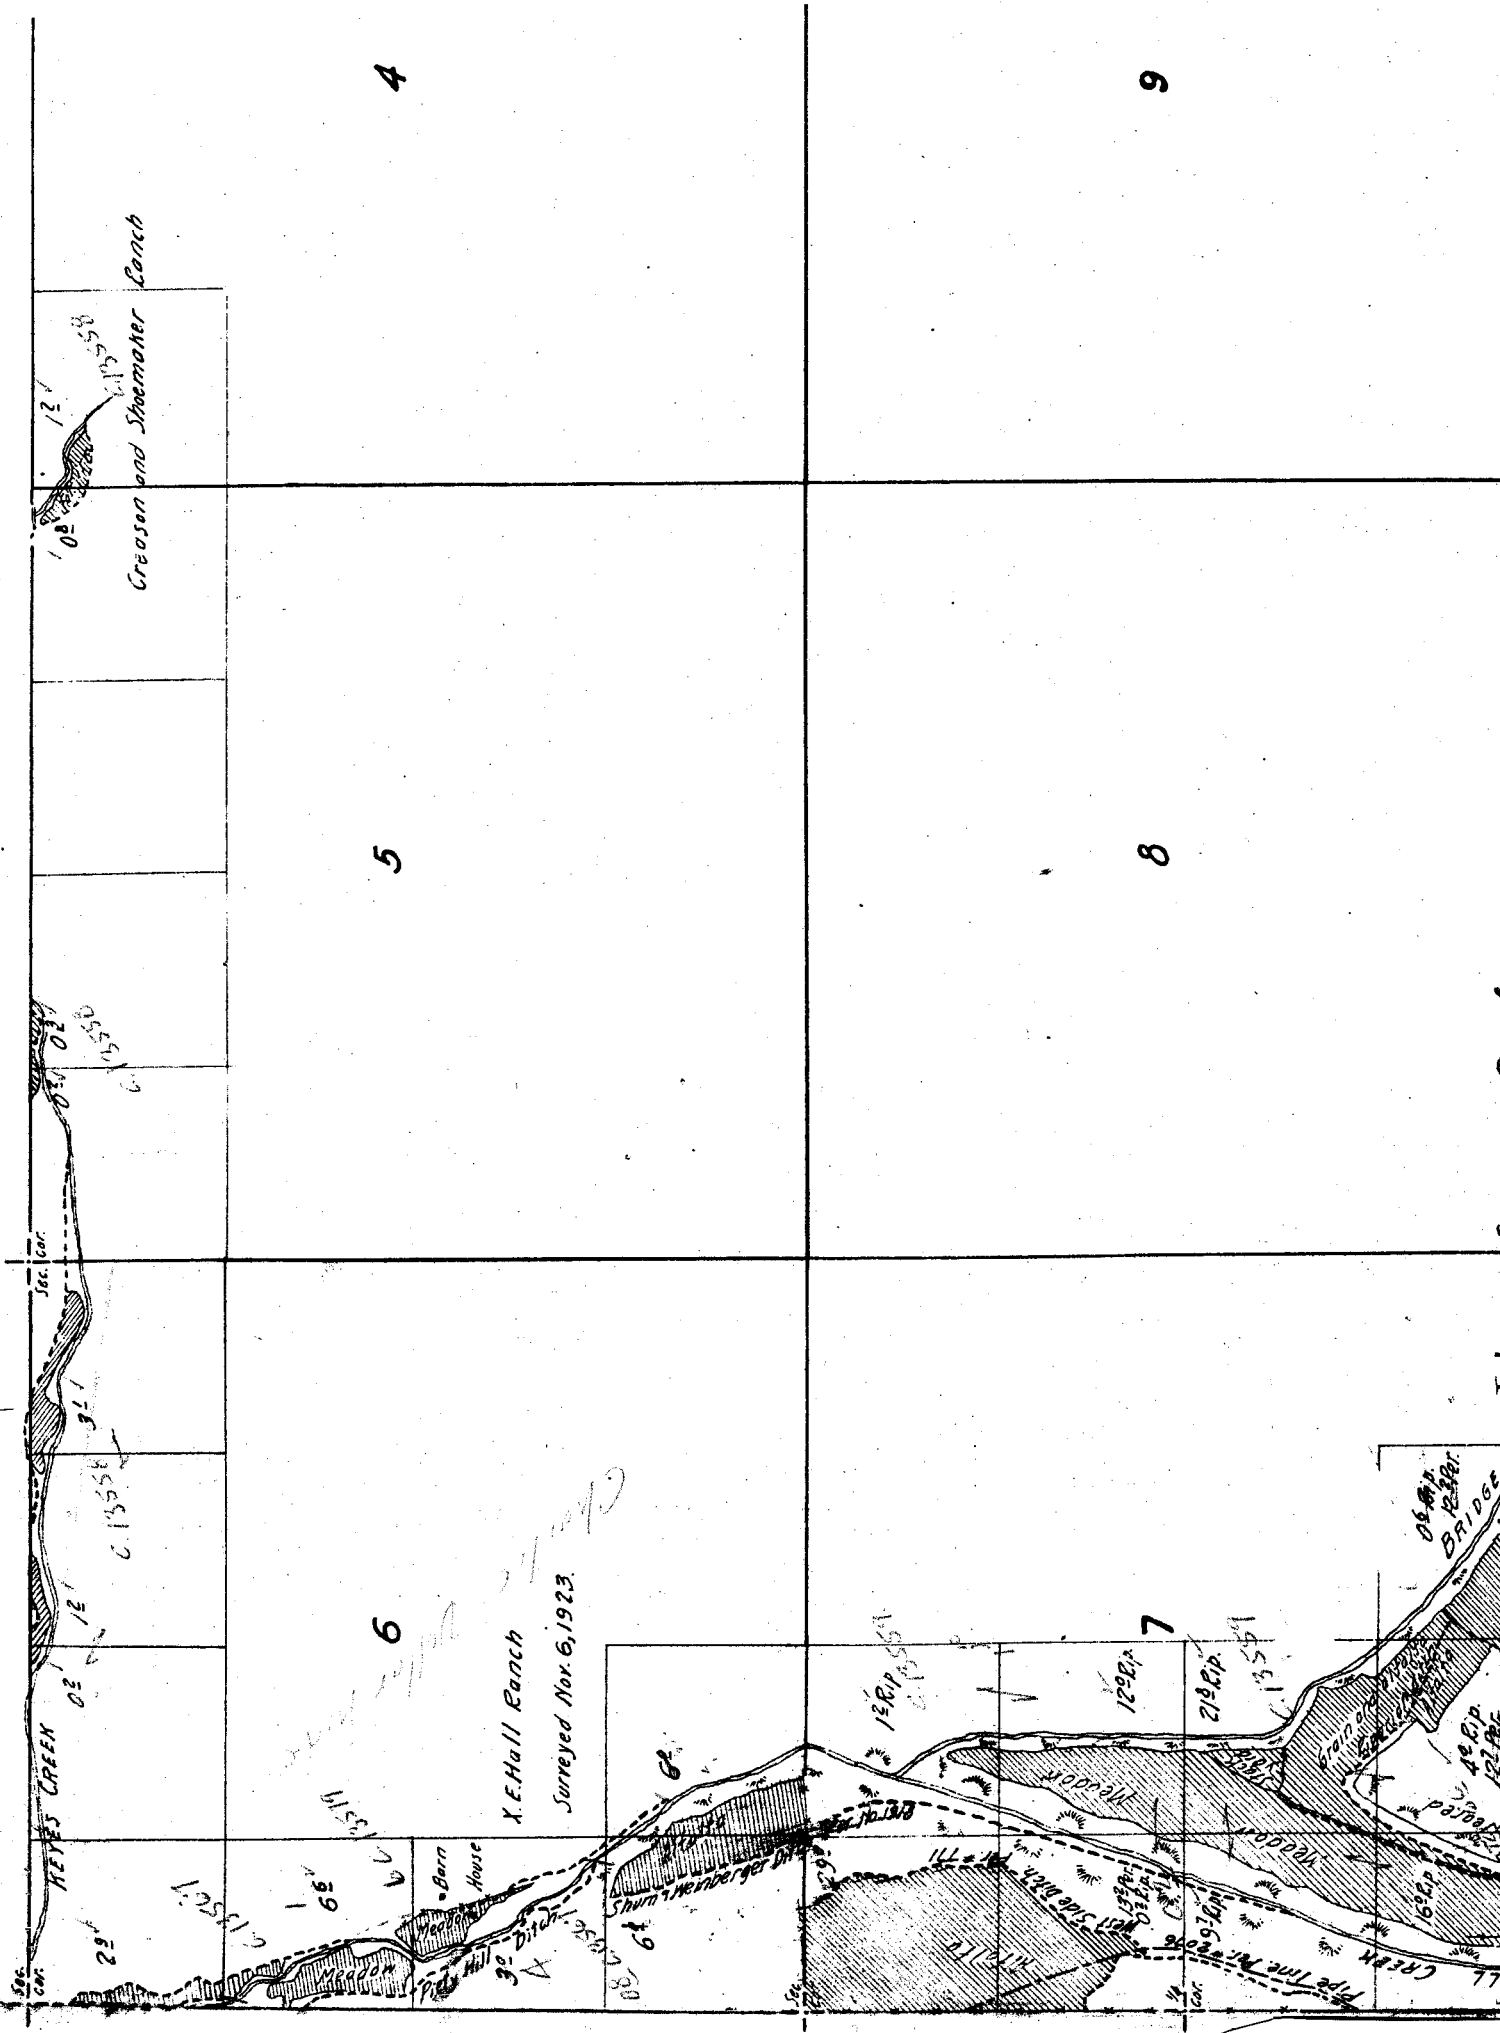

4

9

5

8

6

7

X.E. Hall Ranch  
Surveyed Nov. 6, 1923.

Creason and Shoemaker Ranch

Barr House

KEYS GREEN





























Ob. Br. BRIDGE






Johnson Co. Quid m...

Cr. on Quad maps

Johnson  
CRIDGE CREEK

Cresson and Shoemaker Ranch  
Surveyed Oct. 16, 1920

Surveyed Oct. 20, 1923

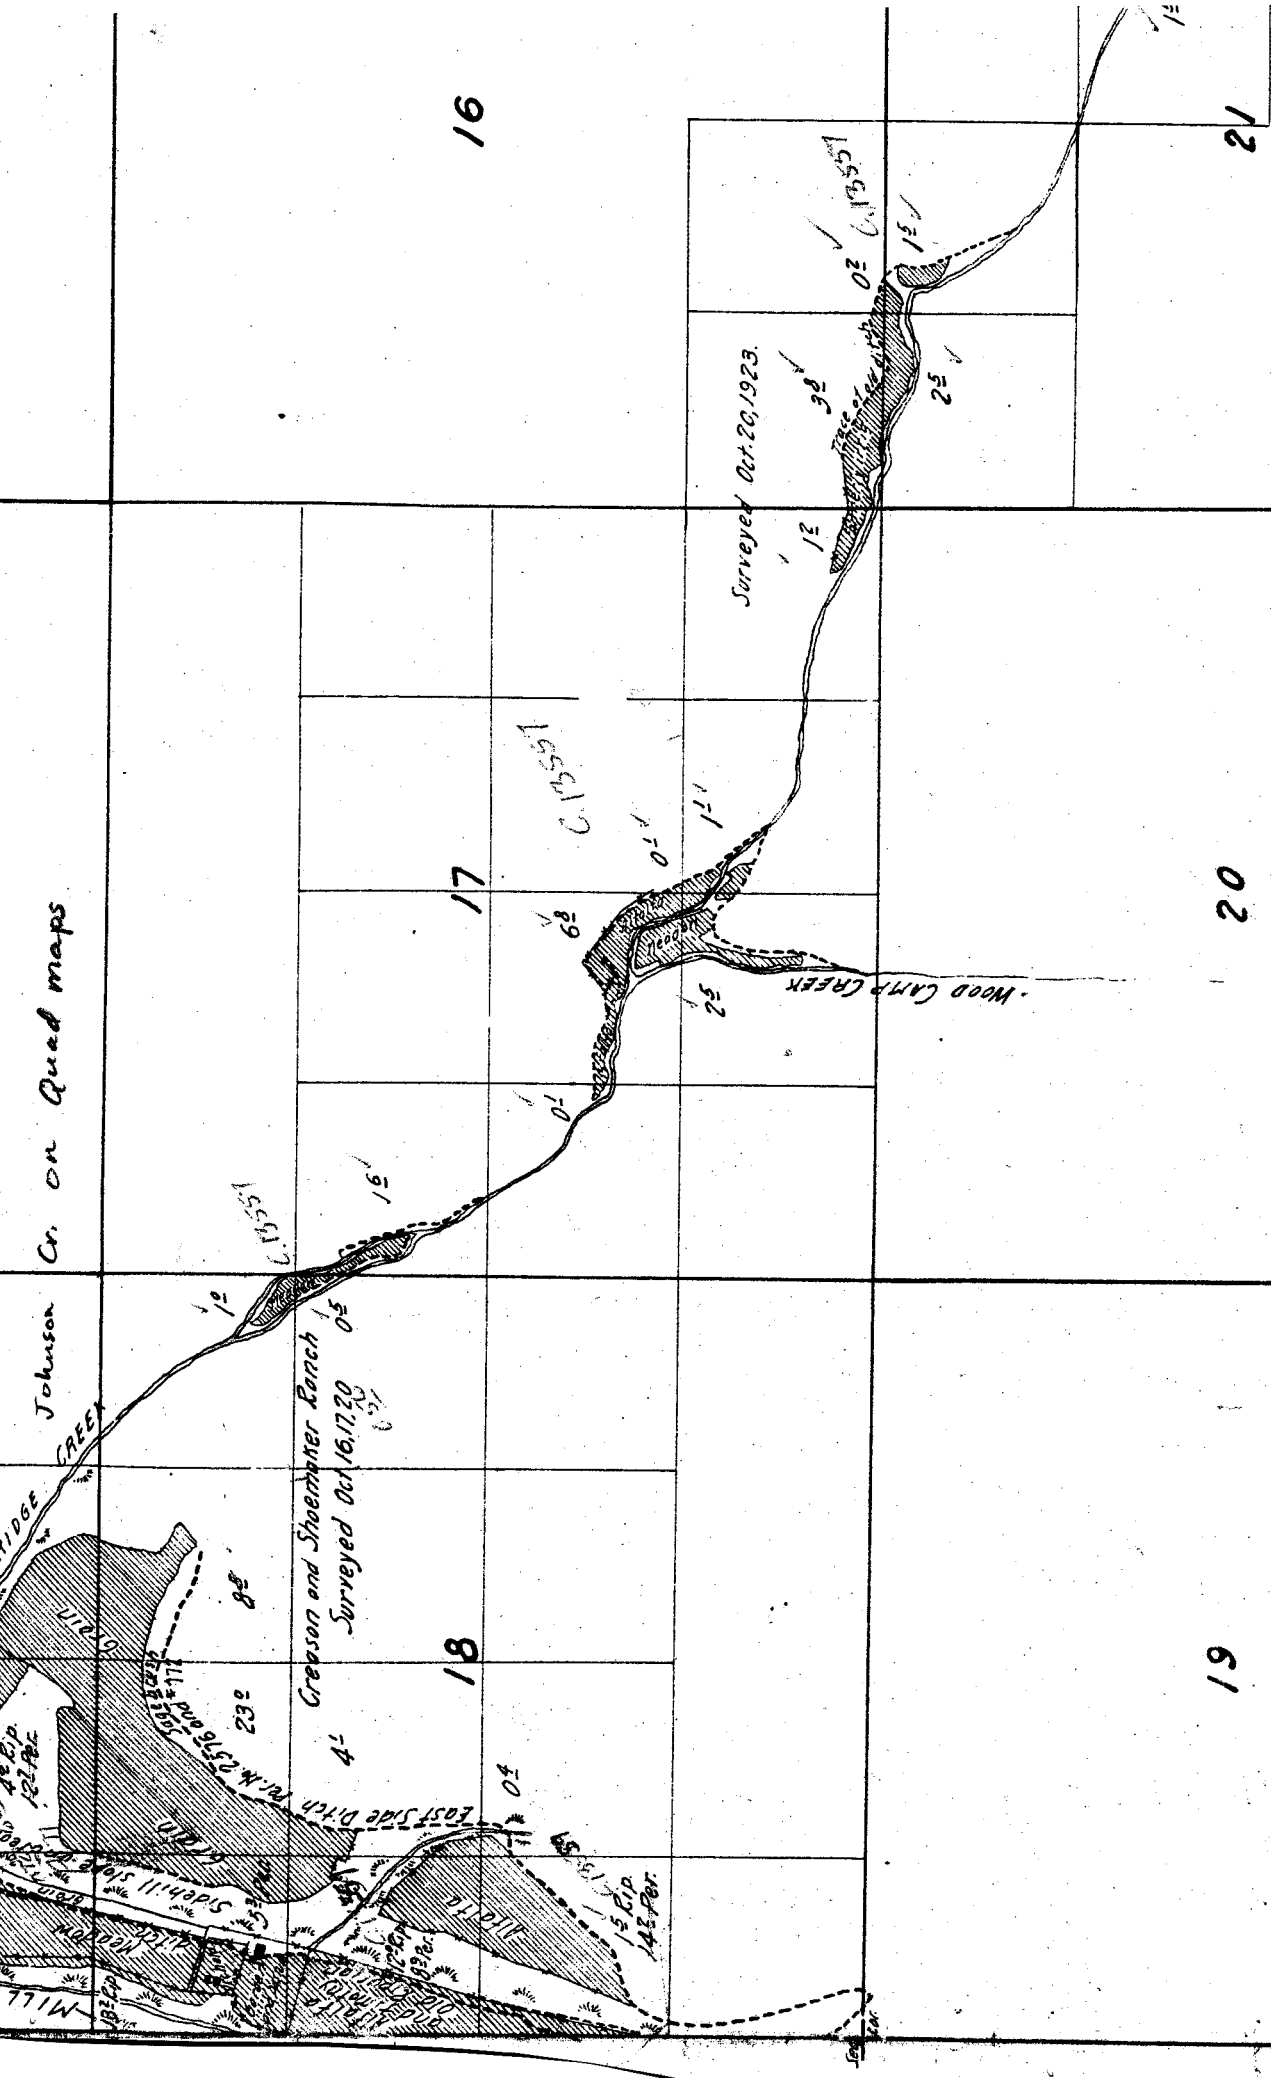

16

17

18

02

61

21




East Side Ditch  






23


24

26

25

35

36

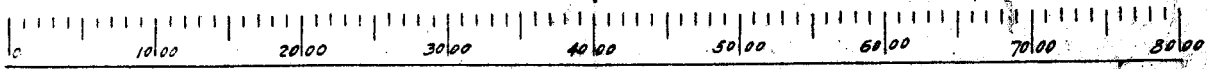

Scale of Feet.

26" x 27"