

6

7

18

8

17

Ben Taylor Ranch  
Surveyed Oct. 8, 9, 1923

5

96

22

2021

42

02

05

122

42

22


92

32



52

1/4 Cor.

Sec. Cor.

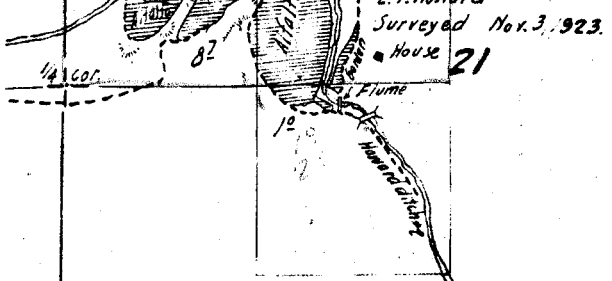

22

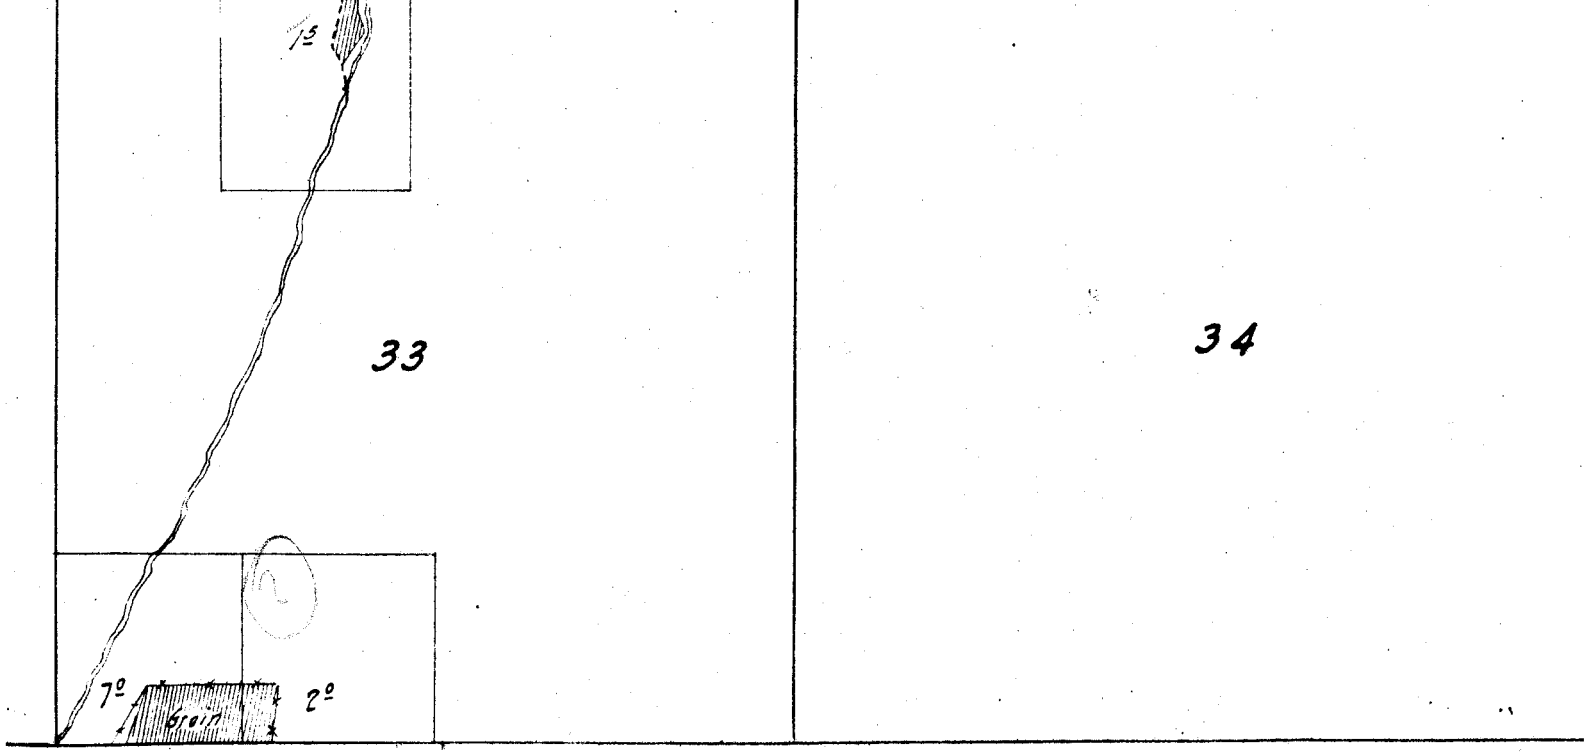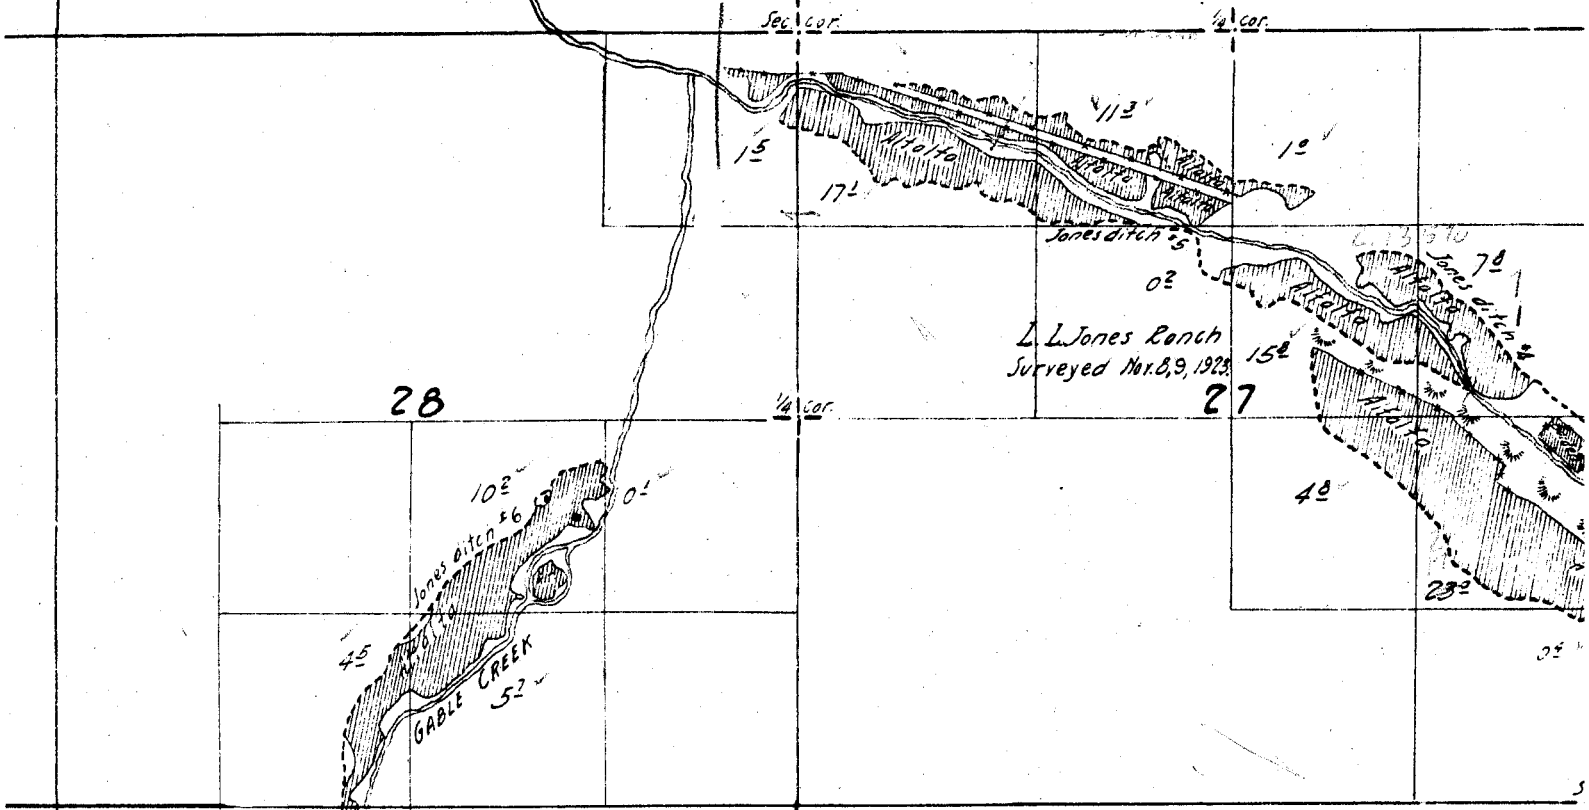

E.

6-1-1

2


1

11

12

14

13

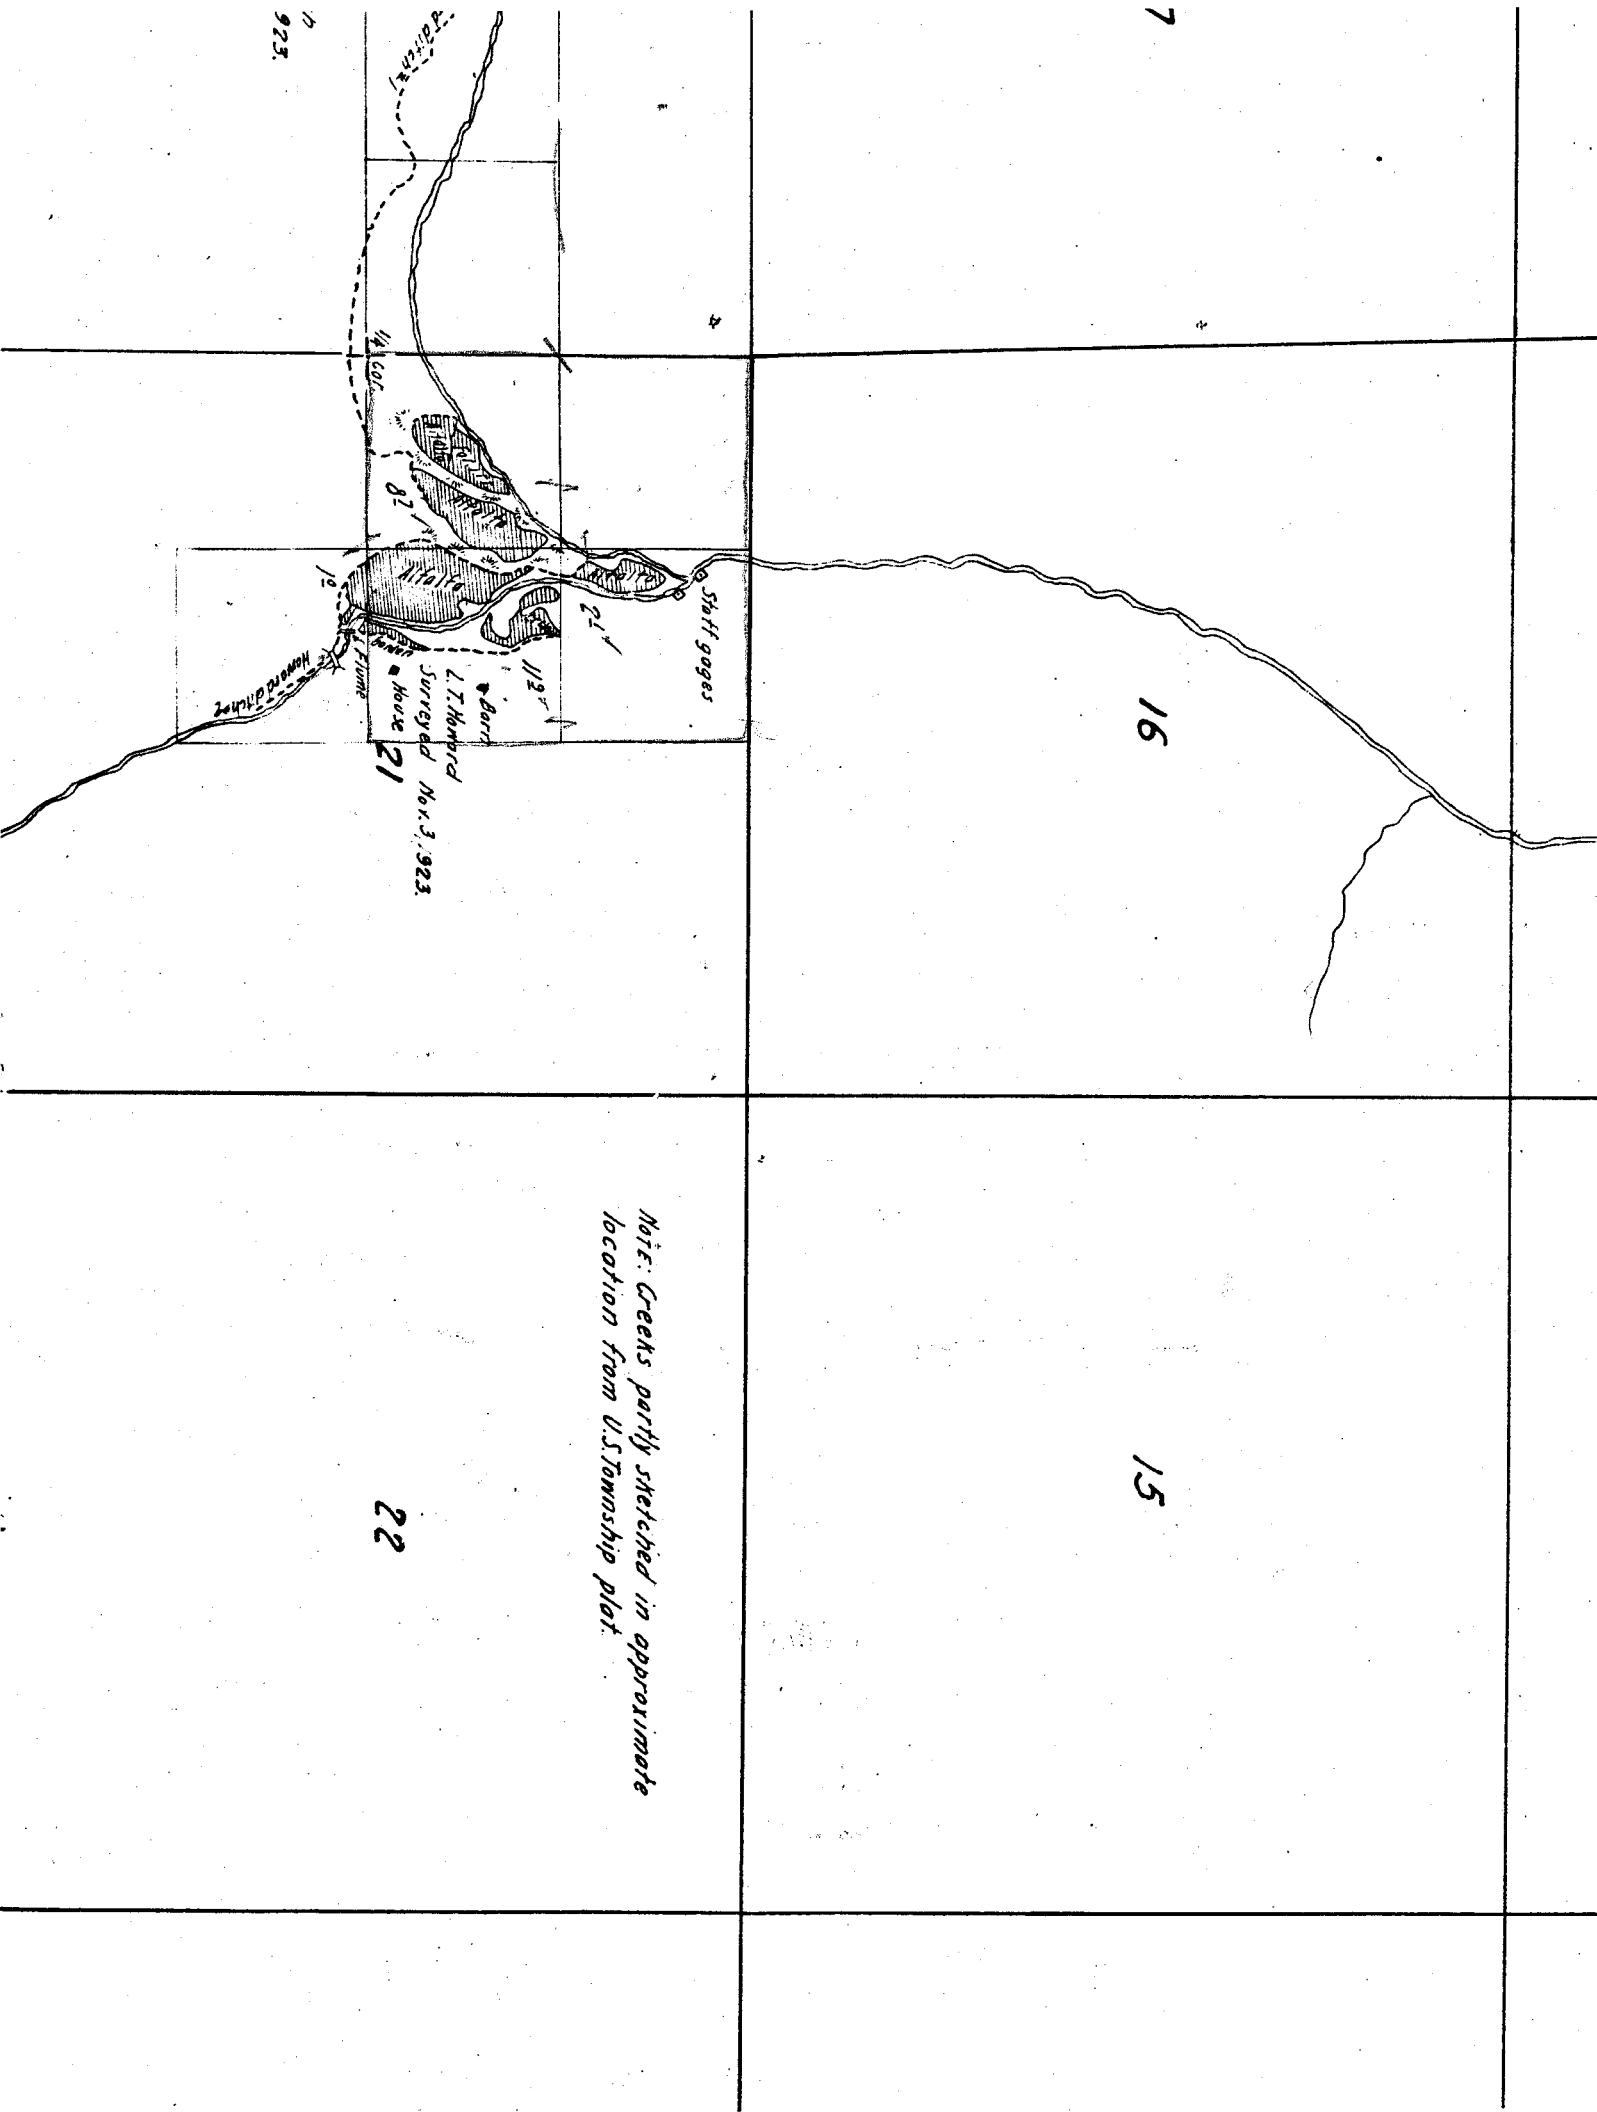

*Note: Creeks partly sketched in approximate location from U.S. Township plat.*


Township


11 S.

Range

21 E.

V. Ranch  
Oct 8, 9, 1923  
5

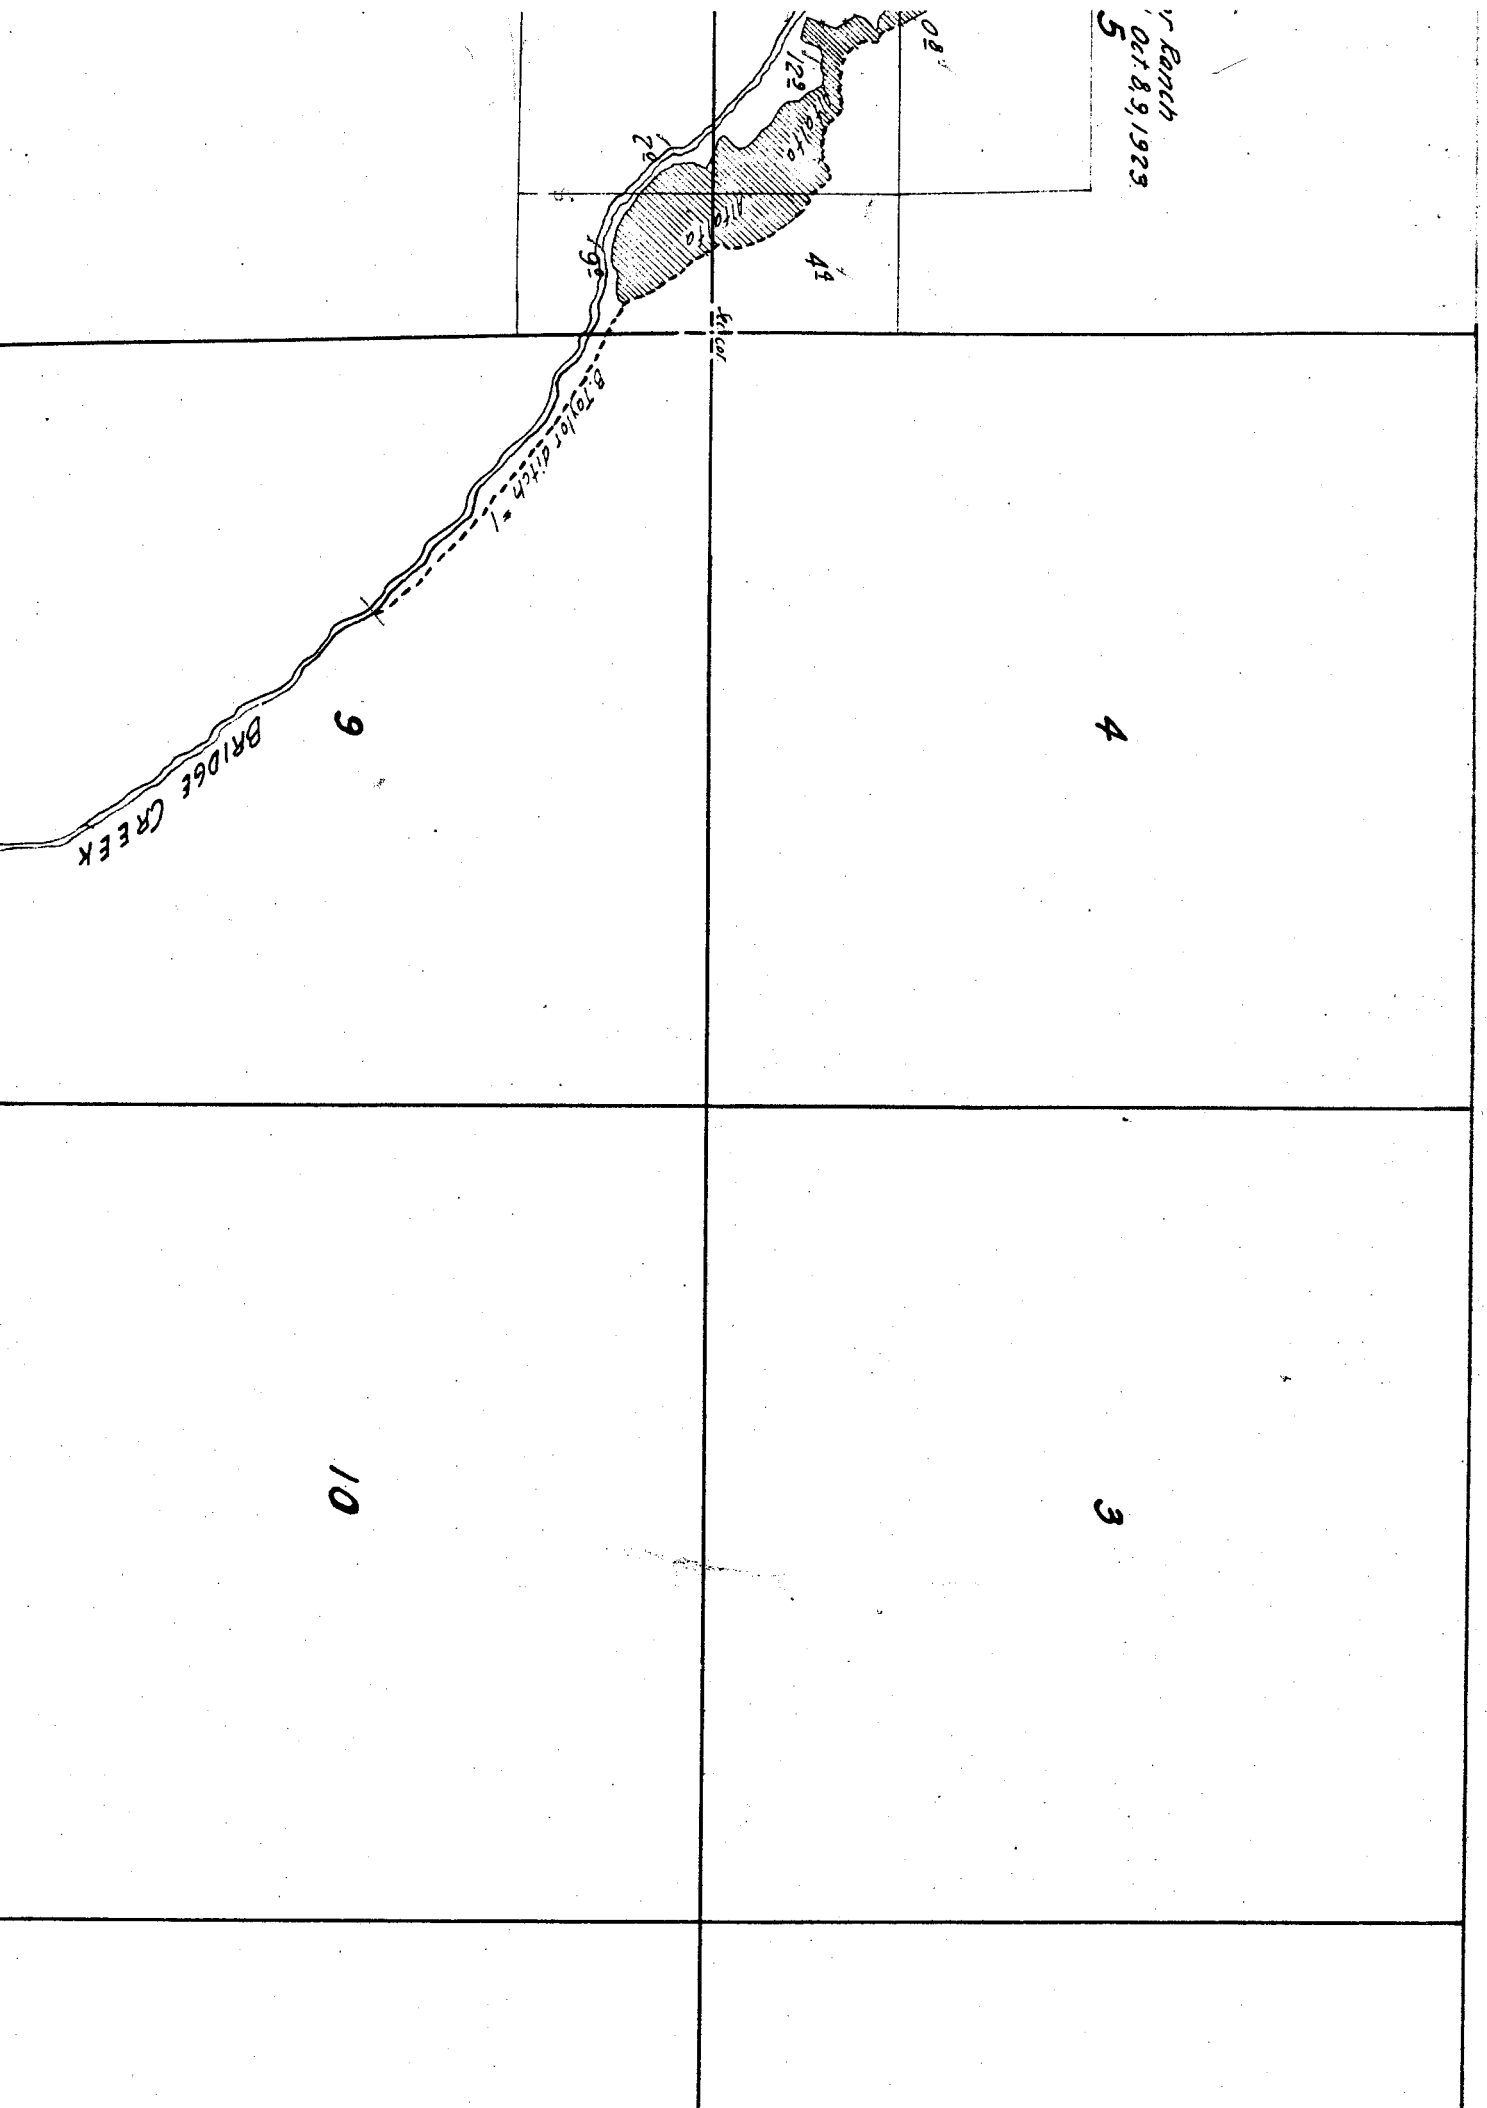

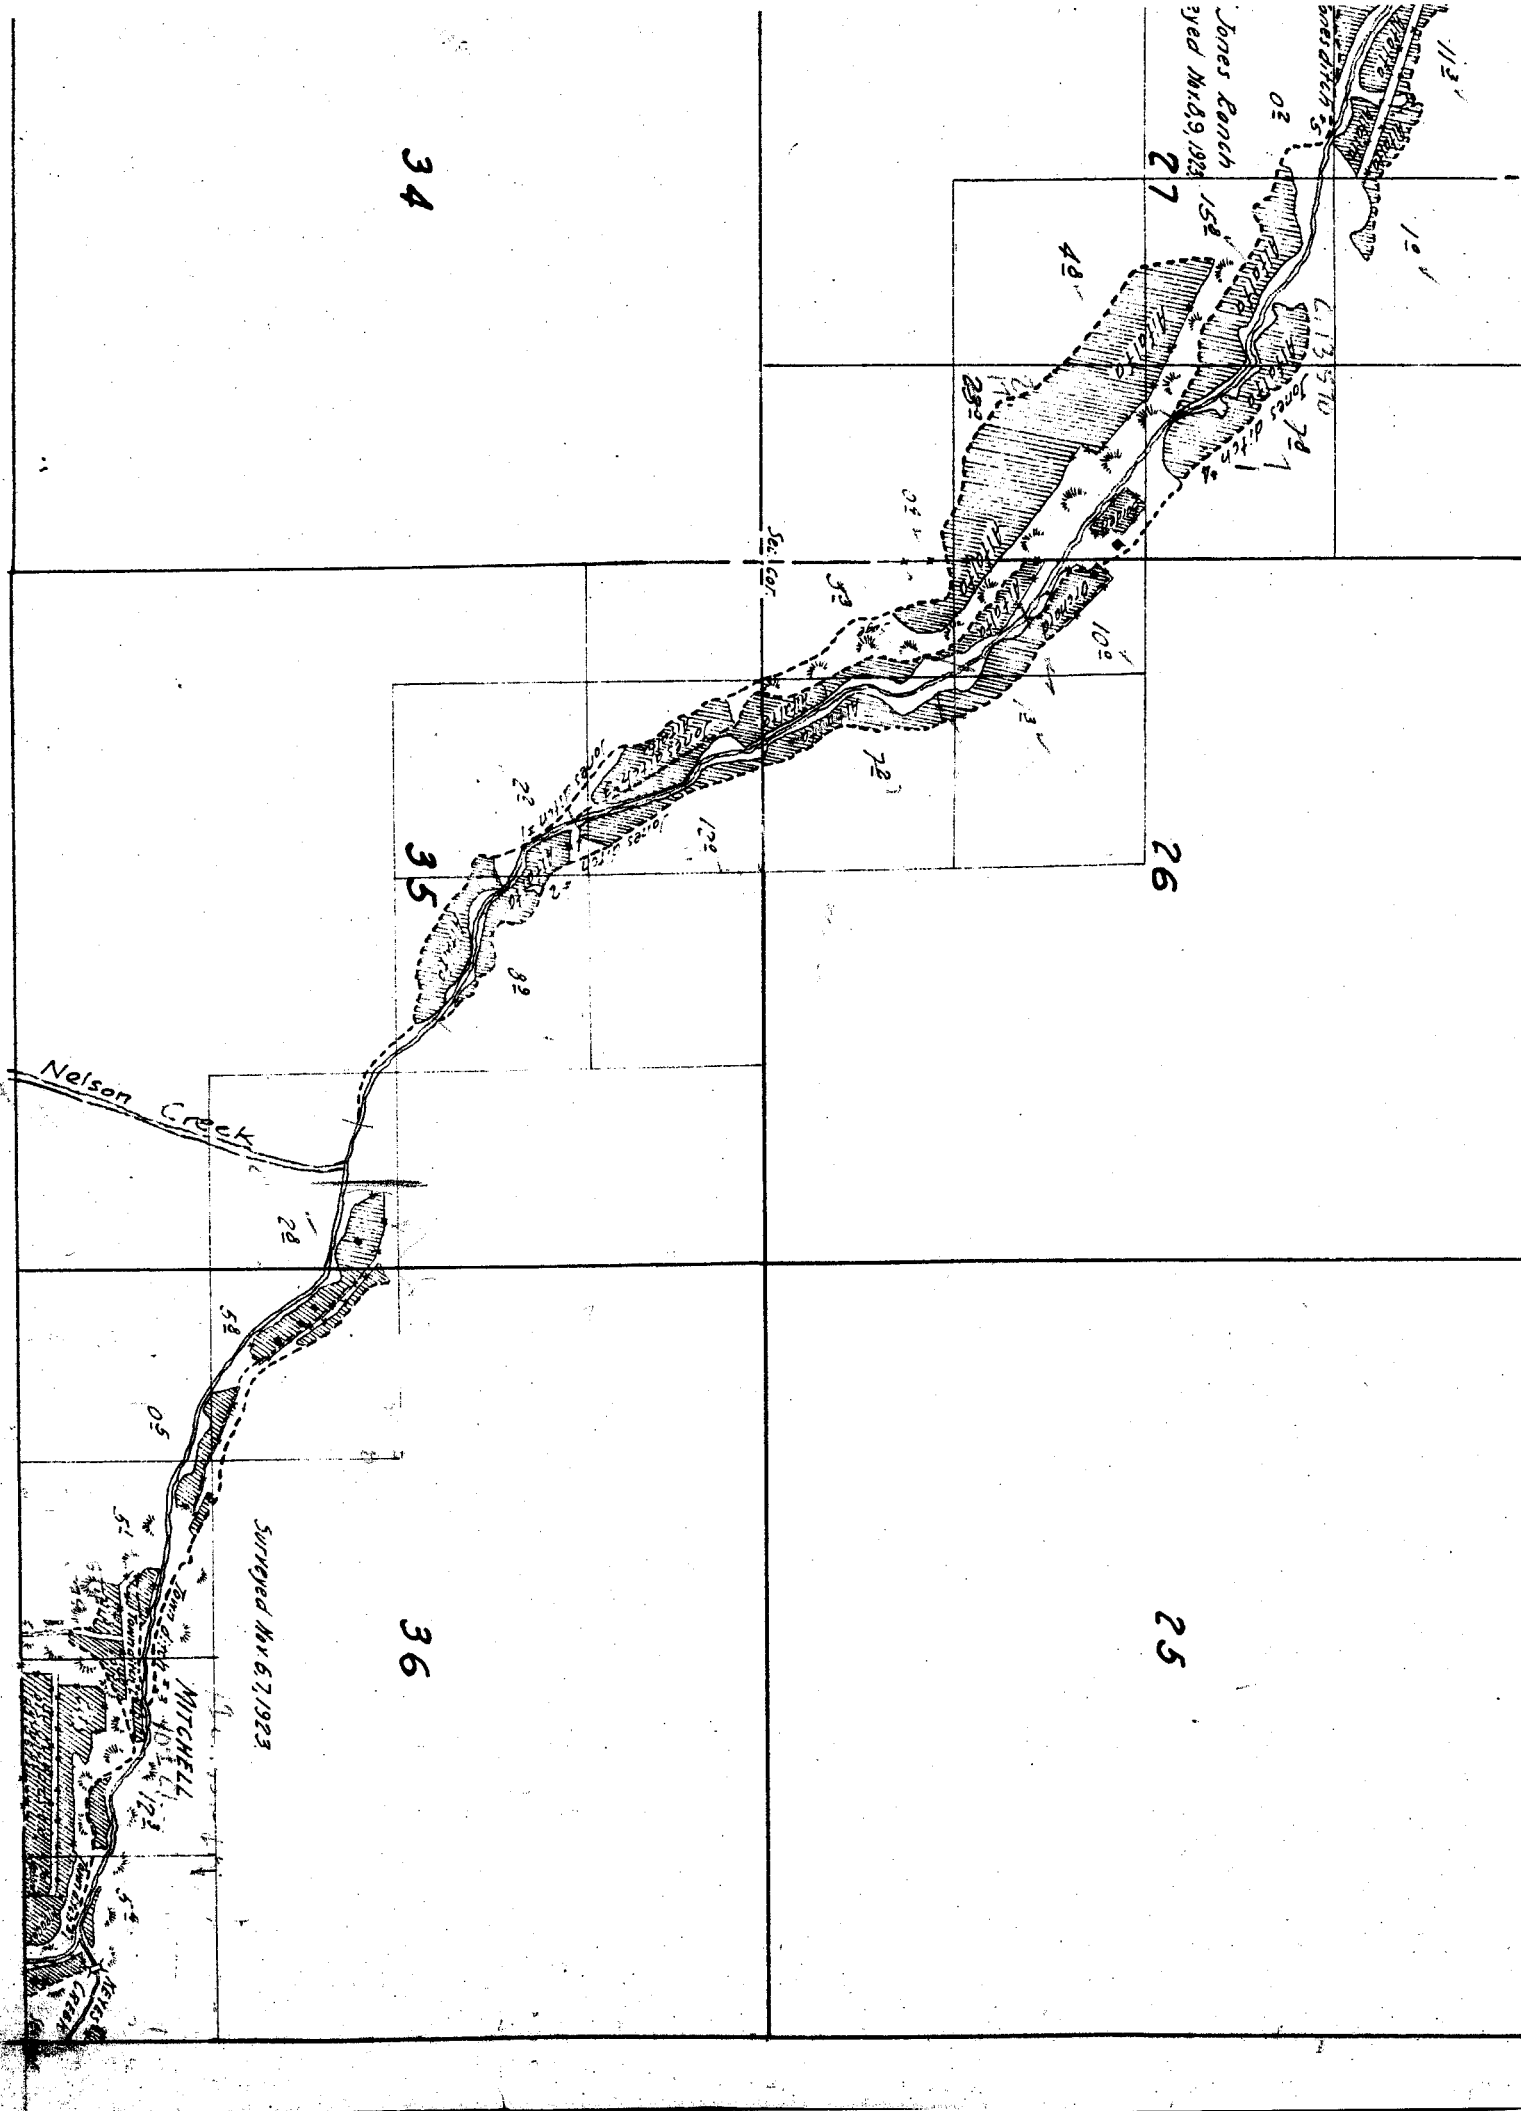

15

14

13

*is partly sketched in approximate  
from U.S. Township plat.*

22

23

24


1/2 acre

16


17

18

19

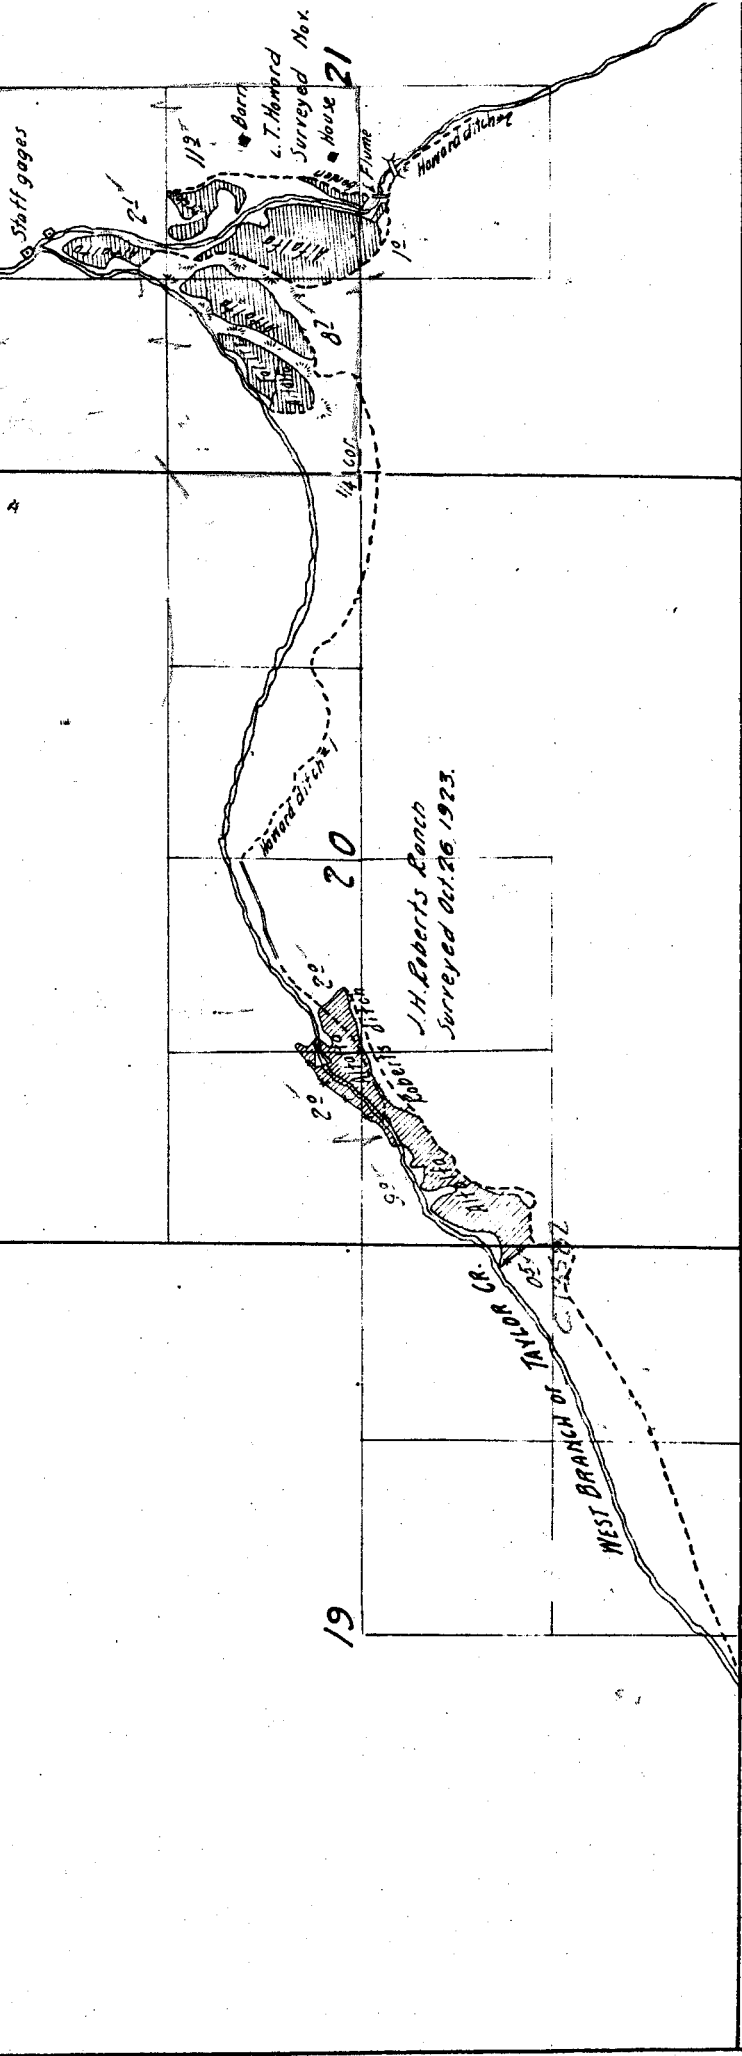



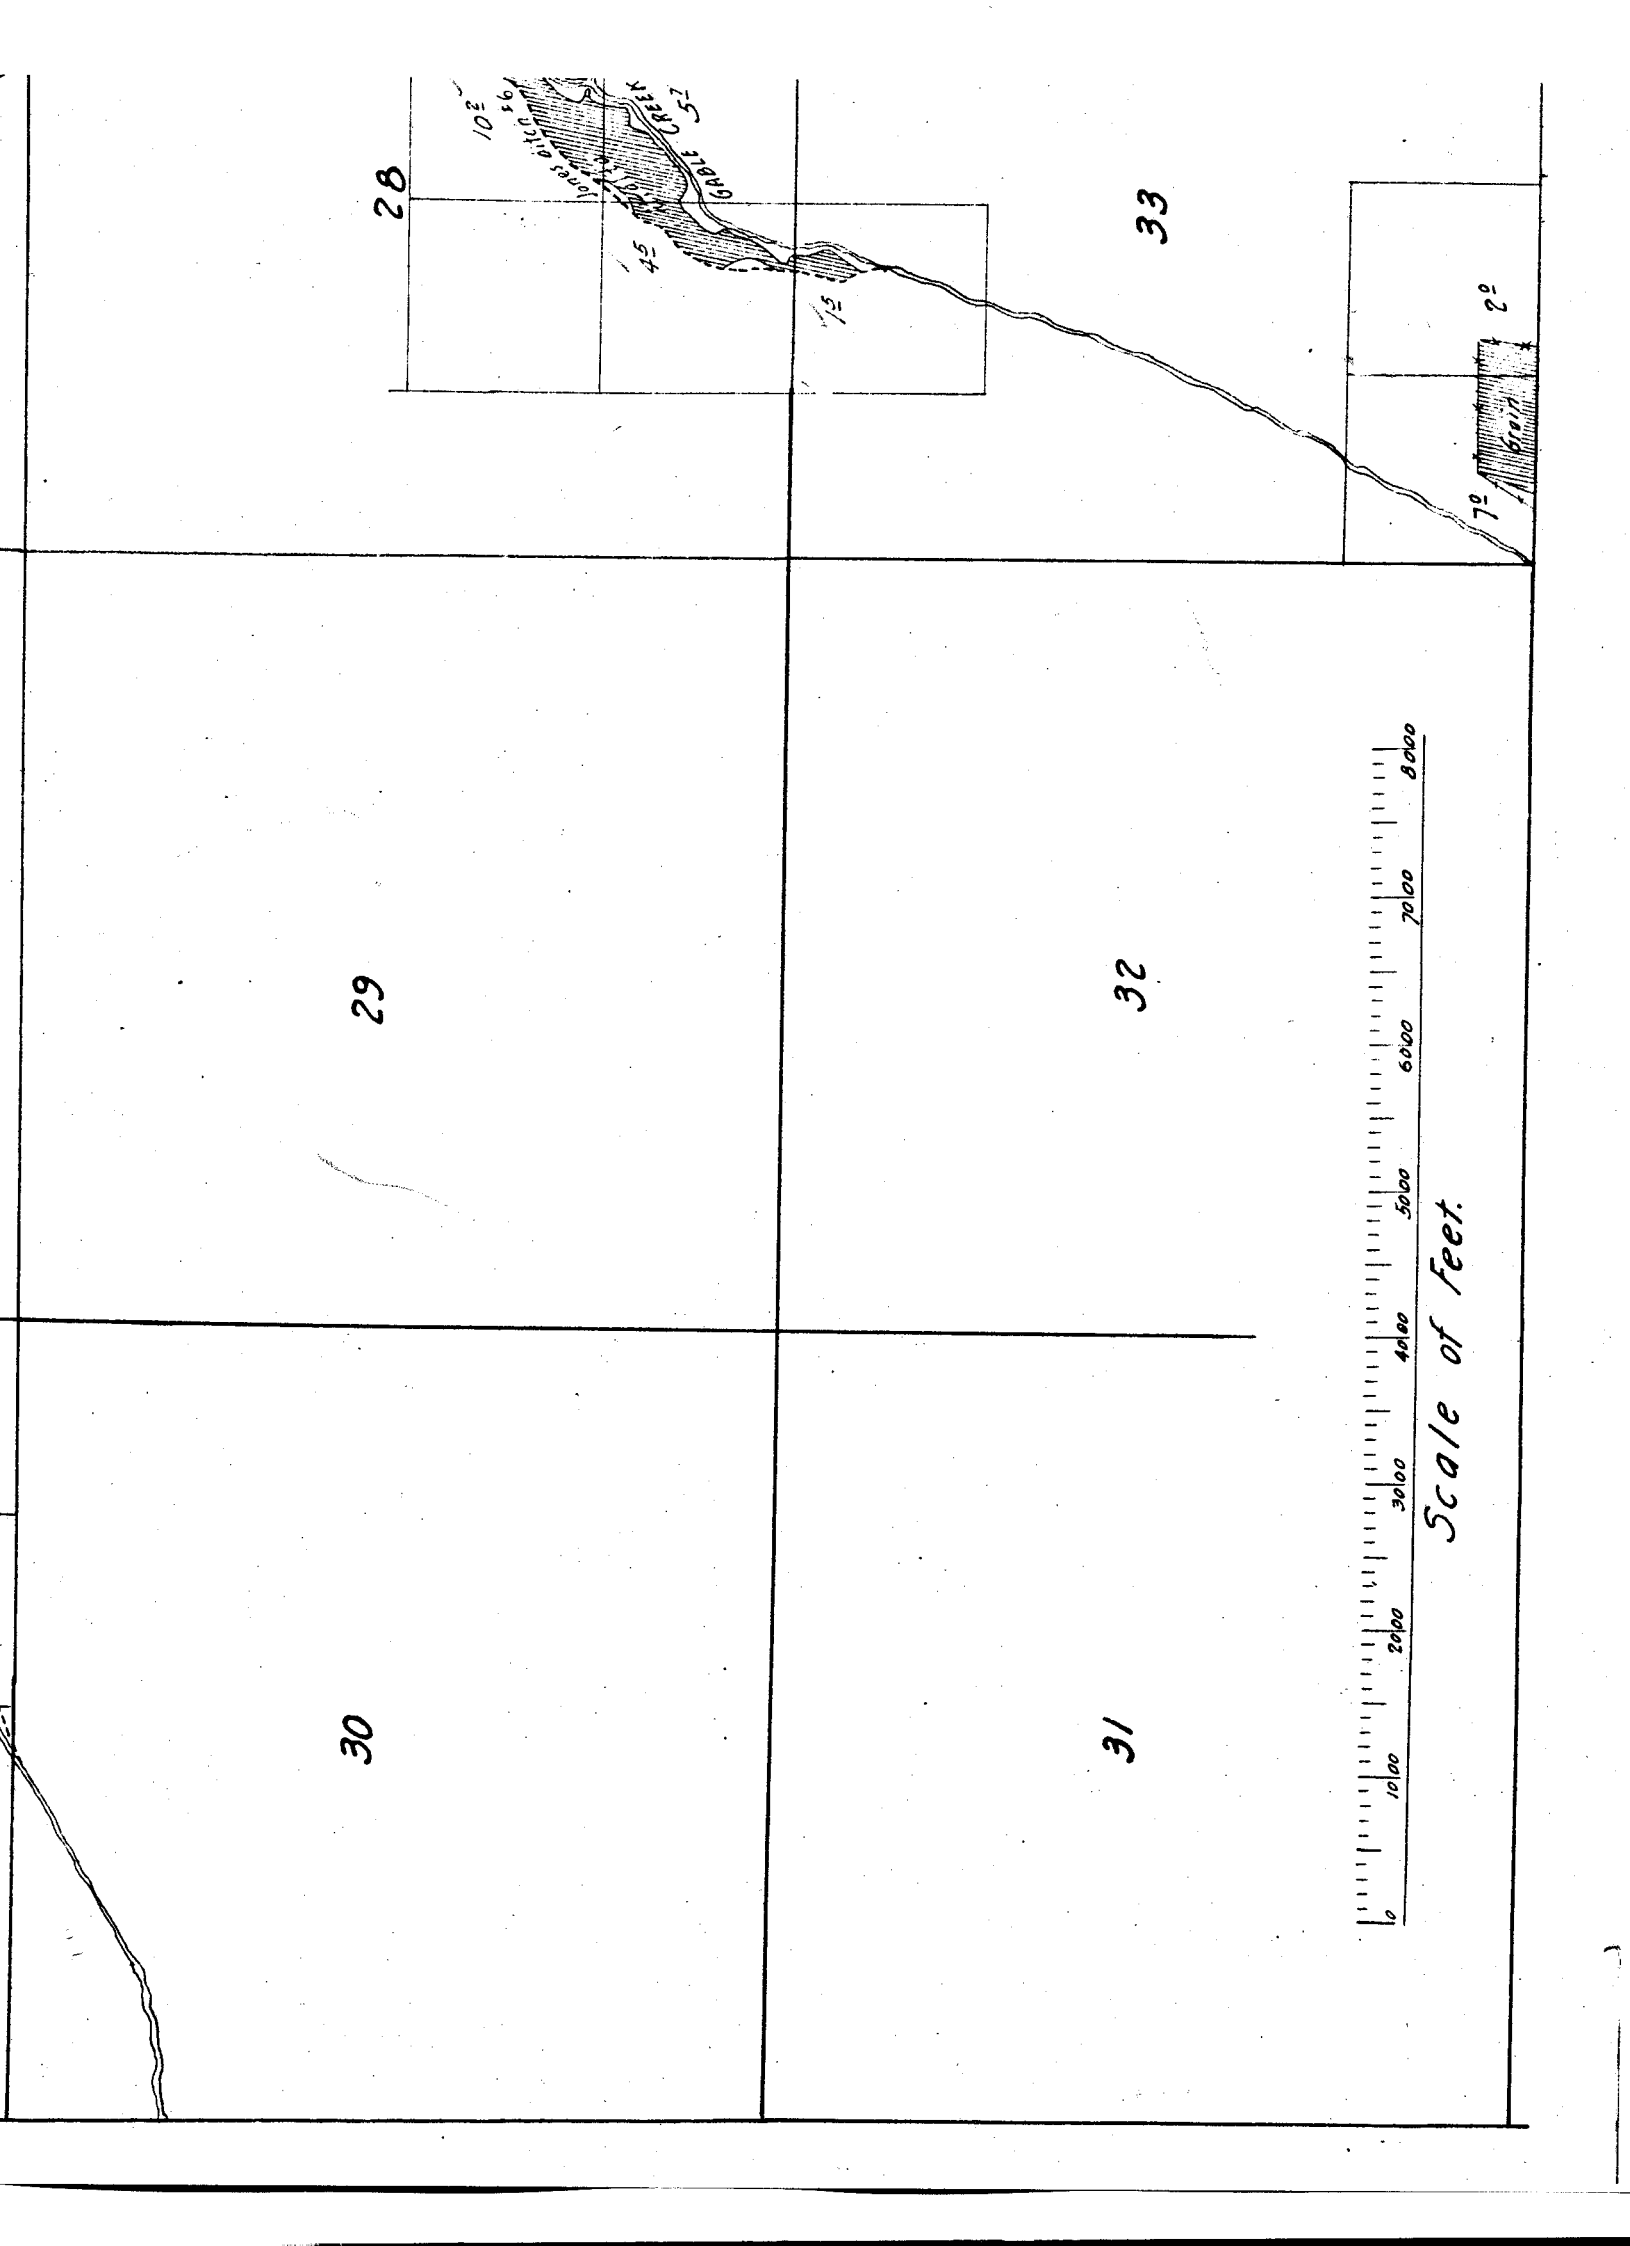

28


33

29

32

30

31

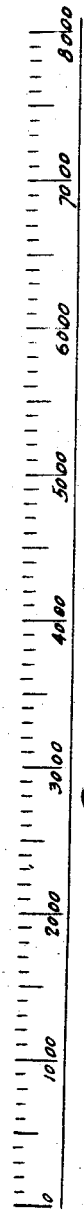

Scale of Feet.

LONGS POINT  
CABLE  
55  
45  
301  
93

70  
51  
20