

6 M. Nelson Reservoir
T.R. 462

28

27

33

34

Maxwell Creek

6

23

24

26


25

MILL CREEK

35

36

Note: - Greers sketched in approximate location
from U.S. Township plats or from Forest Service
map except in vicinity of irrigated areas.
Permit ditches plotted in approximate location
from permit maps except in vicinity of irriga-
ted areas.

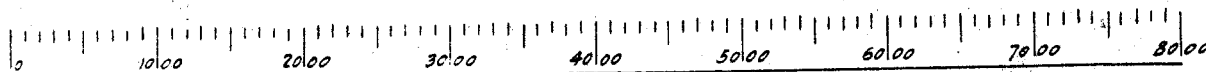

Scale of Feet.

19

20

Leach Creek

30

29

31

32

[illegible]

12

19

18

7/7

20

Surveyed Oct. 17, 23 and Nov 23, 24.

F. Wright Ranch

Approved Oct-1-1923

John W. Brackett,

Surveyed May 22, 24


S. Payne Leach


Surveyed Oct. 27, 1923.

J. W. Dove Ranch

DL 121 X 3
13W

Leach Creek

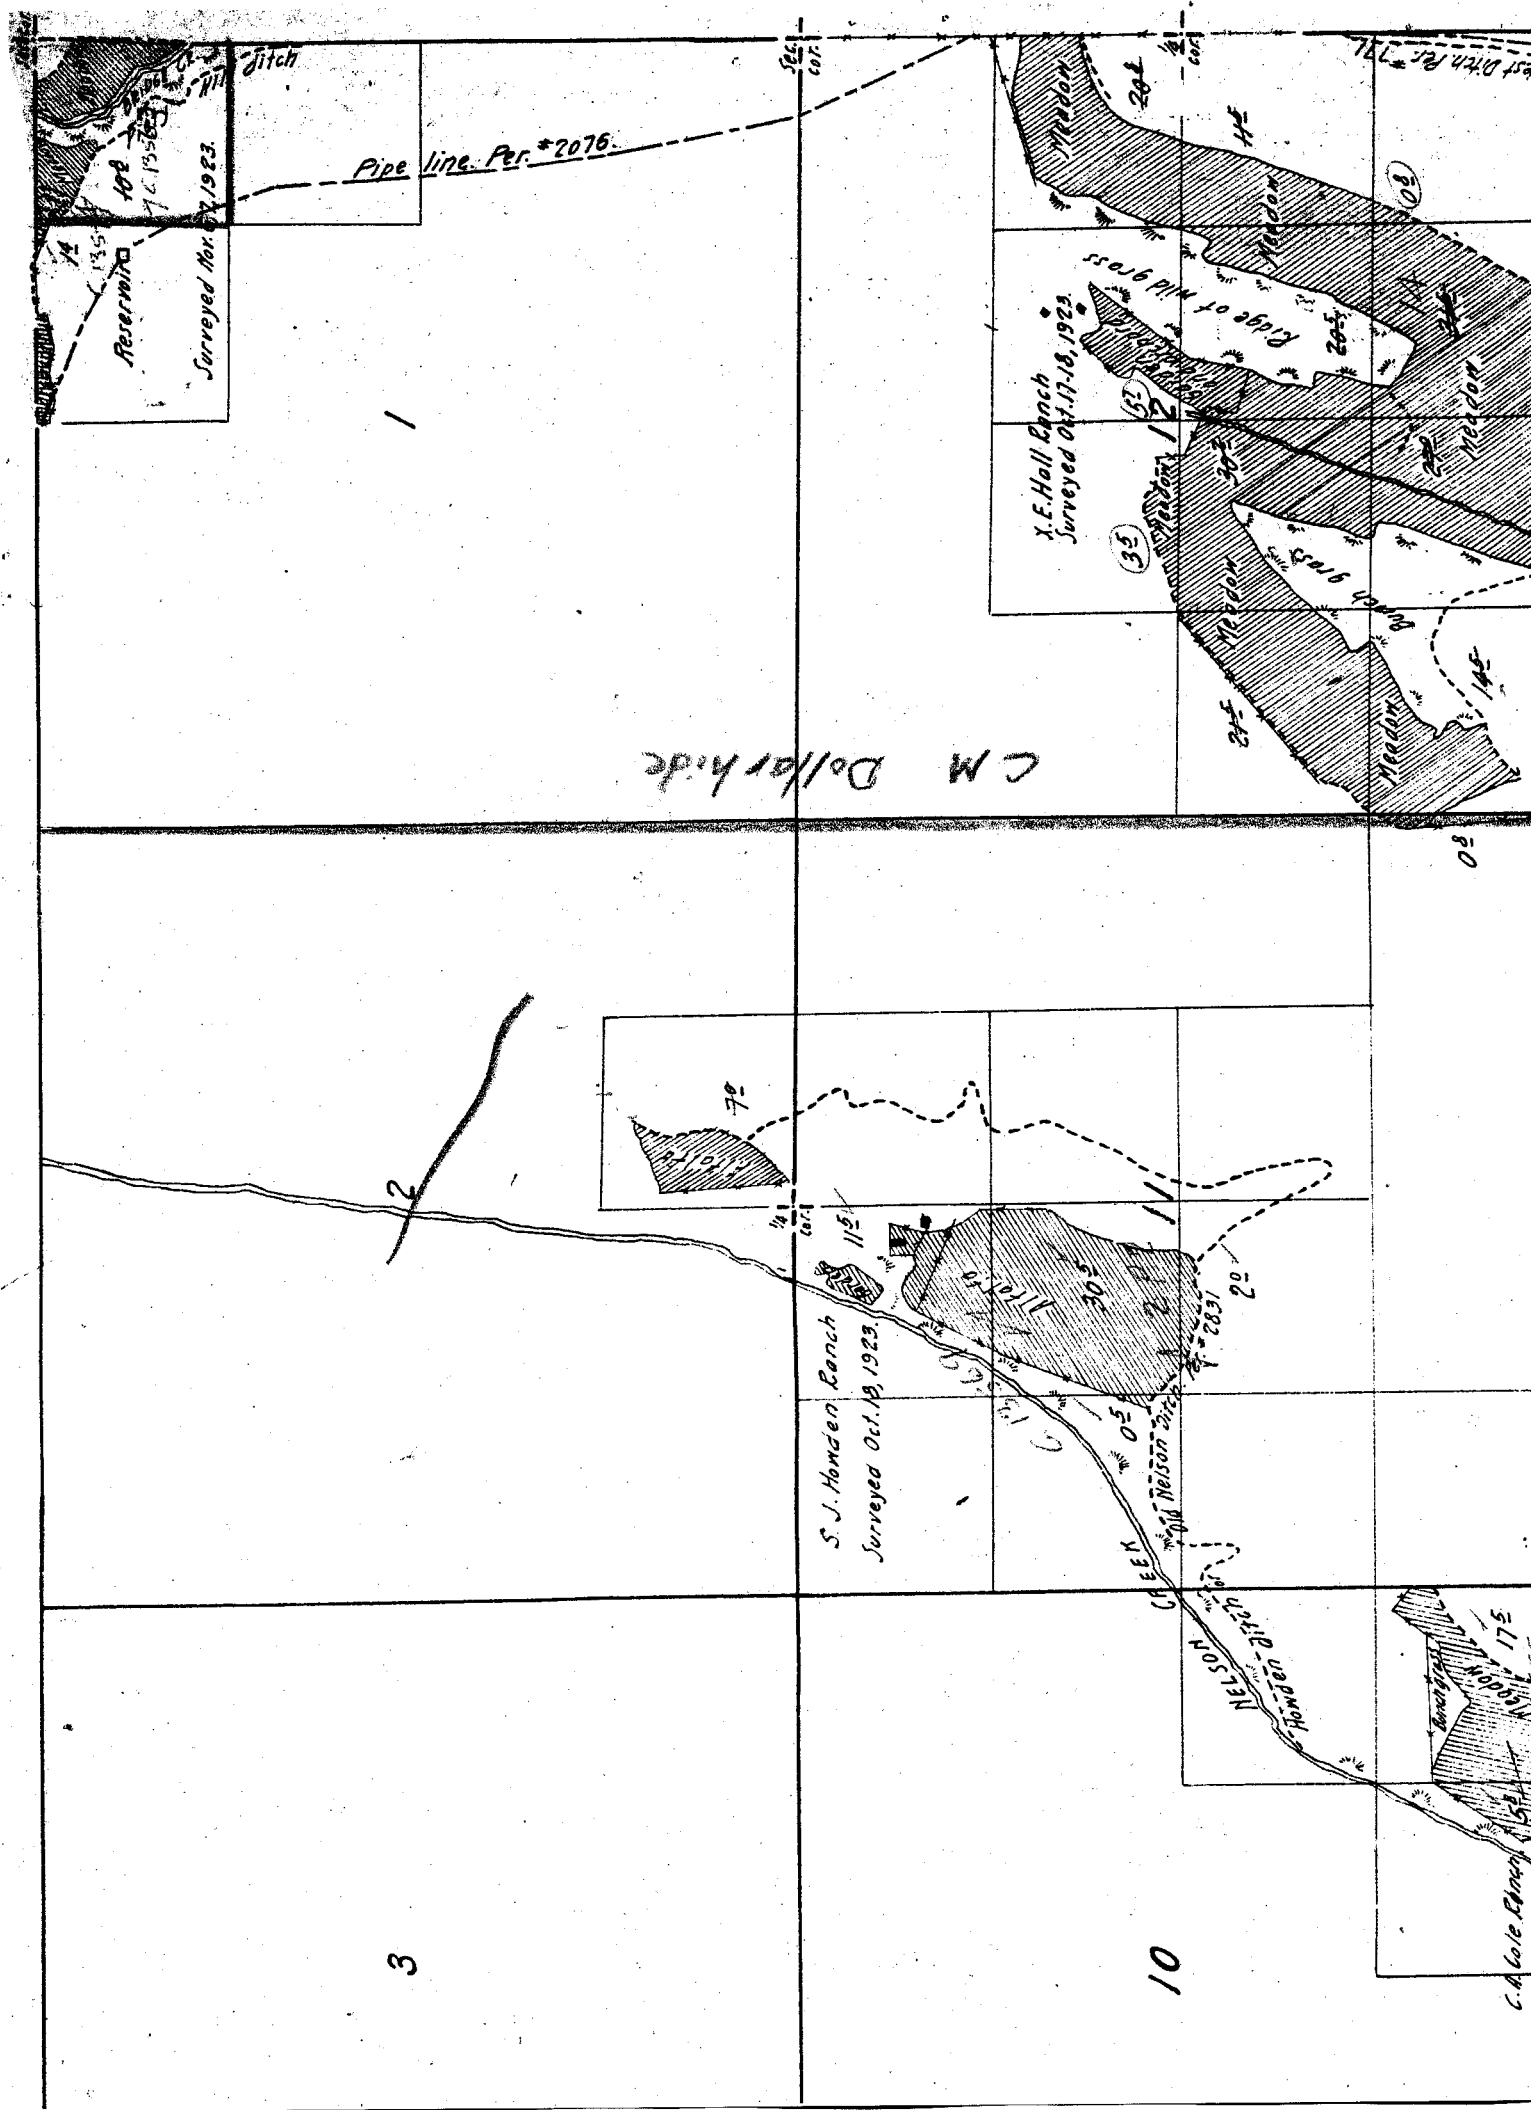

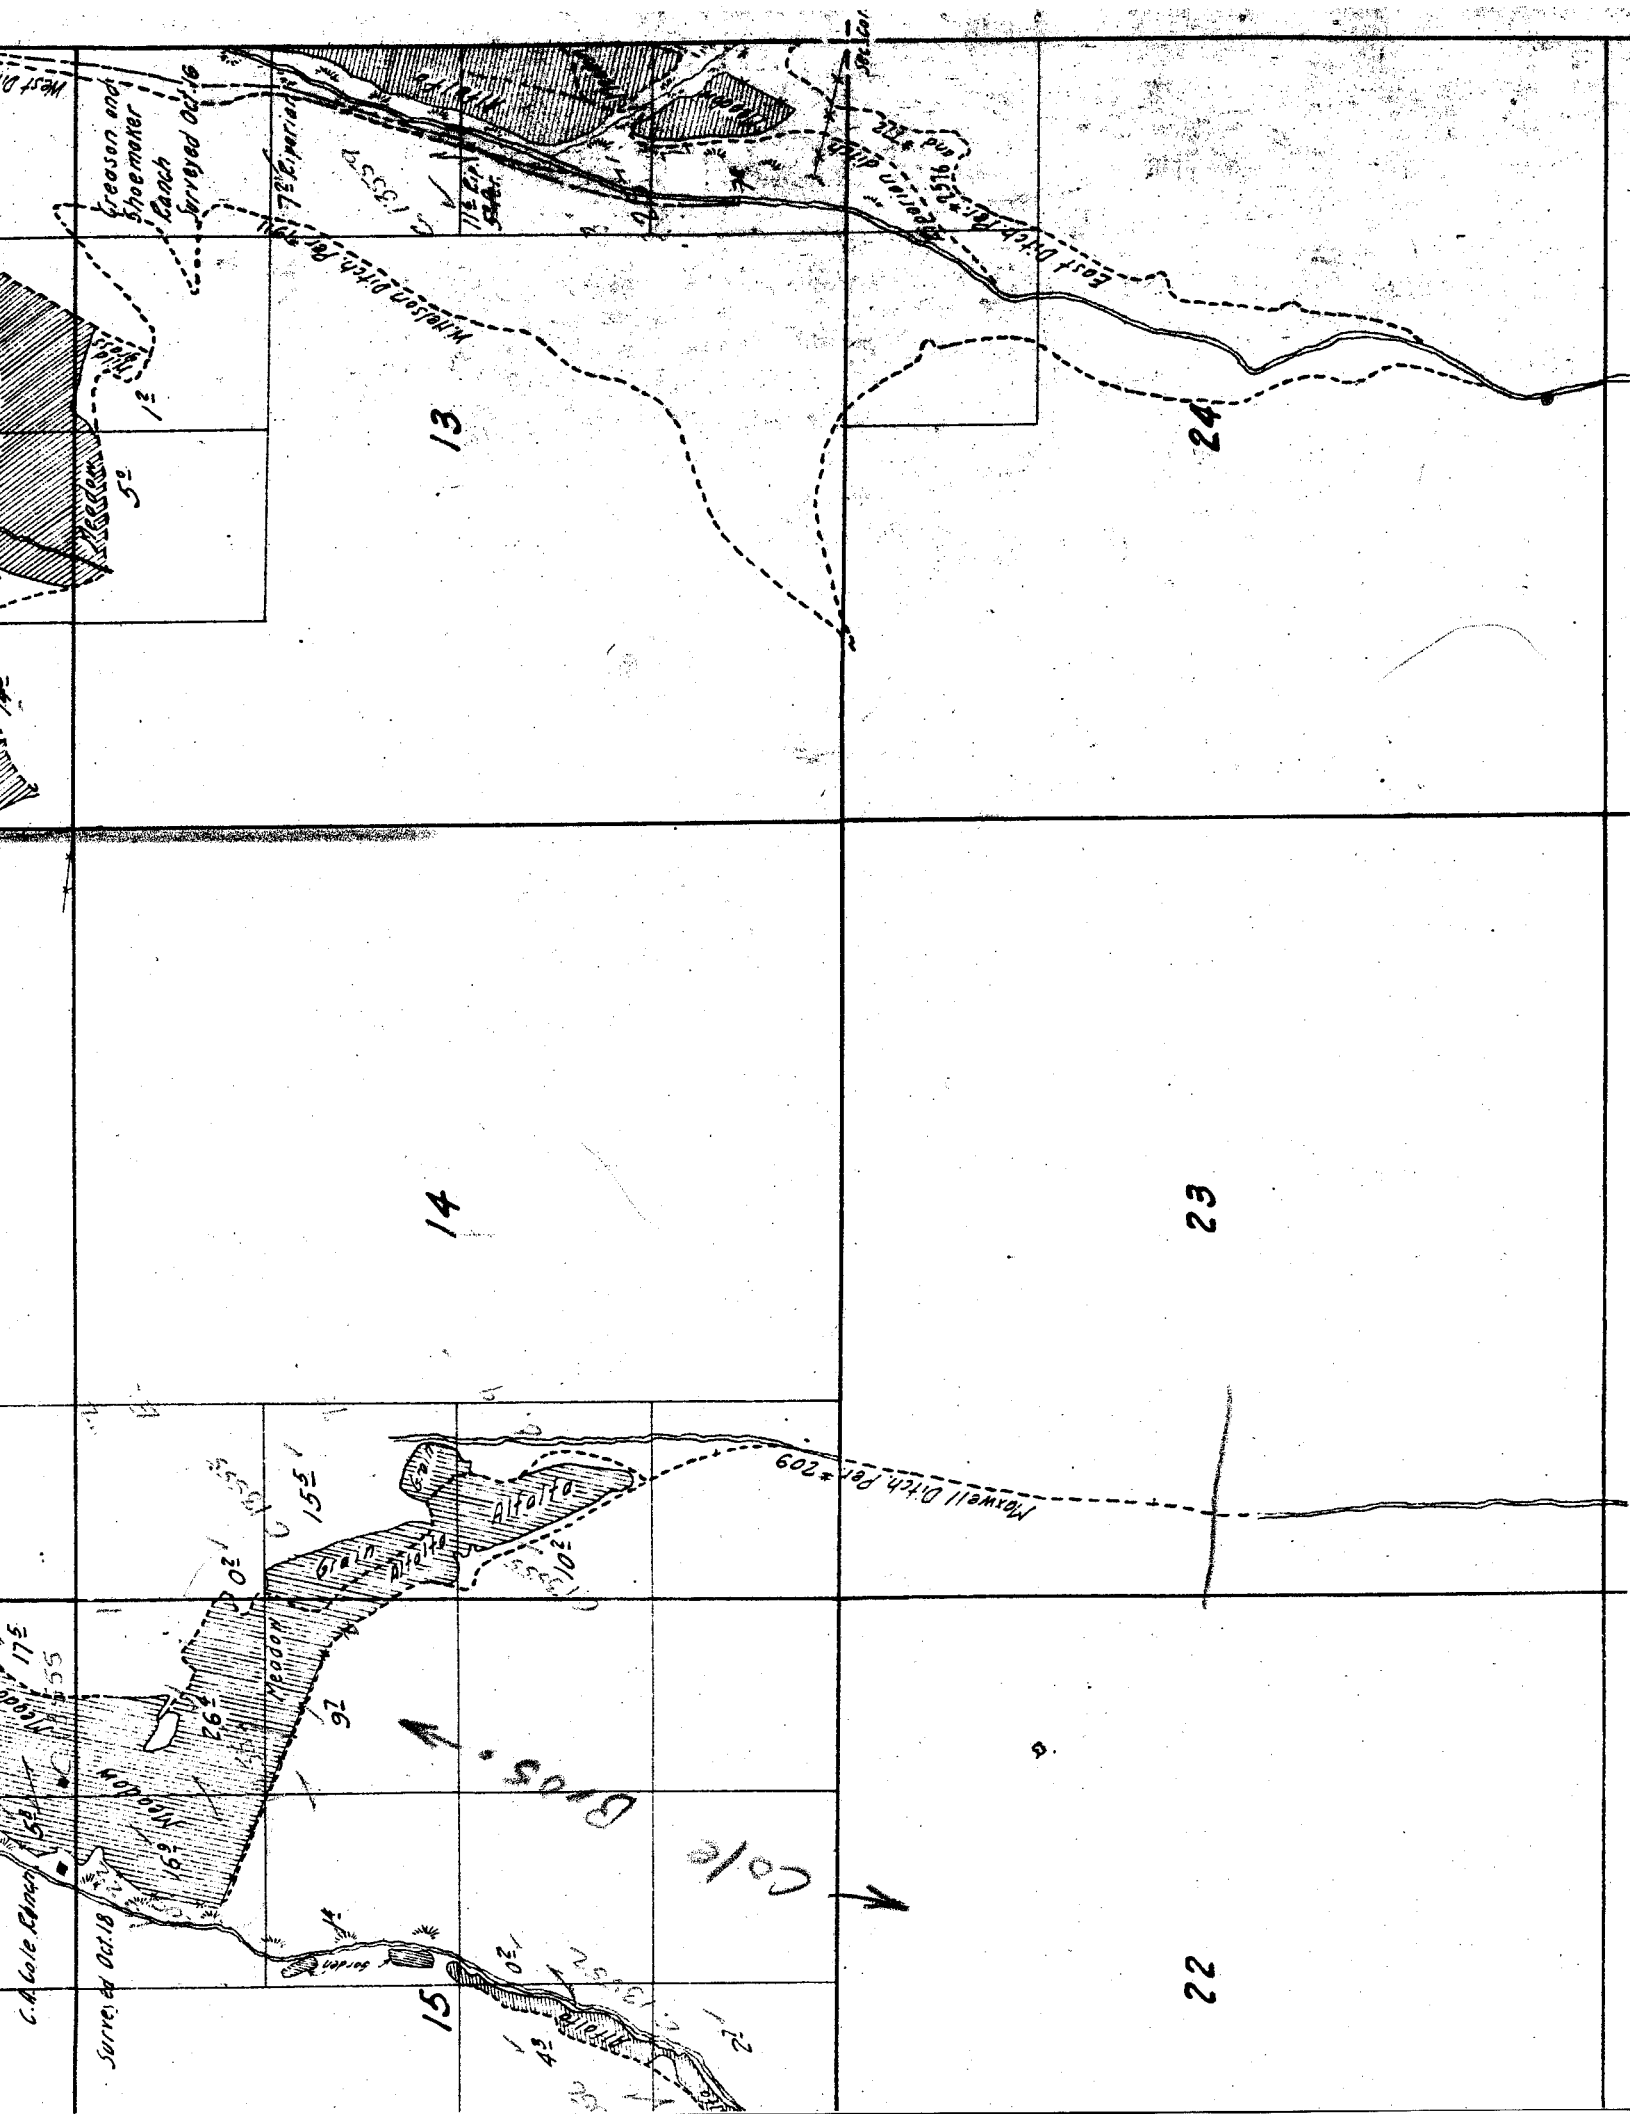

township 12 S, Range 21 E.

