

6

Ben Taylor Ranch
Surveyed Oct. 8, 9, 1923.

5

7



8

18

17


L. L. Jones Ranch

House 21

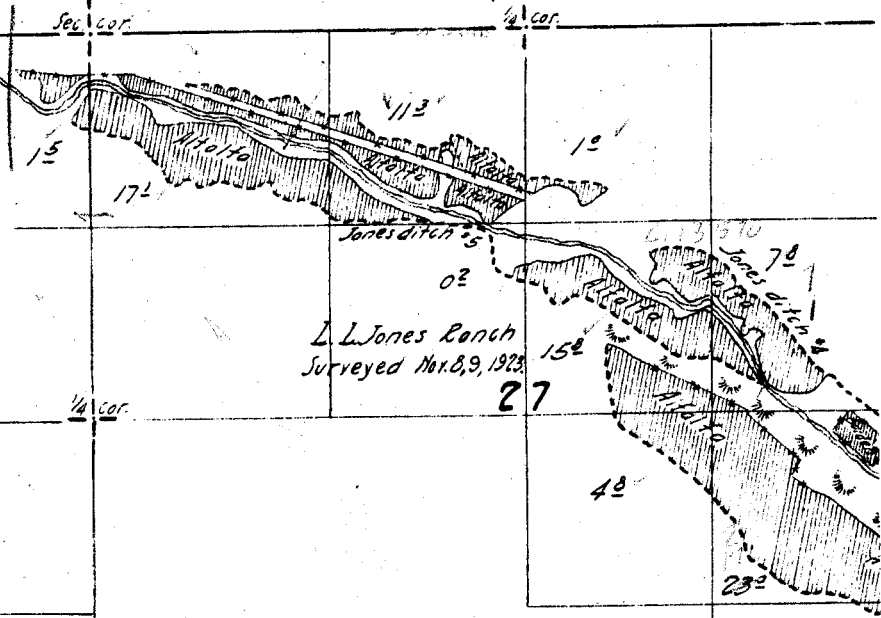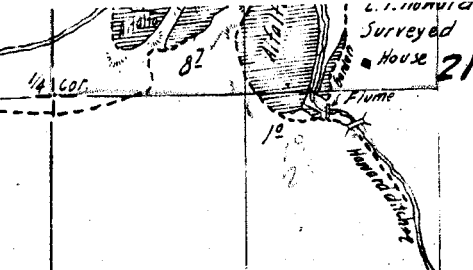


L. L. Jones Ranch
Surveyed Nov. 8, 9, 1923.

28

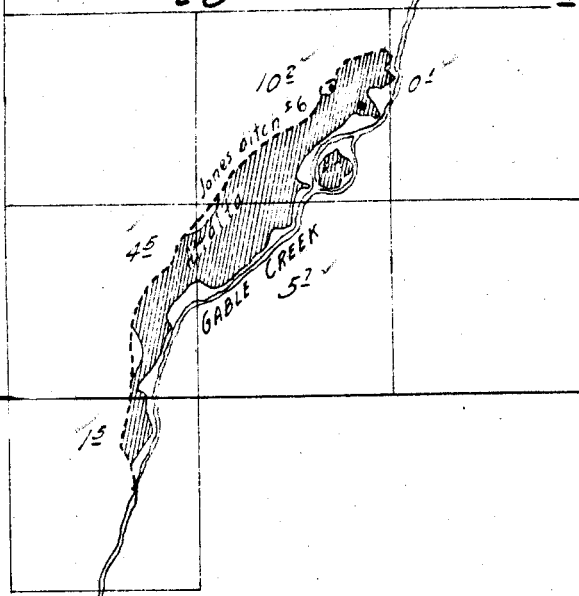

33

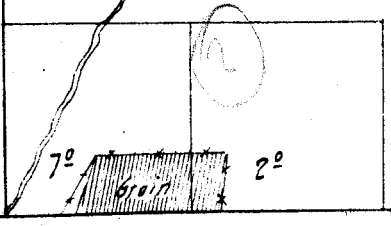

E.

6-1-1

2

1

11

12



14

13


Township


11 S.

Range

21 E.

V. Ranch
5

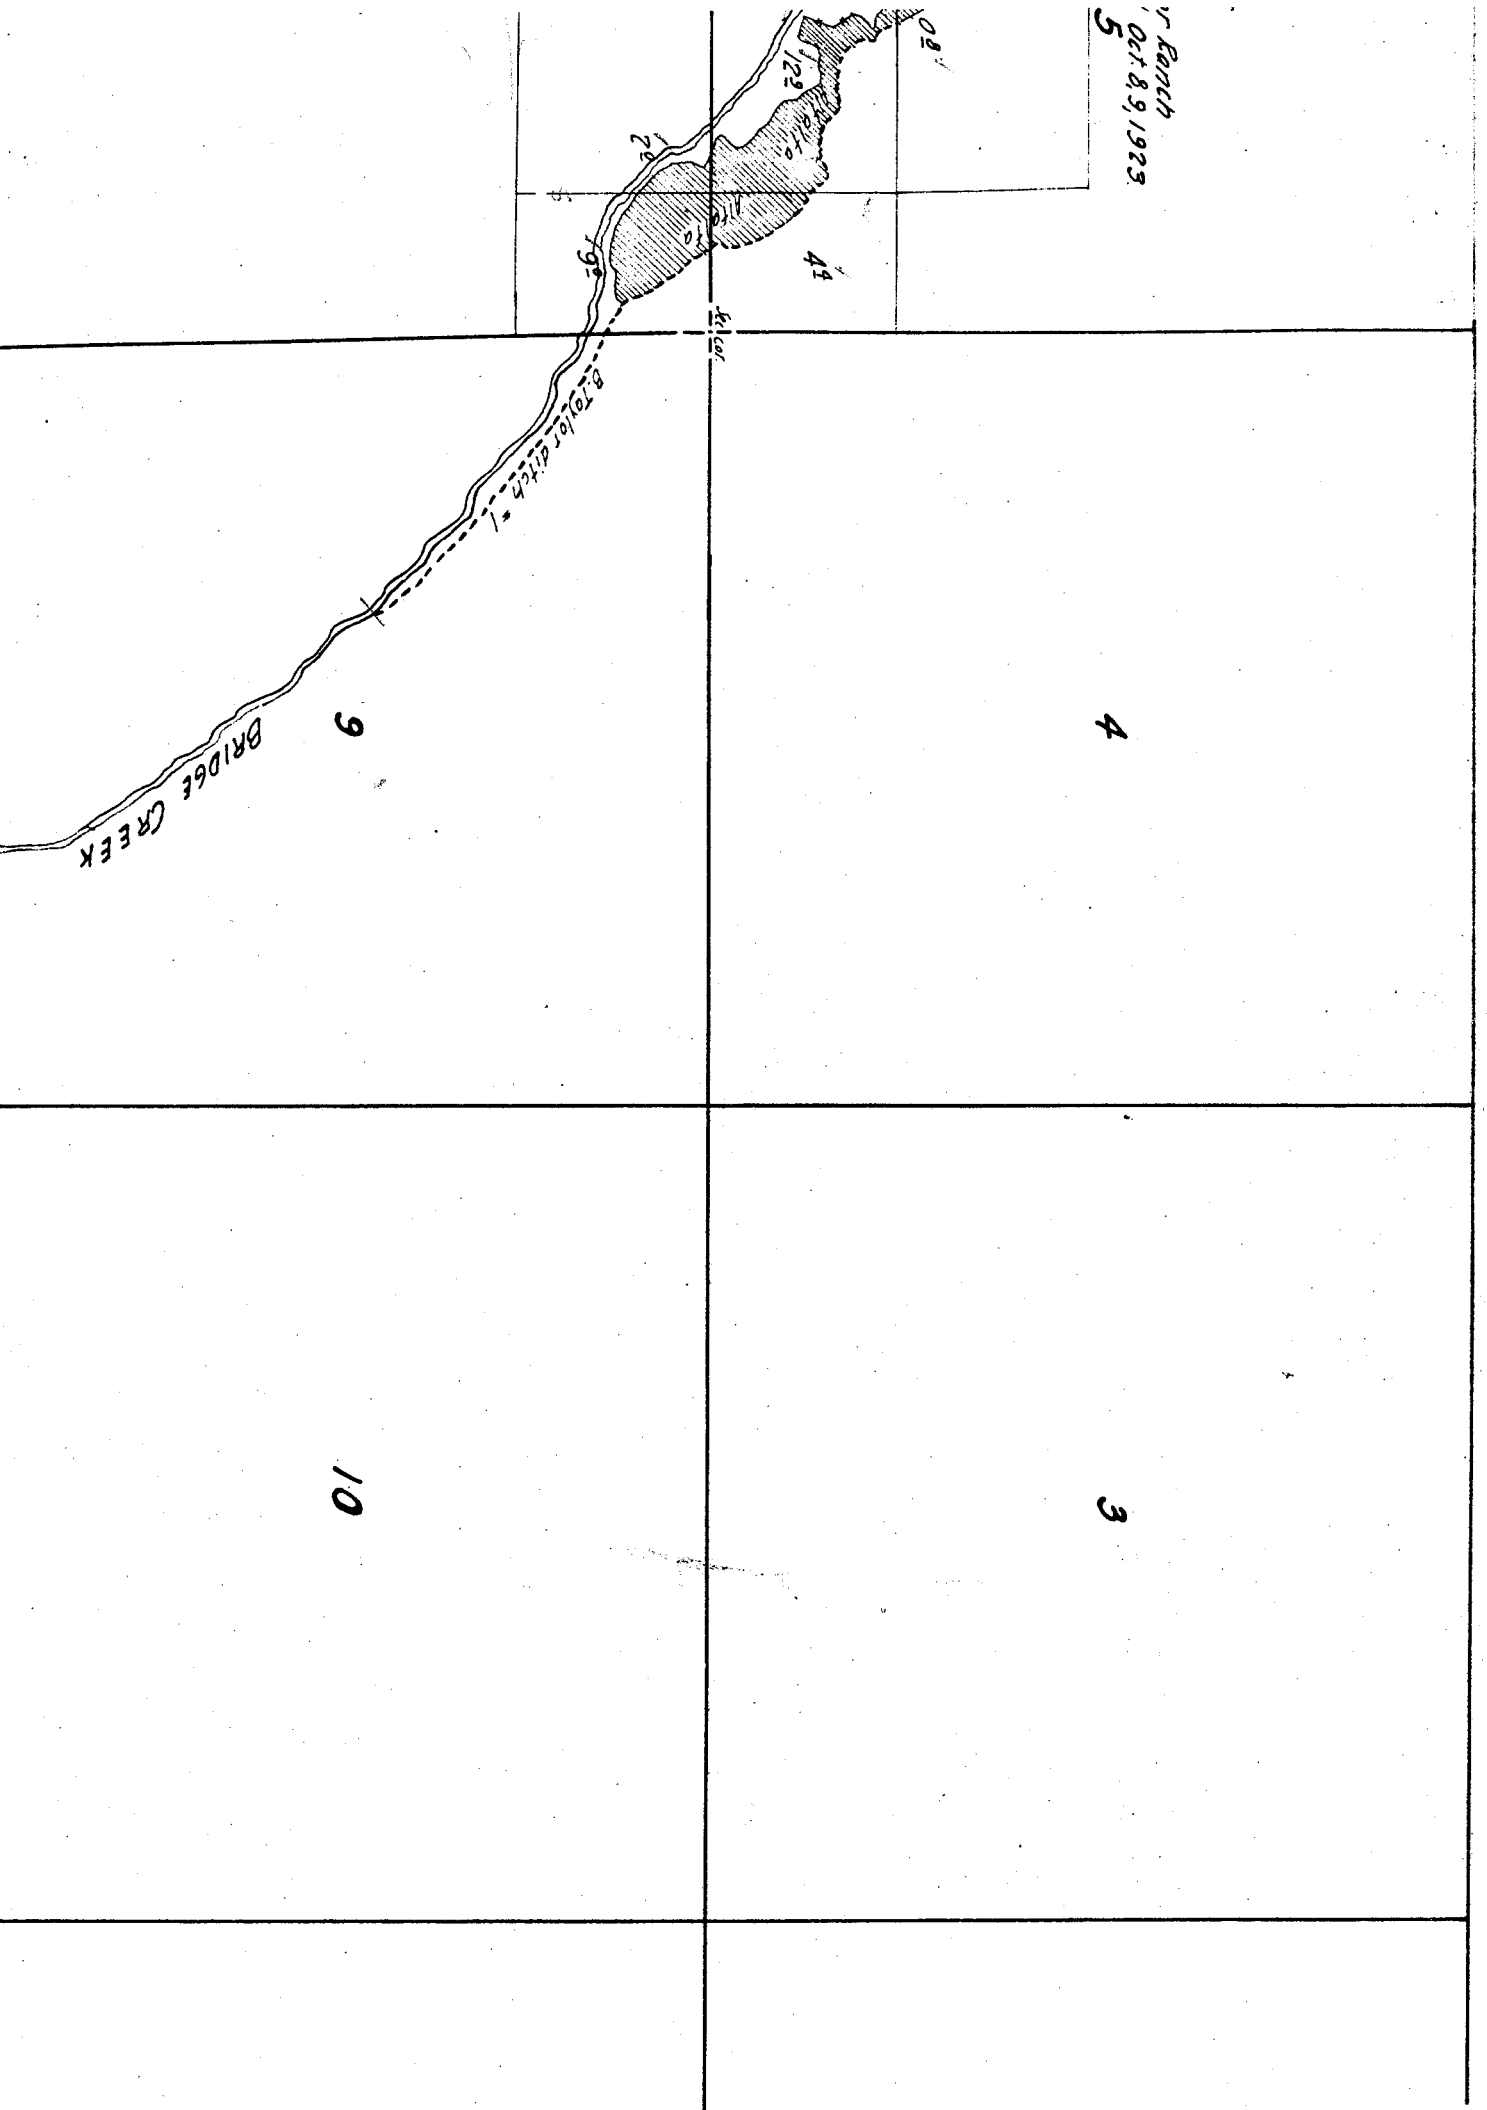

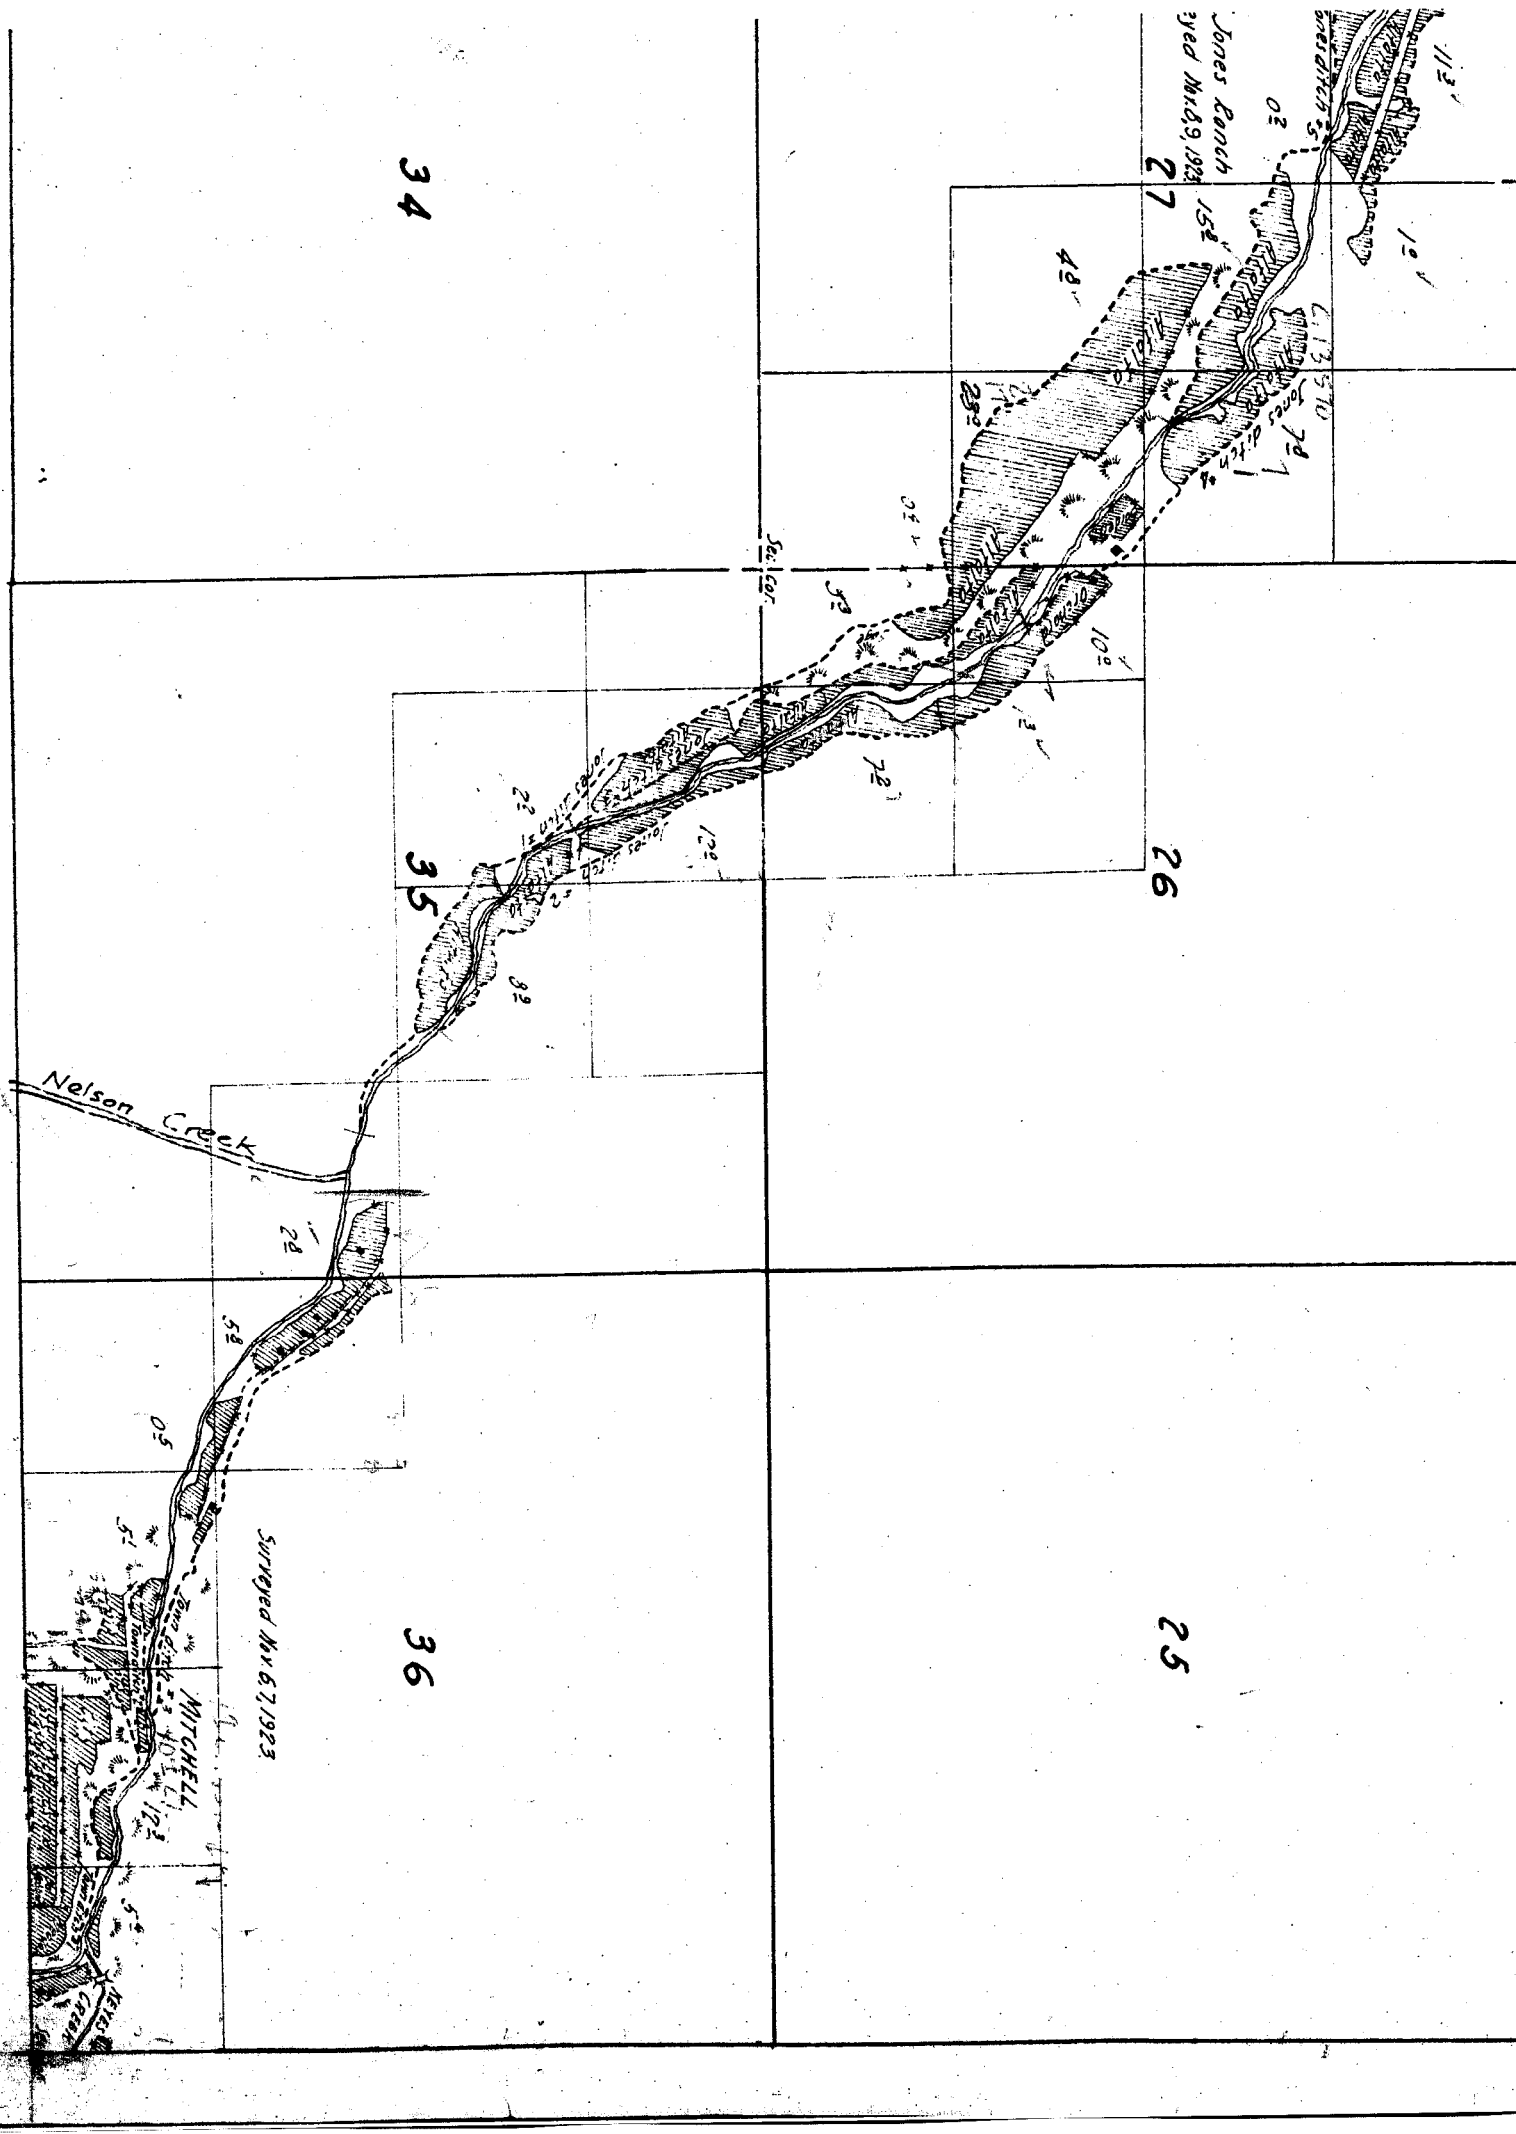

Jones Ranch
Sayed Nov 69, 1923

27

26

25

34

35

36

Surveyed Nov 67, 1923

MITCHELL

Nelson Creek

15

14

13

*5. partly sketched in approximate
form U.S. Township plat.*

22

23

24

1/2 cor.

16

17

18

Staff gages

Barre
L. T. Howard
Surveyed Nov.
House 21

28

20

J. H. Roberts Ranch
Surveyed Oct. 26, 1923.

19

WEST BRANCH OF JOHN RIVER

Howard ditch

Roberts ditch

Howard ditch

1/4 cor

112'

10'

















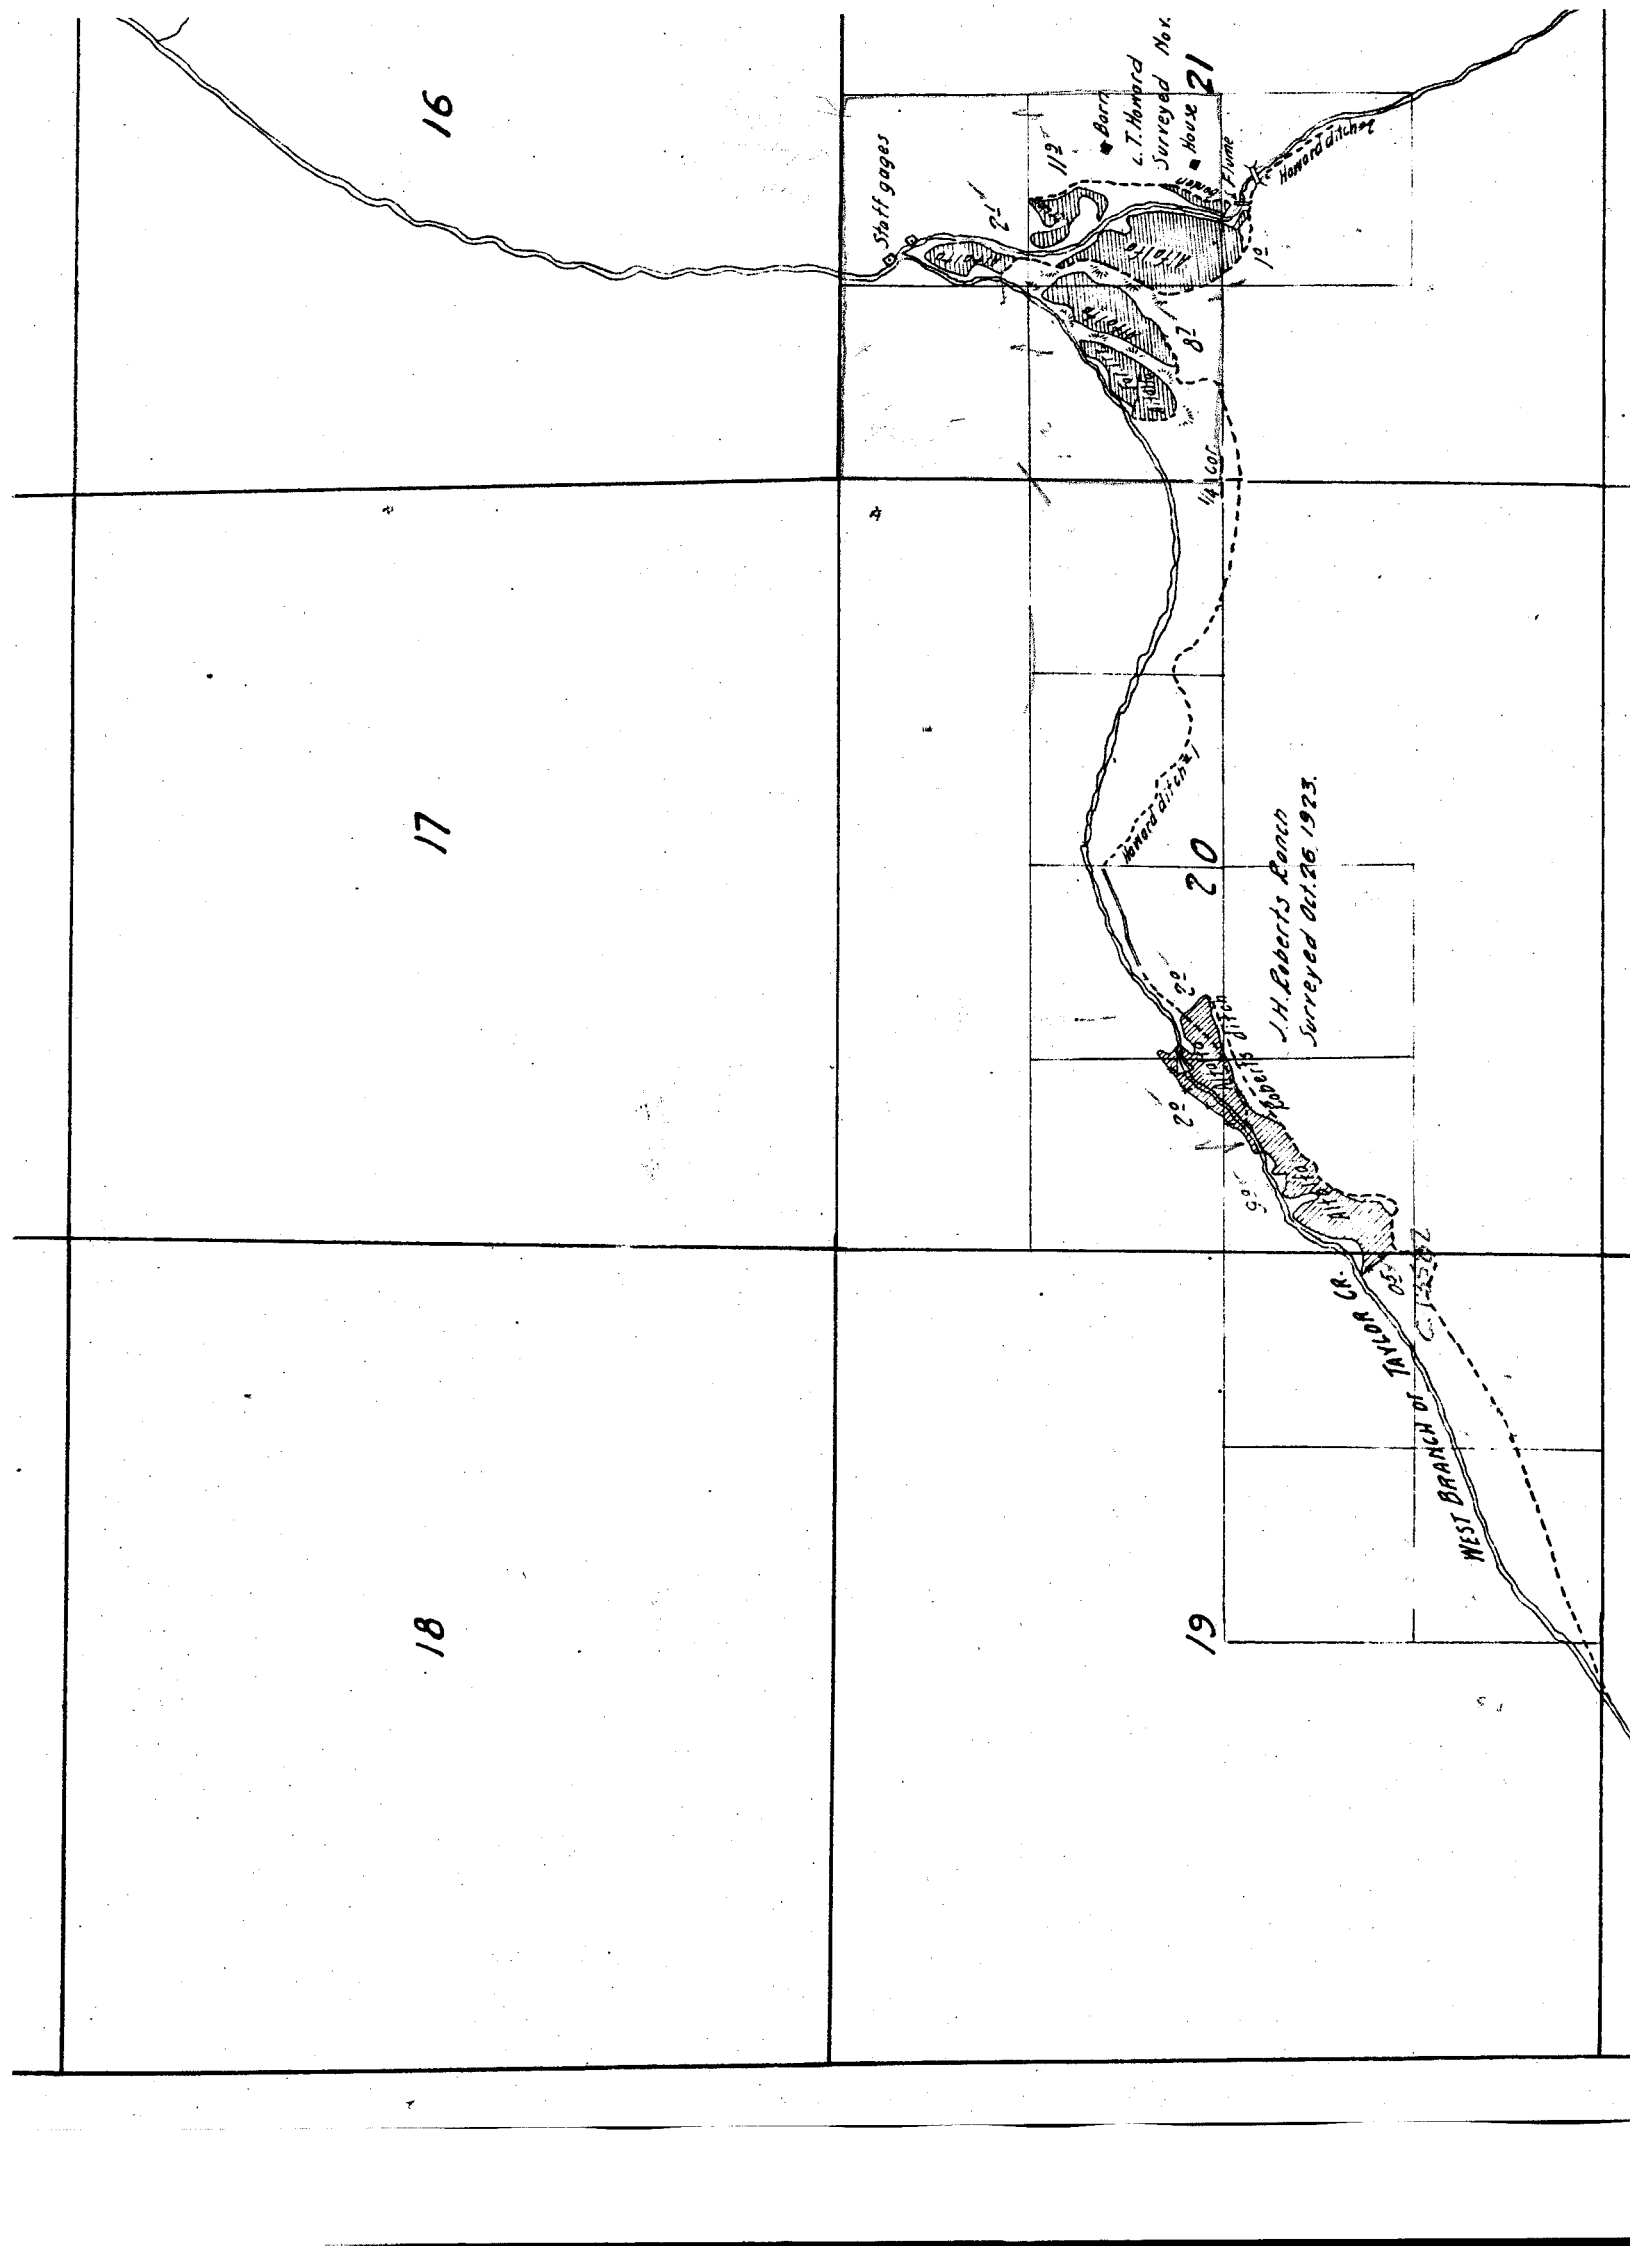

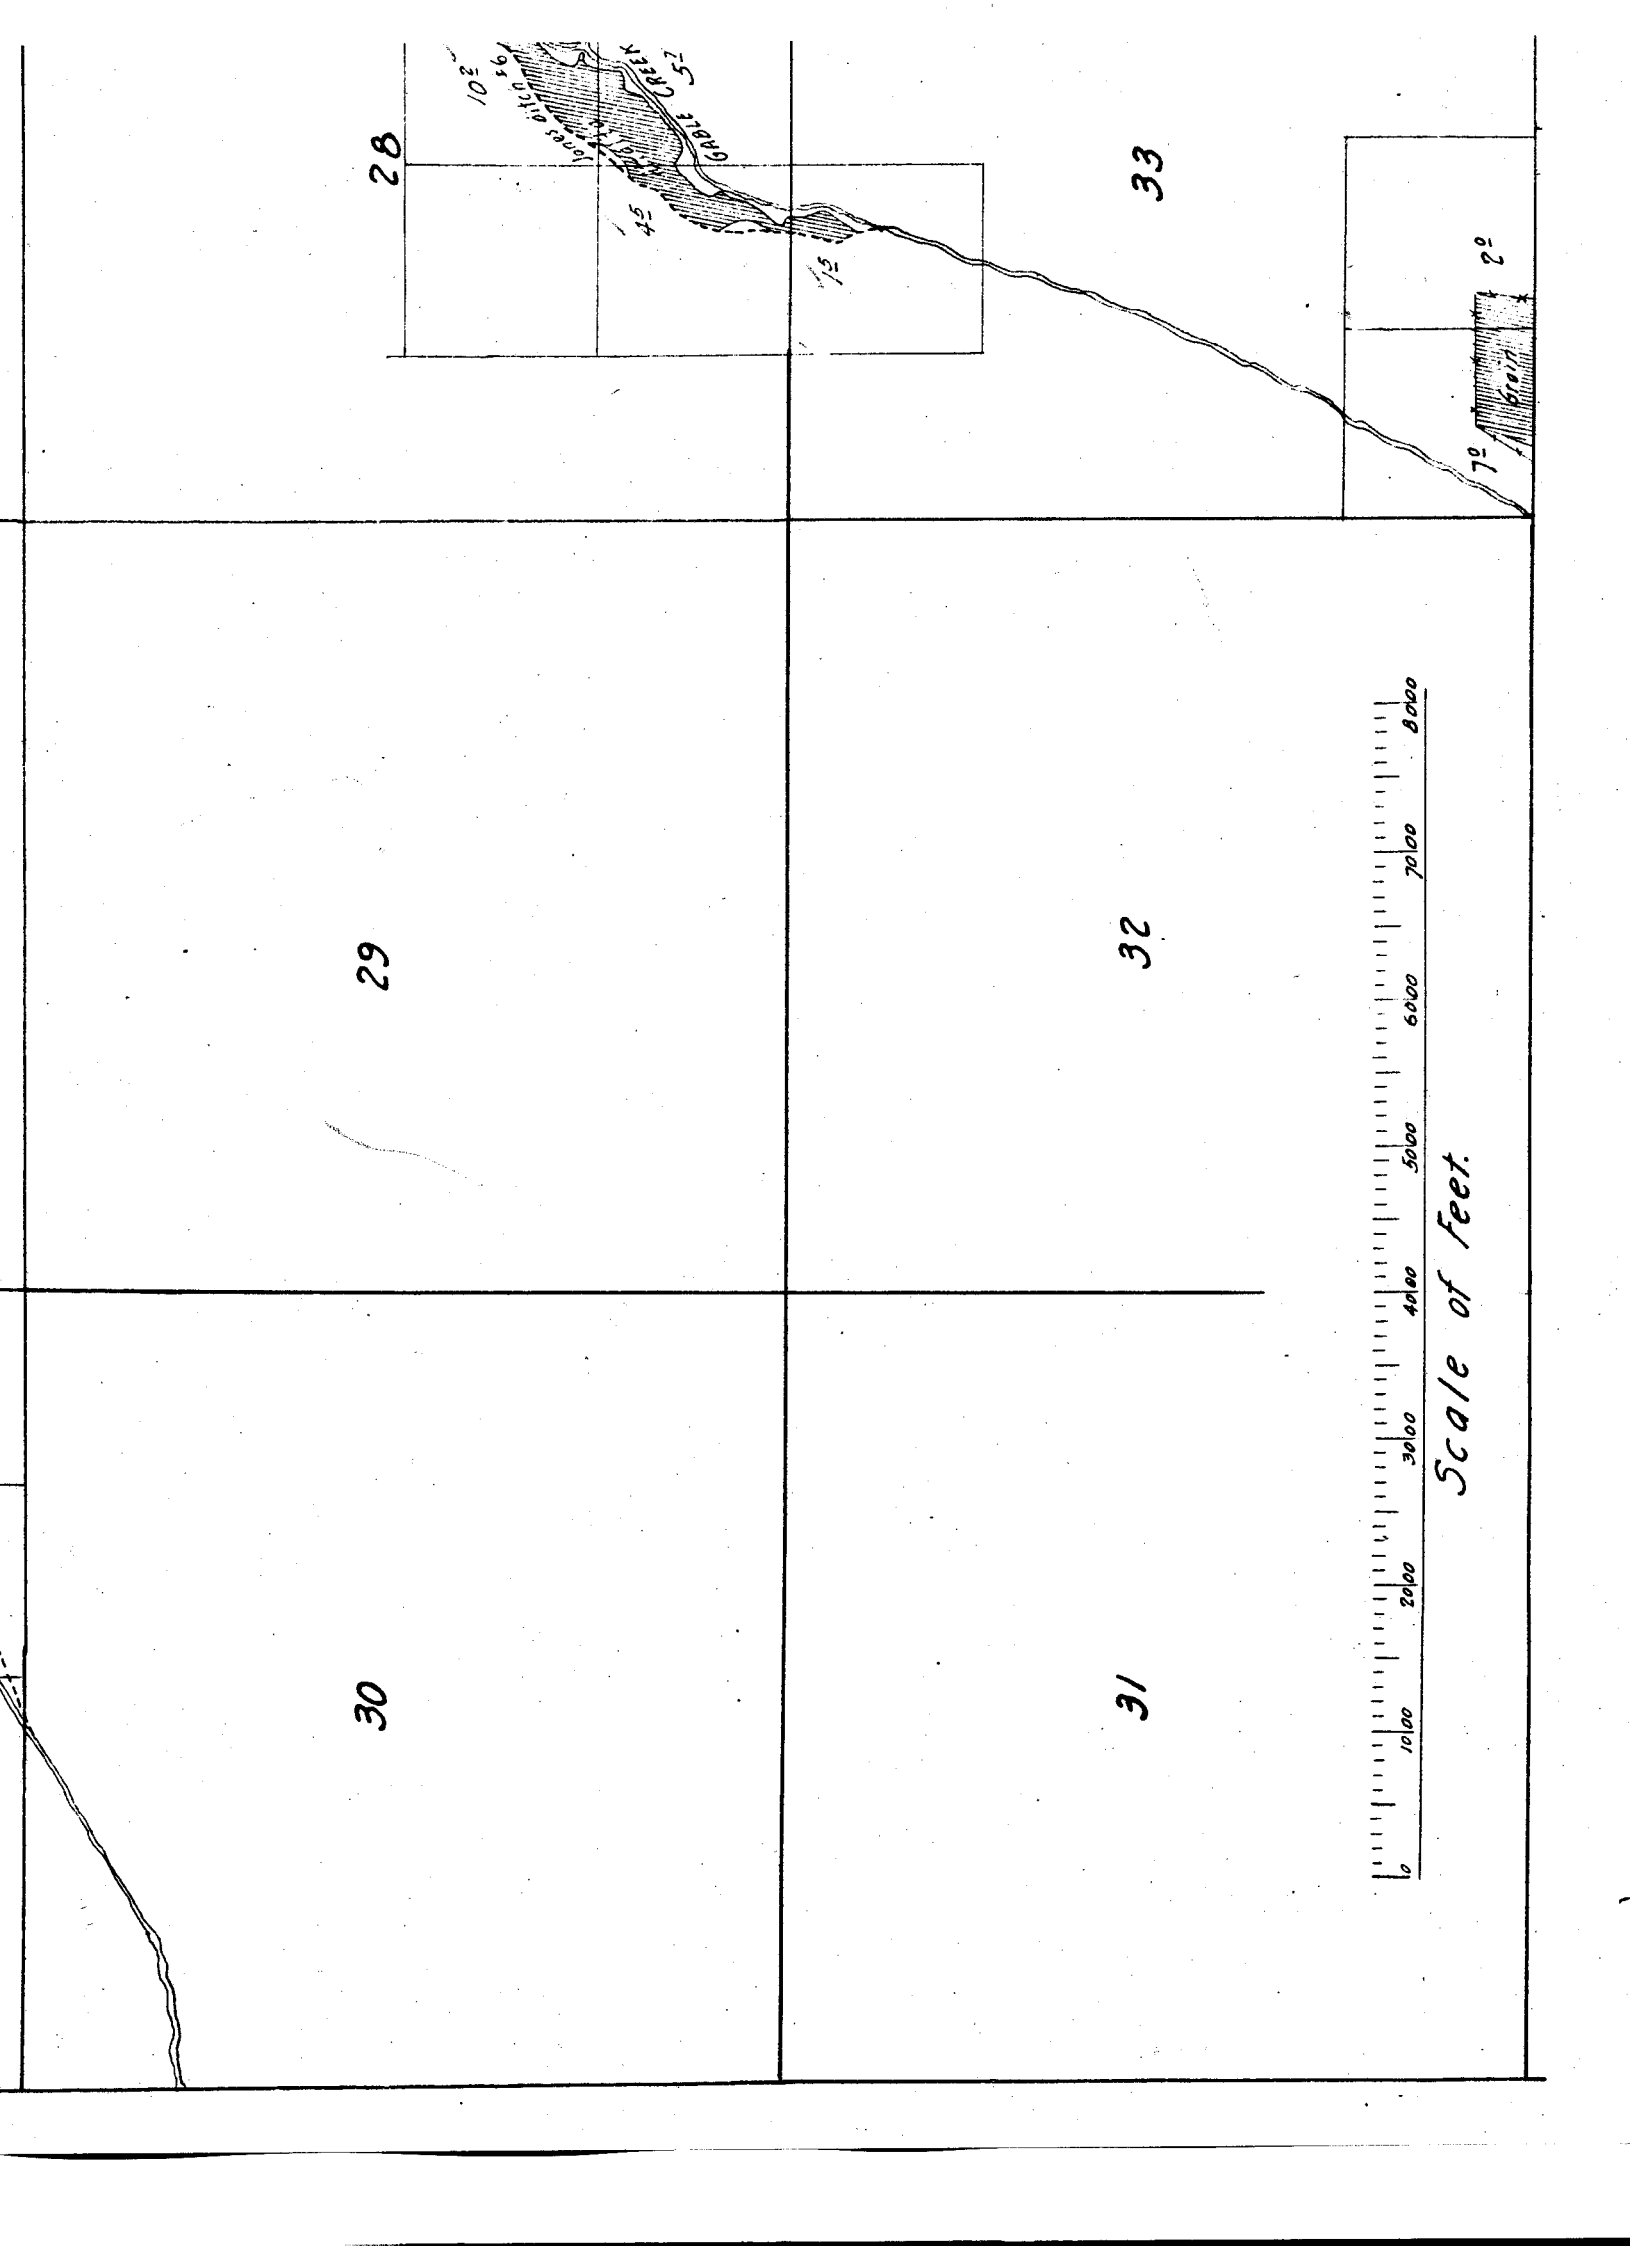

28


33

29

32

30

31

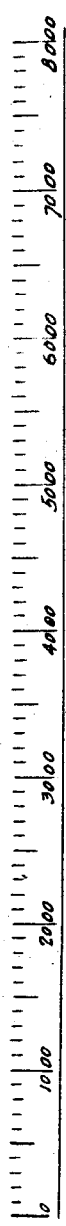

Scale of Feet.

GABLE CREEK
195
102
301

45

75

2°

70'