


JOHN DAY RIVER

54 2006  
04 SE  
172  
from John Day 127  
31

32  
P24769

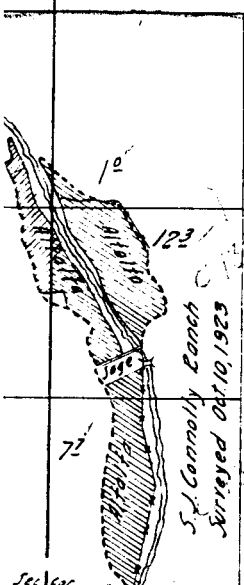


S.J. Connolly Ranch  
Surveyed Oct. 10, 1923

W. H. EXTRACT

2


1

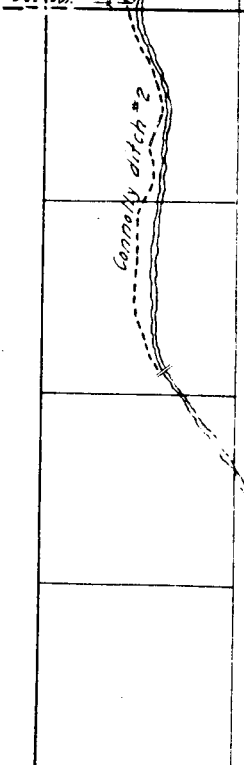

11

12

BRIDGE CREEK

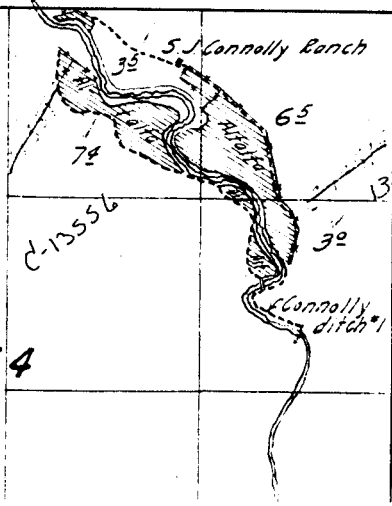

S.J. Connolly Ranch

13556

13556

14

13

13

Mel EXTRA

24

23

22

S. Connolly Ranch

65

69

30

Connolly ditch #1

C13556

14

62

C13575

100

C13575

John Manning Ranch  
Surrender Oct. 9, 1929, 191

08












































































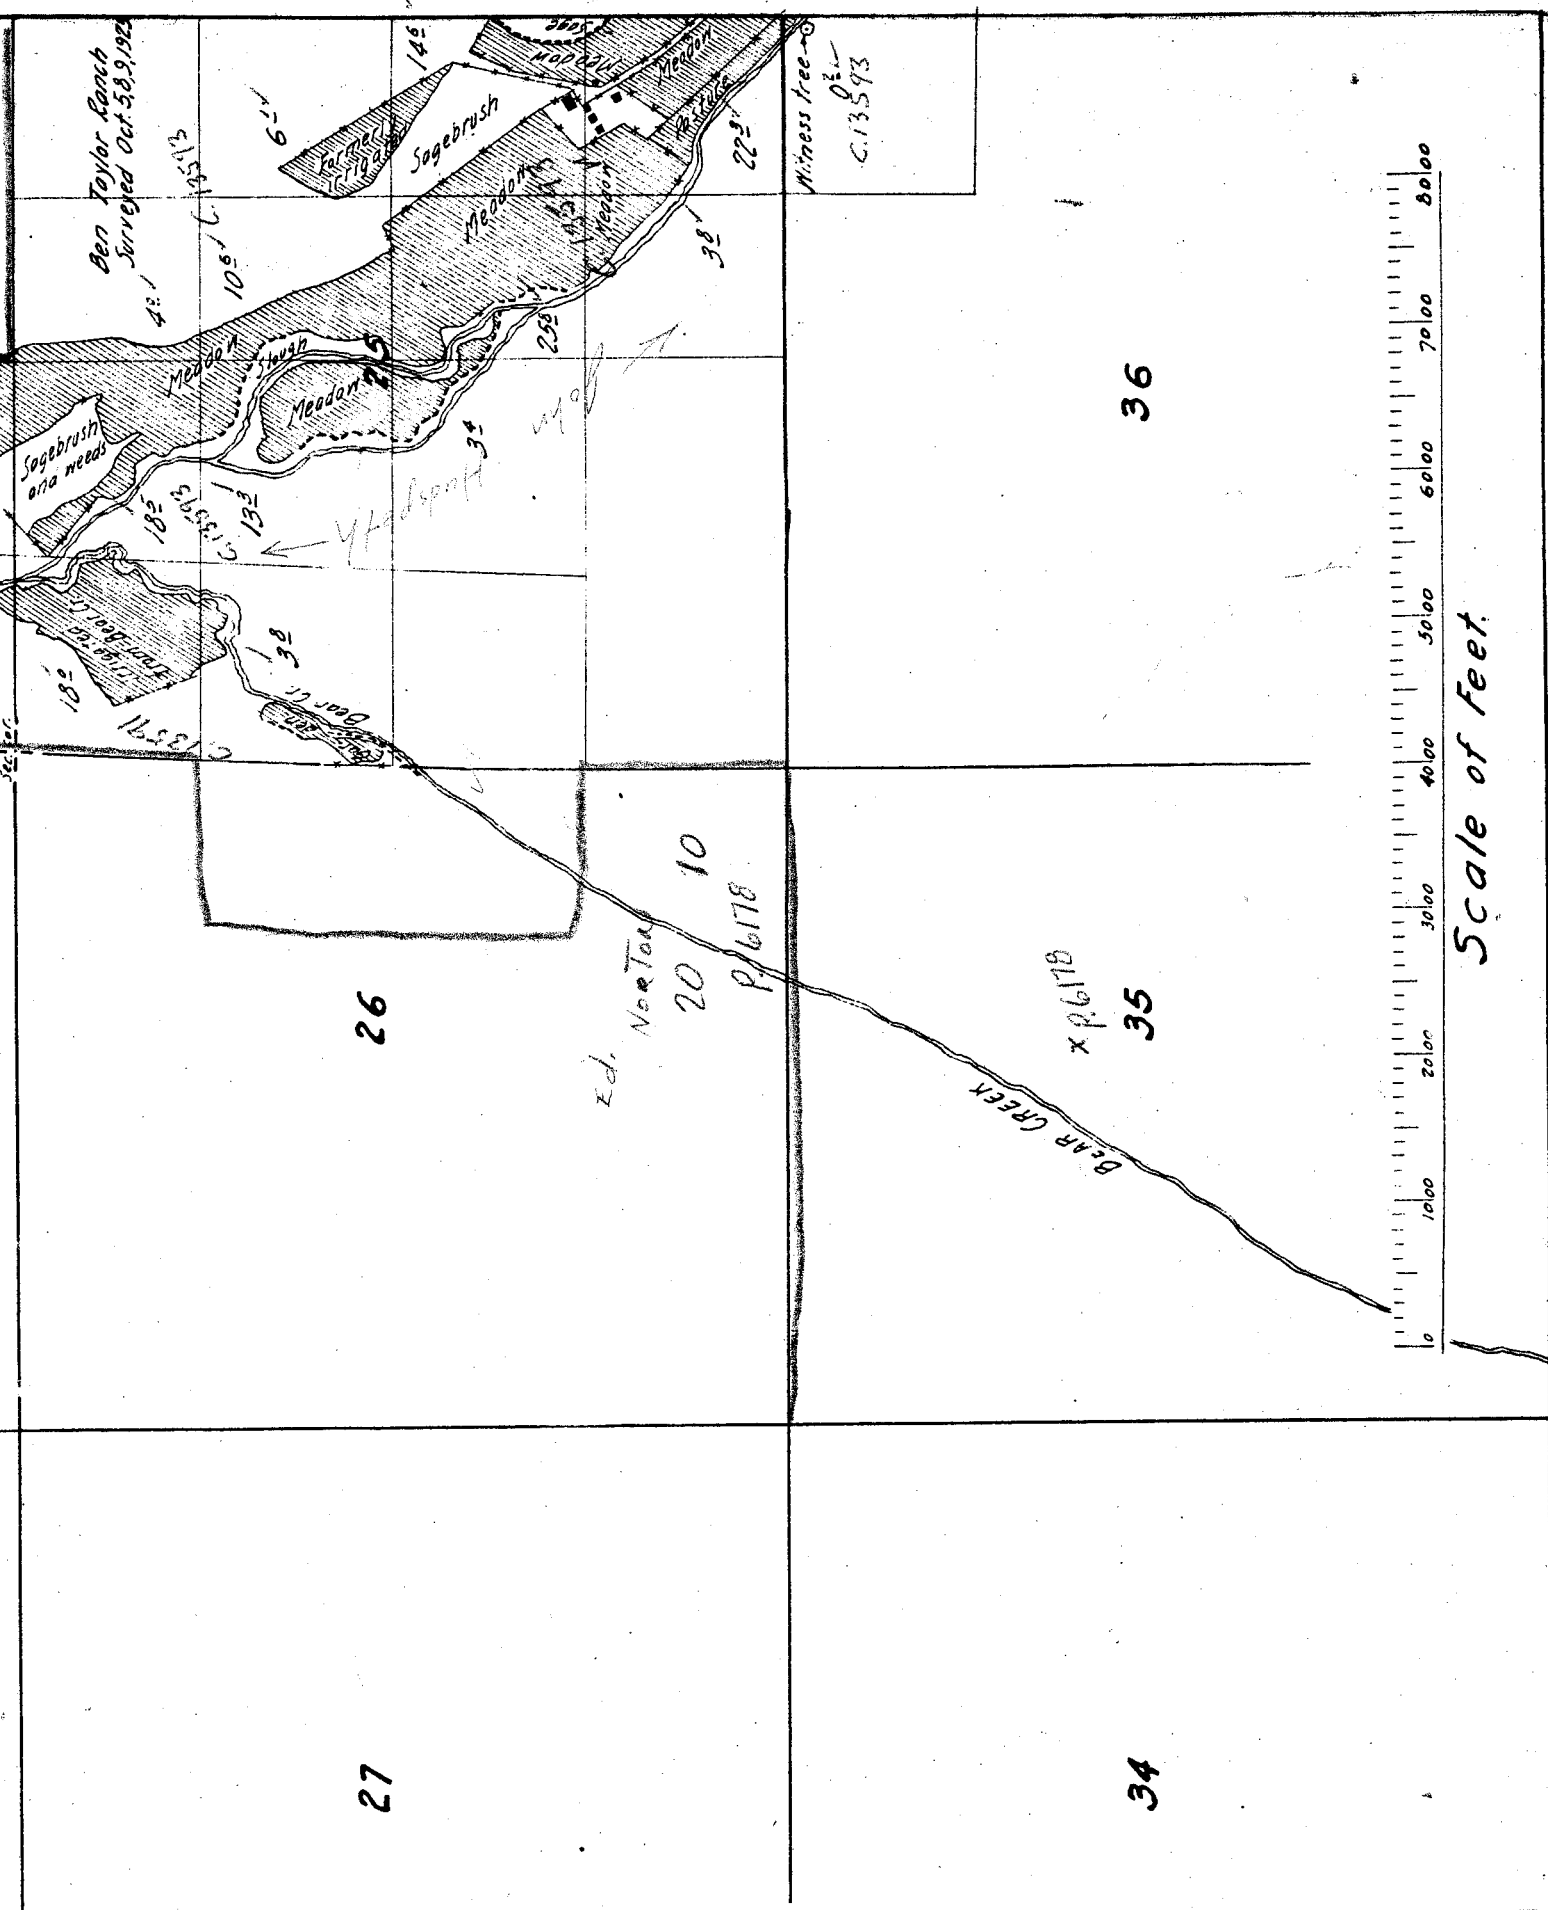

Ben Taylor Ranch  
Surveyed Oct. 5, 9, 1922

Sagebrush  
area needs

6-1/4

105' 1/2

182'

132'

38'

38'

26

27

Ed. Nor-Ton  
20 10  
P. 6178


Witness tree  
C. 13593

36

35

34

DEAR CREEK  
x 96178

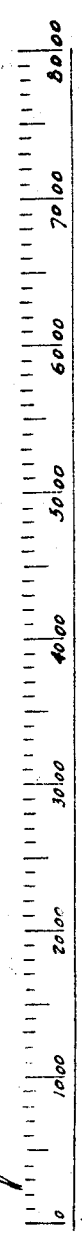

Scale of feet.



6

5

7

8

18

17

18

17

16

19

20

21

30

29

28

31

32.



33

27

34

28

33

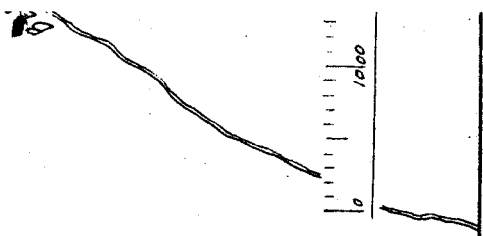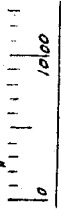



15<sup>\*</sup>

22

16

12