

1/4 Sec

Sec  
1600

6

Ben Taylor Ranch  
Surreyed Oct. 8, 9, 1923

5

7

8

18

17

52

32

96

22

42

2021

02


05

122

42

20

92

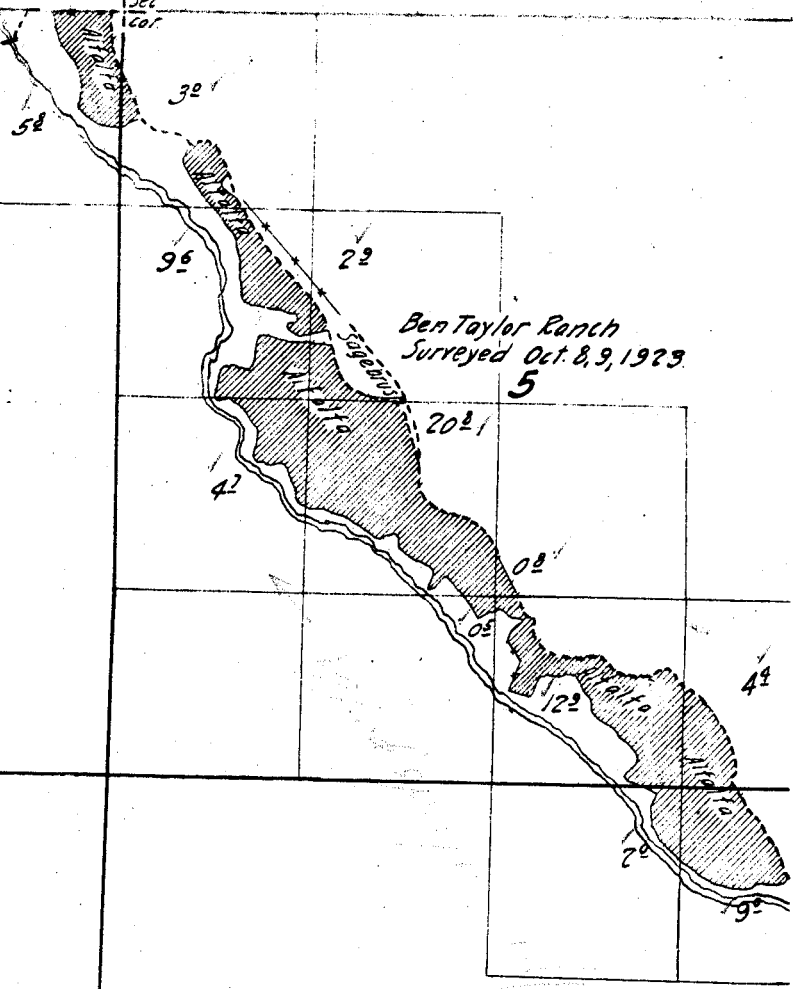

E.

6-1-1

2

1


11

12





14

13

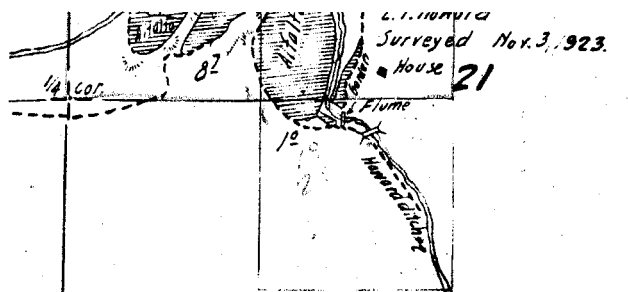


22

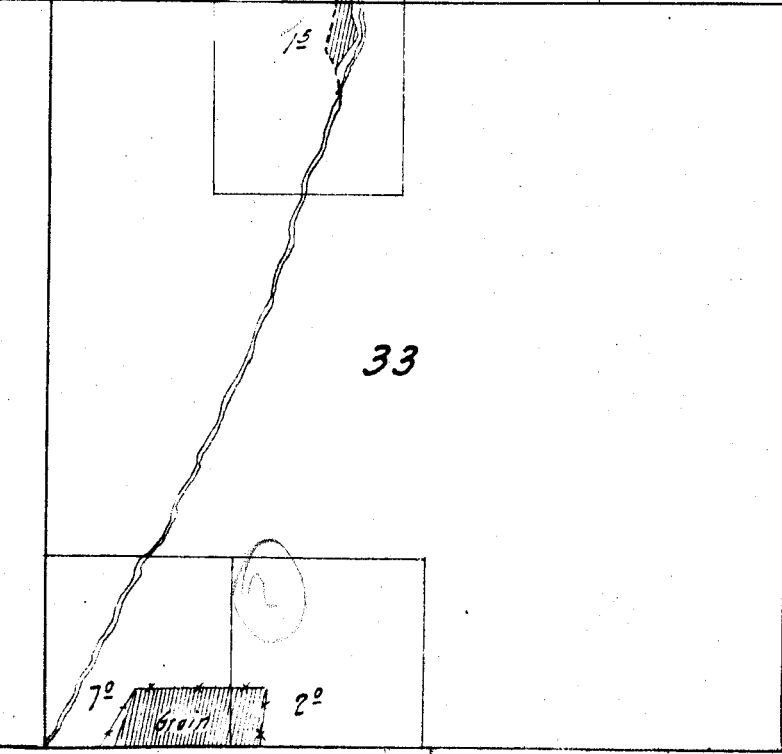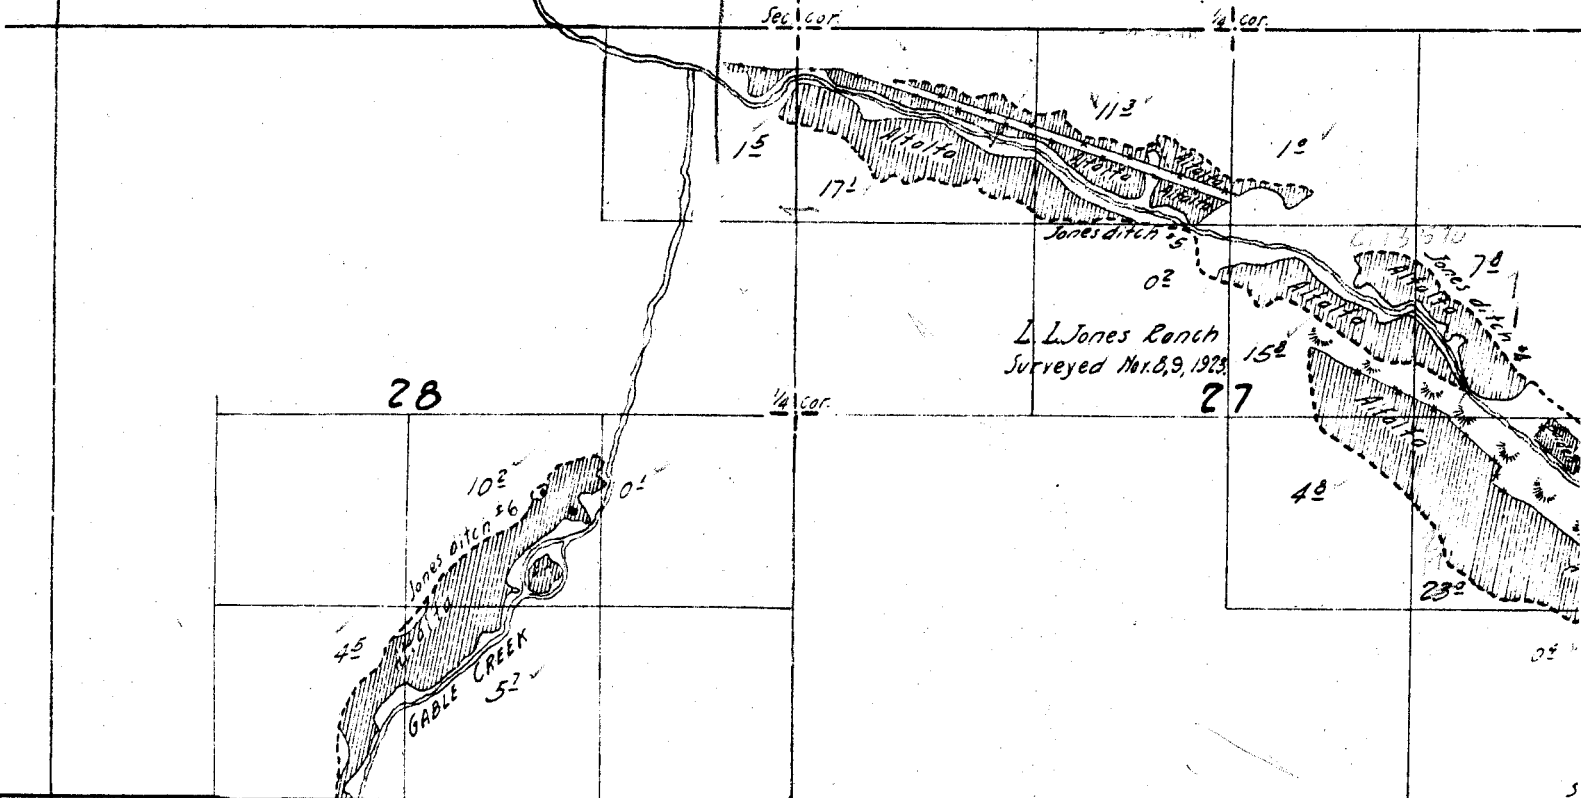

33

34

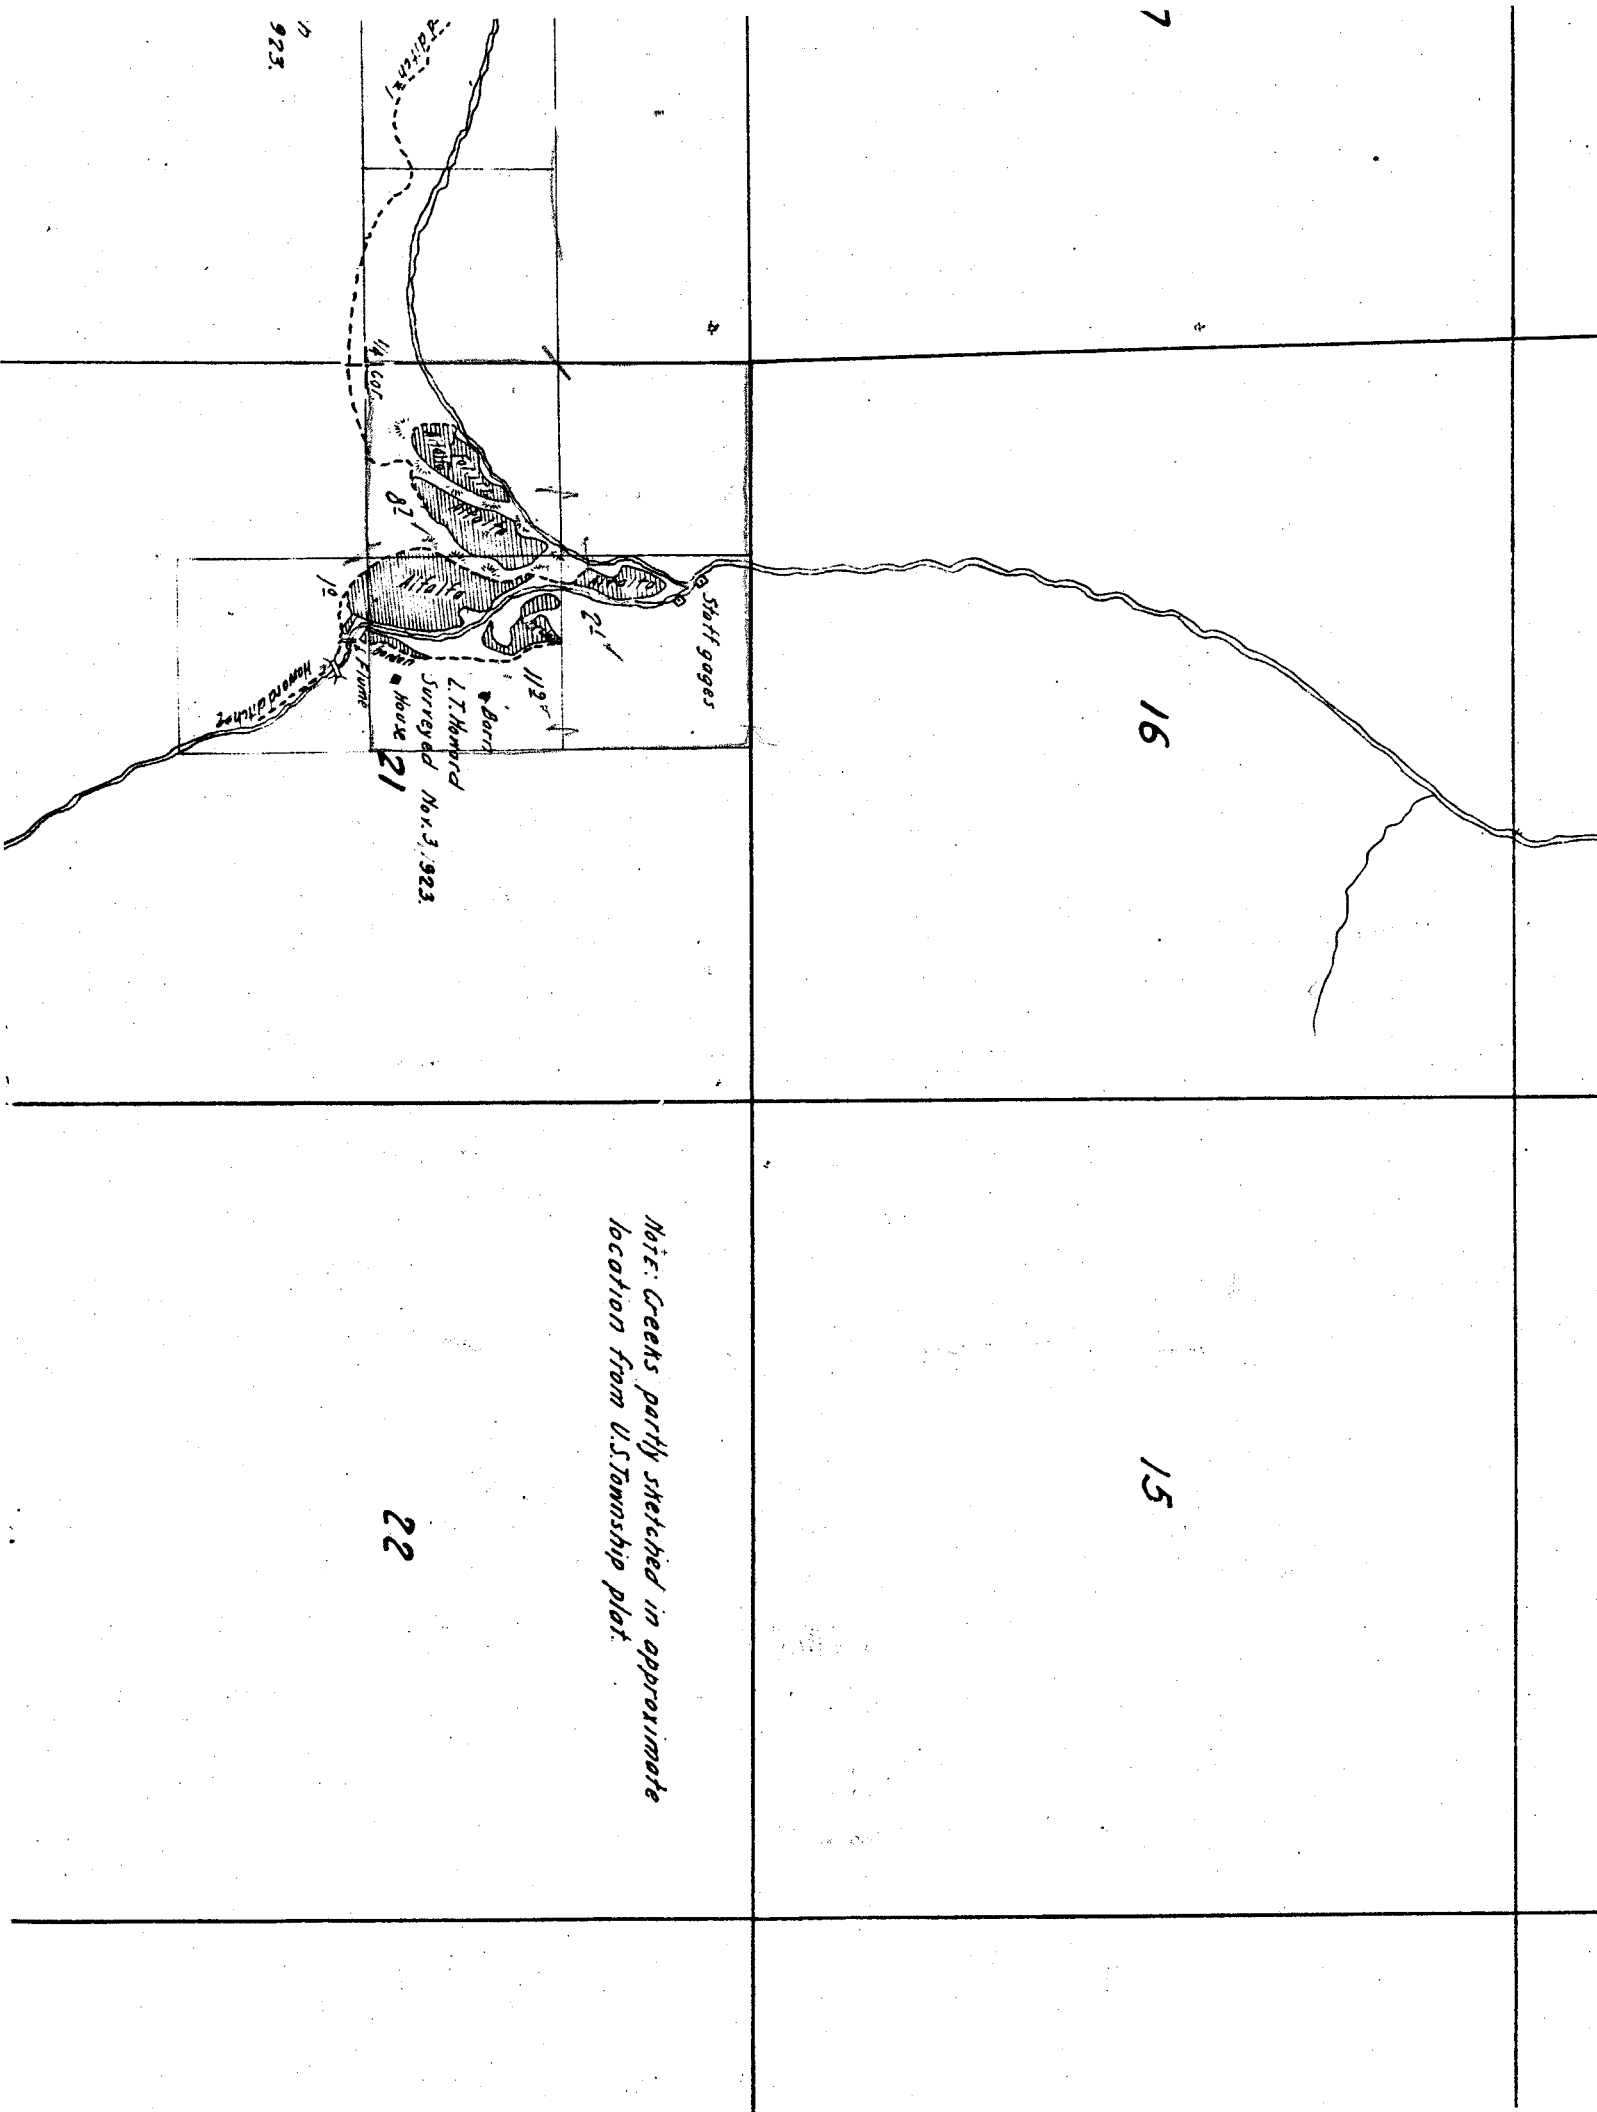

*Note: Creeks partly sketched in approximate location from U.S. Township plat.*

7  
923

16


15

Staff gages  
1/4 Cor.  
Barre  
L. Howard  
house  
21

22

Township 11 S, Range 21 E.

V. Ranch  
Oct 8, 9, 1923  
5

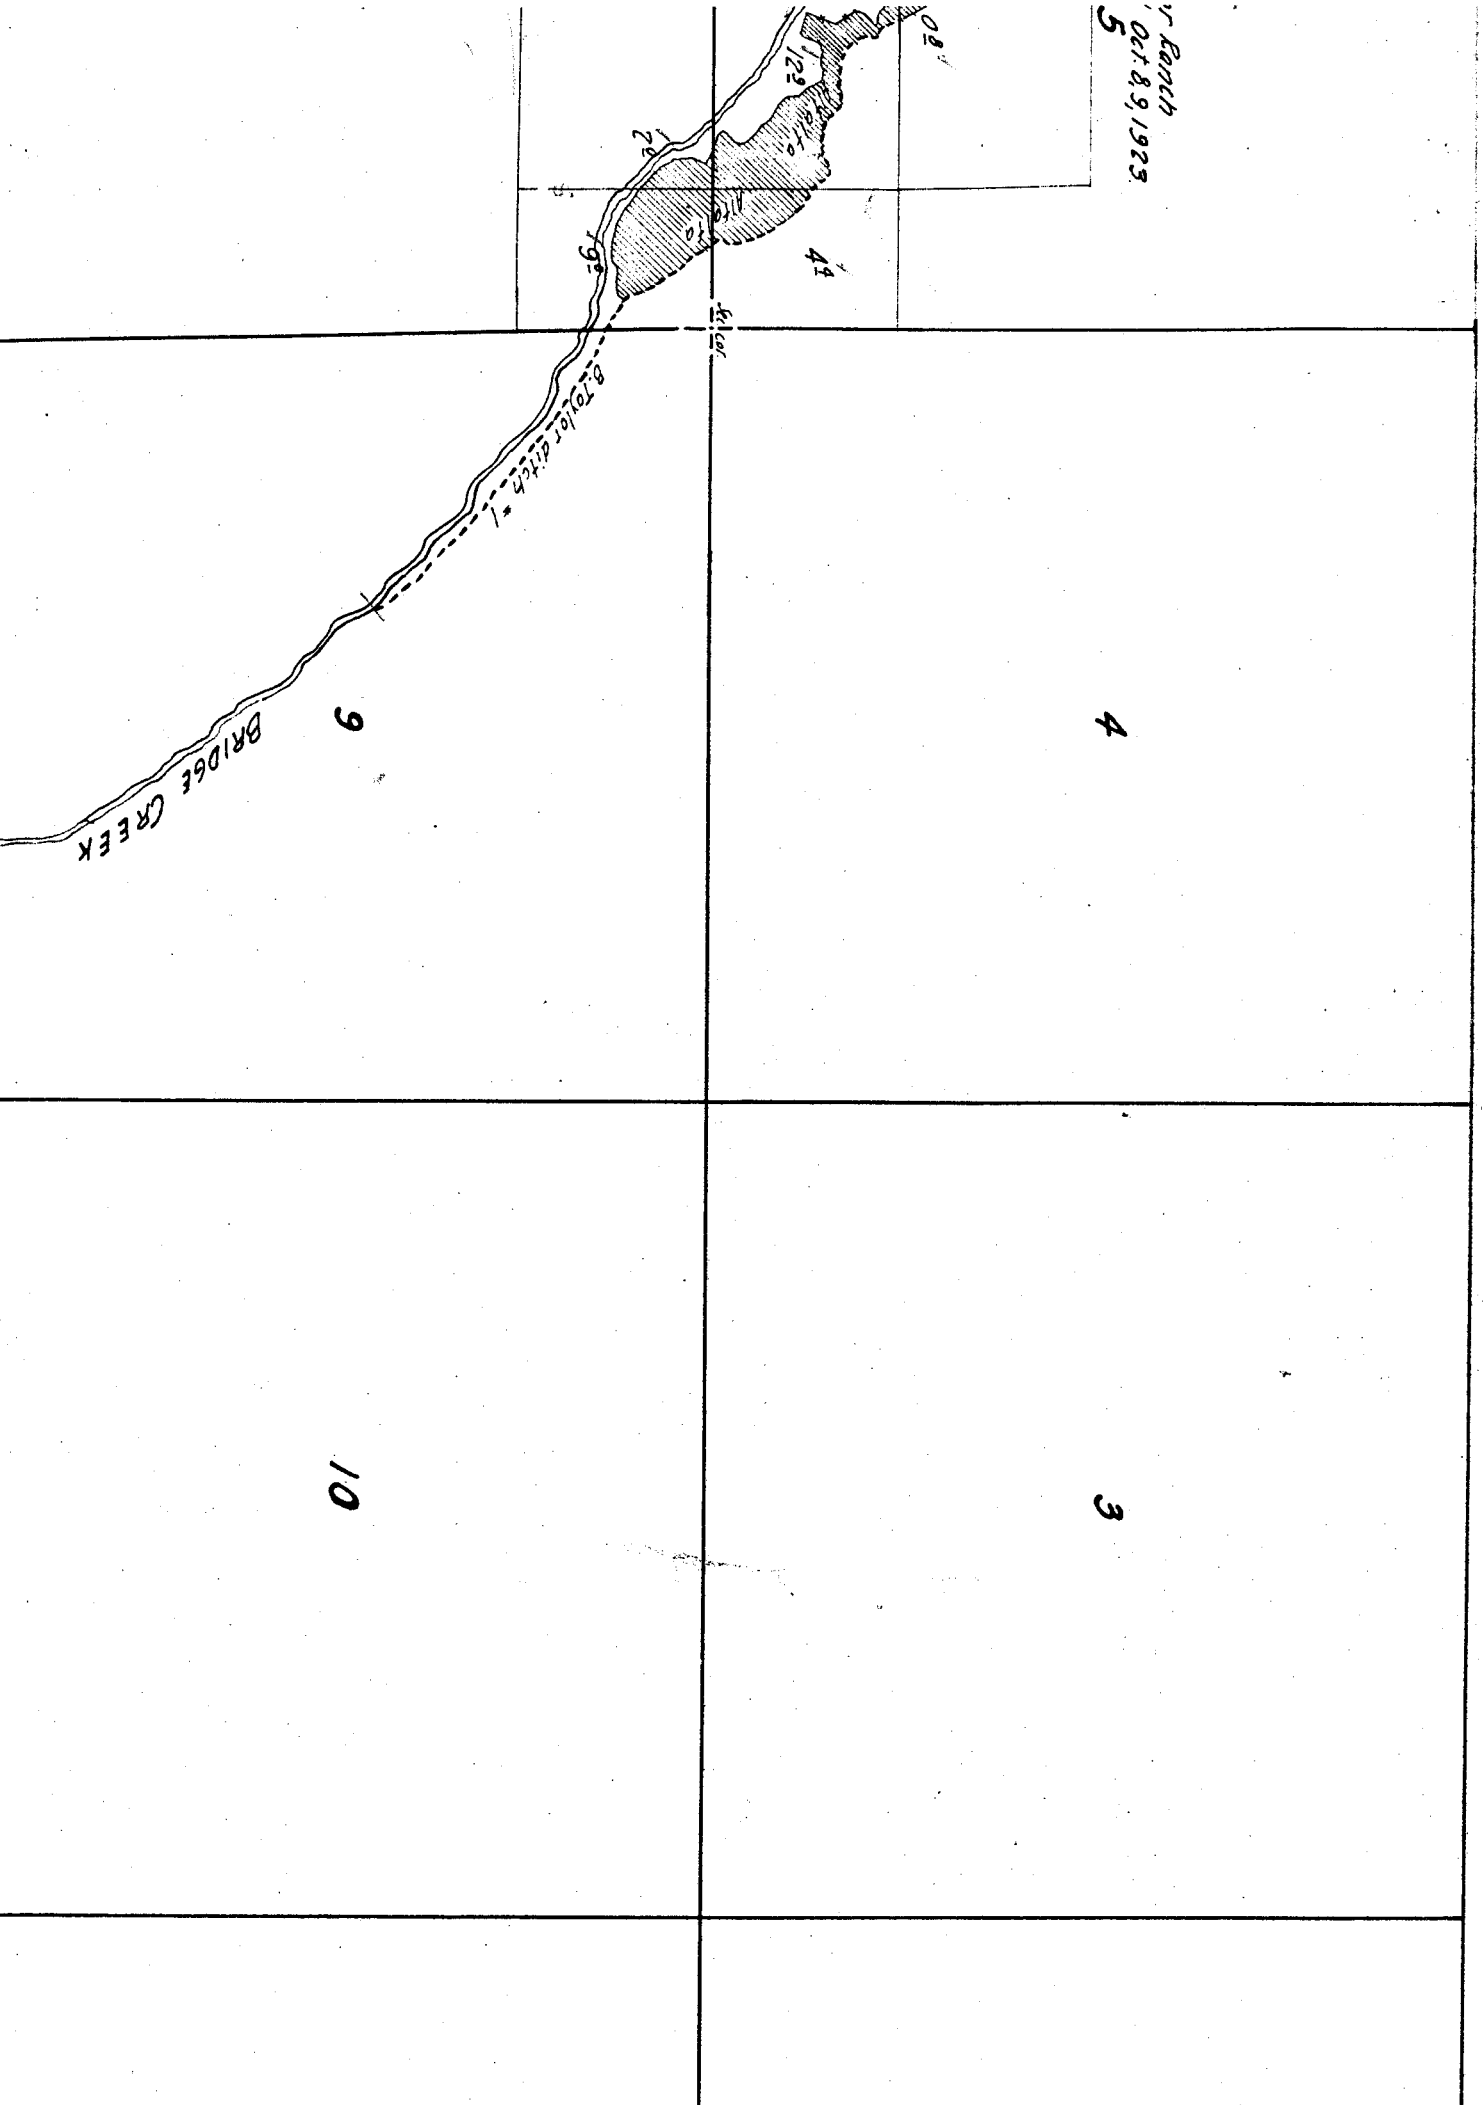

112'  
Jones Ranch  

27

34

26

35


25

36

Nelson Creek

Surveyed Nov 6, 1923

MITCHELL

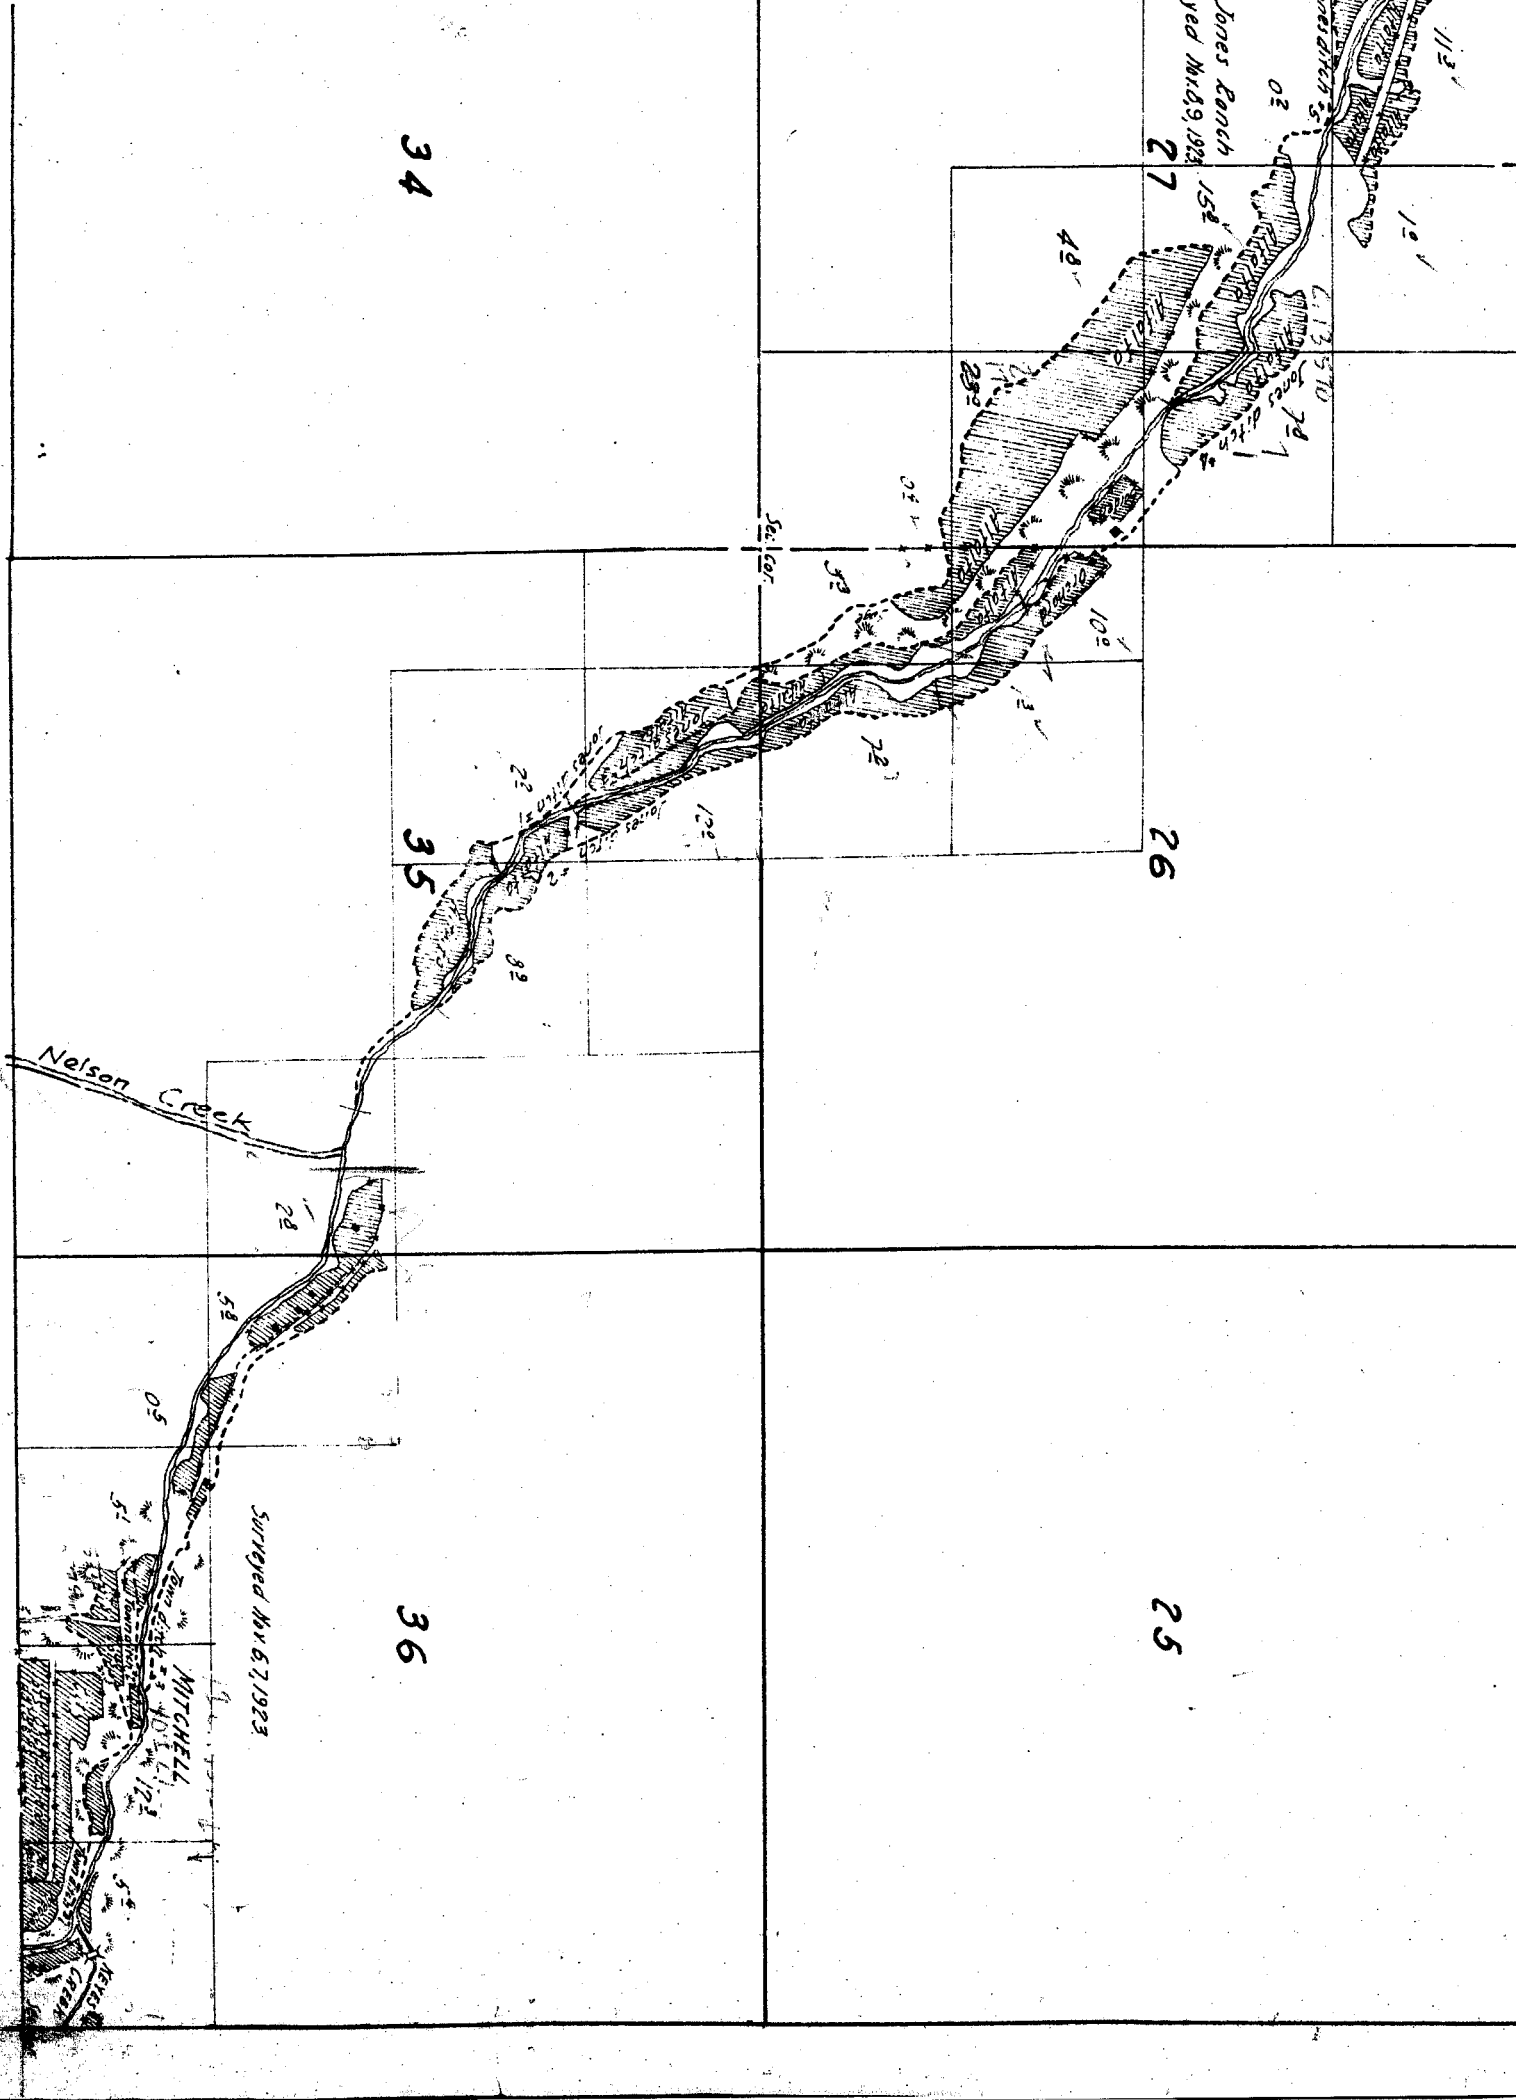

15

14

13

*s. partly sketched in approximate  
form U.S. Township plot.*

22

23


24

41205


16

17

18

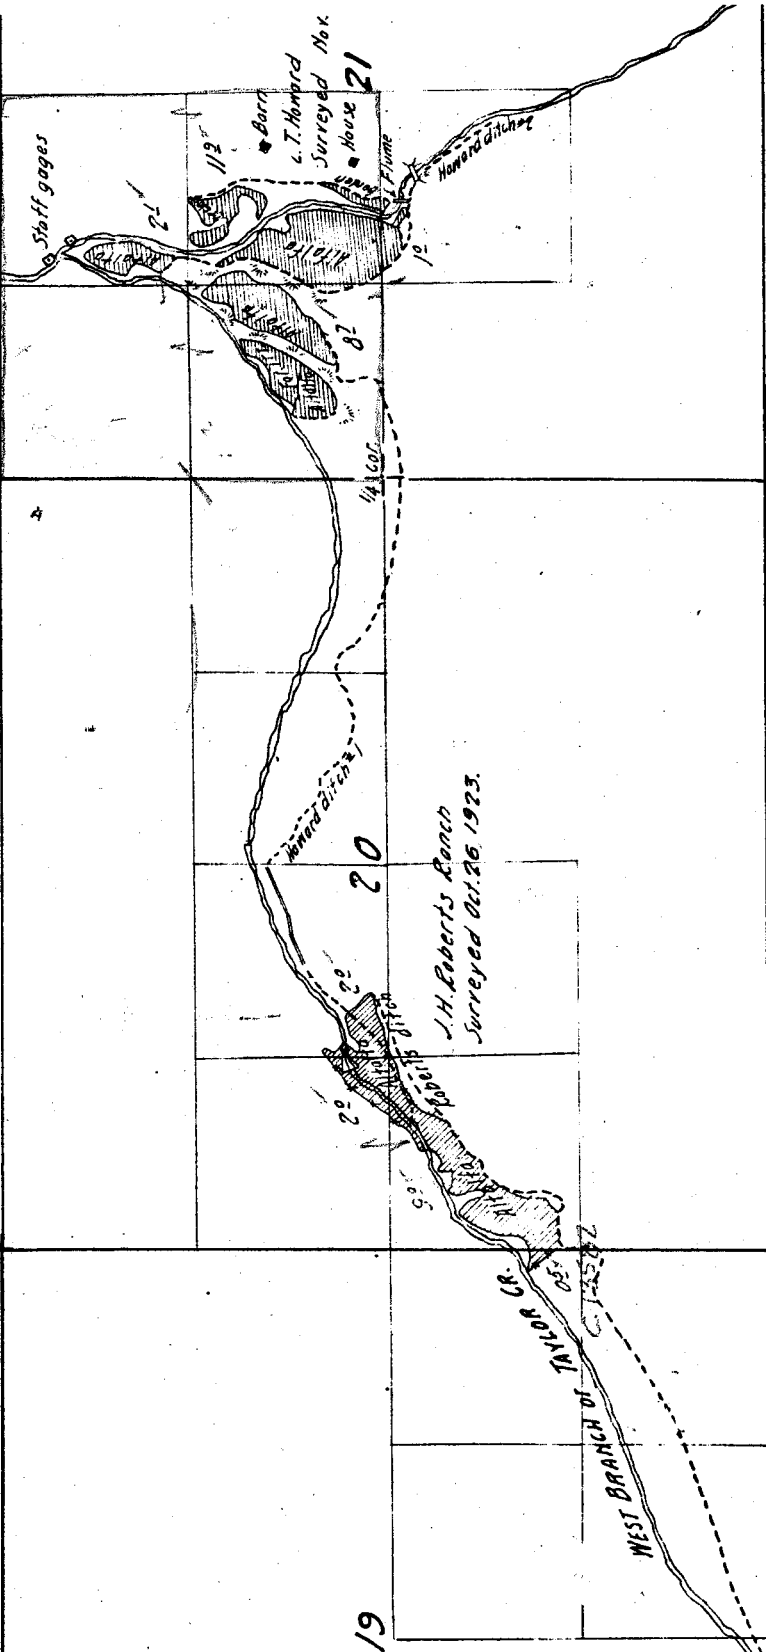



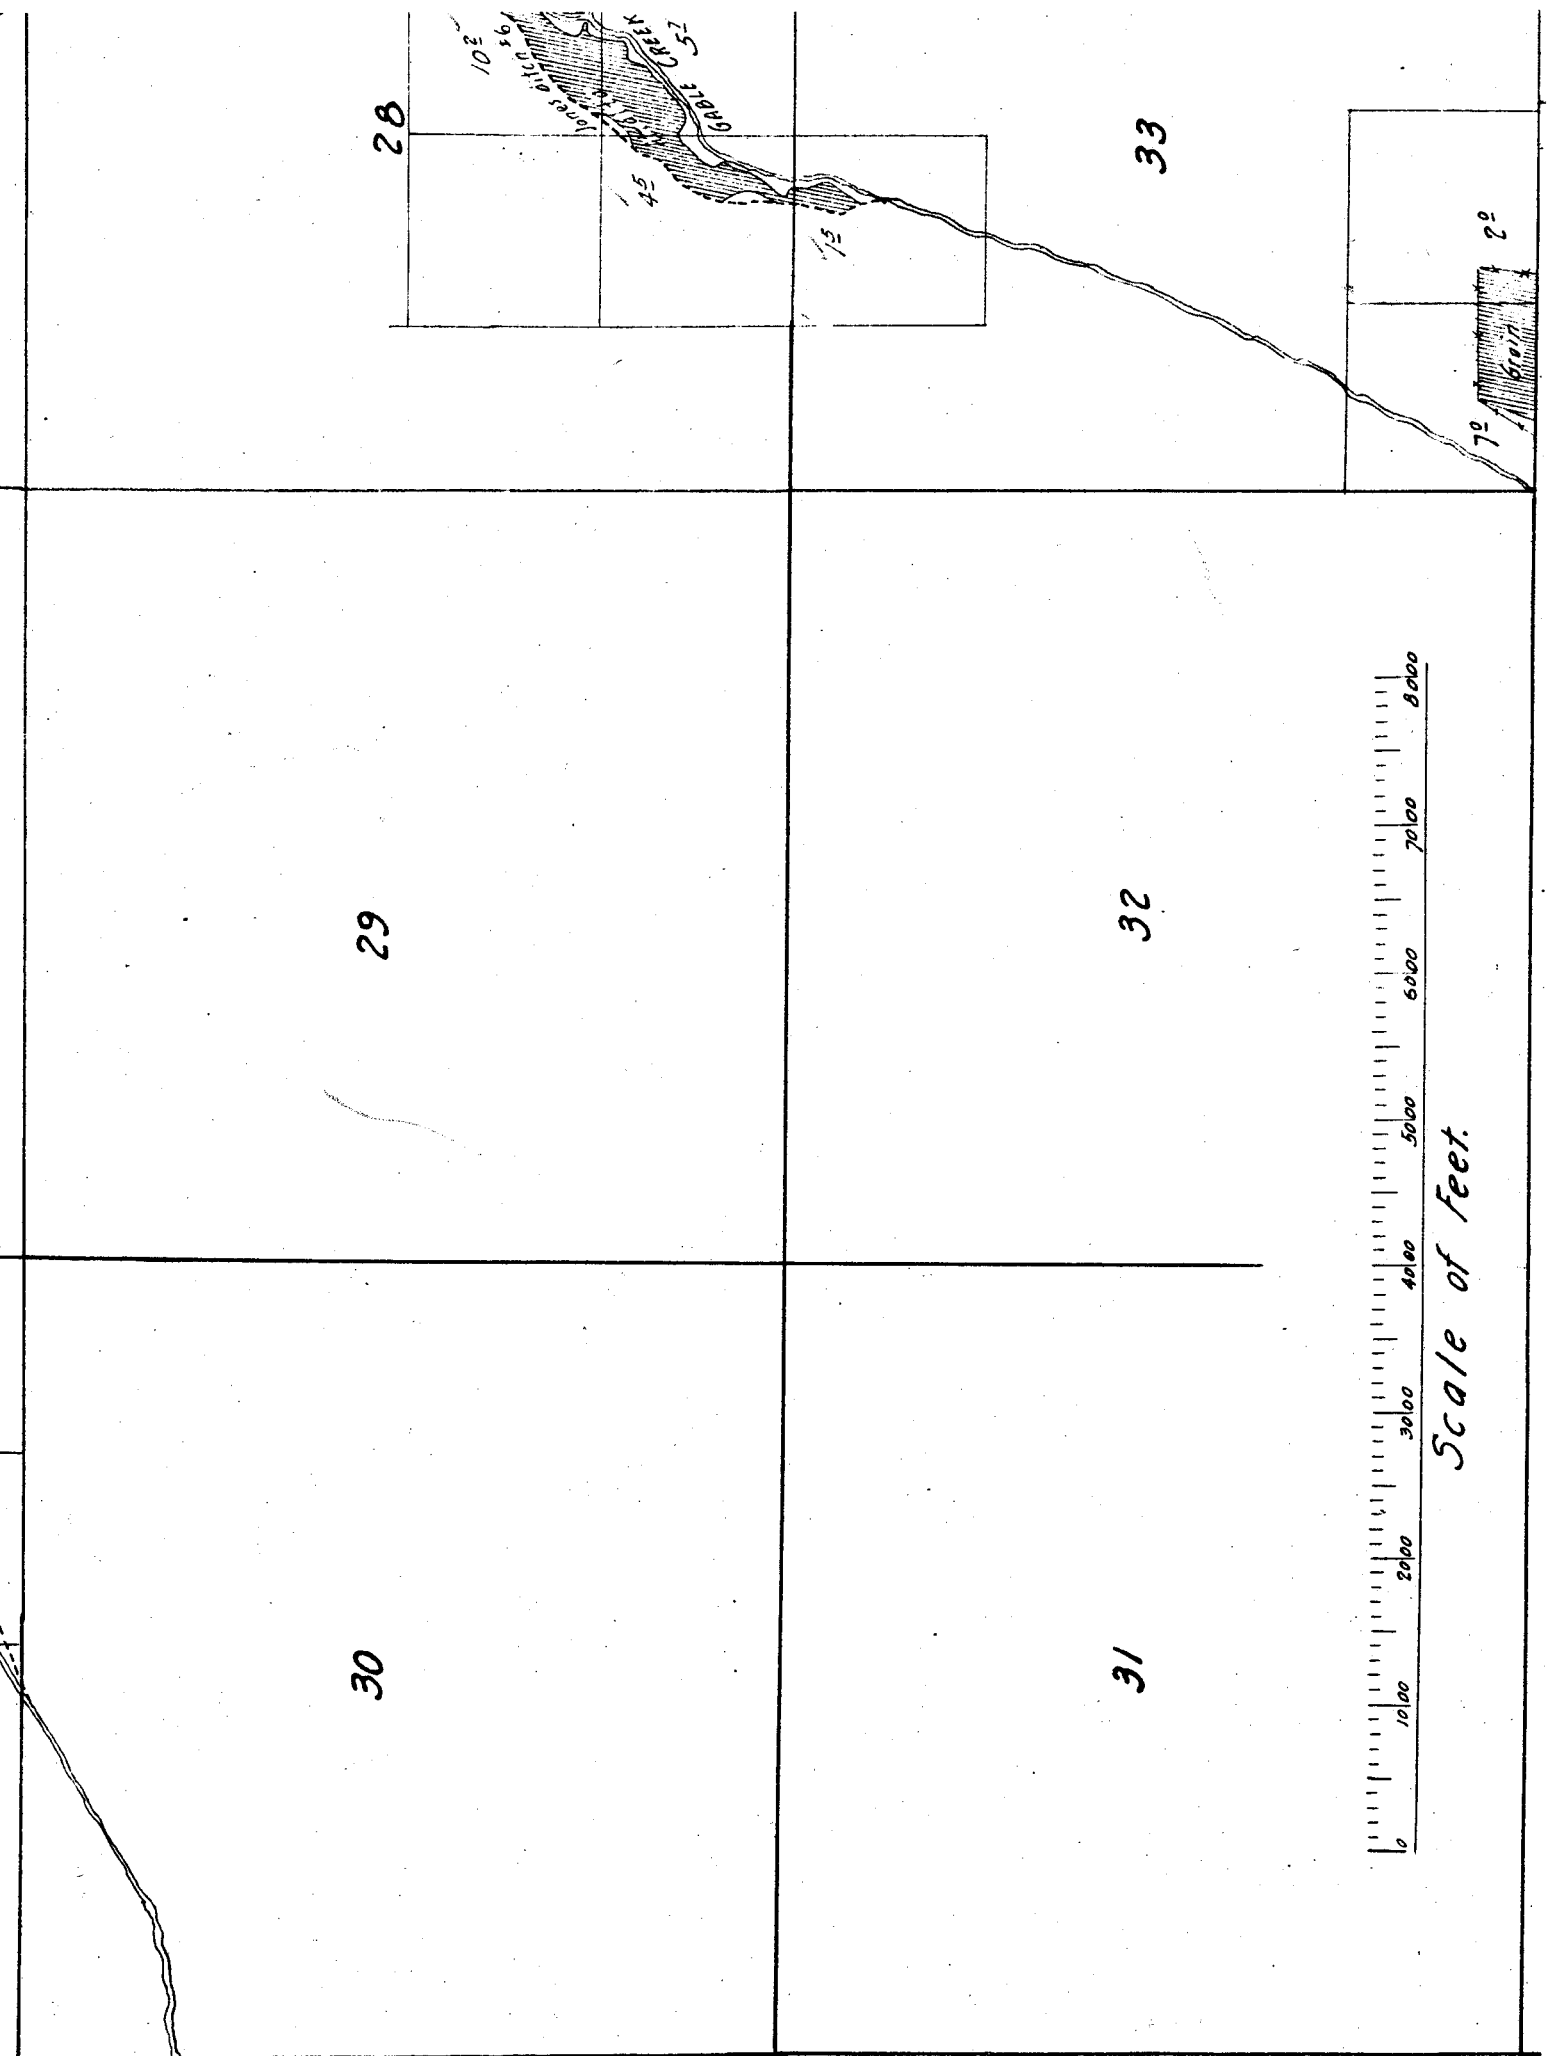

28

33

29

32

30

31



Scale of feet.

GRABLE CREEK  
JOHNS DITCH  
105  
195  
301

45

51

70

20