


ownship

12 S,

Range

20 E.

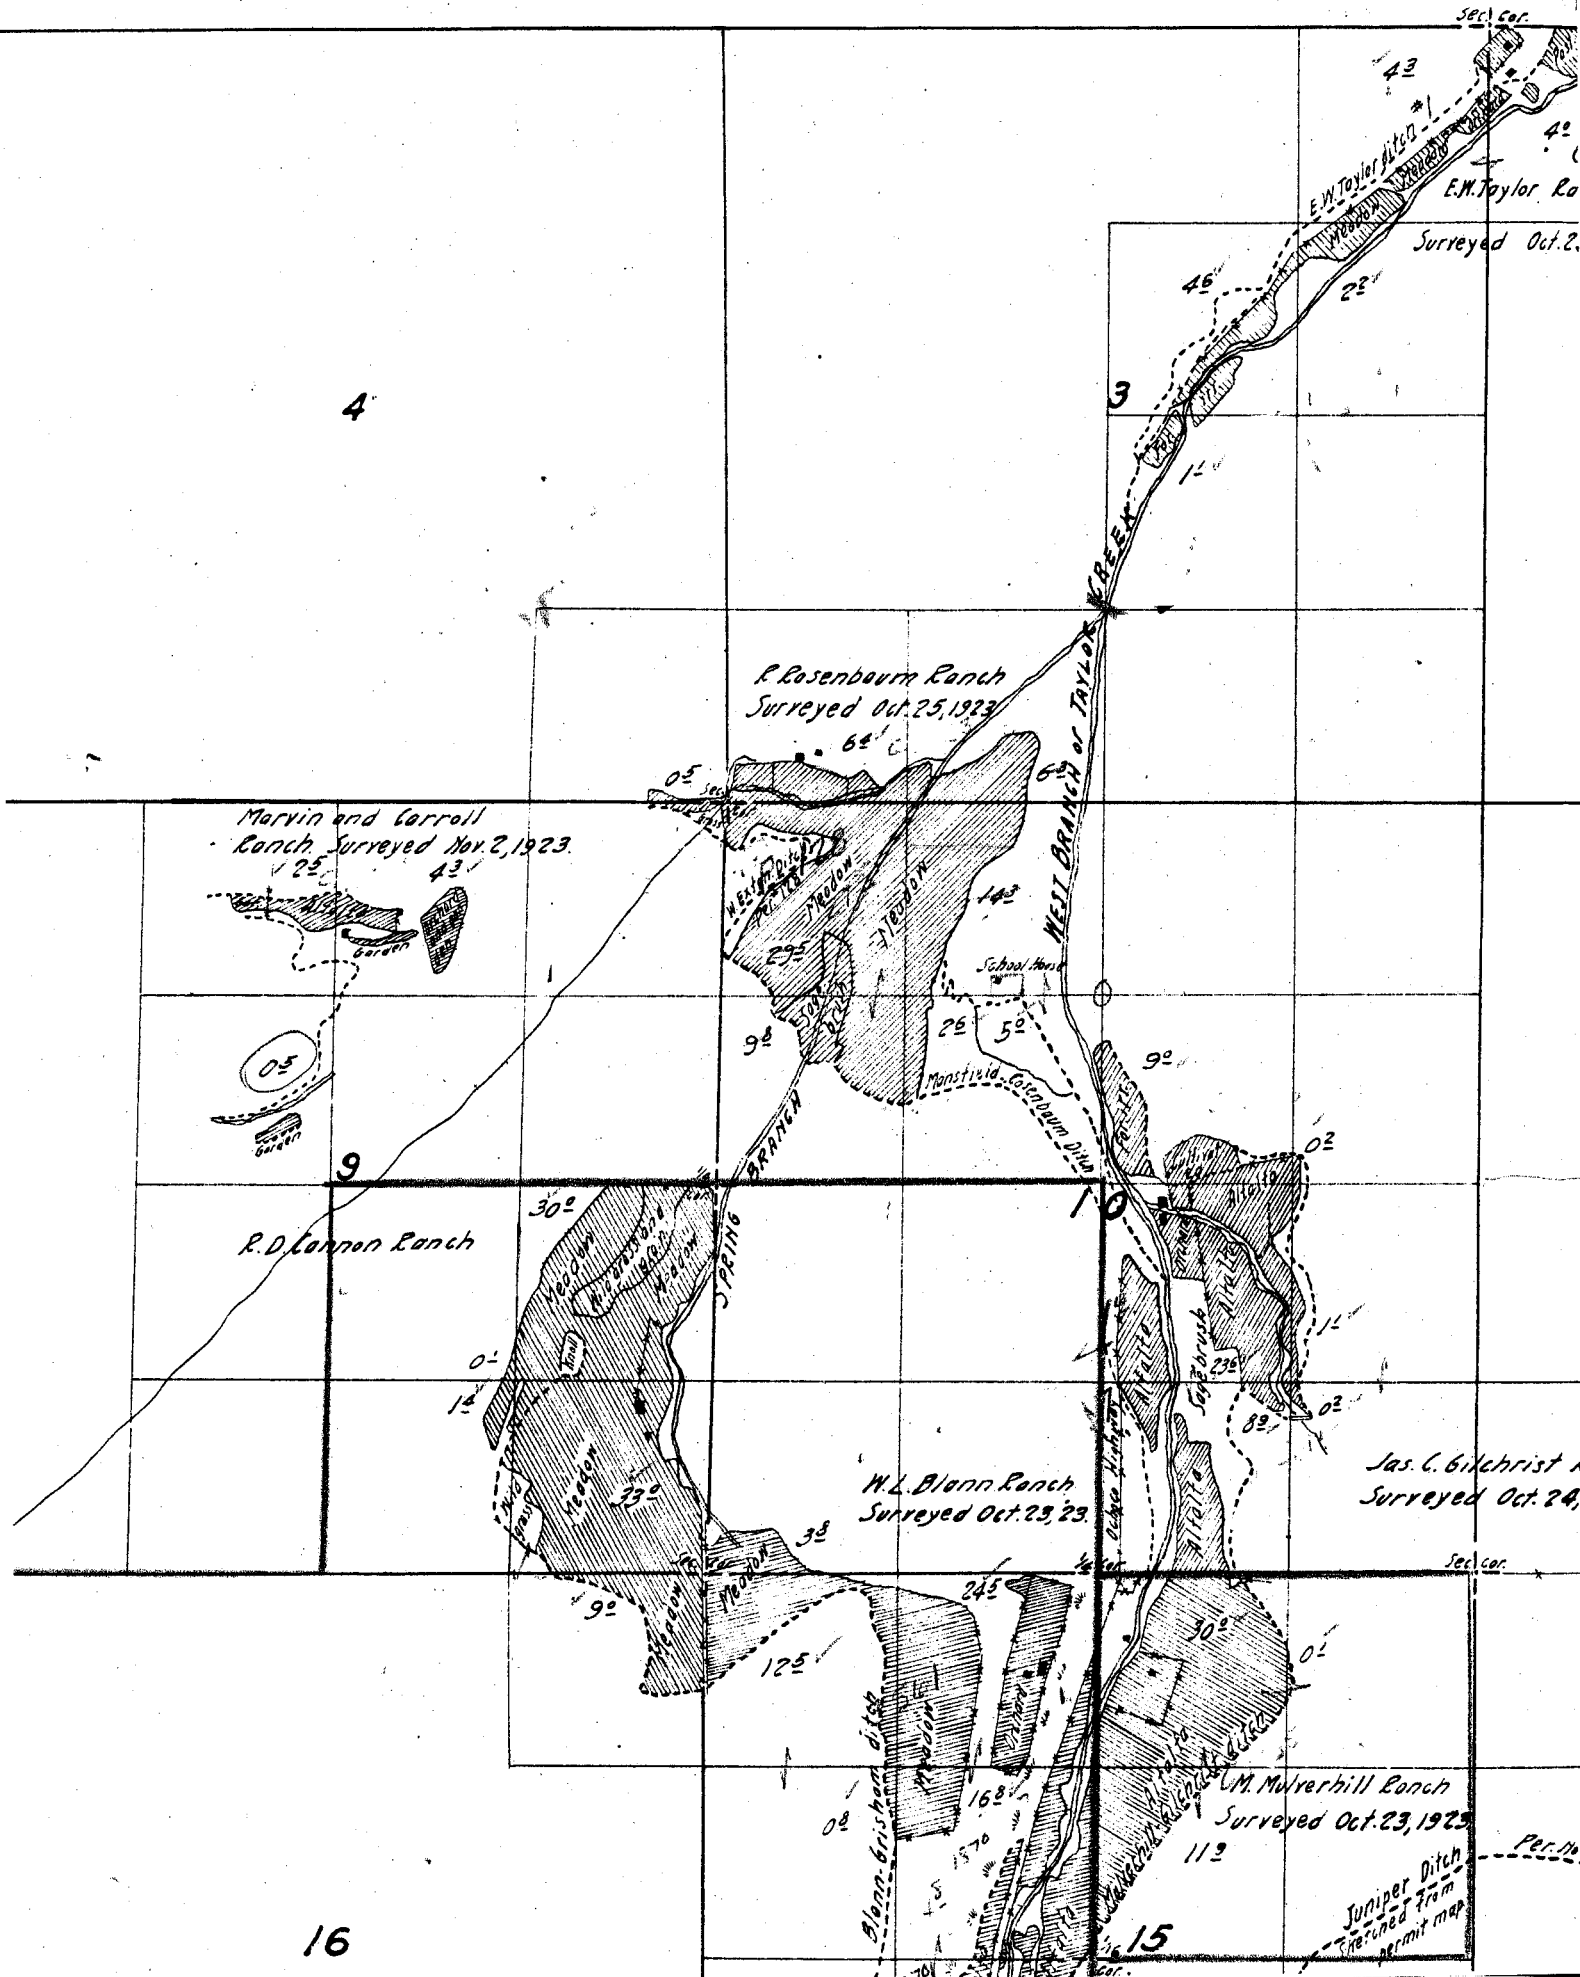

23

24

THOMPSON


26

25

*Note: - Creeks sketched in approximate
location from U.S. Township plat, U.S. Forest
Service map, and permit maps, except in
vicinity of irrigated areas.*

35

36

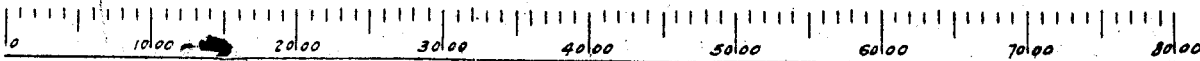

Scale of Feet.

32


31

29

30

20

19

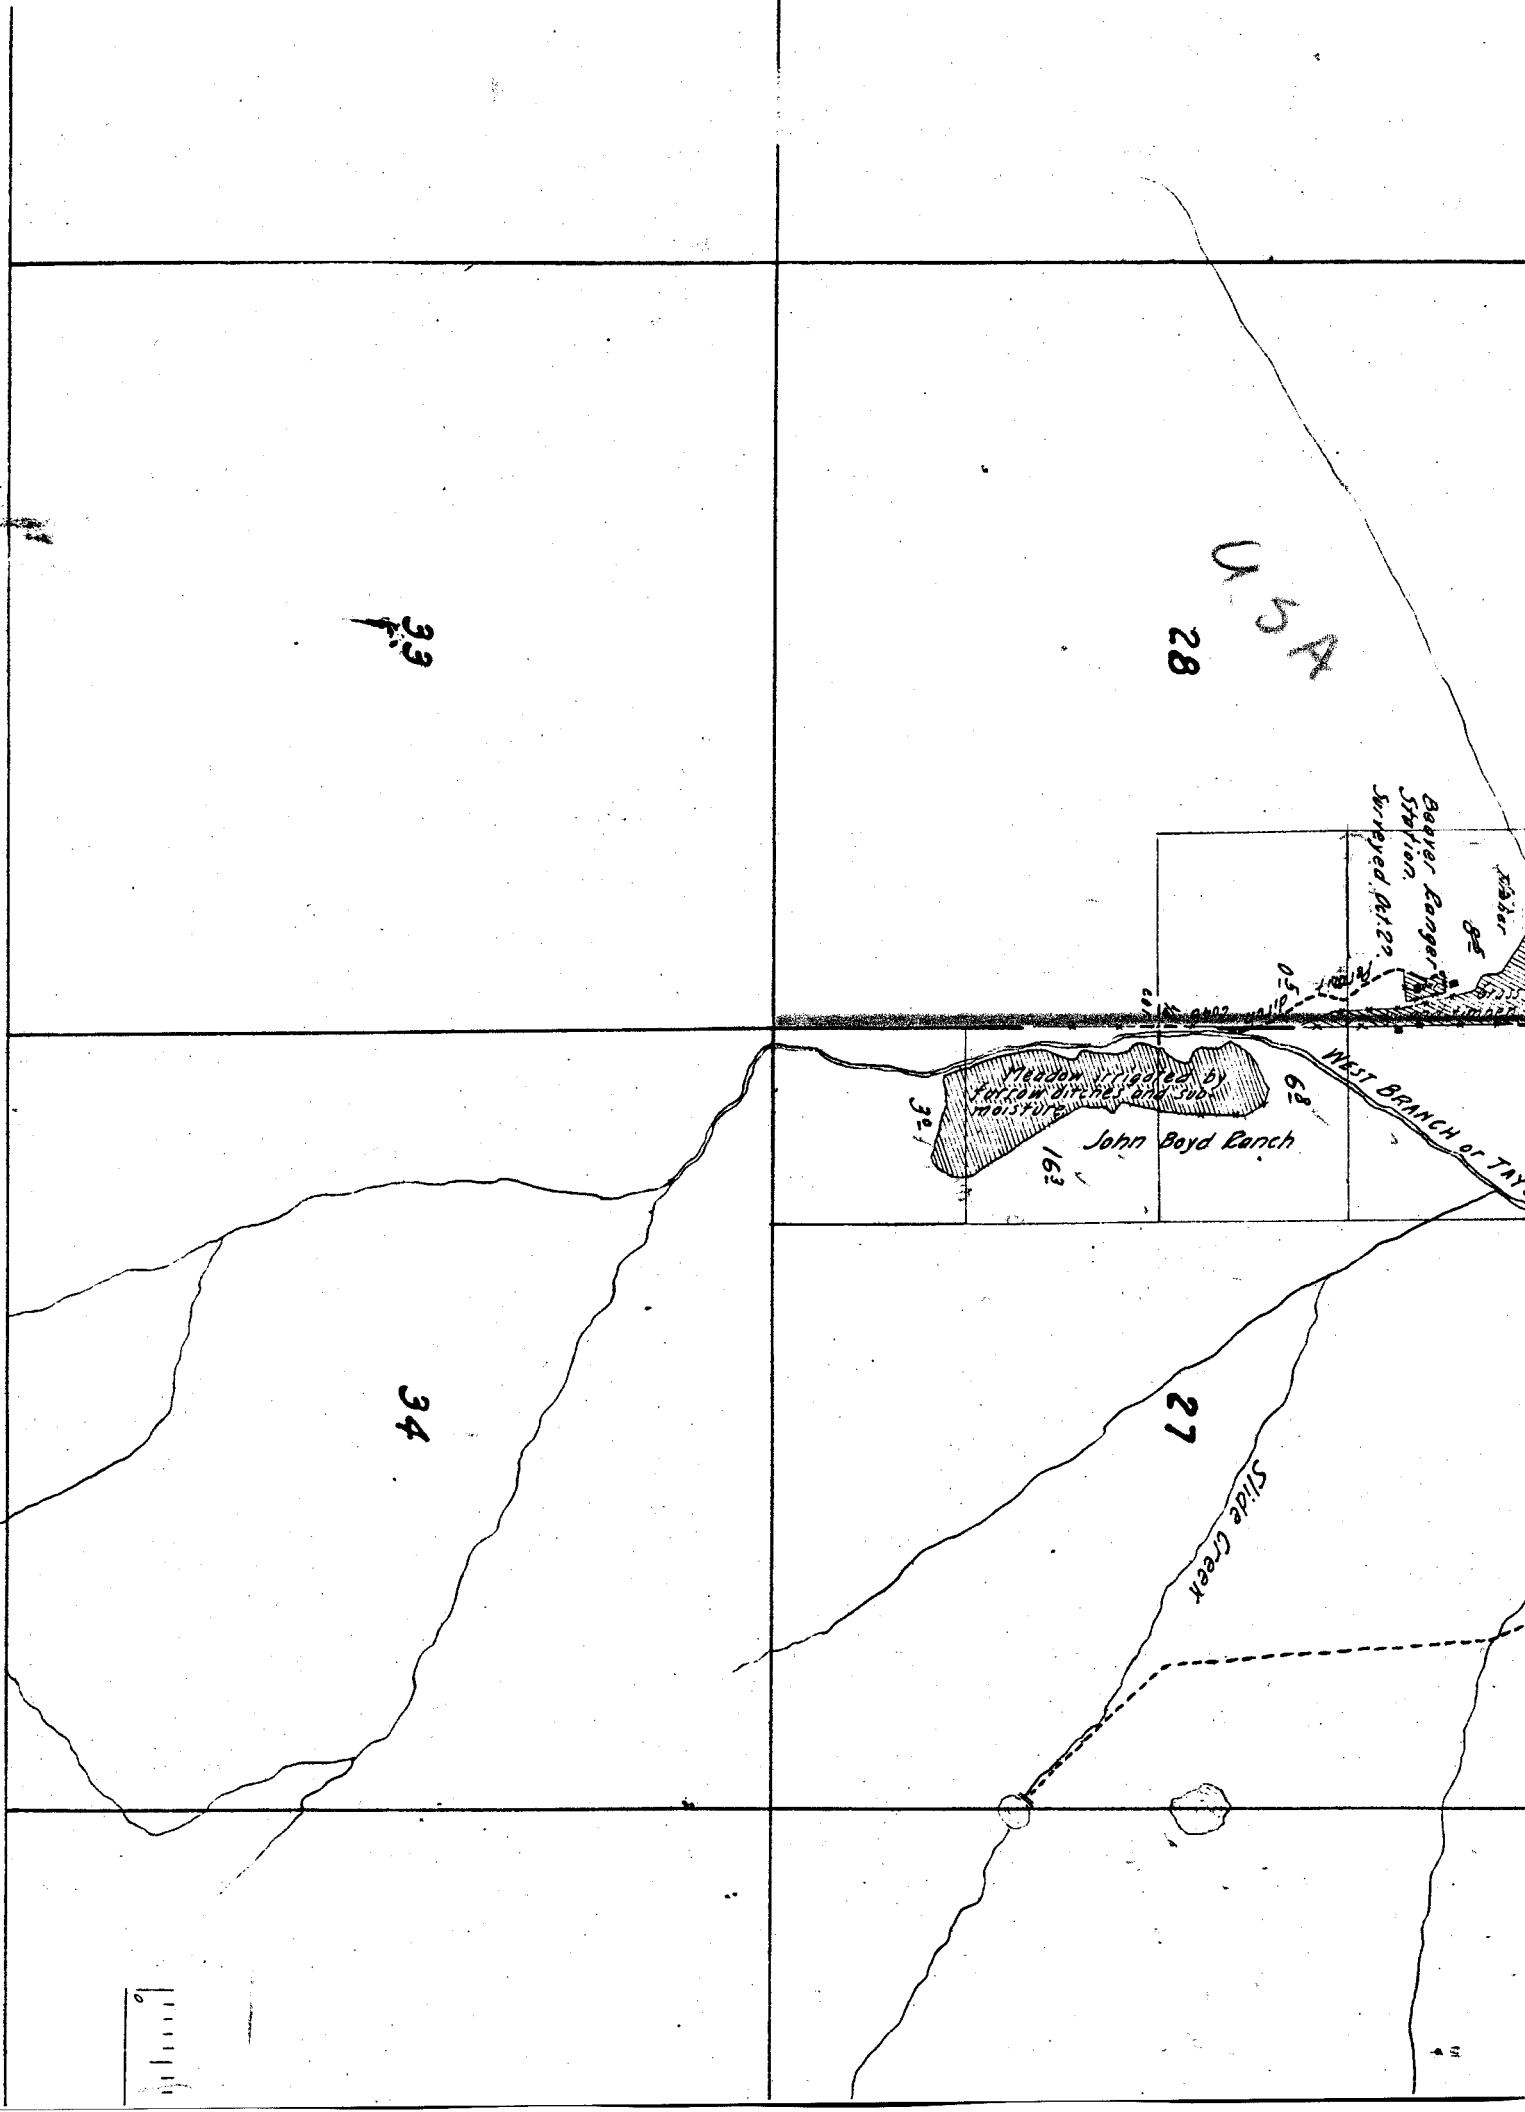

USA
28

33

Boyer Ranger
Station


Meadow irrigated by
narrow ditches and sub-
moisture
John Boyd Ranch
163

West Branch of TN

27


Side Creek

34

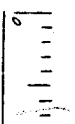


16


21

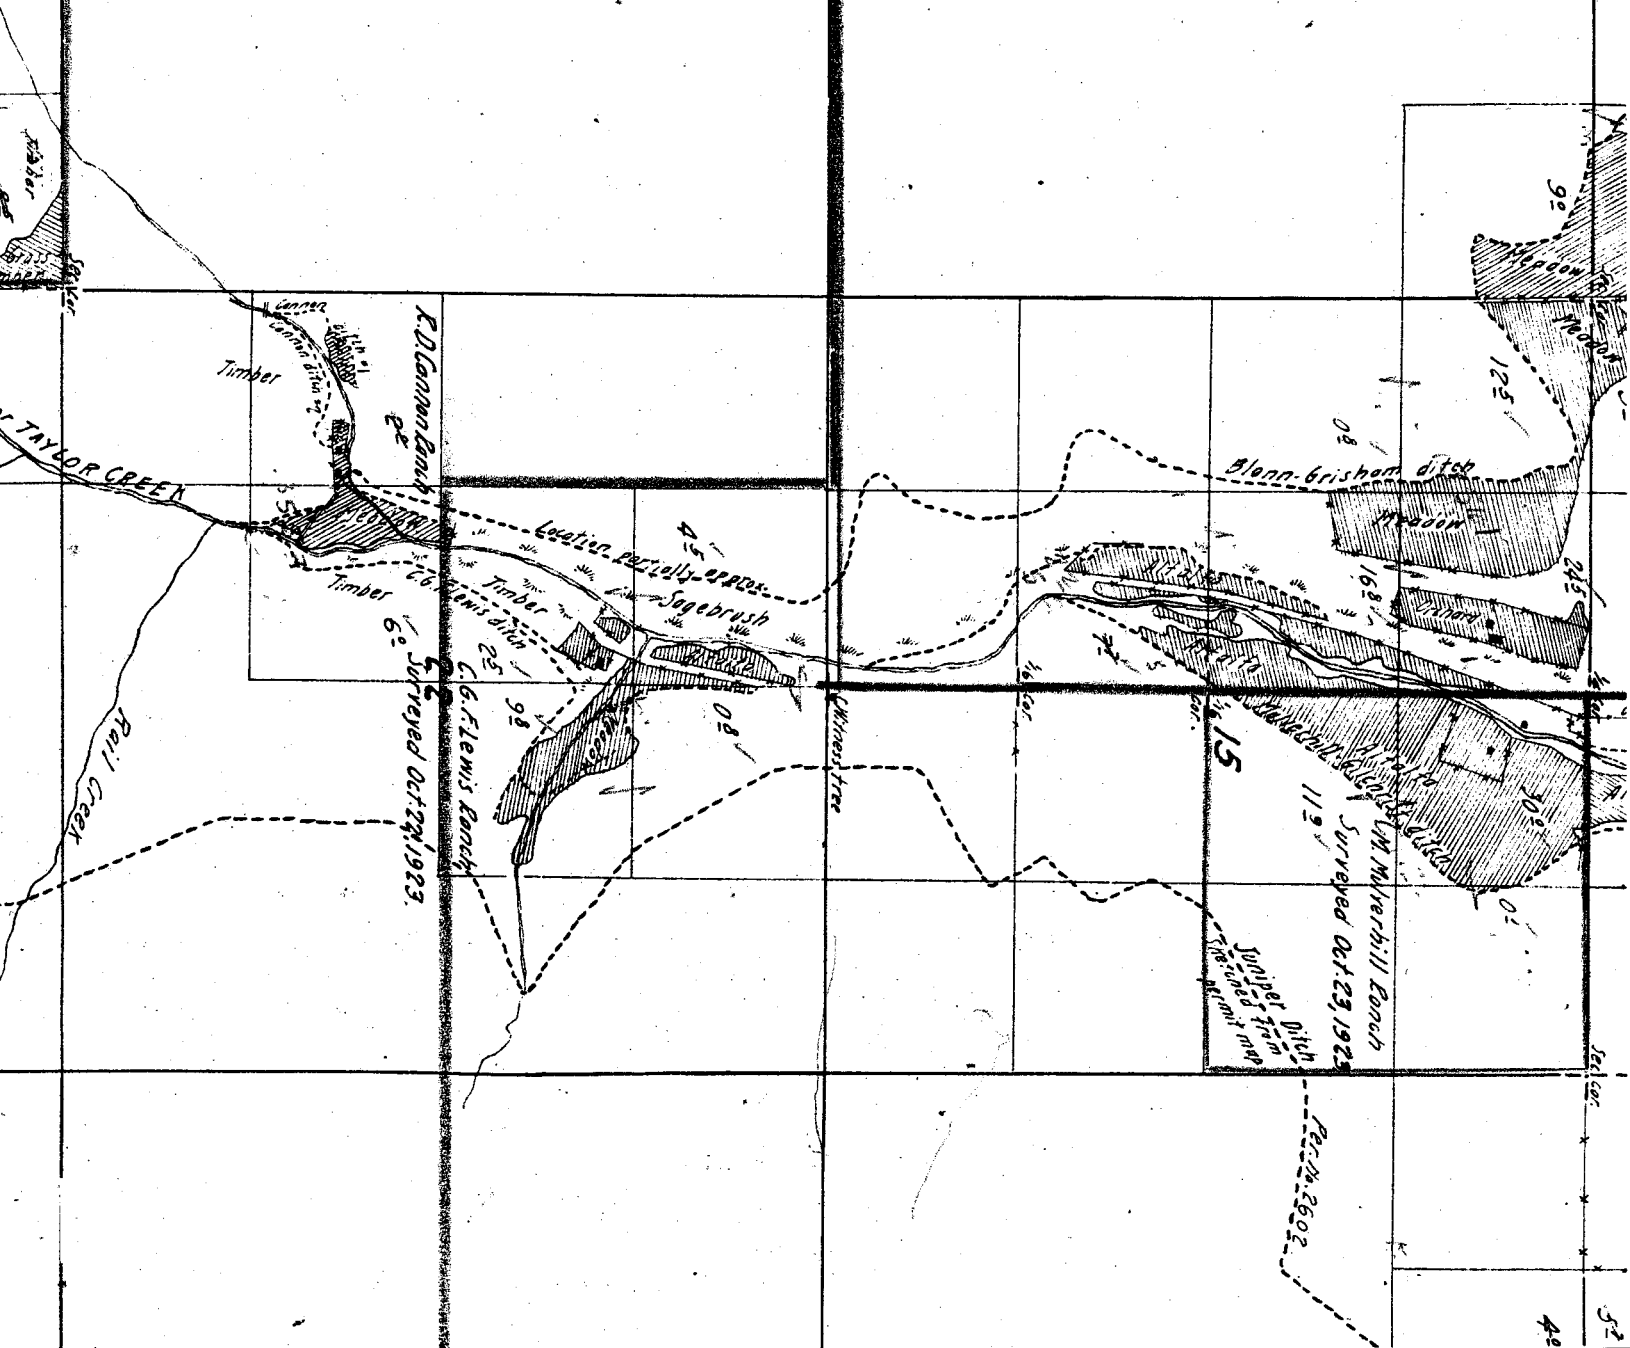

ge' 20 E.

9-1-1

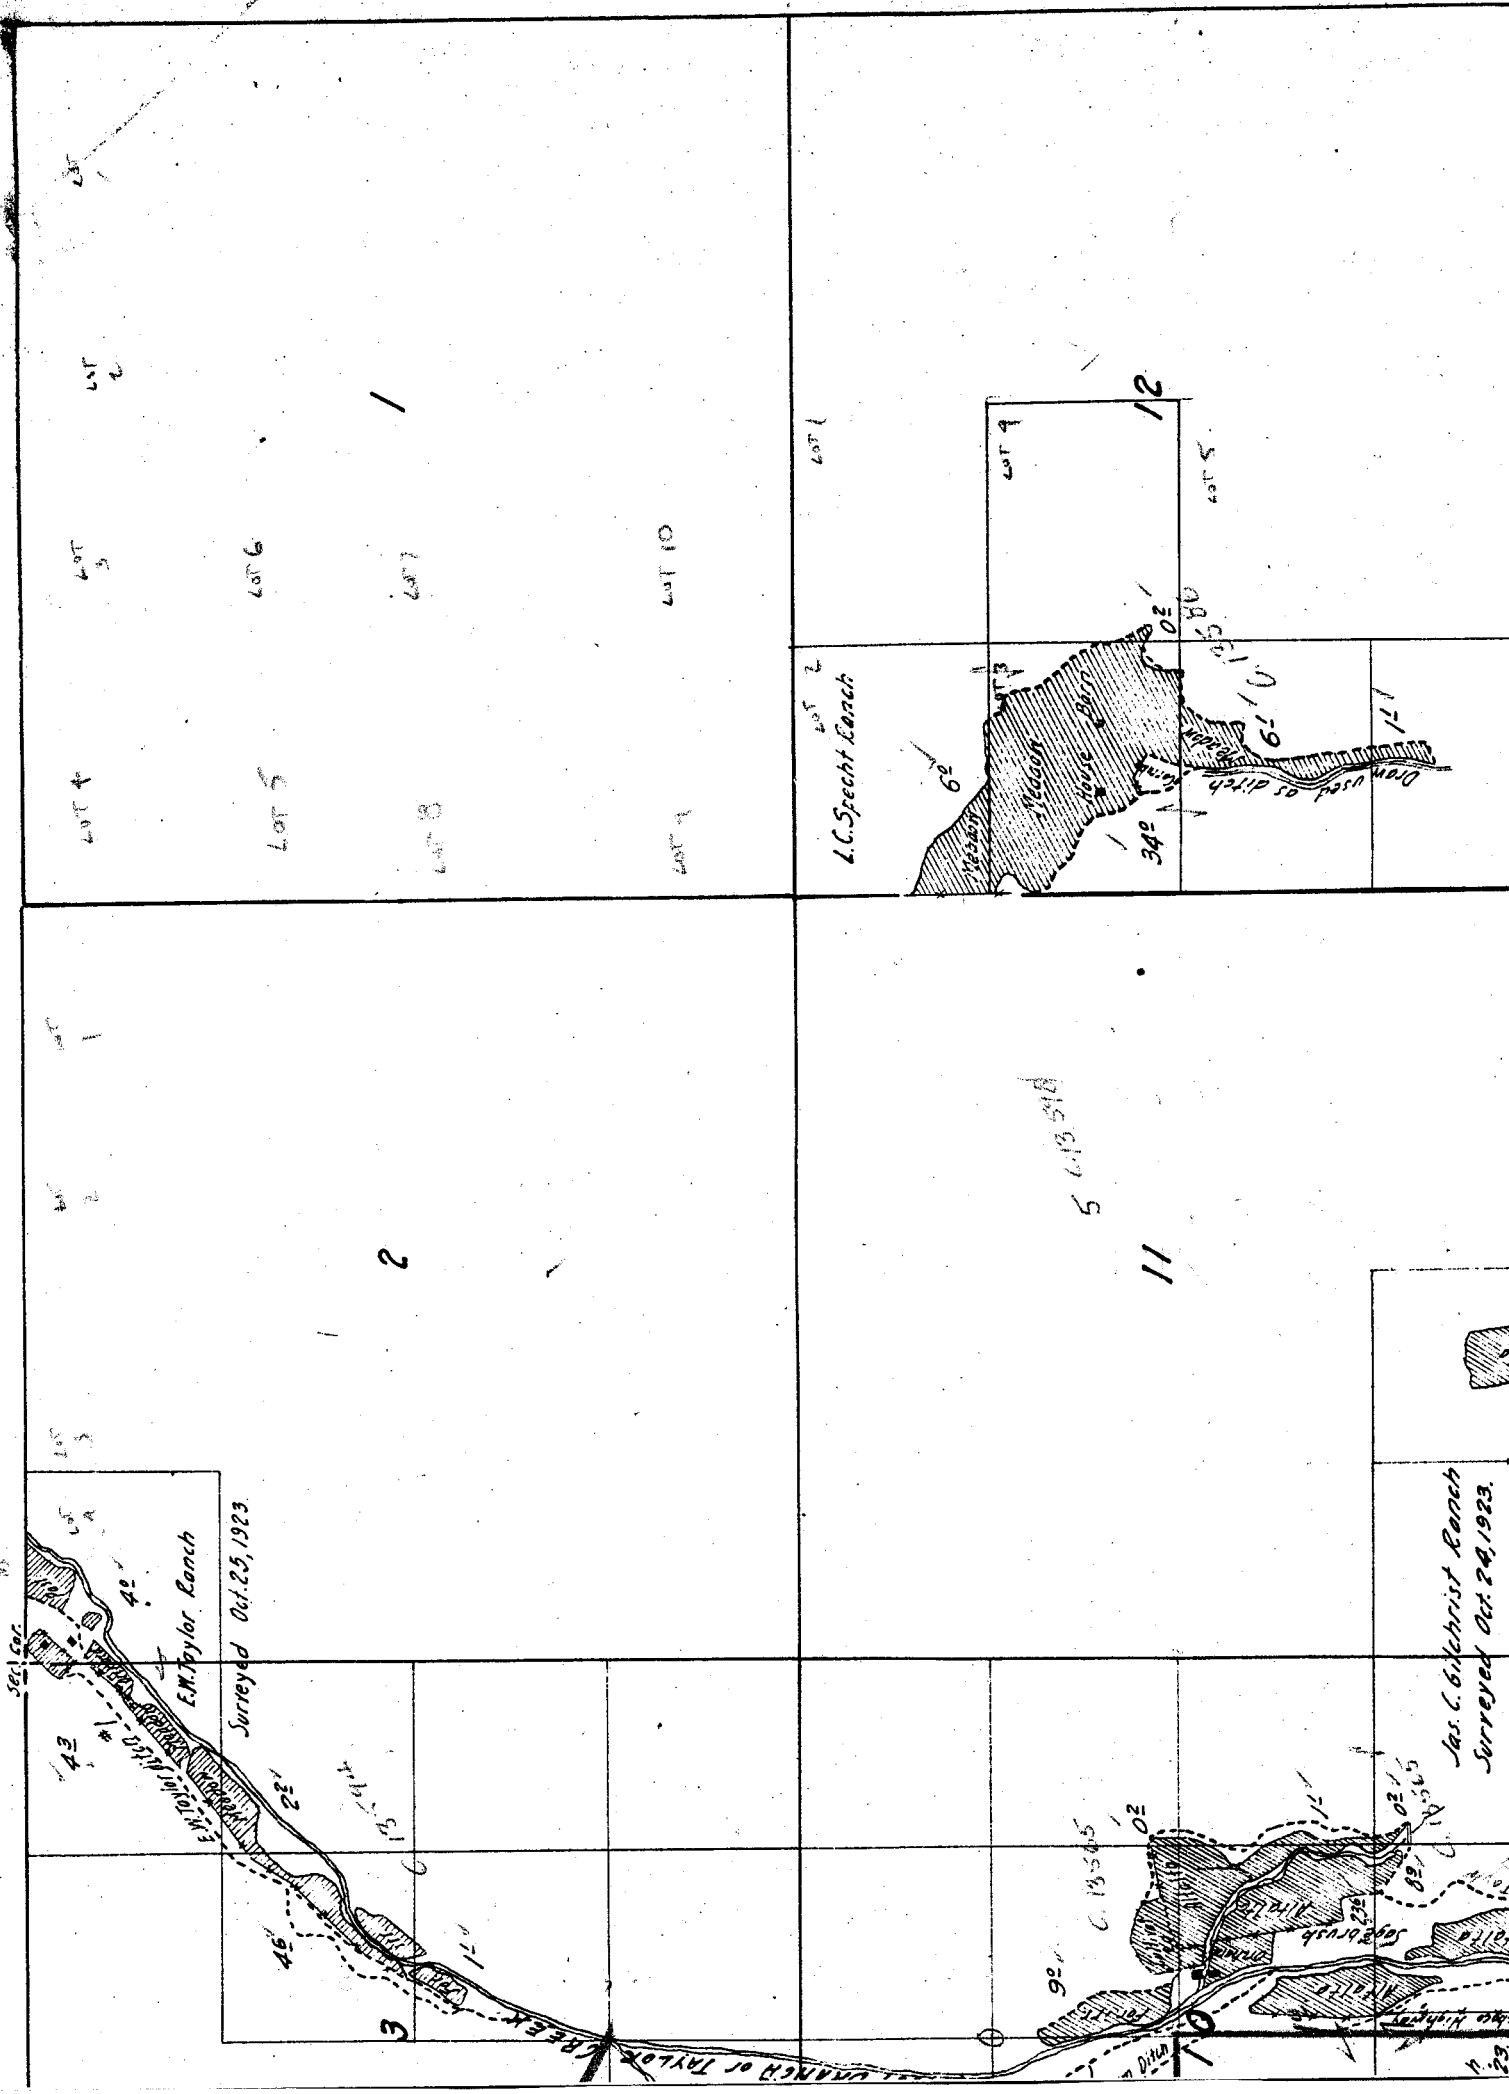

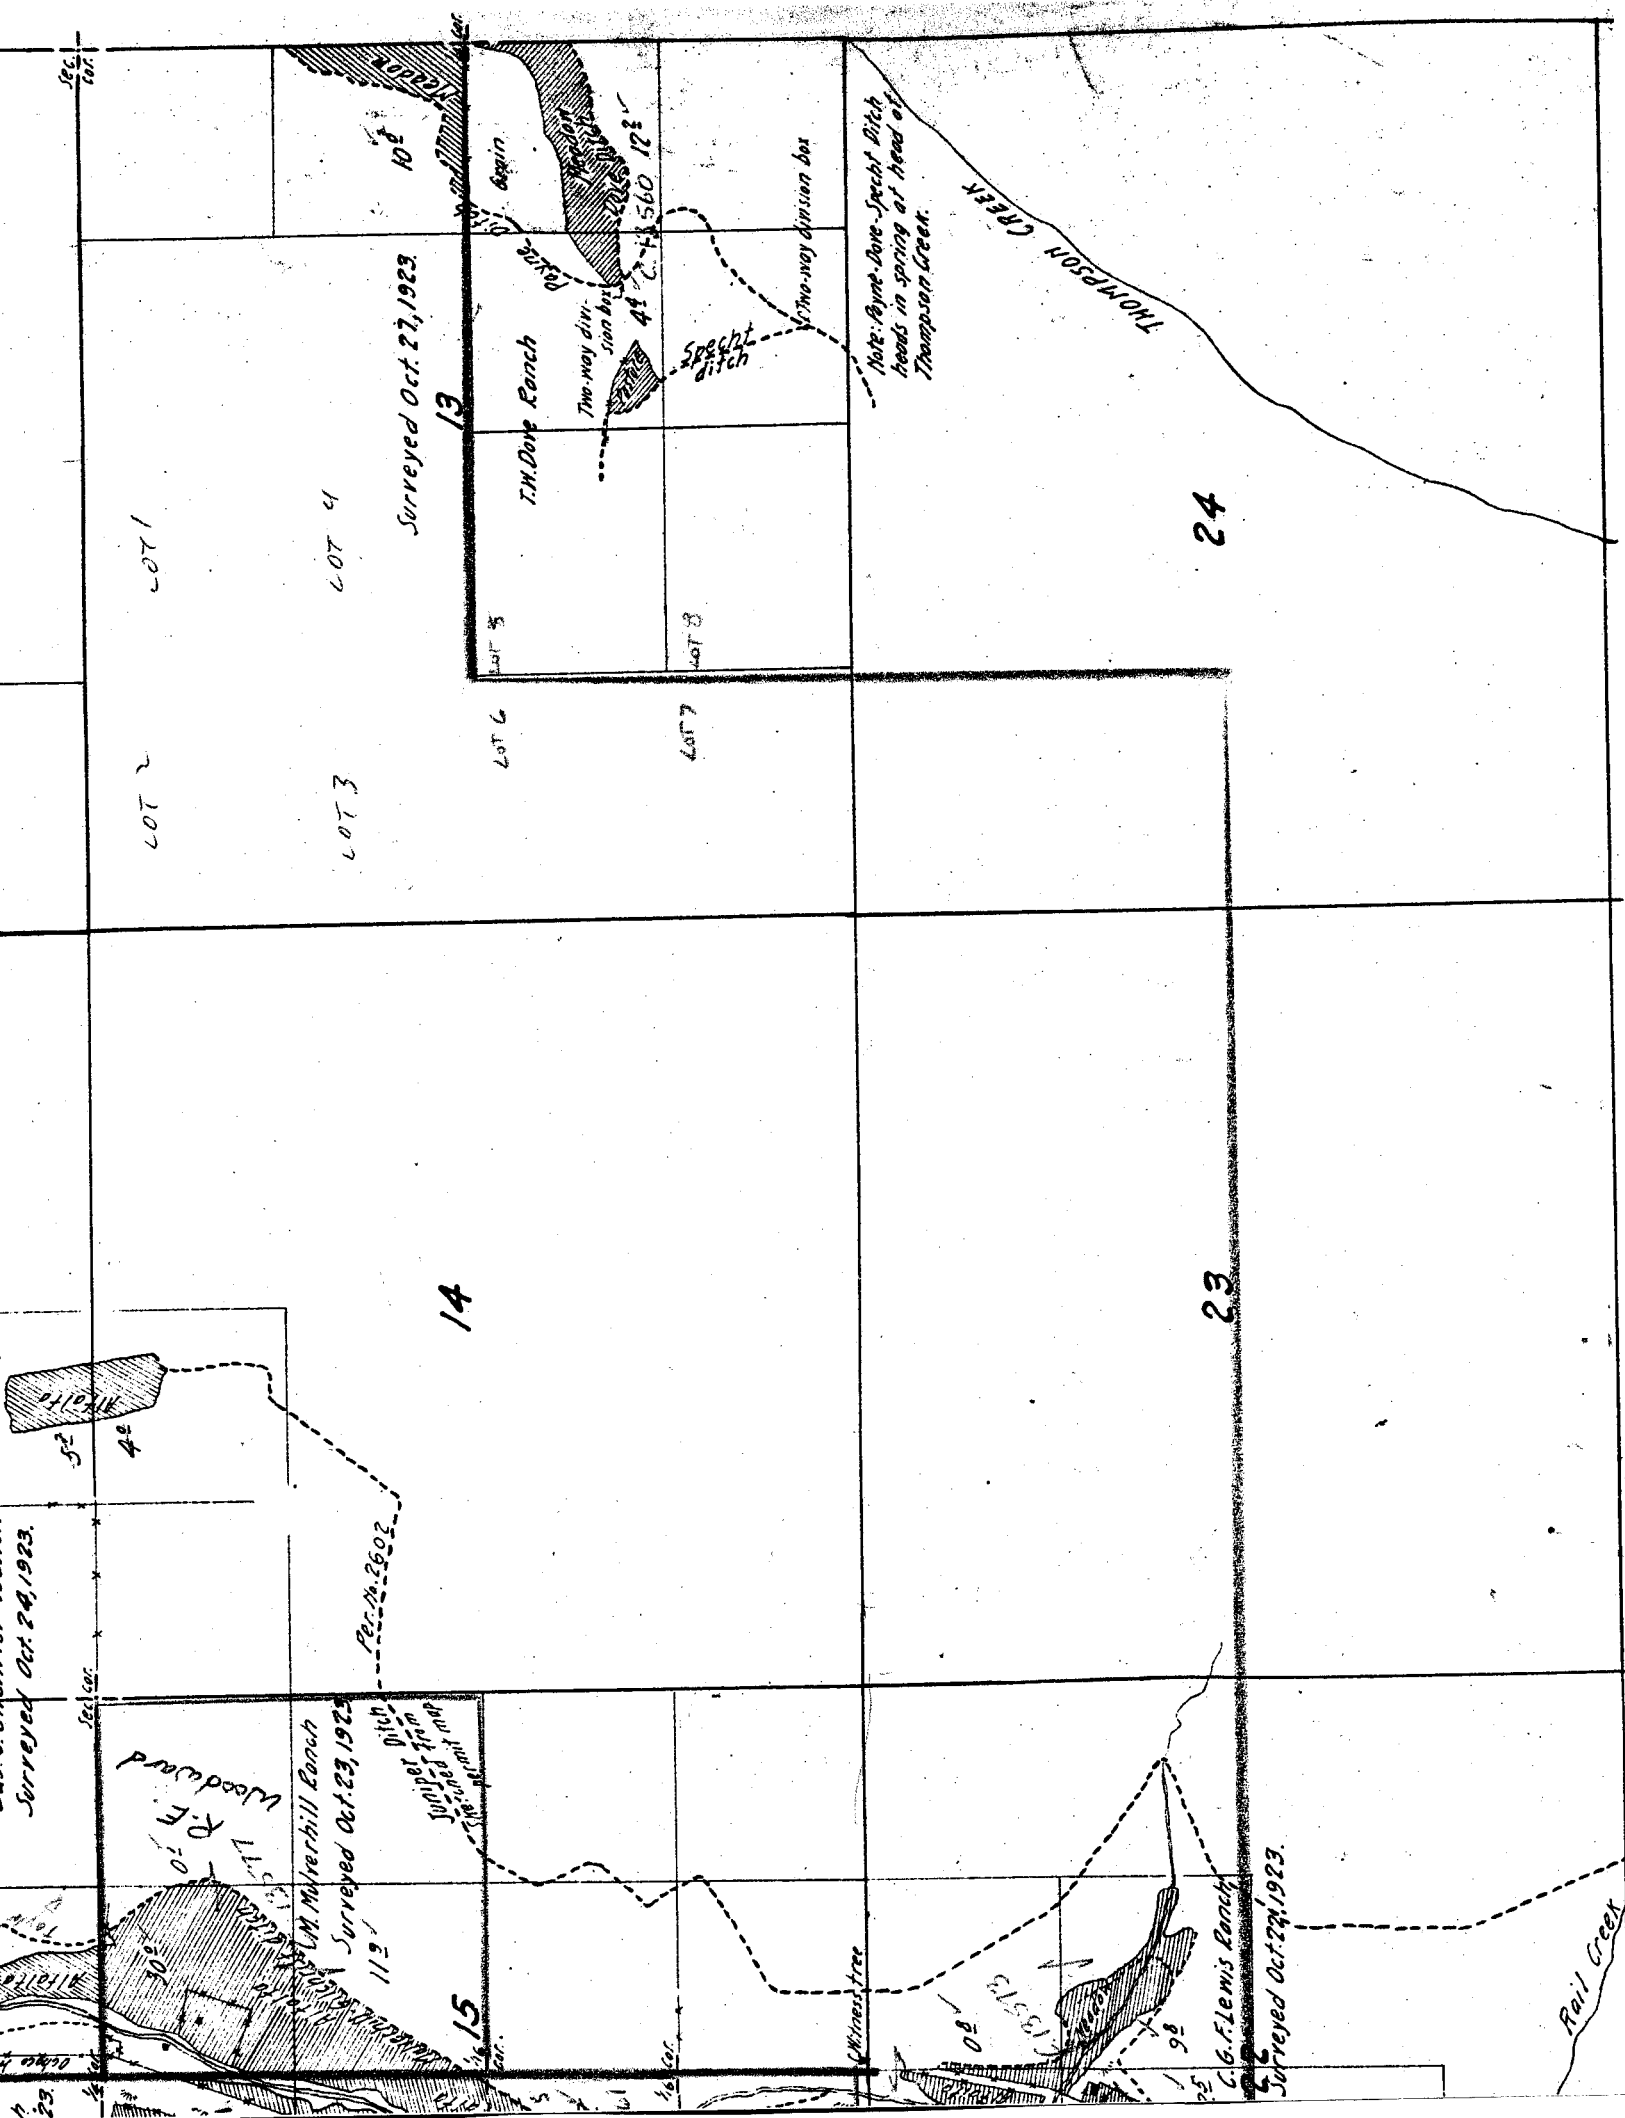

Township

6

5


4

8

9

Marvin and
Lanck Survey
1880 1884

R.D. Cannon E.

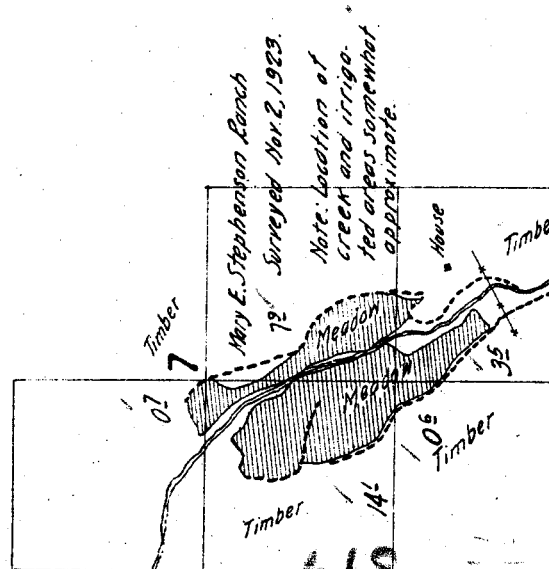

May E. Stephenson Ranch
79' Surveyed Nov. 2, 1923.

Stephenson

12


16

68

17

61

18

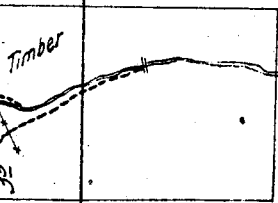

HEFLIN CREEK