

Jones Ranch
158
Surveyed Nov 67, 1923

27

26

25

34

35

36

Nelson Creek

Surveyed Nov 67, 1923

MITCHELL

15

14


13

*is partly sketched in approximate
form U.S. Township plat.*

22

23


24

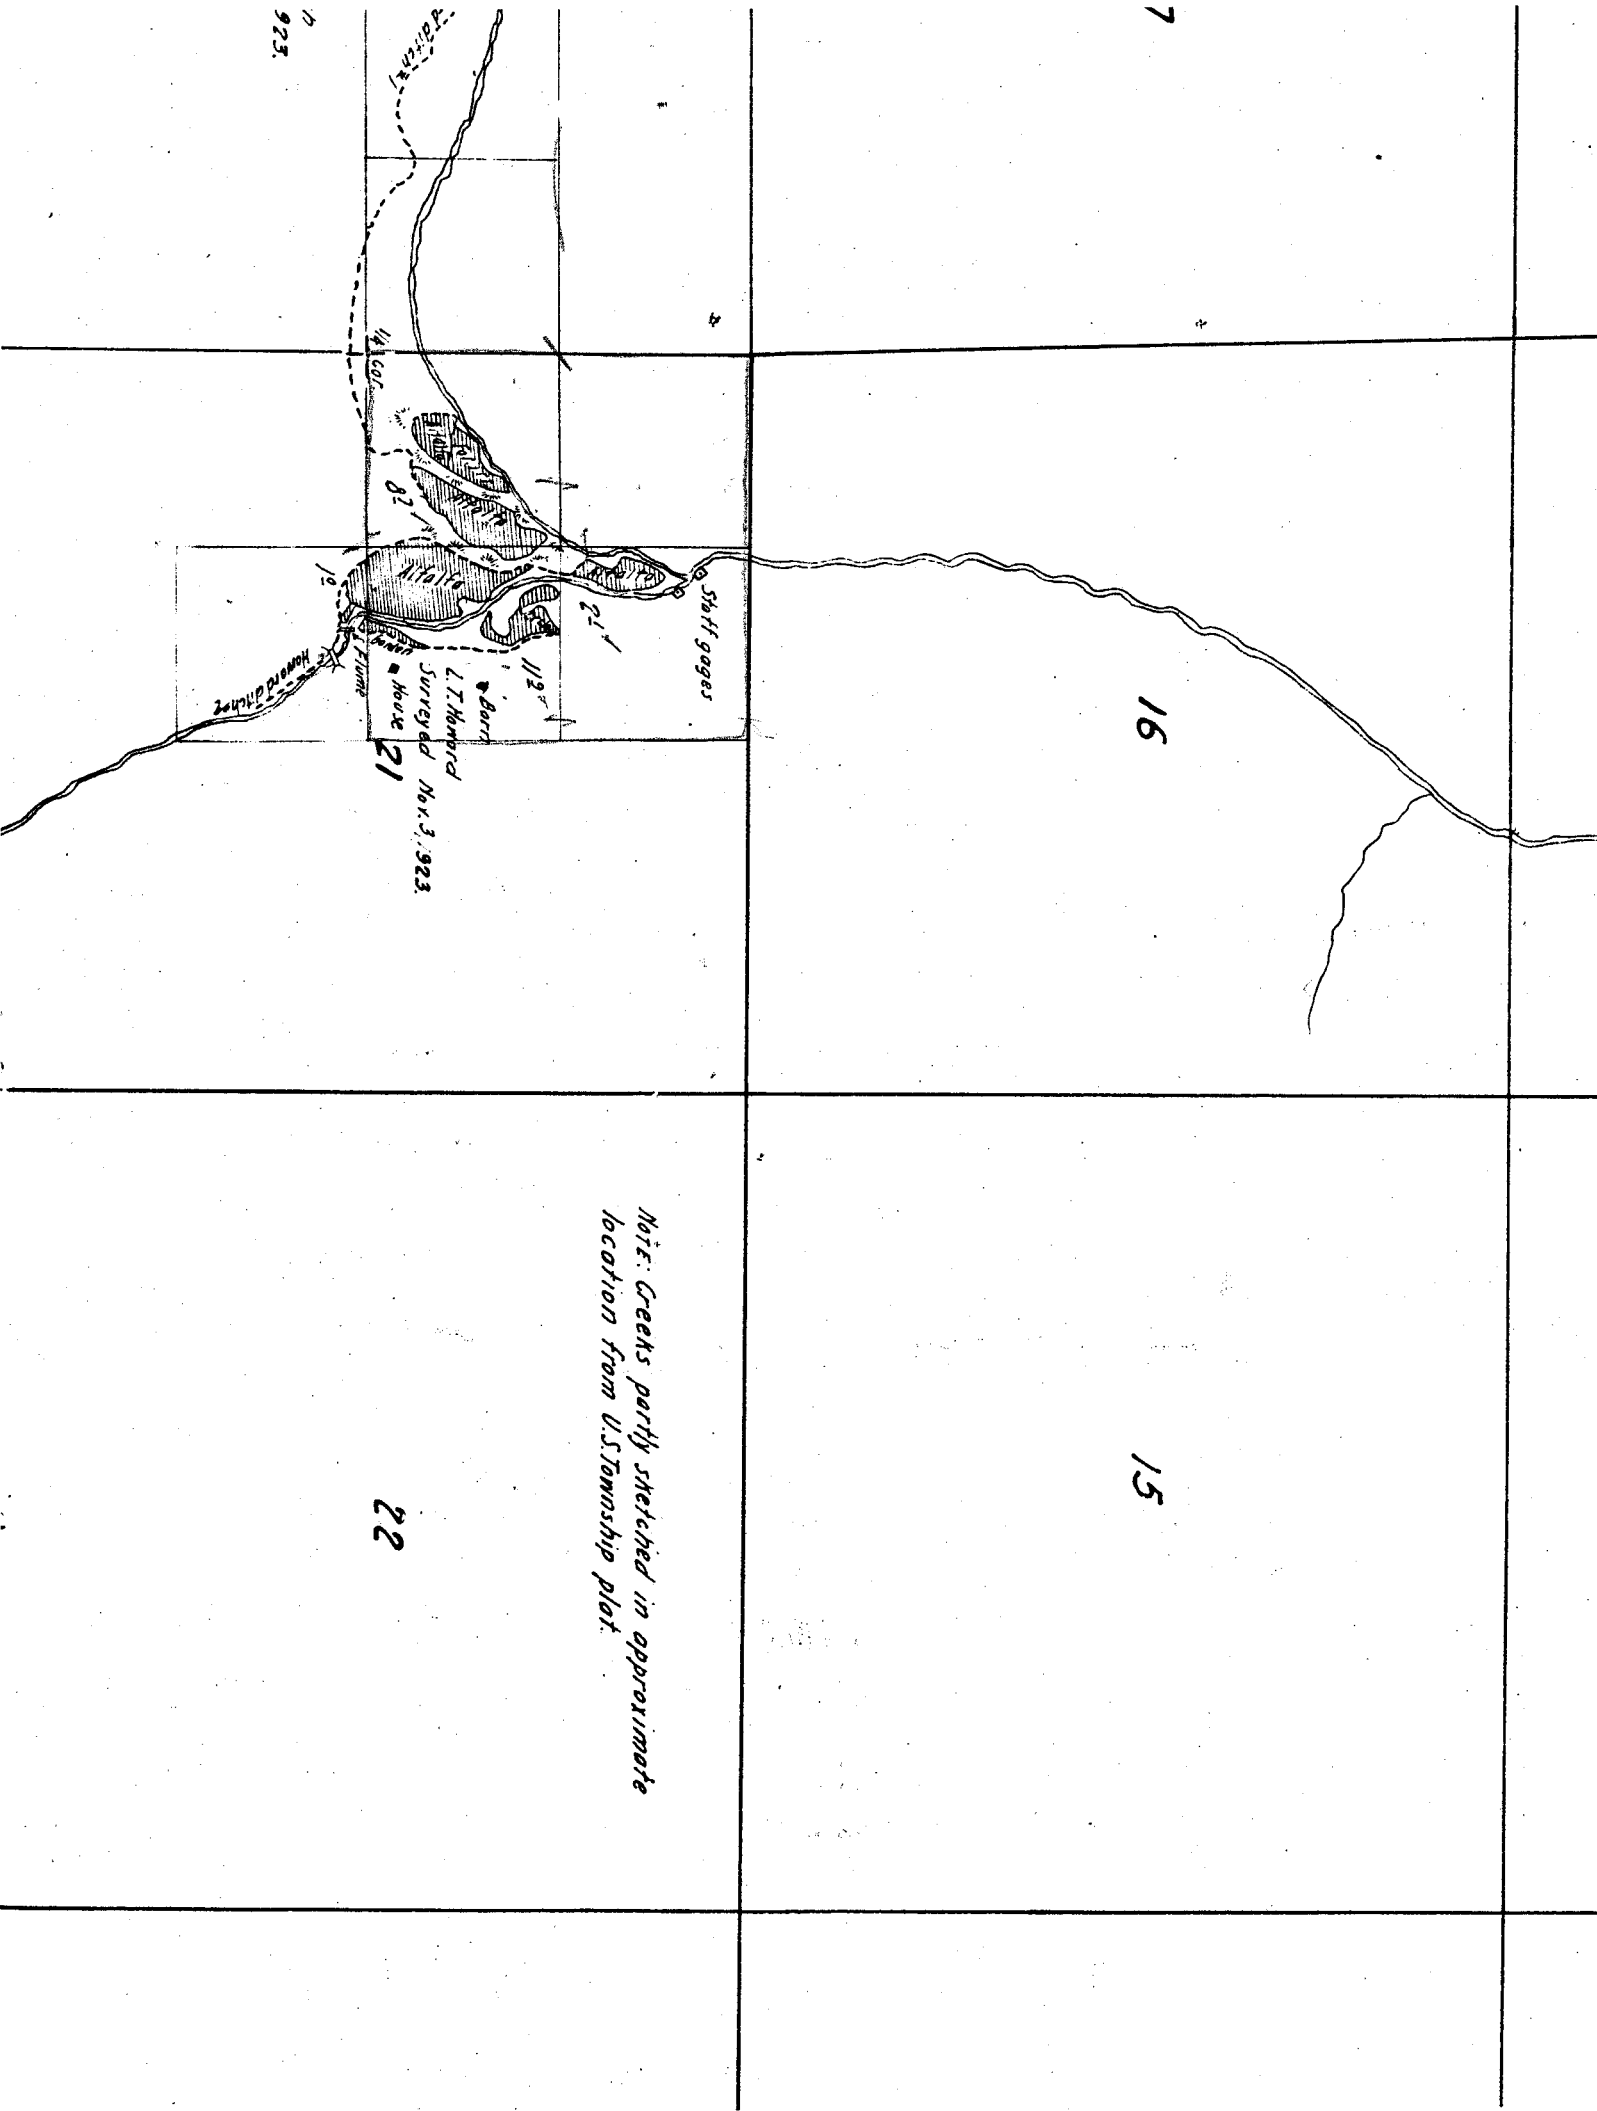

Note: Creeks partly sketched in approximate location from U.S. Township plot.

Township 11 S. Range 21 E.

V. Ranch
Oct 8, 9, 1923
5

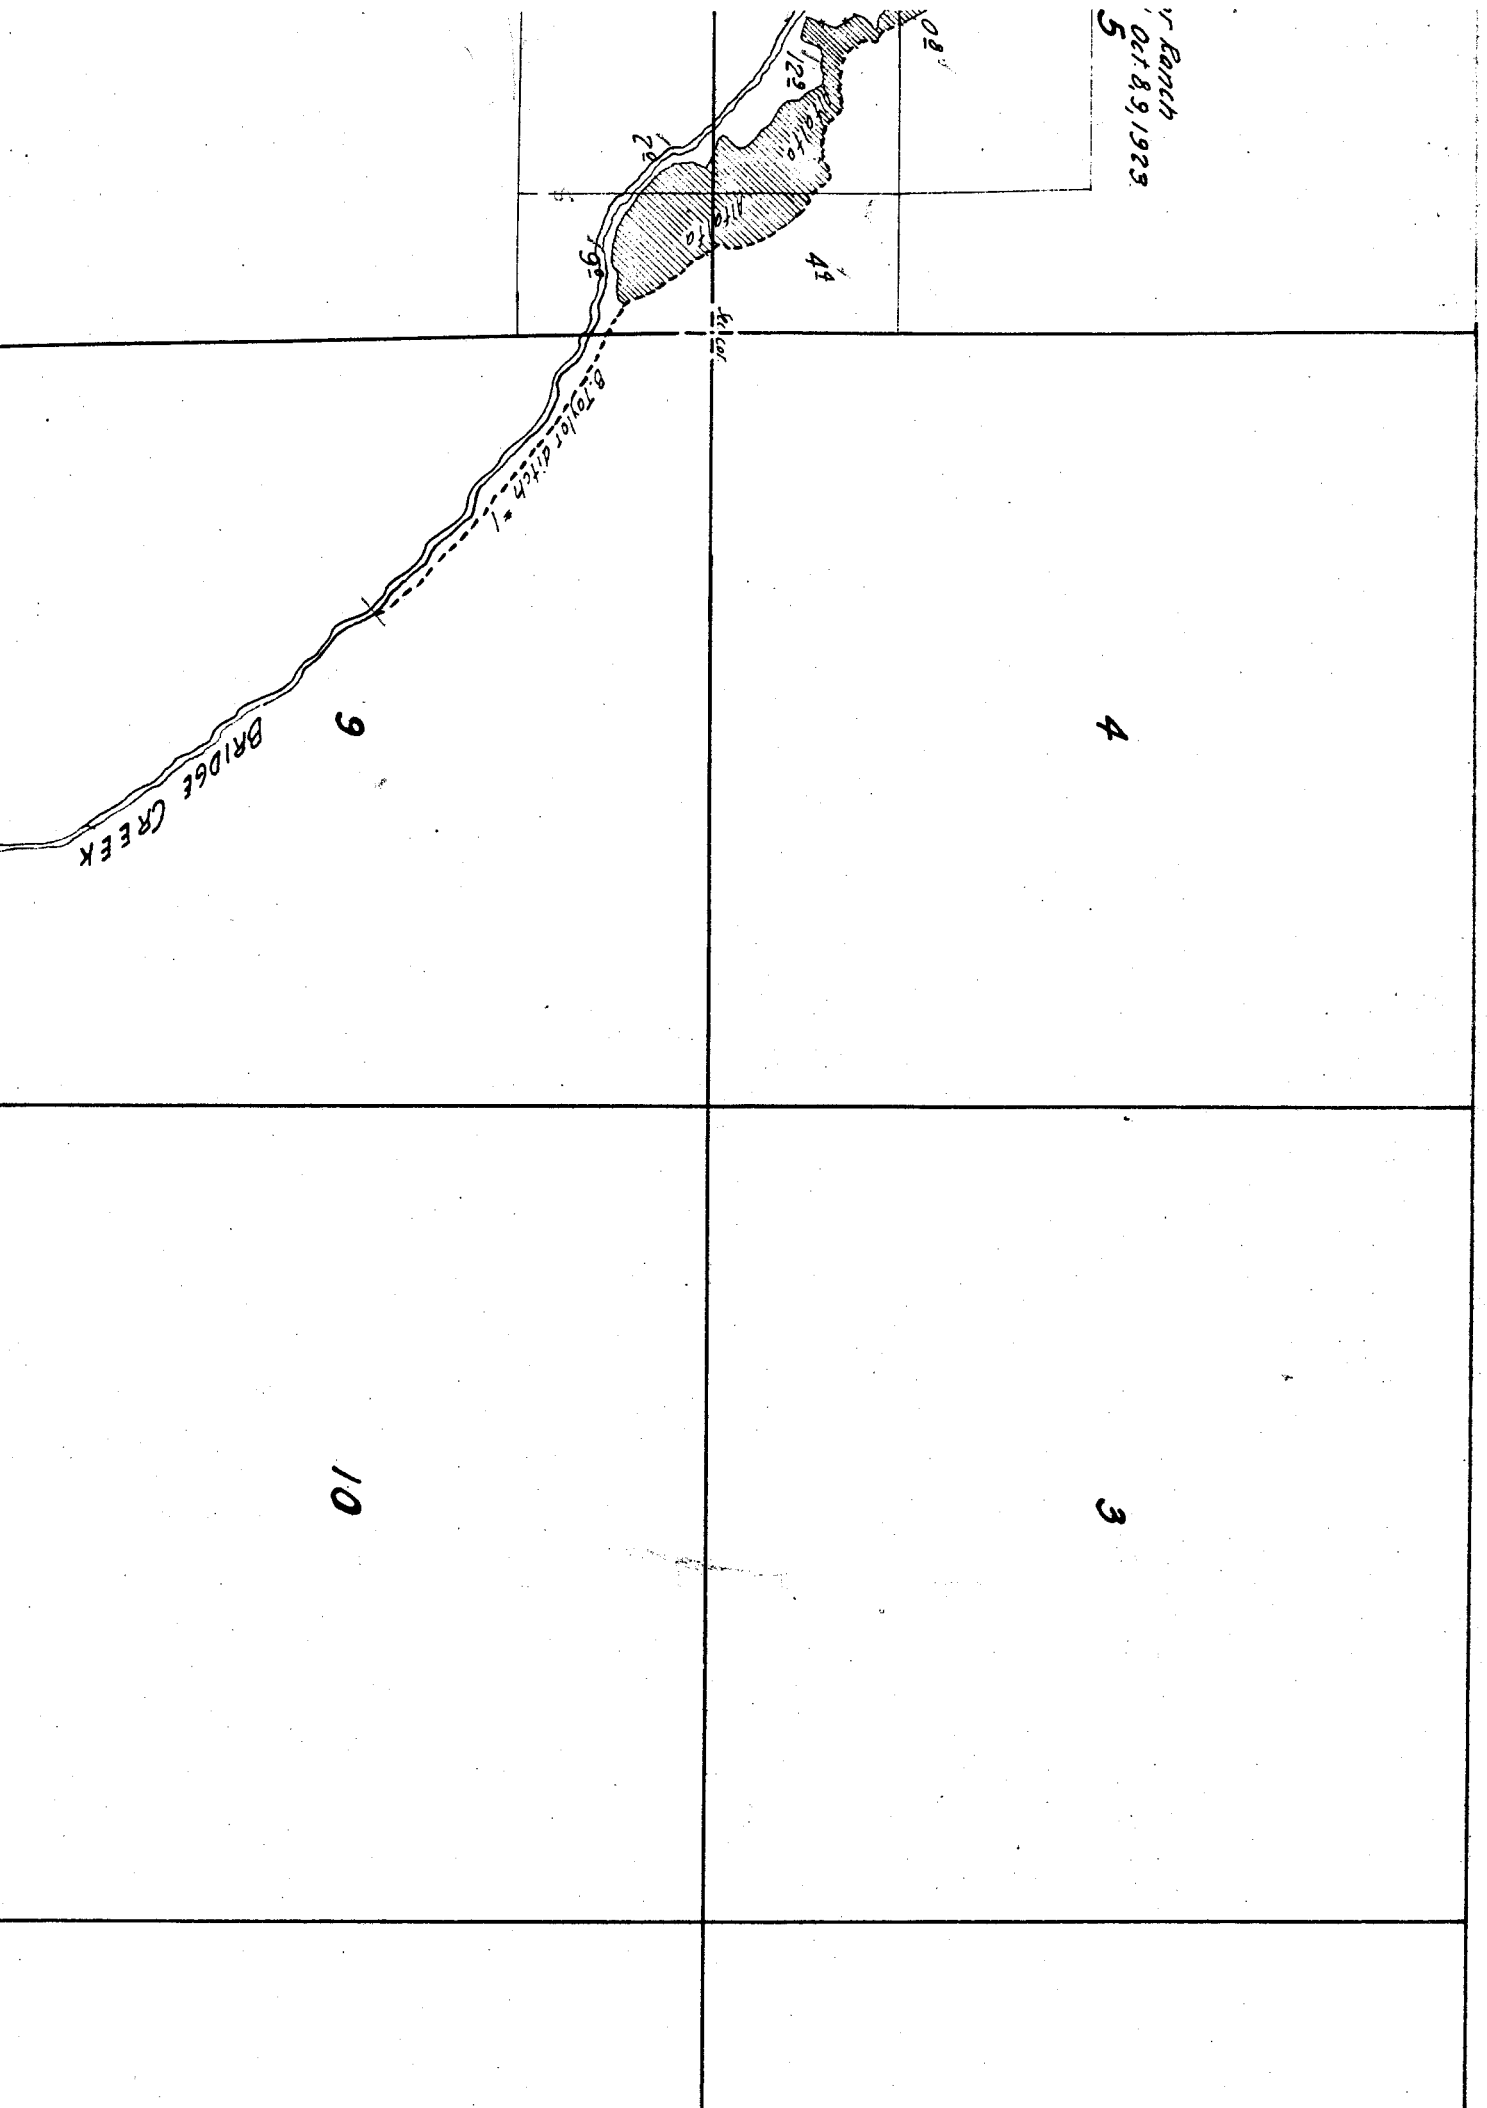

E.

6-1-1

2

1


11

12





14

13

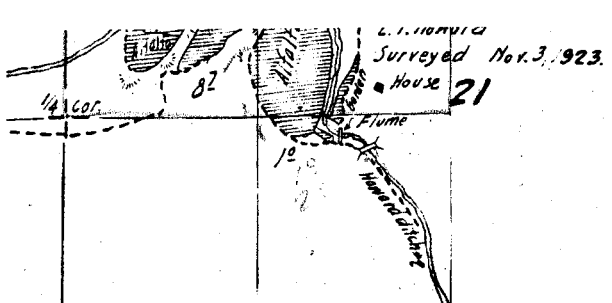

22

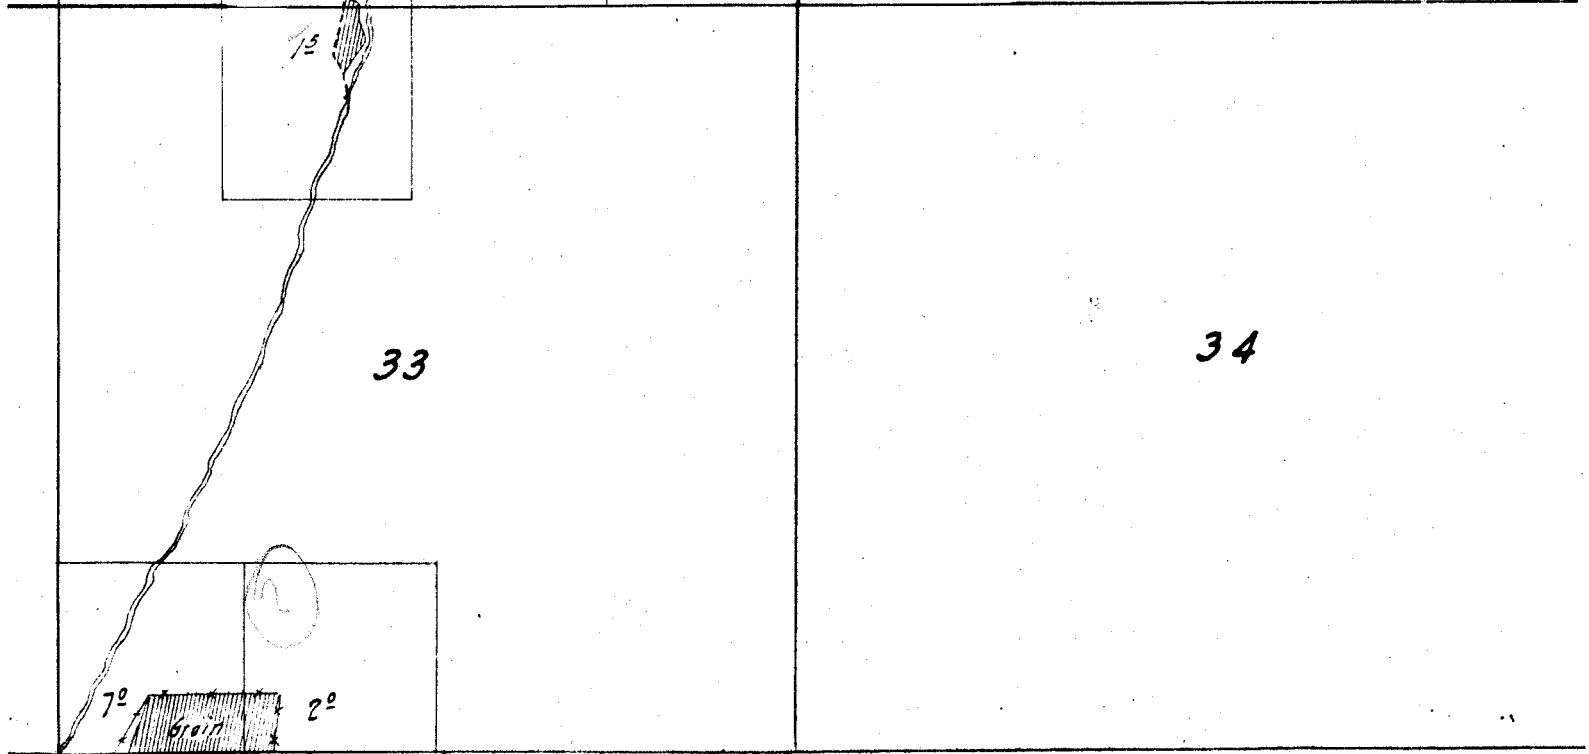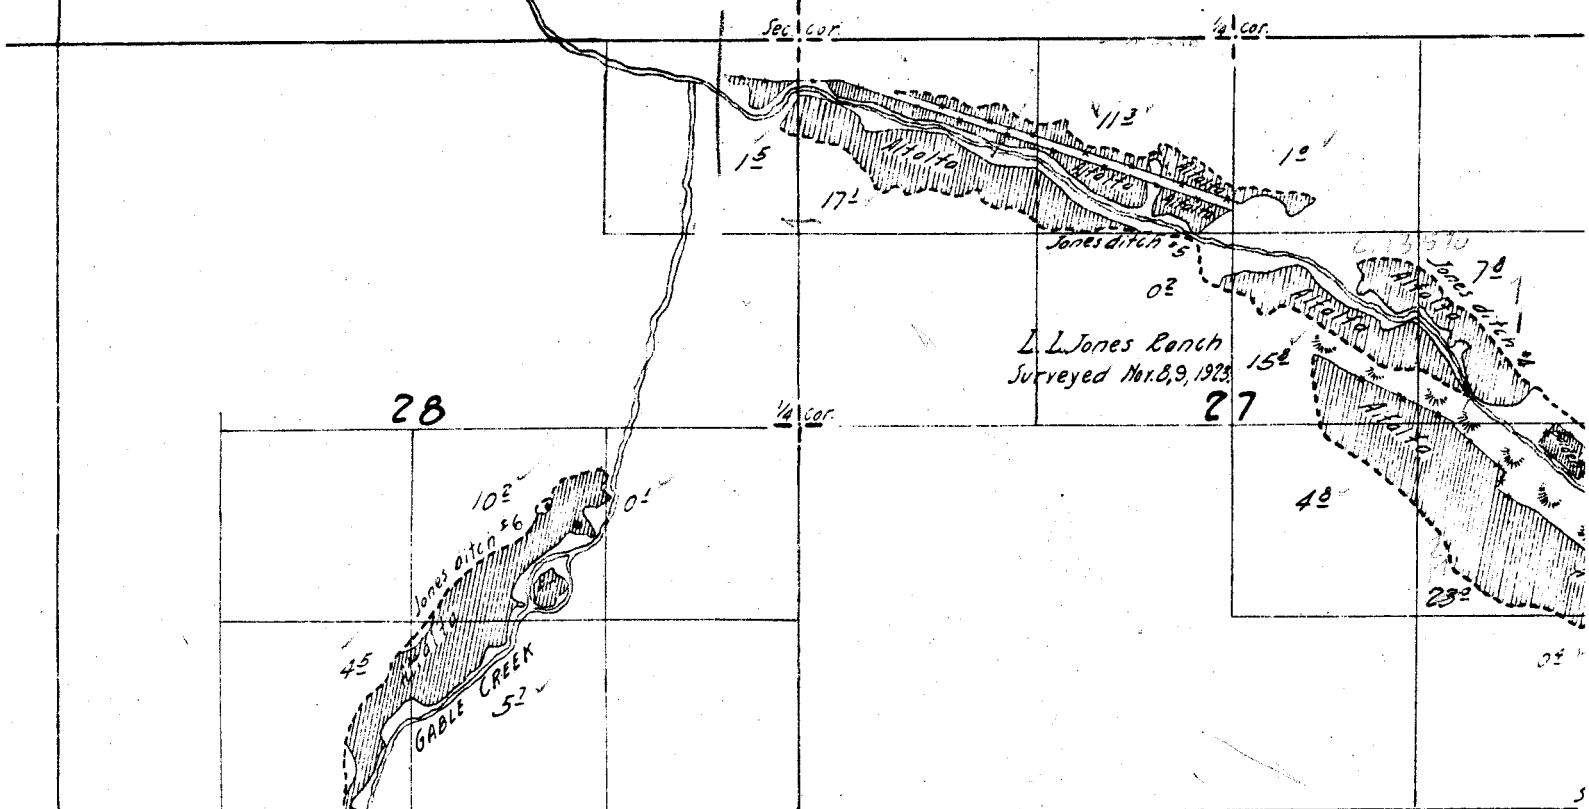

1/4 Sec

Sec
1600

6

Ben Taylor Ranch
Surreyed Oct. 8, 9, 1929

5

7

8

18

17

52

32

96

22

42

2021

02

05

122

42

20

92

