

28


33

29

32

30

31

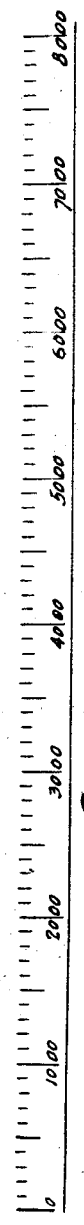

Scale of feet.


195
301
CREEK
GRABLE CREEK
45
51

7°
2°

16

17

18

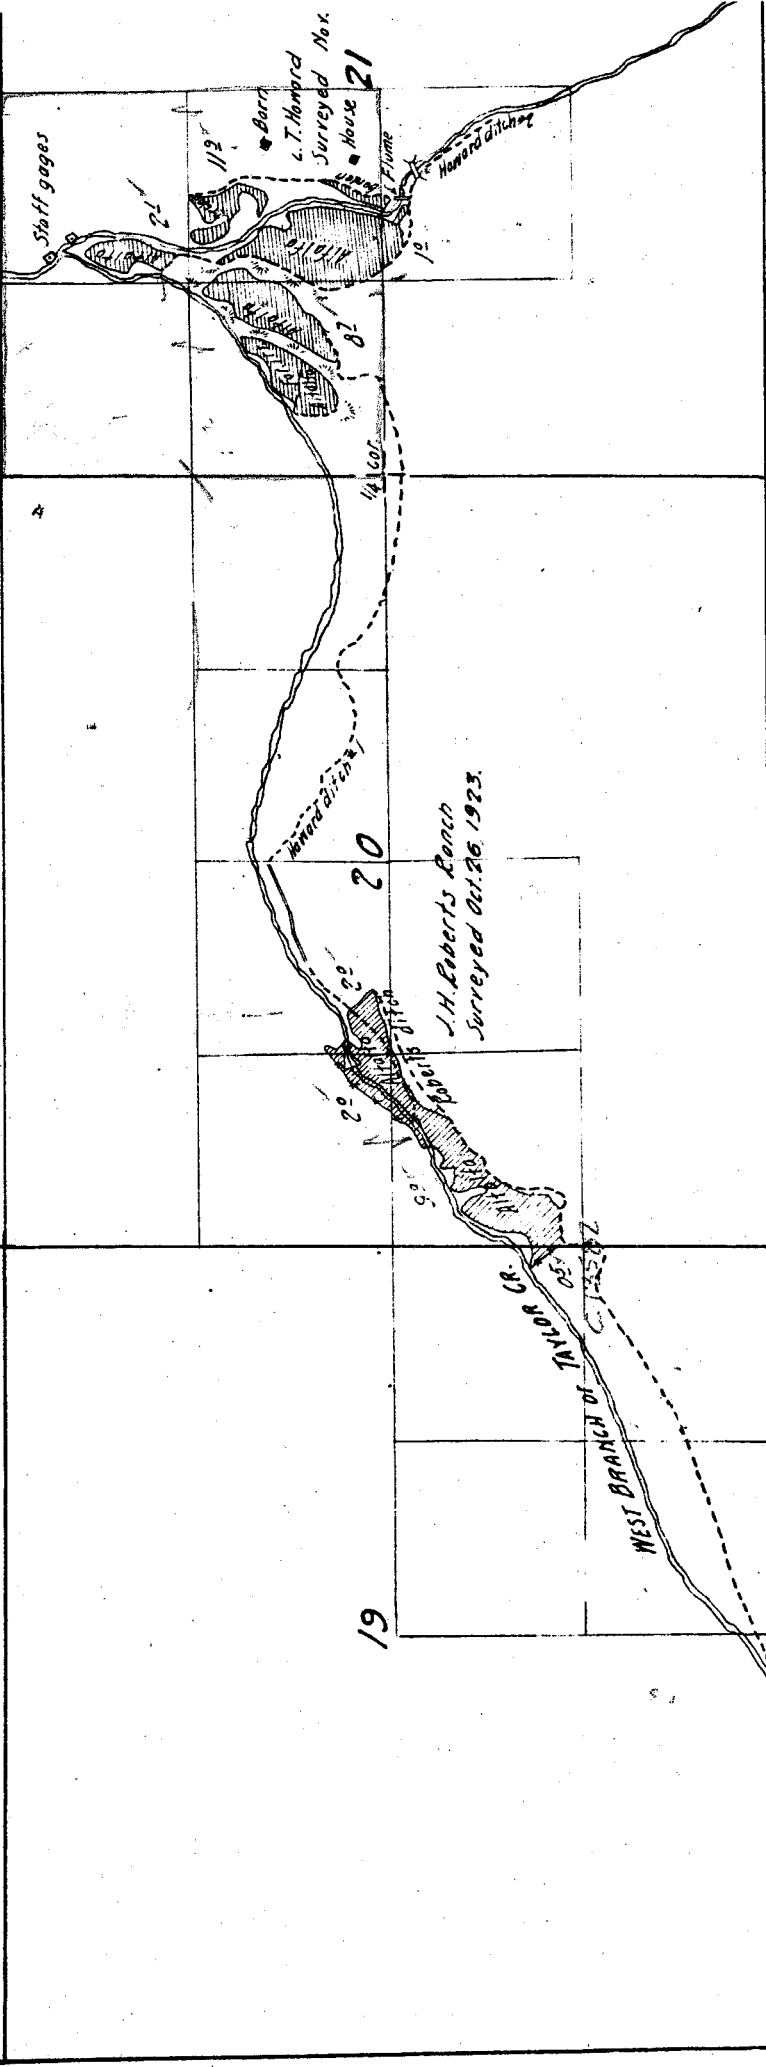

Surveyed Nov. 3, 1923.
House 21
Flume
10
17
1/4 cor.

22

Sec. cor. 1/4 cor.
15
17
113
15
Jones ditch
02
L. L. Jones Ranch
Surveyed Nov. 8, 9, 1923.
15
27
48
79
23
02

28
10
Jones ditch
45
102
56
05
GABLE CREEK
52
15

33

34

7
6
2

E.

6-1-1

2

1

11

12

14

13


1/4 Cor.

Sec
60r.

6

7

18

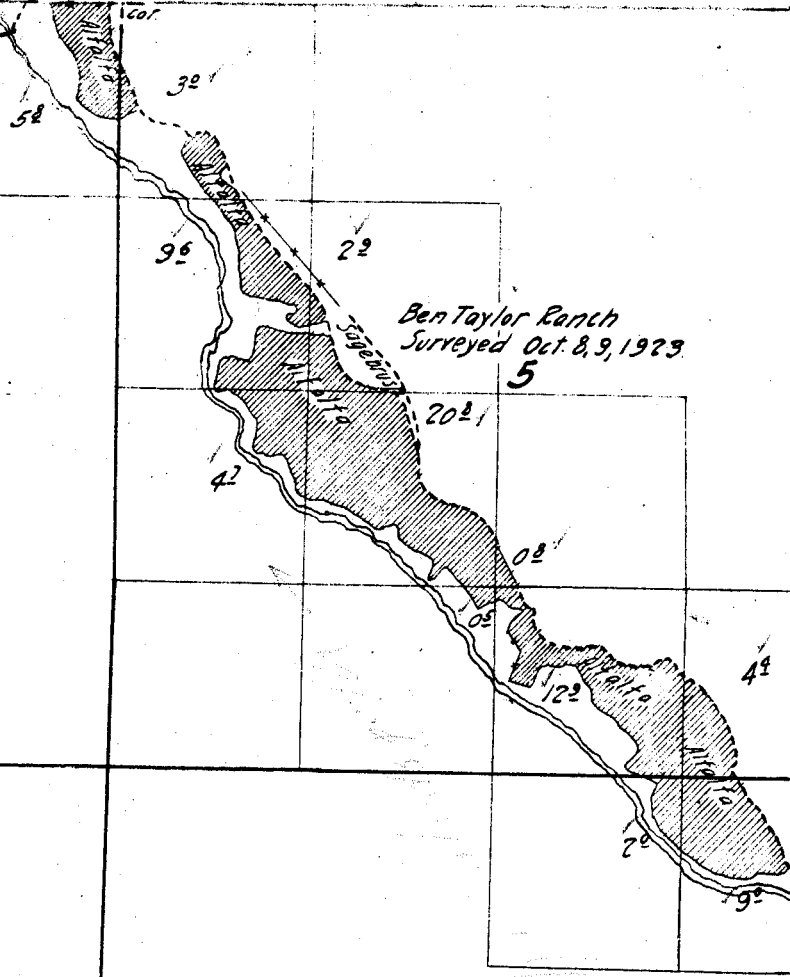

8

17

113'
Jones Ranch
Sd. Midg, 1923

27


26

25

34

35

36

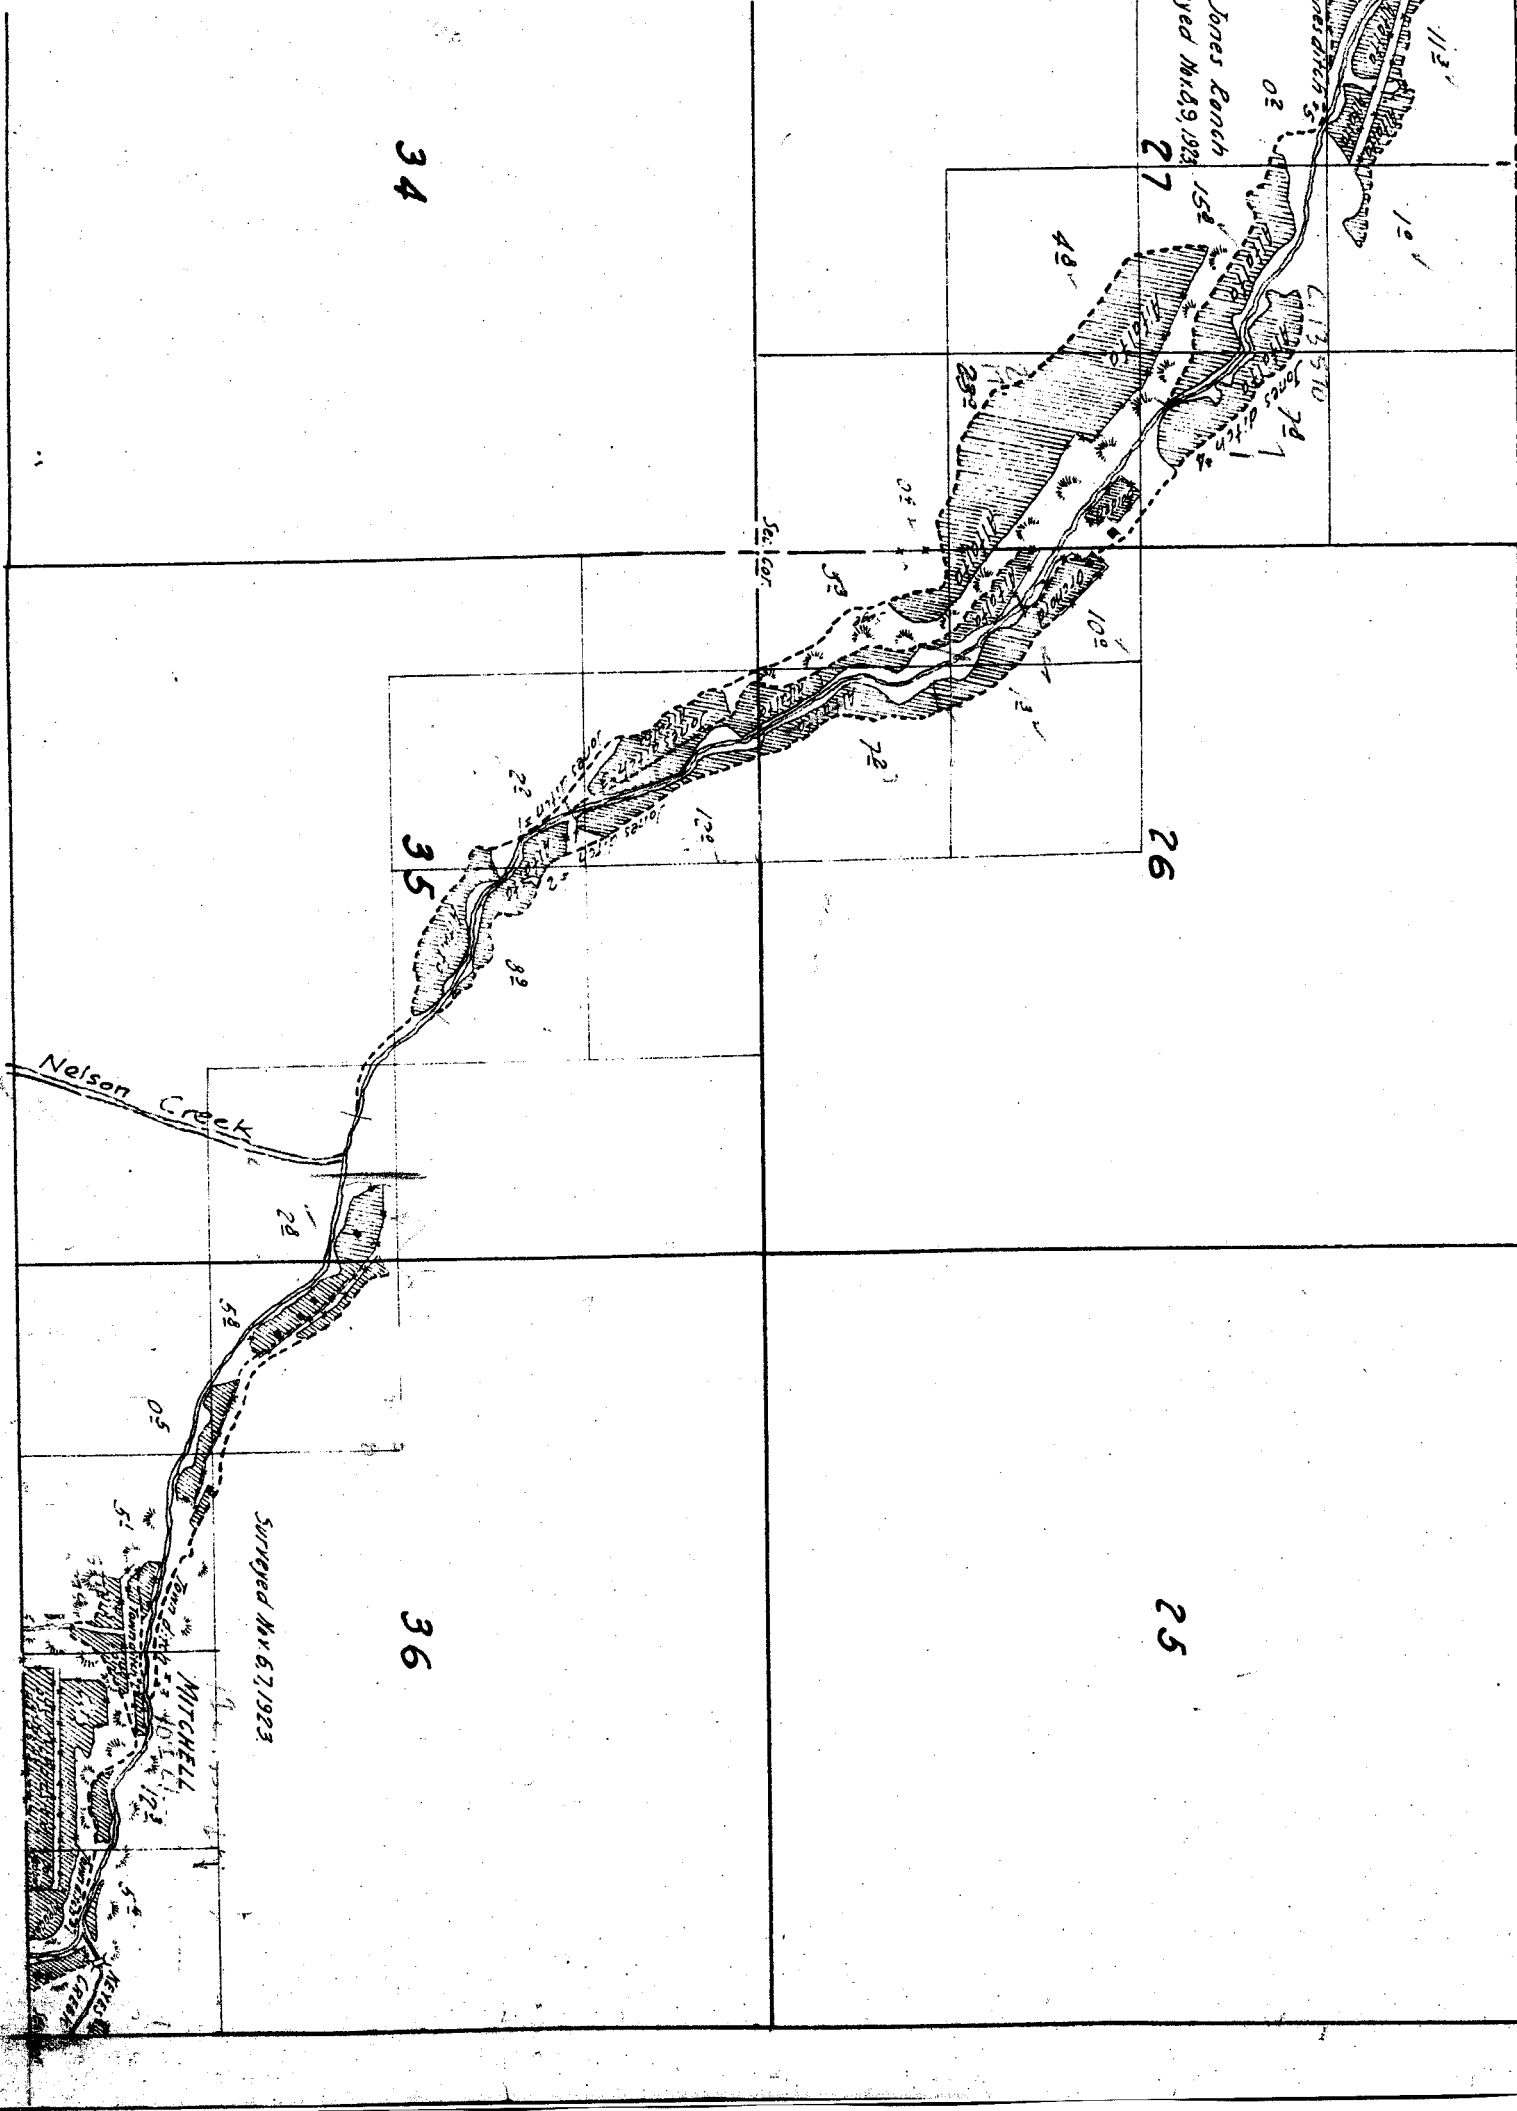

15

14

13


*is partly sketched in approximate
form U.S. Township plat.*

22

23

24

1/2 Sec.

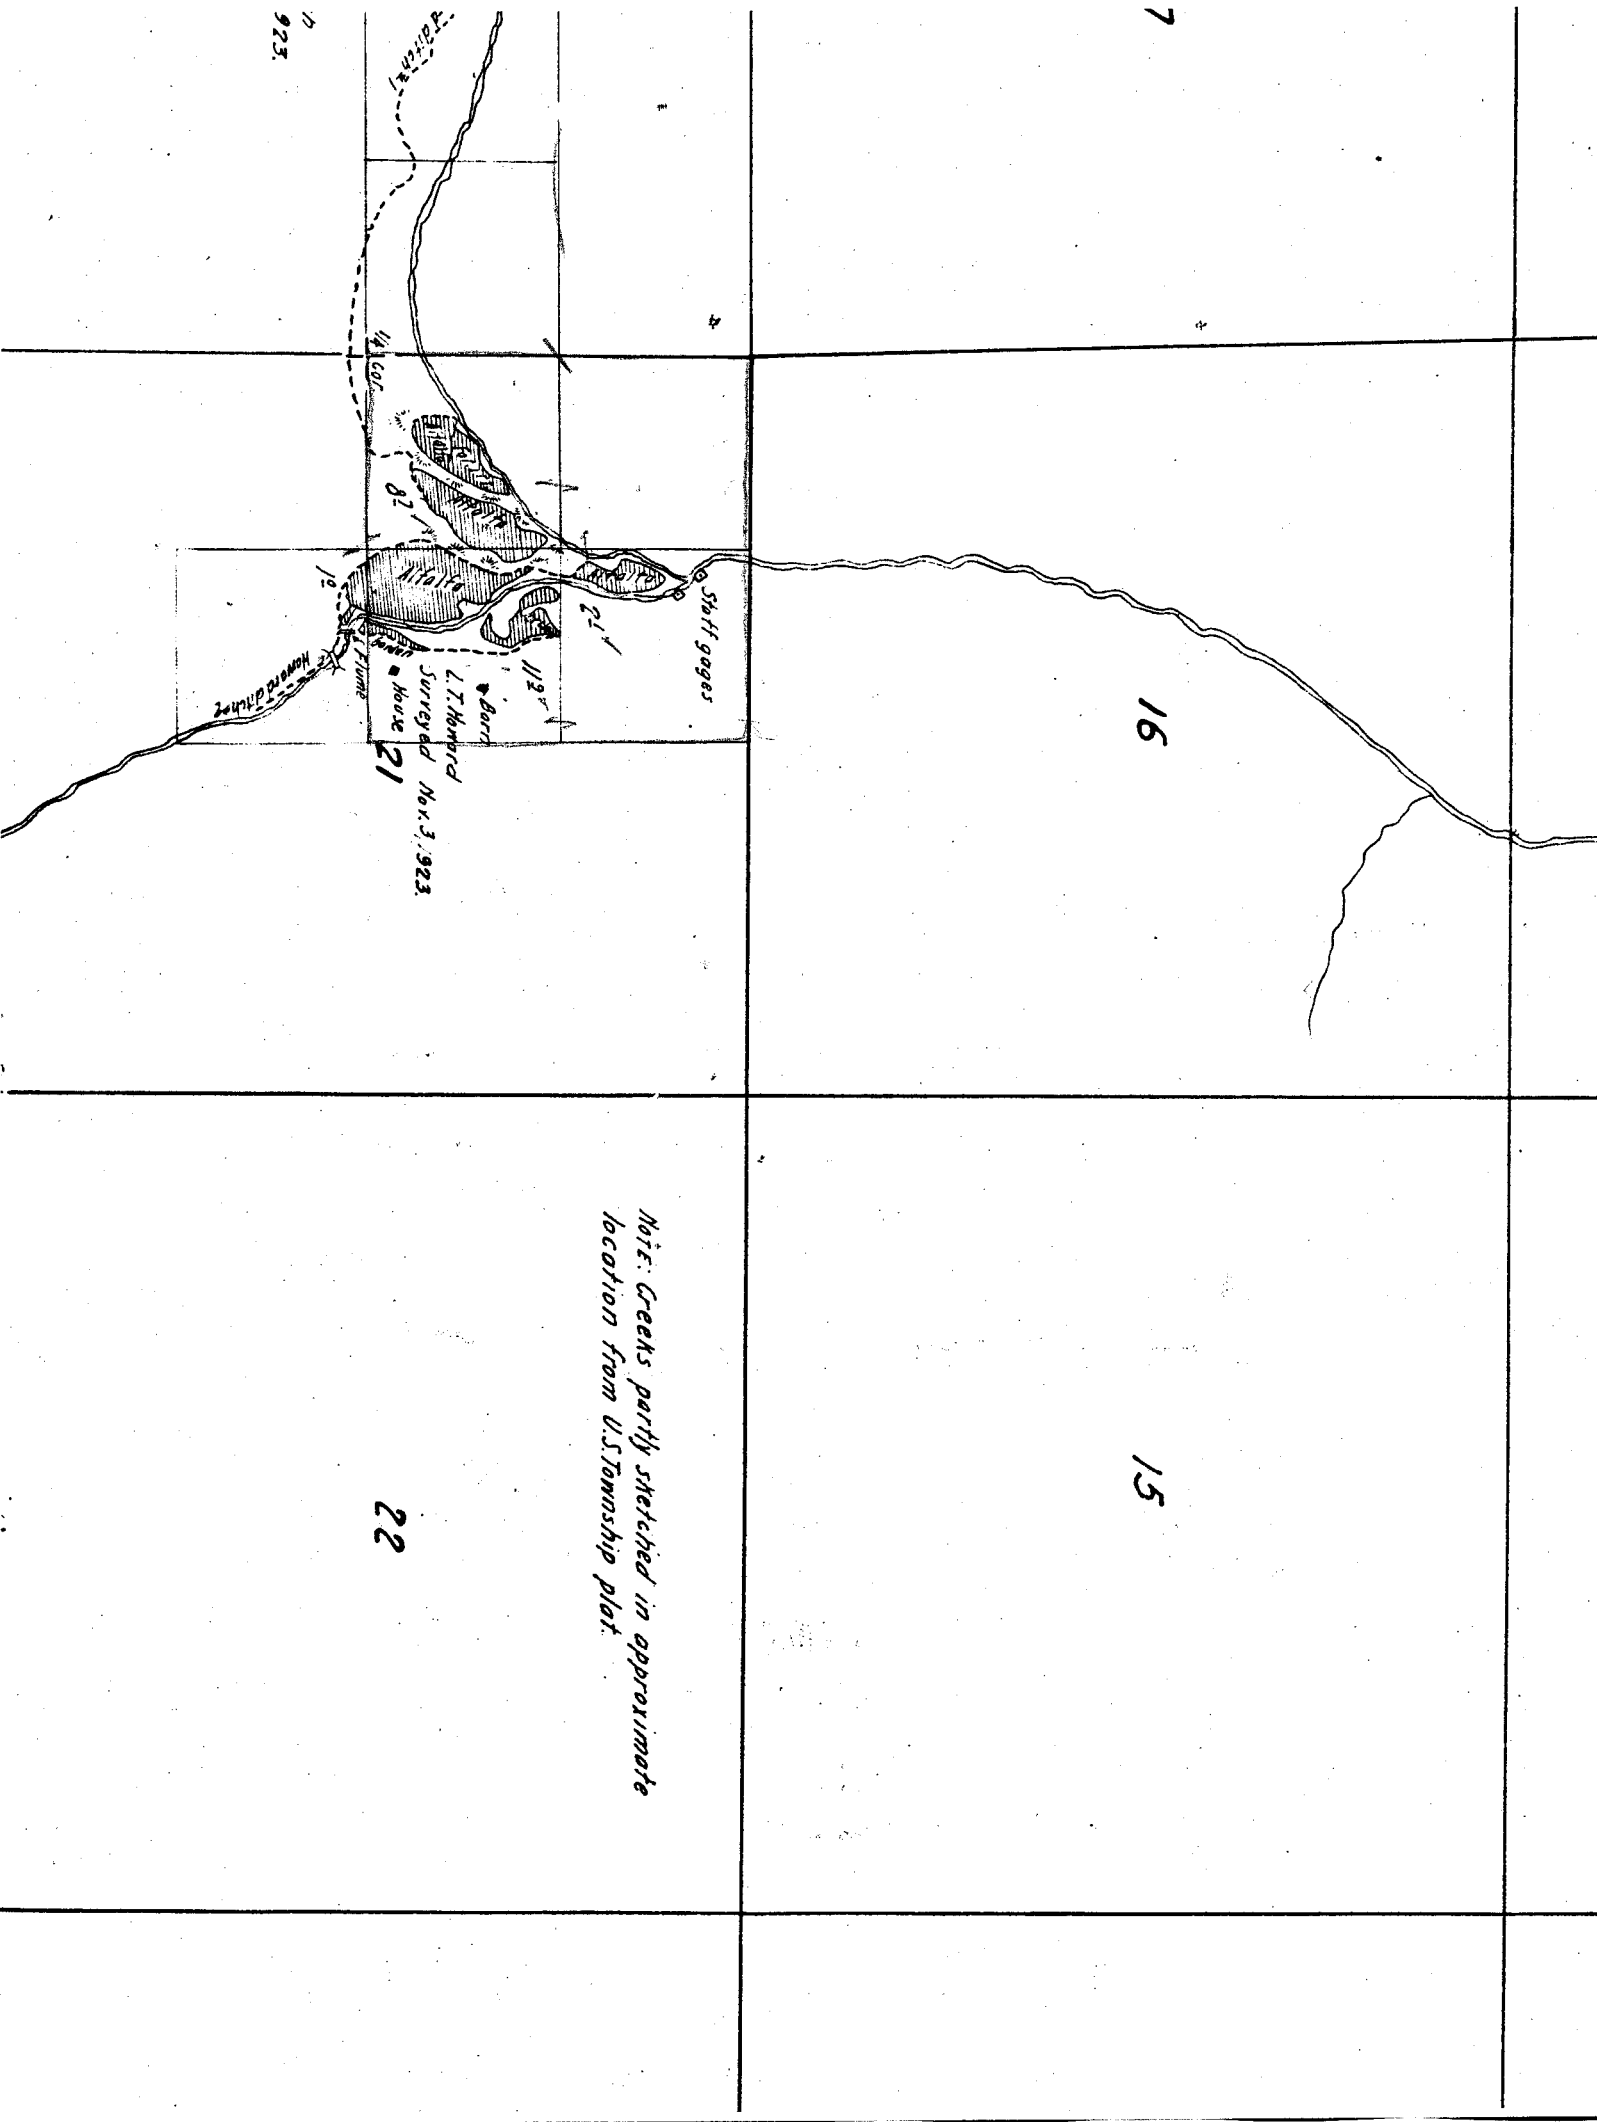

Note: Creeks partly sketched in approximate location from U.S. Township plat.

923

7

16

15

22

Steff gages

L. Howard
Surveyed Nov. 3, 1923
Barrs house


1/4 cor.

119'

82'

21'

12'

1/2

1/2

Township 11 S., Range 21 E.

5

