

16


12

17

65

18

61

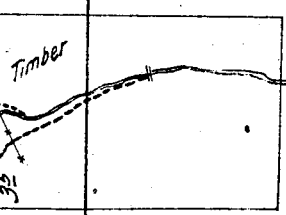

HEFLIN CREEK

Township

6

5

4

1.





9


R.D. Lannon E.

8


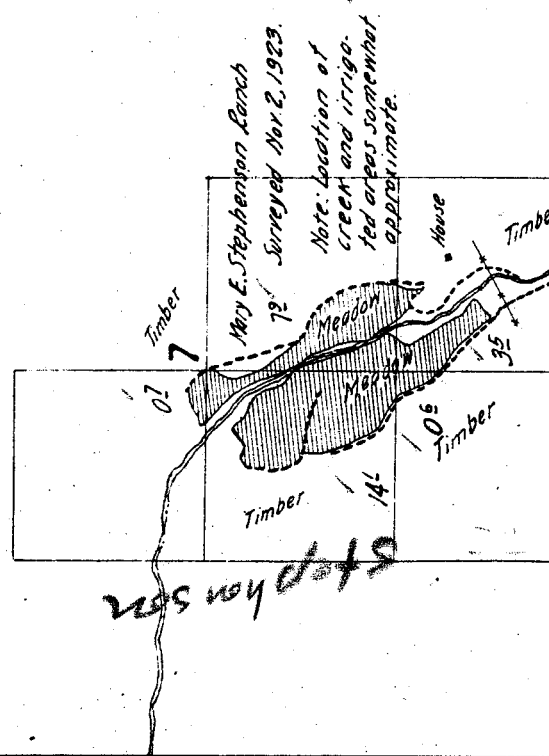


ge' 20 E.

9-1-1

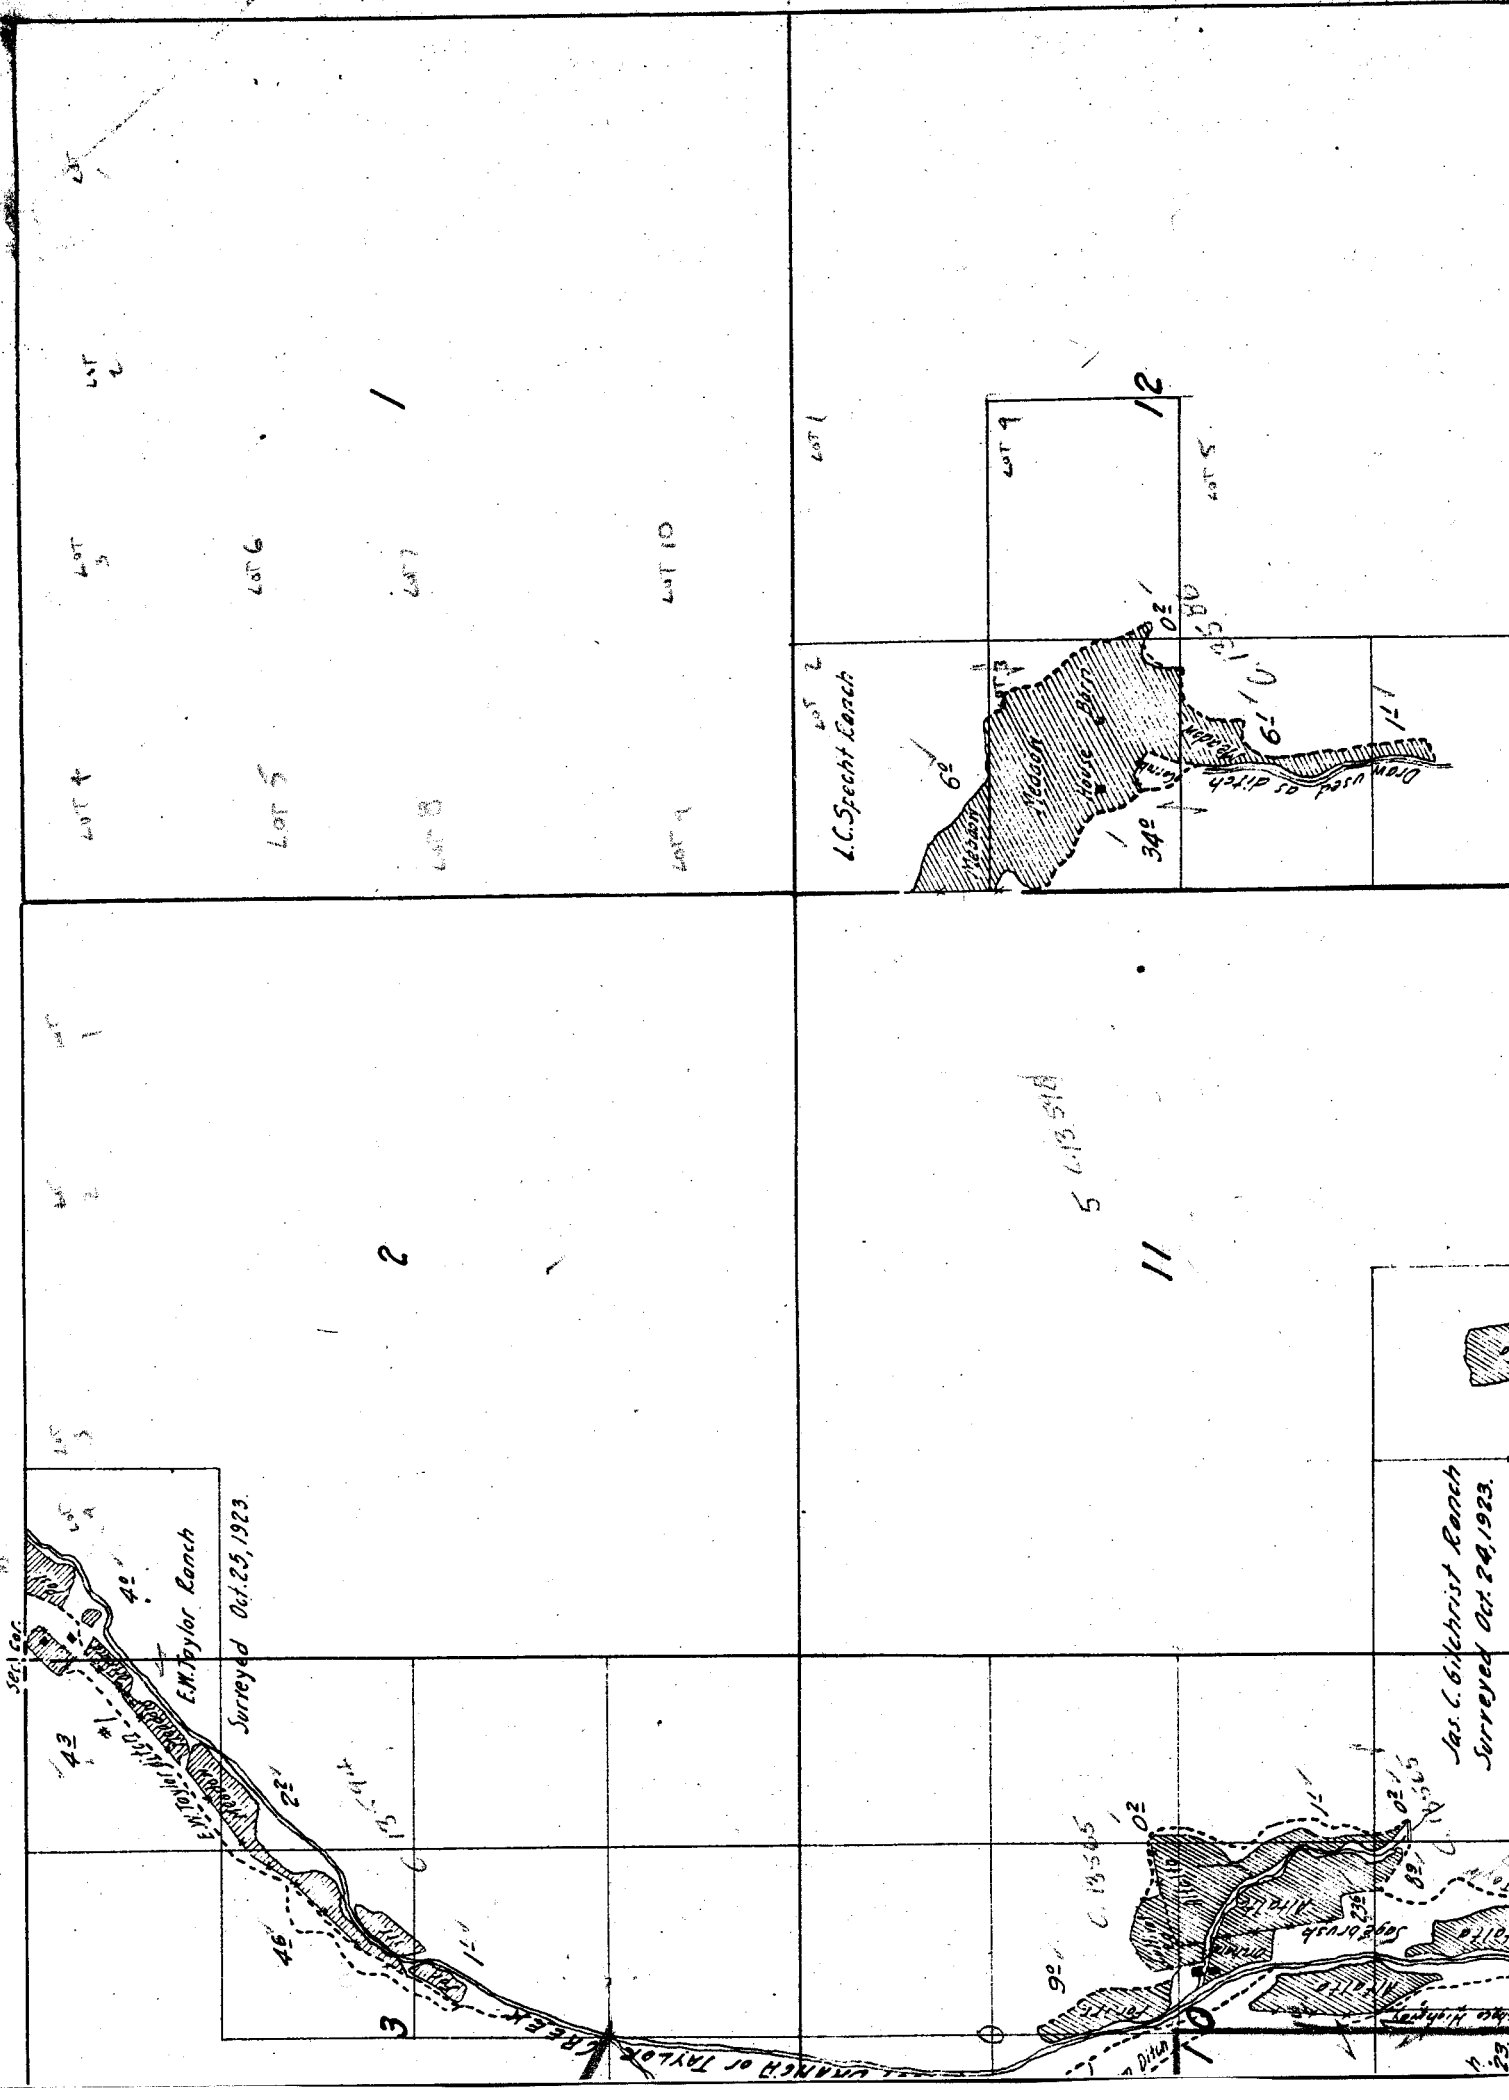

Surveyed Oct 24, 1923.

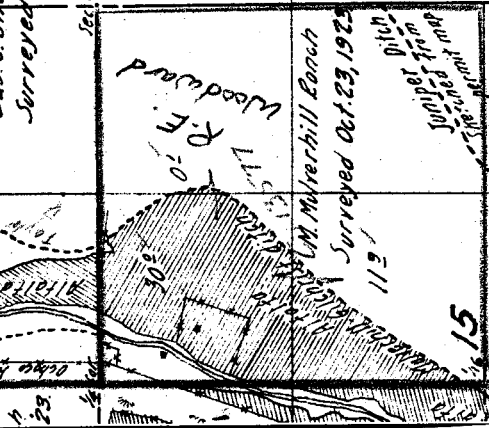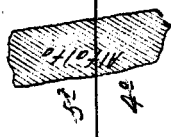

Surveyed Oct 23, 1923

112'

15

14

Surveyed Oct 27, 1923

13

J.M. Dove Ranch

Two-way division box

Specht ditch

Two-way division box

Specht ditch

Note: Byrne-Dove-Specht Ditch heads in spring at head of Thompson Creek.

THOMPSON CREEK

24

23

G.G. Lewis Ranch
Surveyed Oct 24, 1923.

112'

132'

15

14

13

12

11

10

Rail Creek

USA
28

33

Boyer longer
Station
Surveyed, 1812.

John Boyd Ranch
163
321
68
Muddy 1900 by
Fulton ditto 1900
Muddy

WEST BRANCH OF TN


27

Slide Creek


34



16

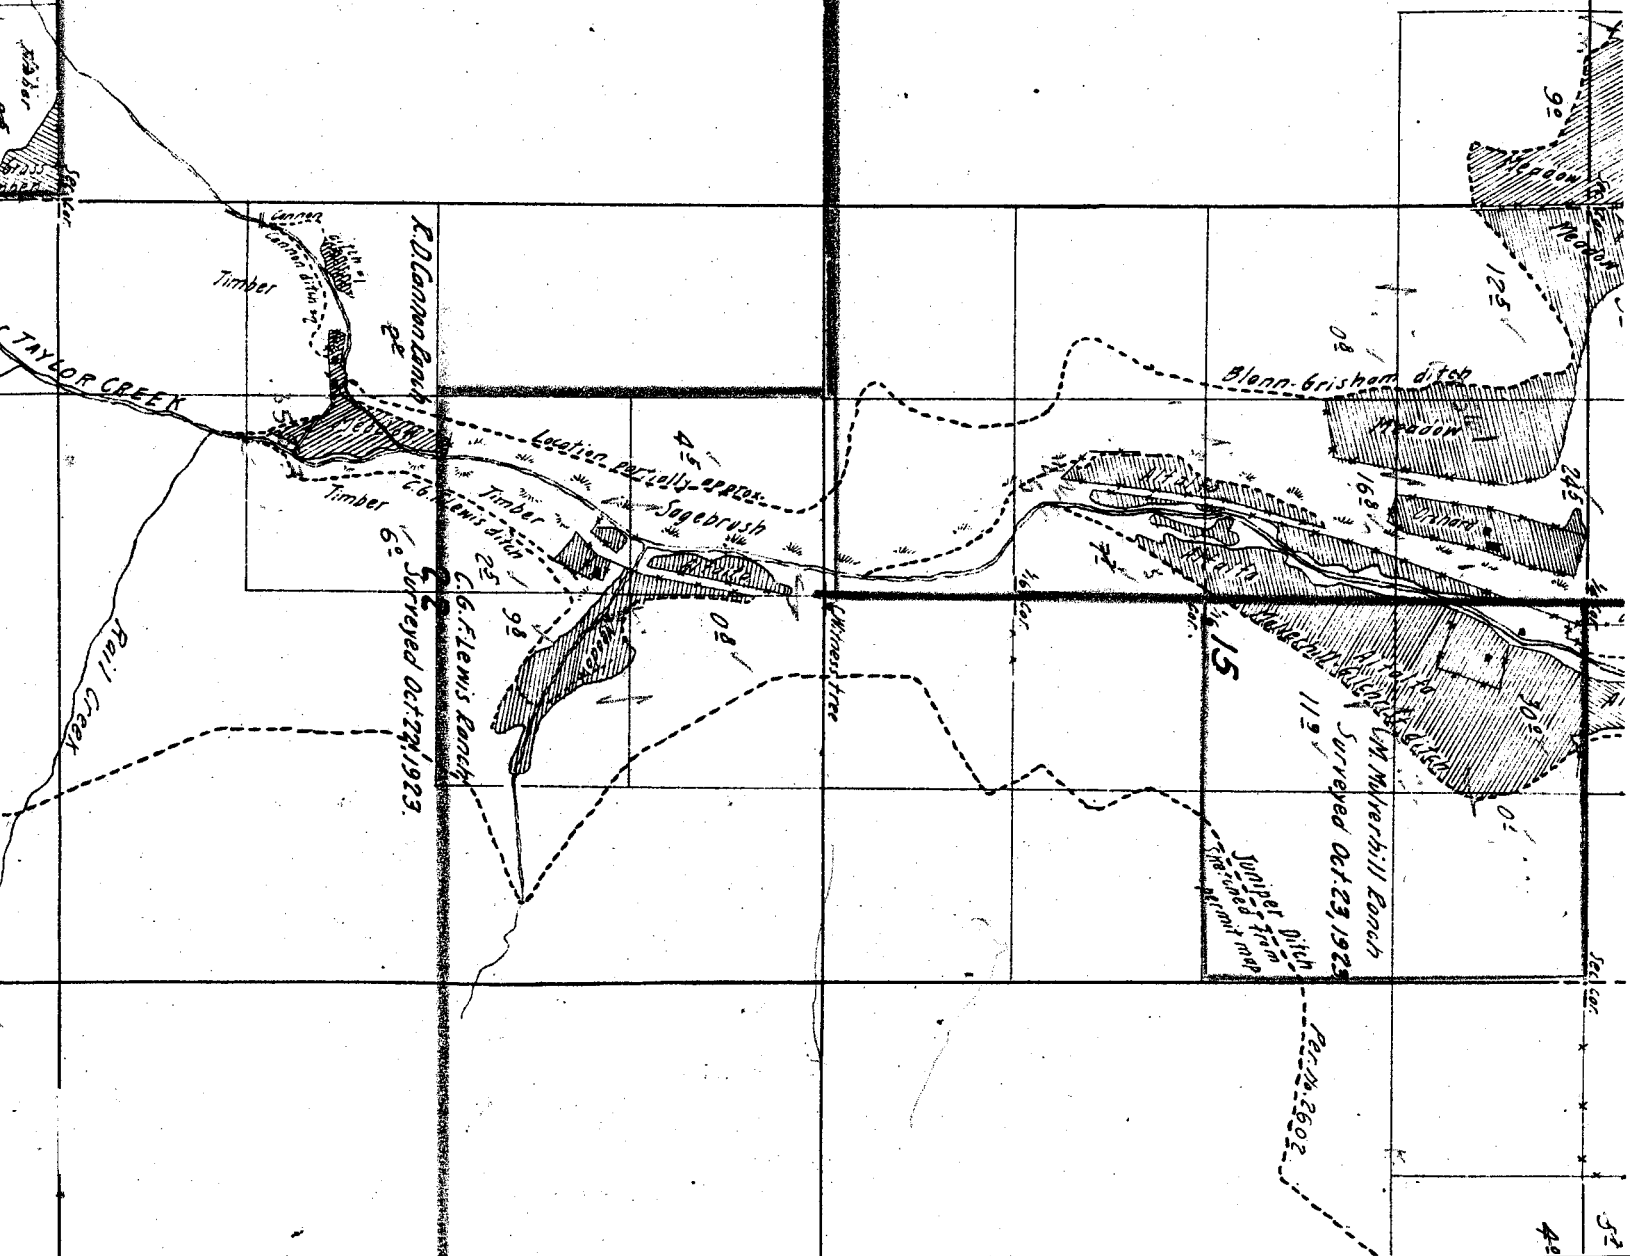

12

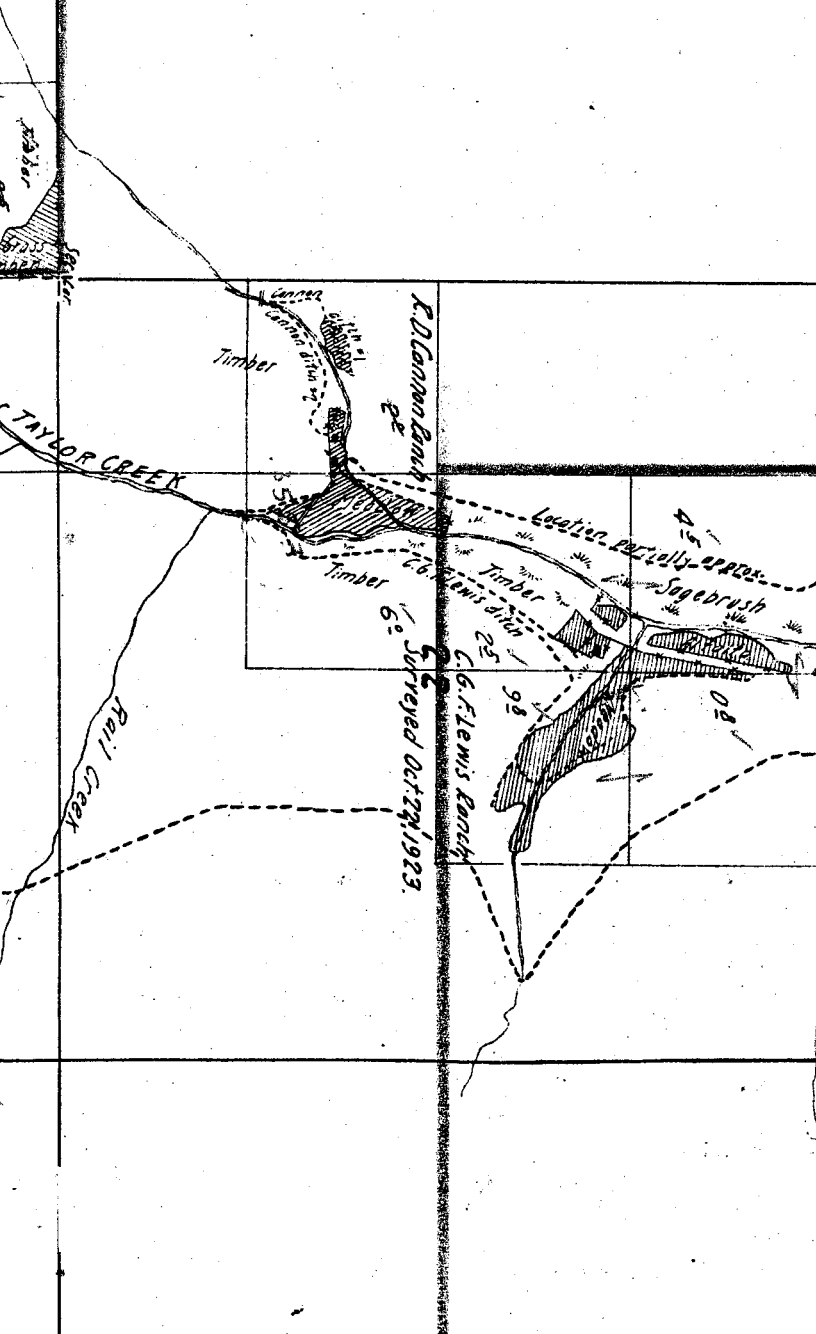

32

31


29

30

20

19

Scale of Feet.

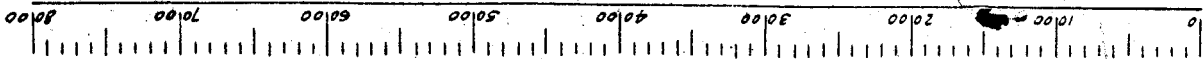

35

36

Note: - Greens sketched in approximate
location from U.S. township plat, U.S. forest
service map, and permit maps, except in
vicinity of irrigated areas.

26

25

23

24

THOMPSON

ownship

12 S.

Range

20 E.

16

9

4

