

19

20


Leach Creek

30

29

31

32

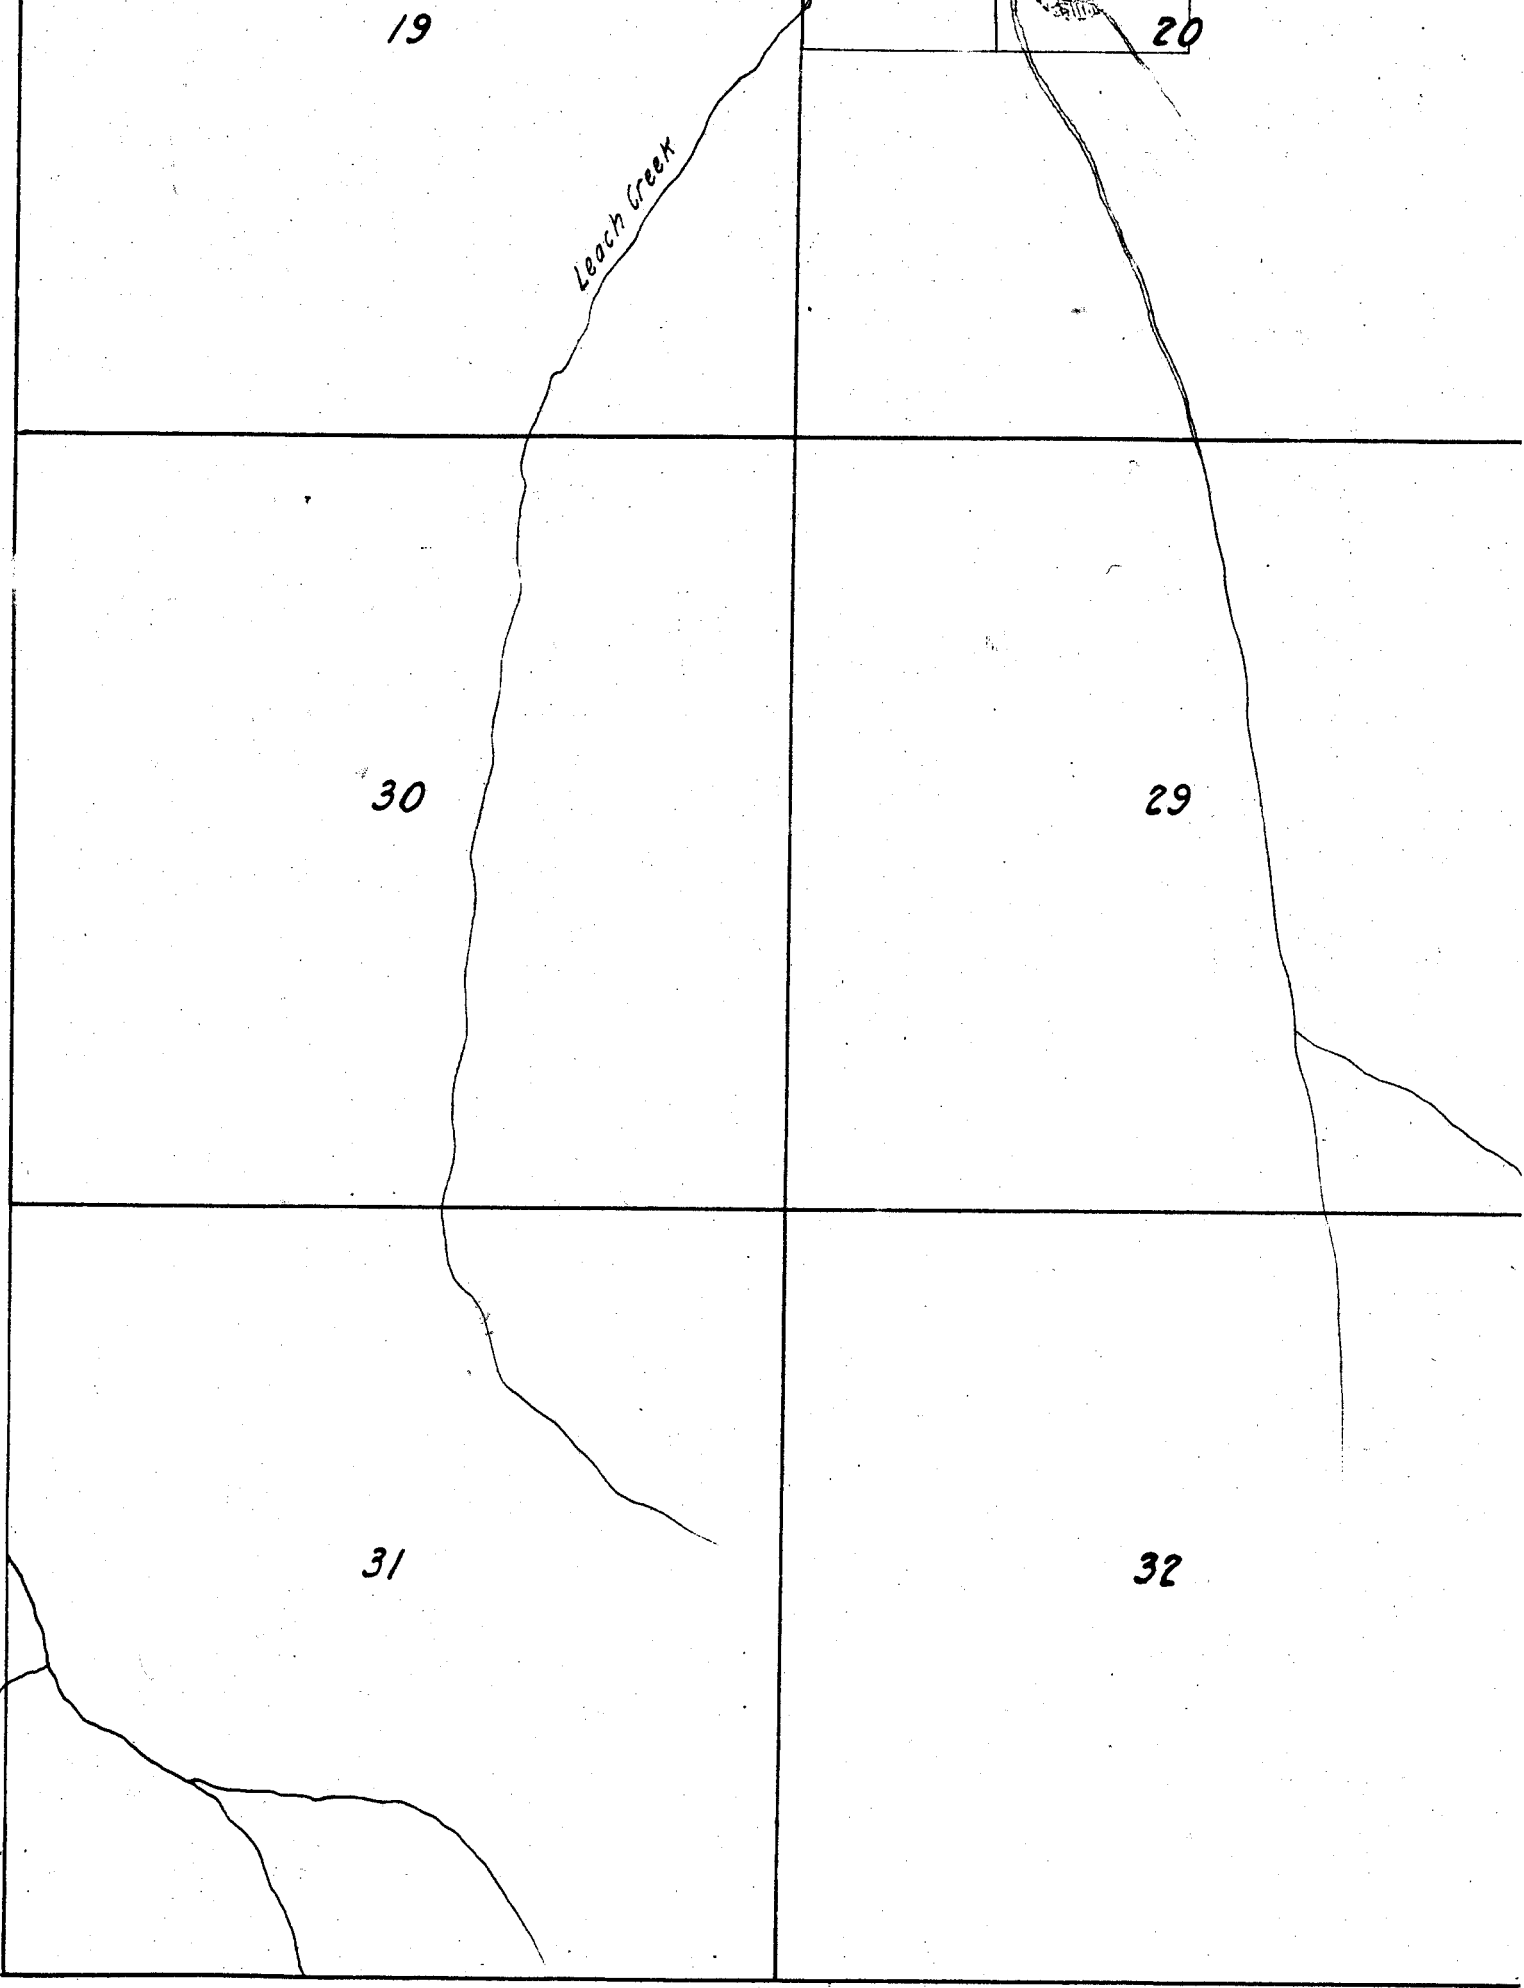

23

24

26

25

MILL CREEK

35

36

Note: - Creeks sketched in approximate location from U.S. Township plats or from Forest Service map except in vicinity of irrigated areas. Permit ditches plotted in approximate location from permit maps except in vicinity of irrigated areas.



Scale of Feet.

G.M. Nelson Reservoir
No. 462


28

27

33

34

Maxwell Creek

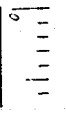


12324.

16

21

22

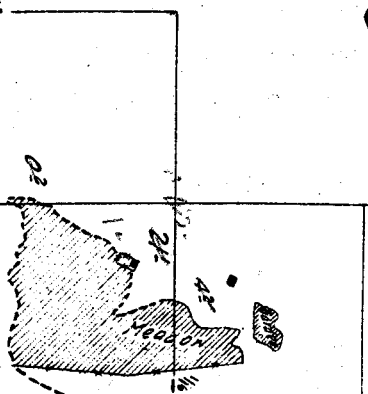

Nelson and Campbell
 ranch

G.M. Nelson ditch
 Per. # 4223

Cole Bros.


Survey of Oct. 18

Meadow

92


155

Maxwell Ditch Per. # 209

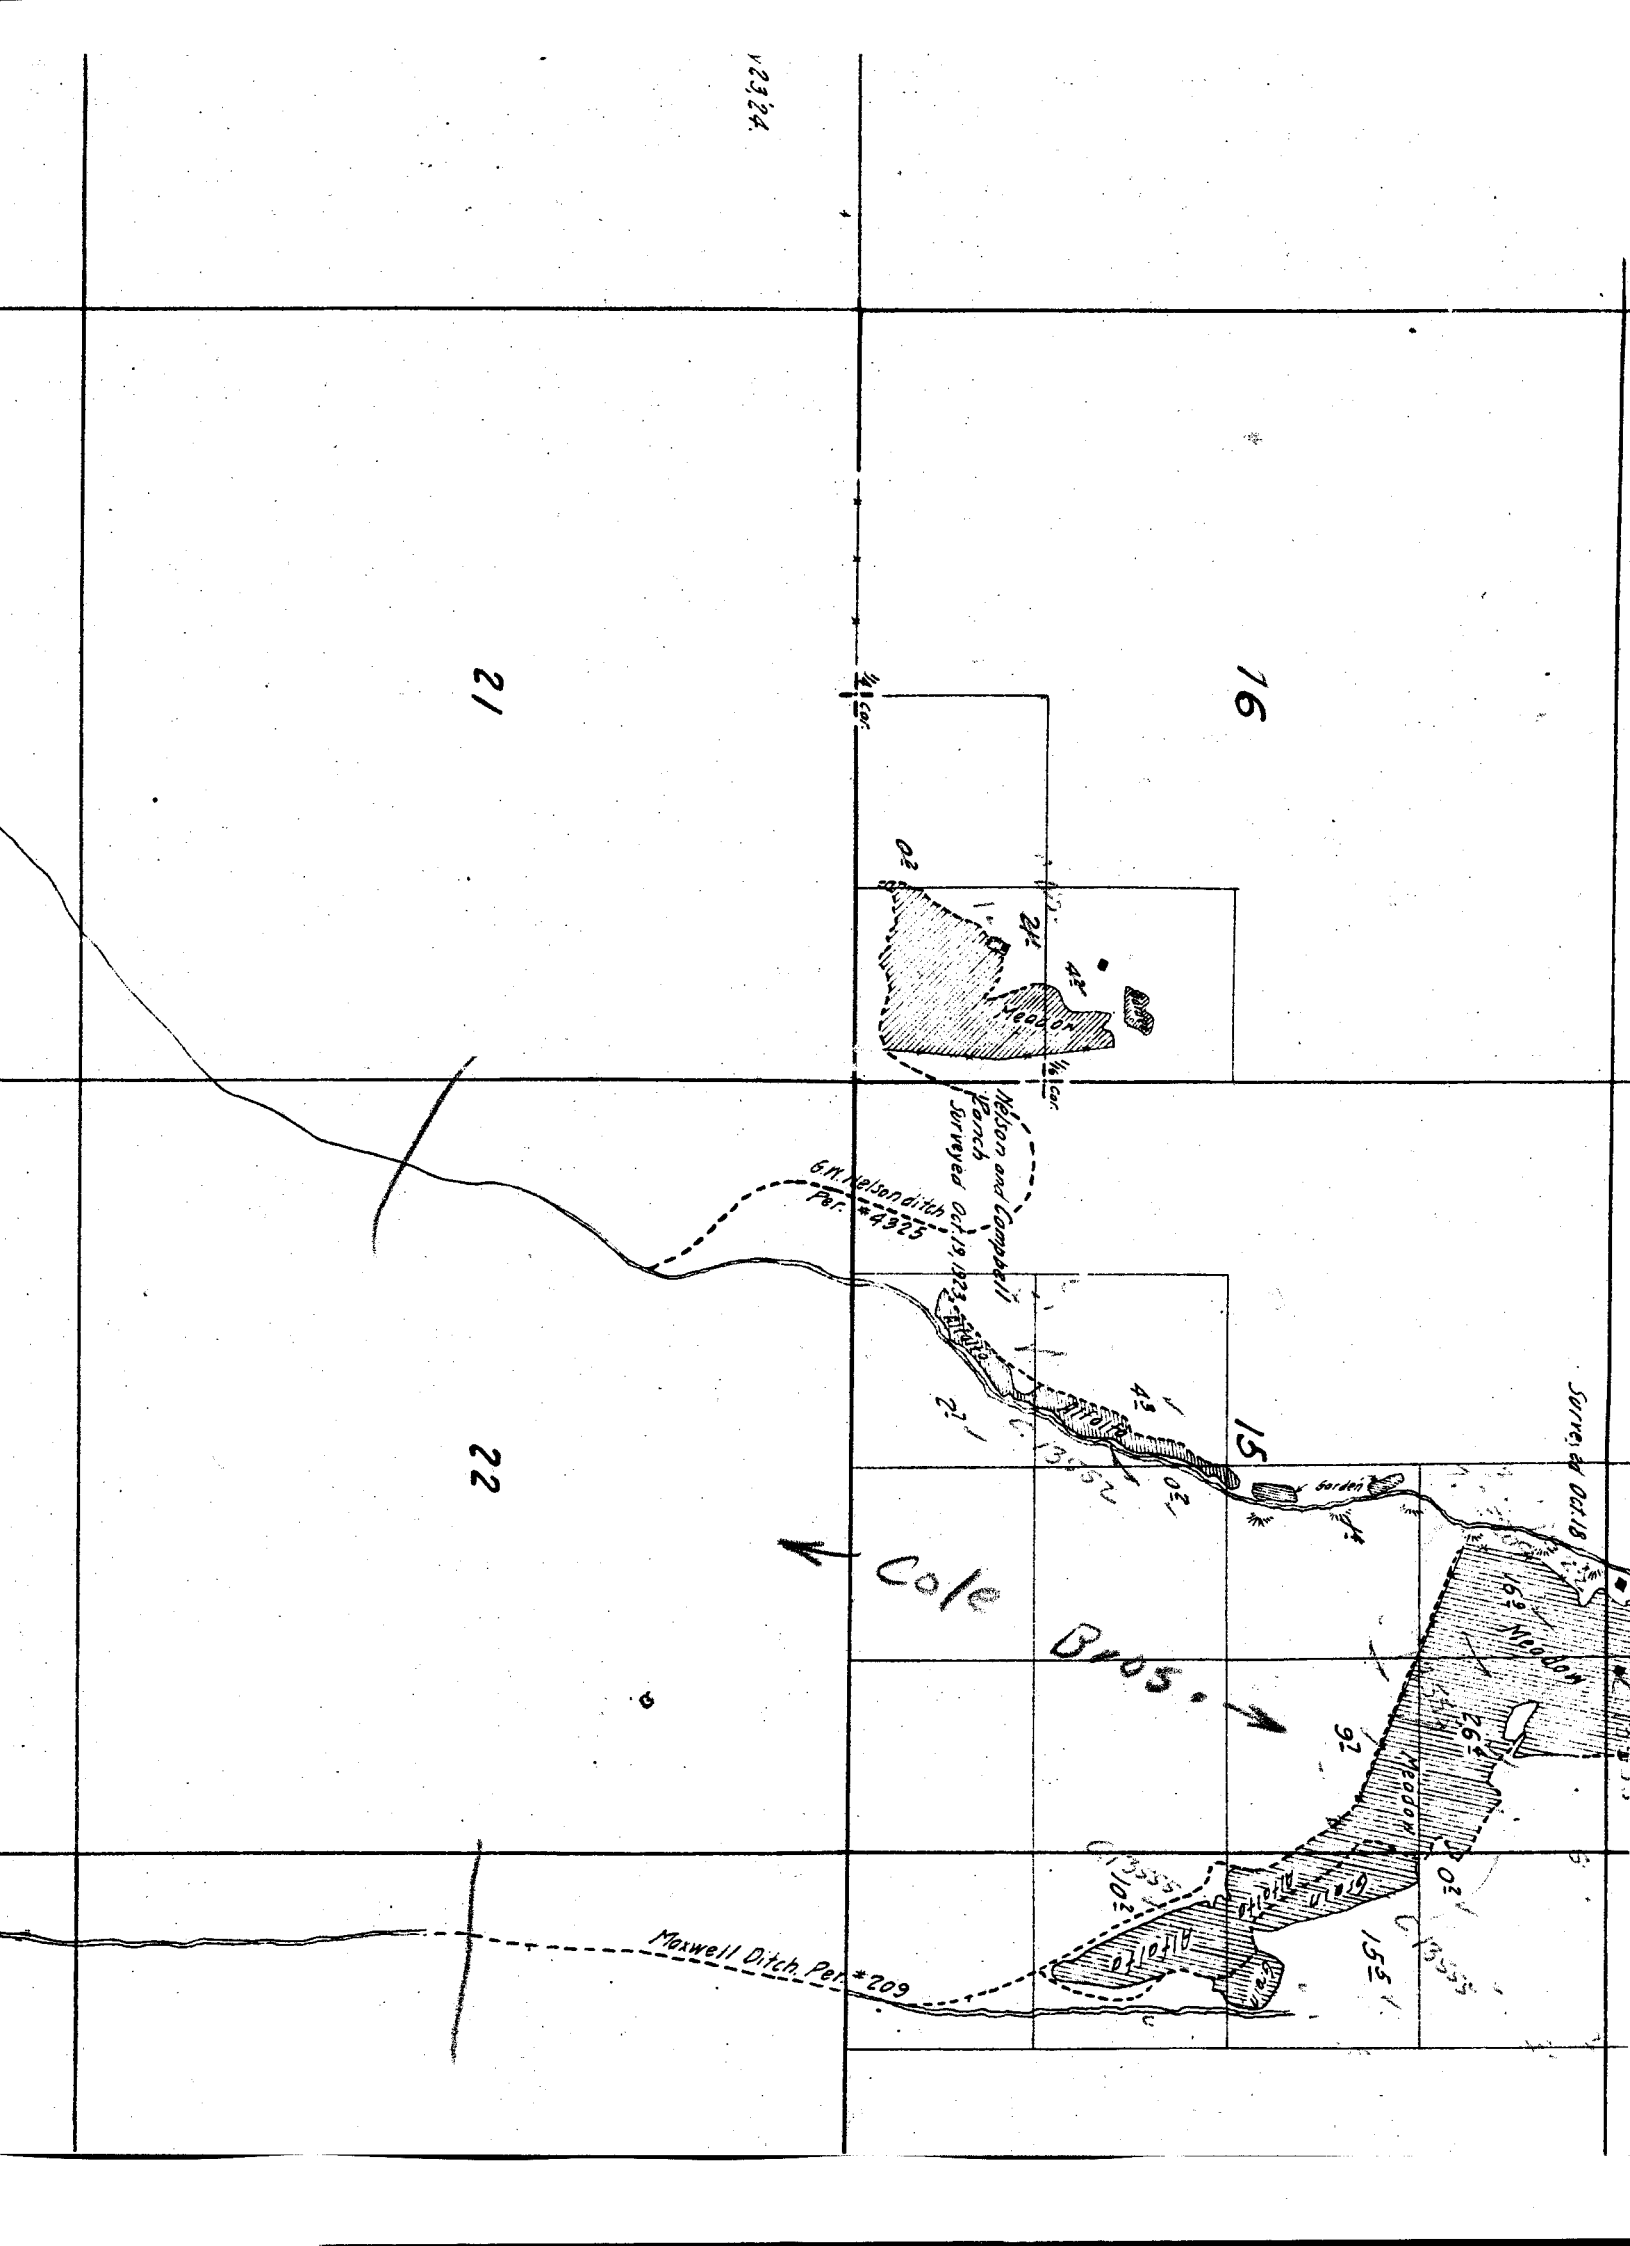

C. A. Cole Ranch

Surveyed Oct. 18

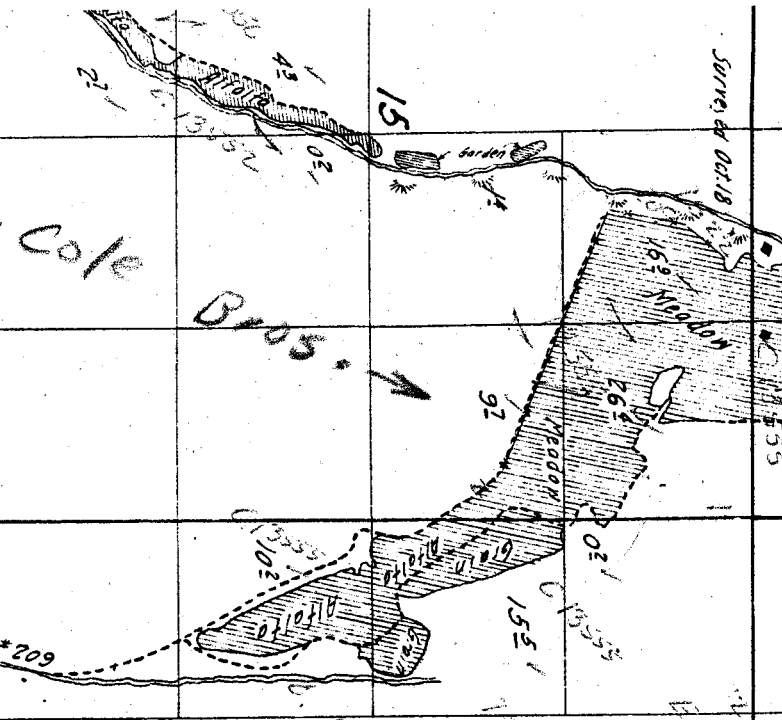

22

23

14

13

24

Maxwell Ditch Per. #209

Cole Bros.


Kreason and Shoemaker Ranch Surveyed Oct. 16

East Ditch Per. #151 and #152

W. Nelson Ditch Per. #178

1/2 E. 1/4 Sec. 13537

West

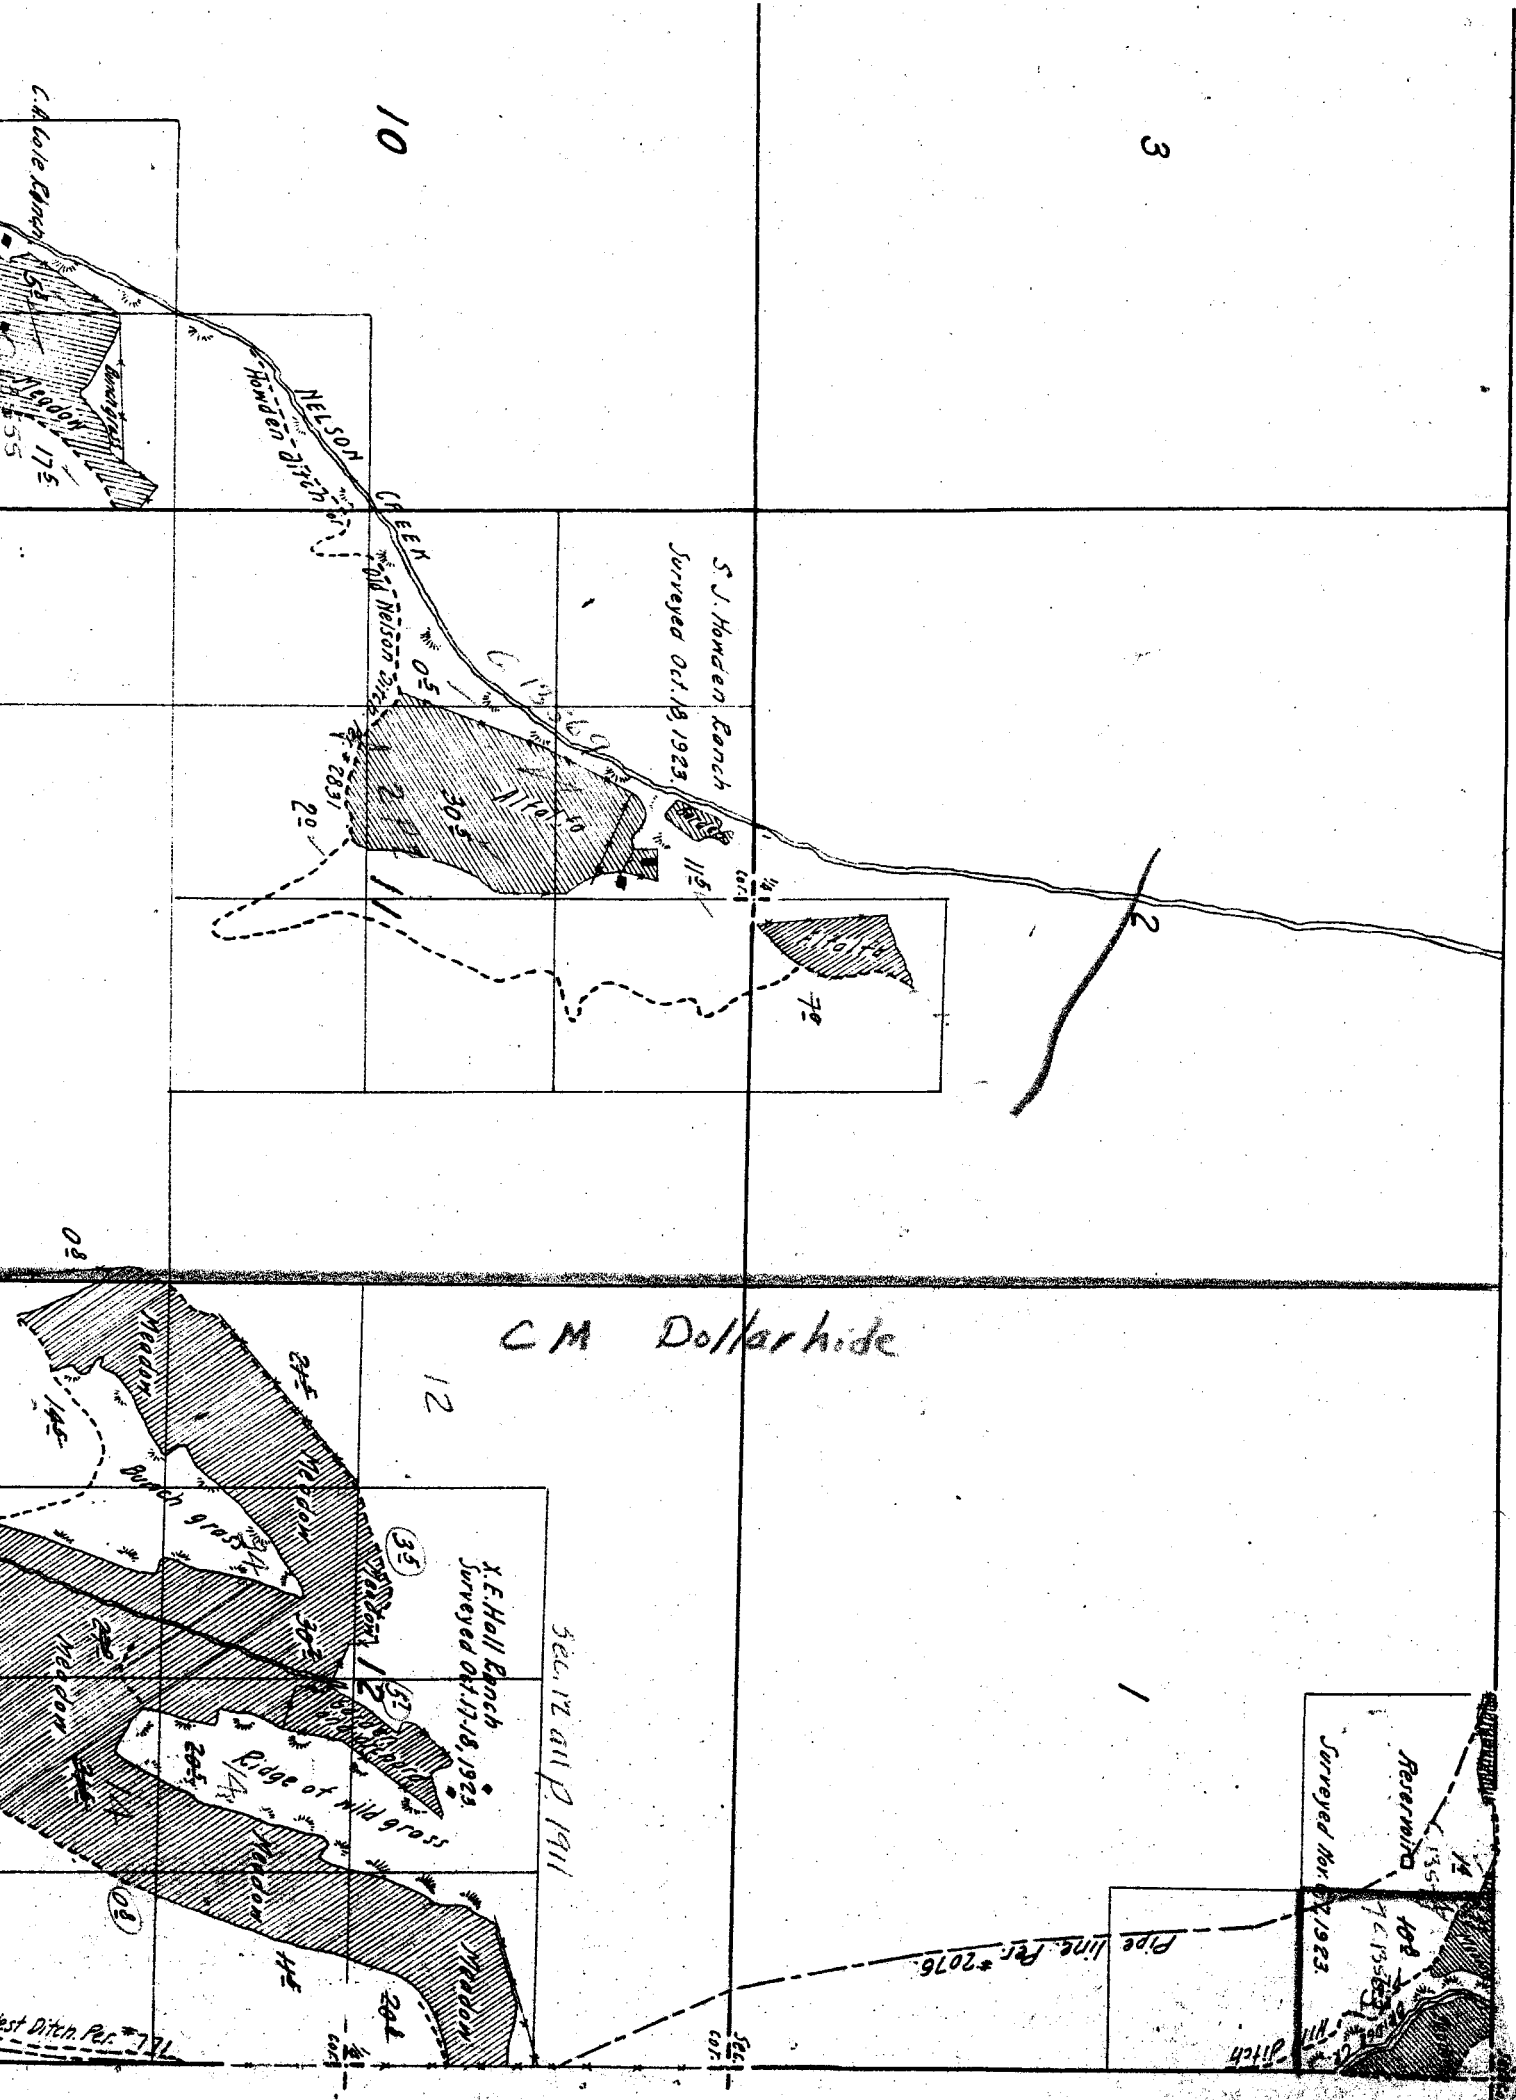

3

10

2

12

C.M. Dollarhide

X.E. Hall Ranch
Surveyed Oct. 17, 18, 1923

S.J. Howden Ranch
Surveyed Oct. 18, 1923

Reservoir
Surveyed Nov. 27, 1923

Pipe line Per. #2076

Sec. 12 all P 1911

C.M. Dollarhide

West Ditch Per. #771

Township

