


28

27

33


34

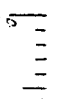

16

15

Surveyed Oct. 20, 1923.

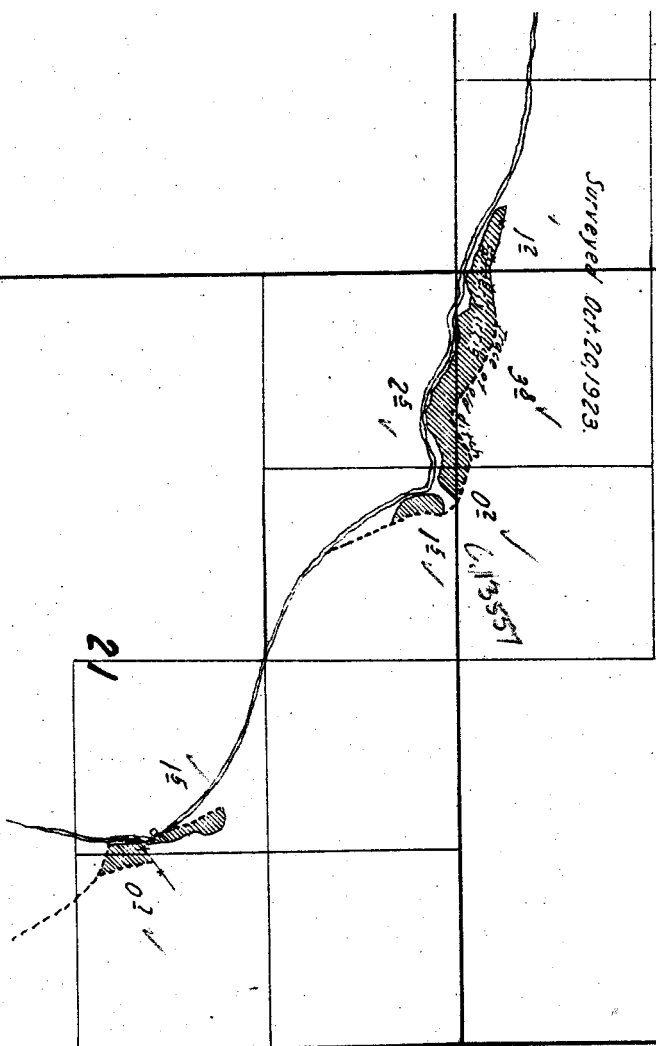

22

21

15


14

13

22

23

24

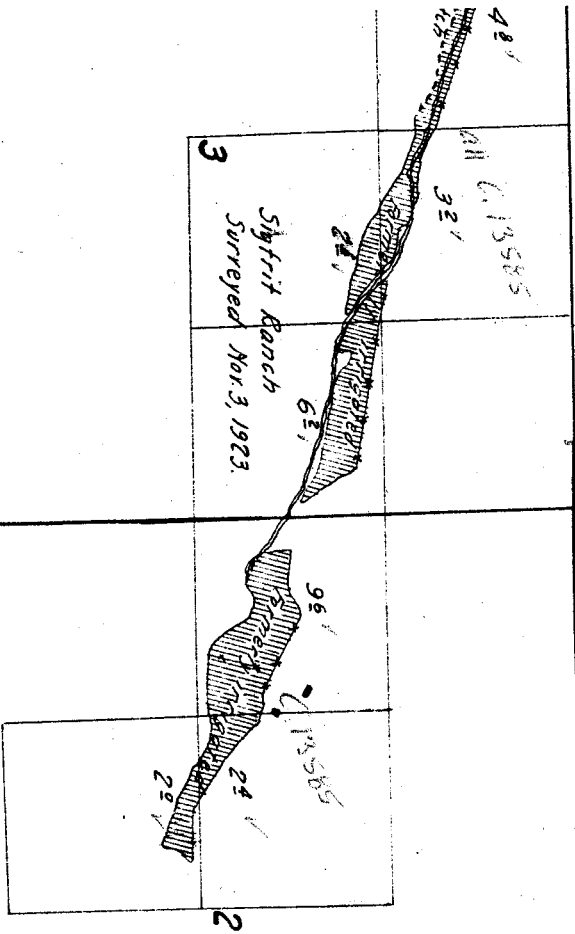


10

11

12

ownship 12 S, Range 22 E.

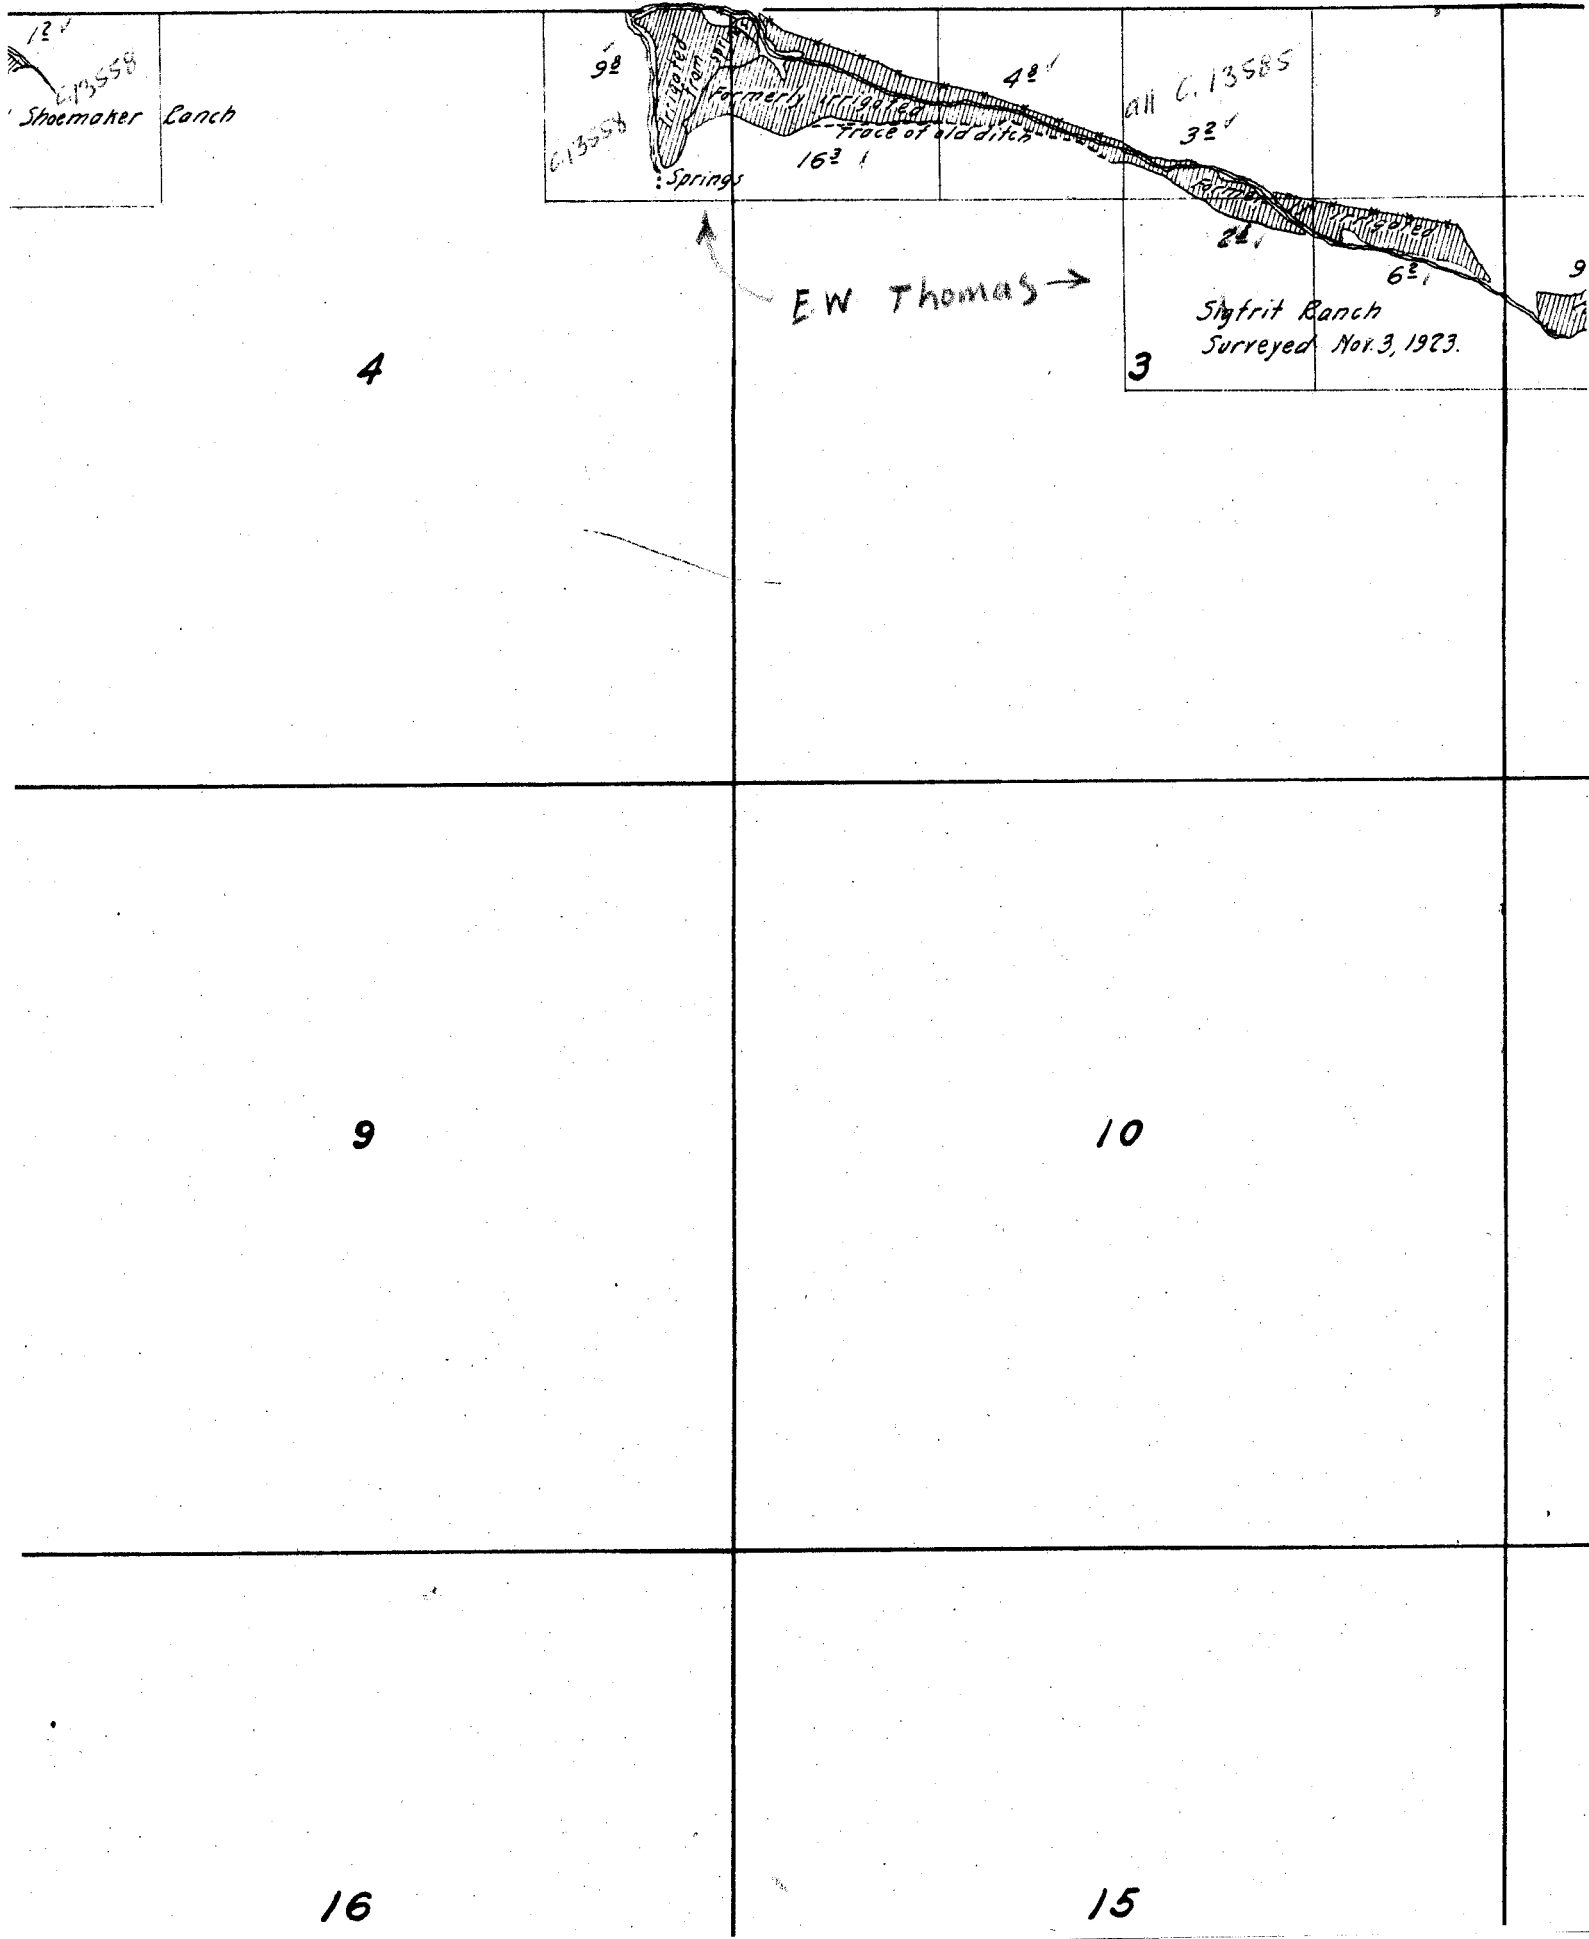

19

20


30

29


31

32

Township 1

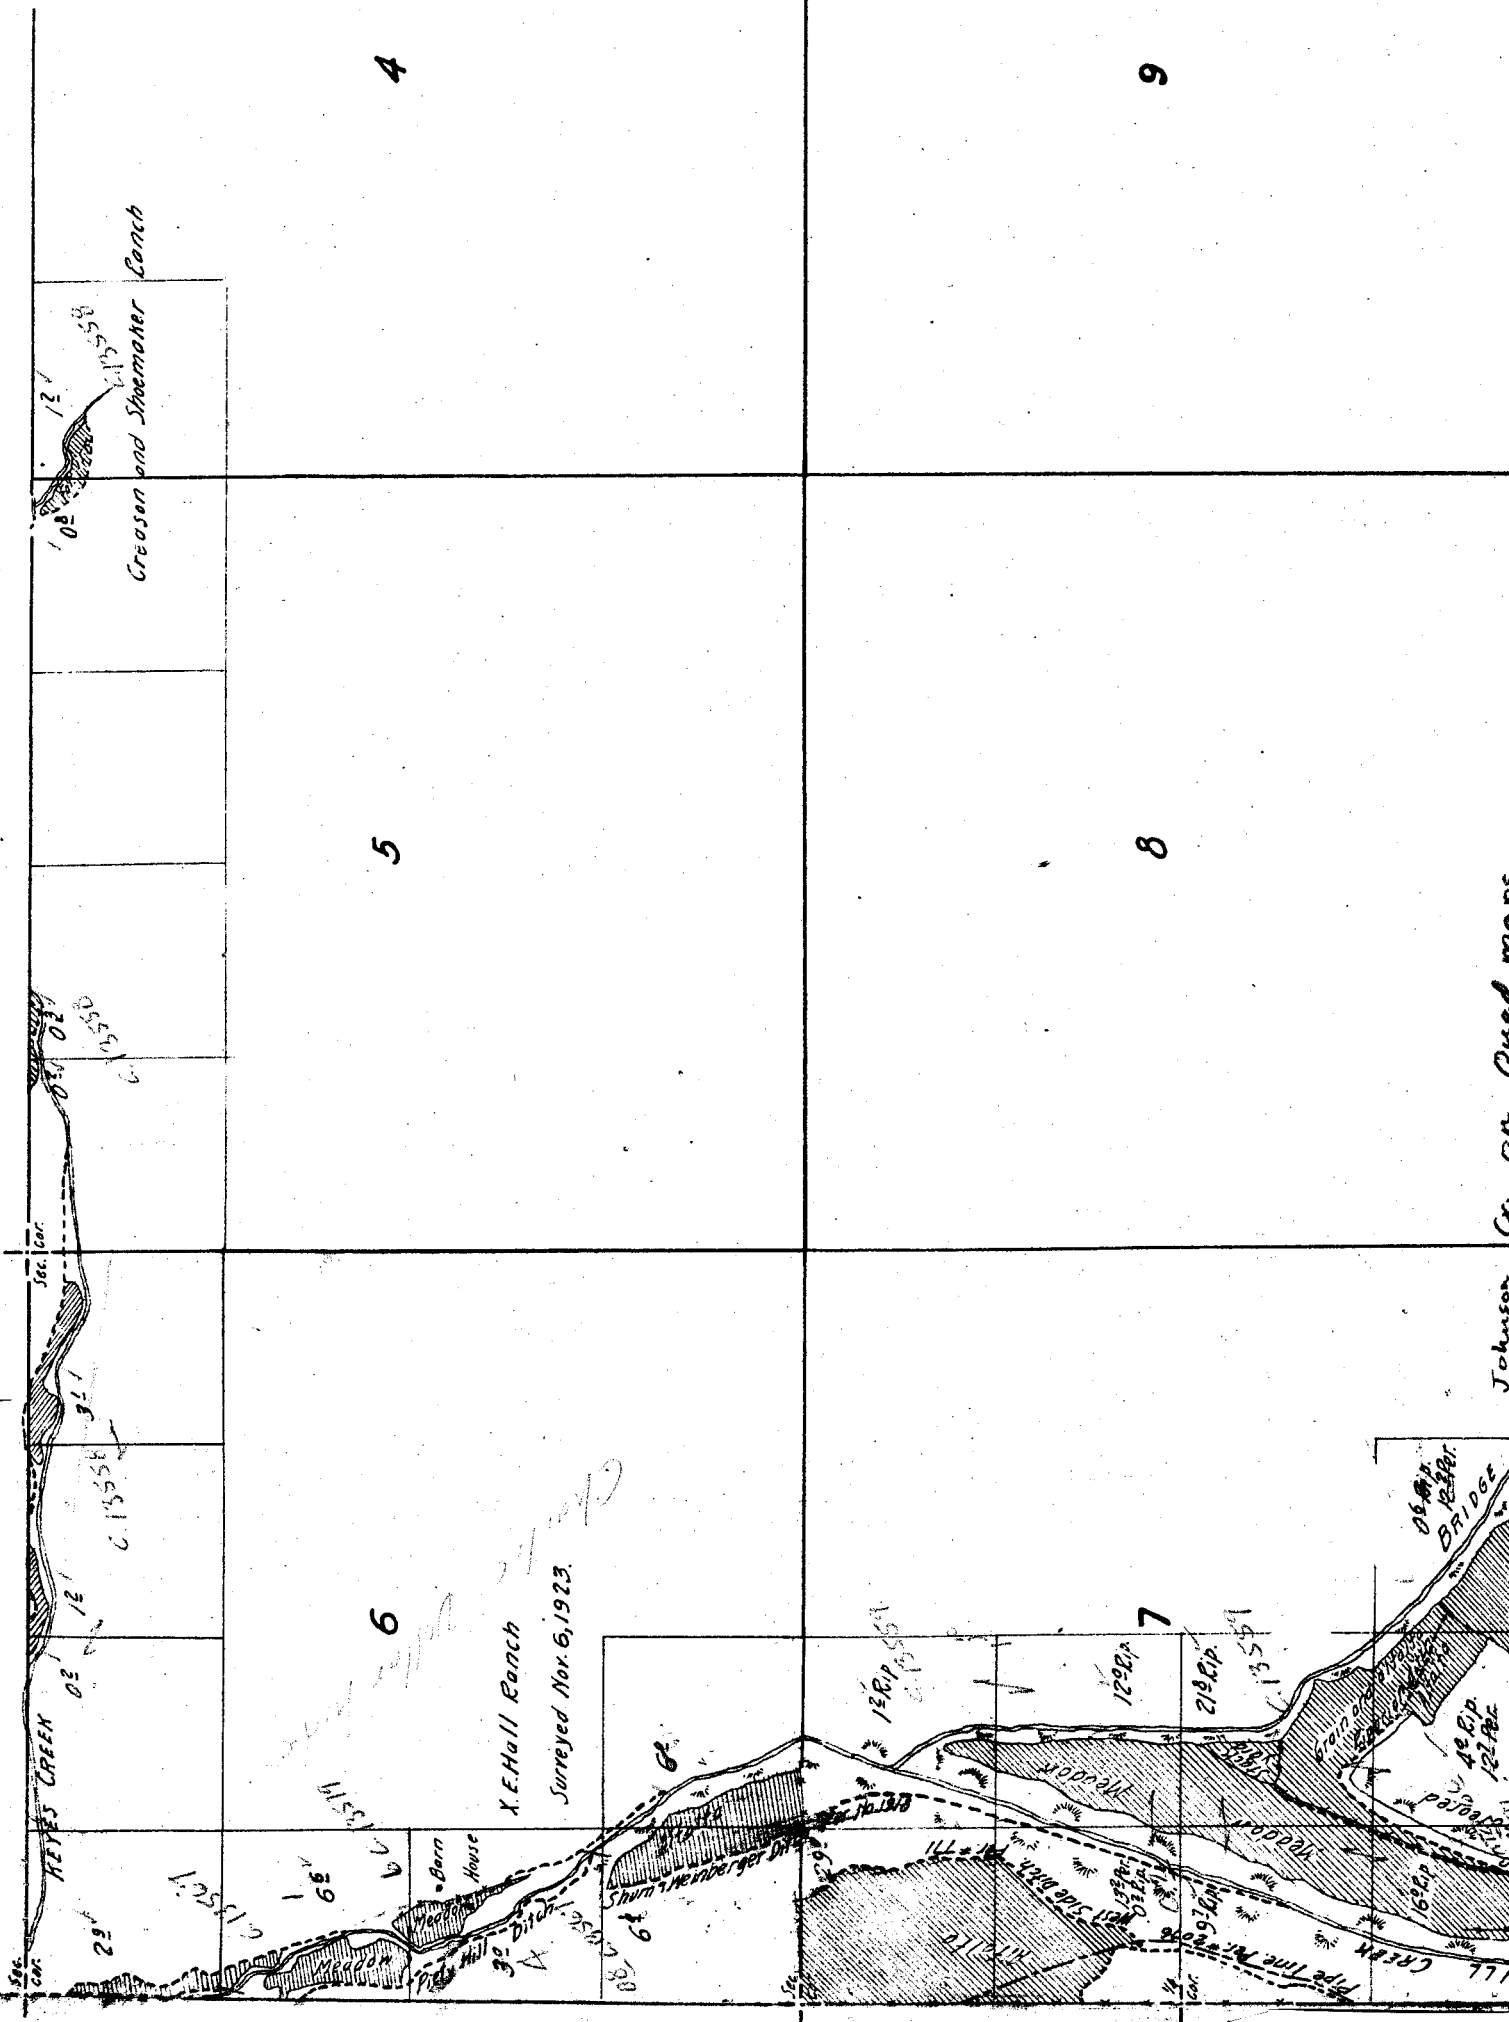

JO
CREEK

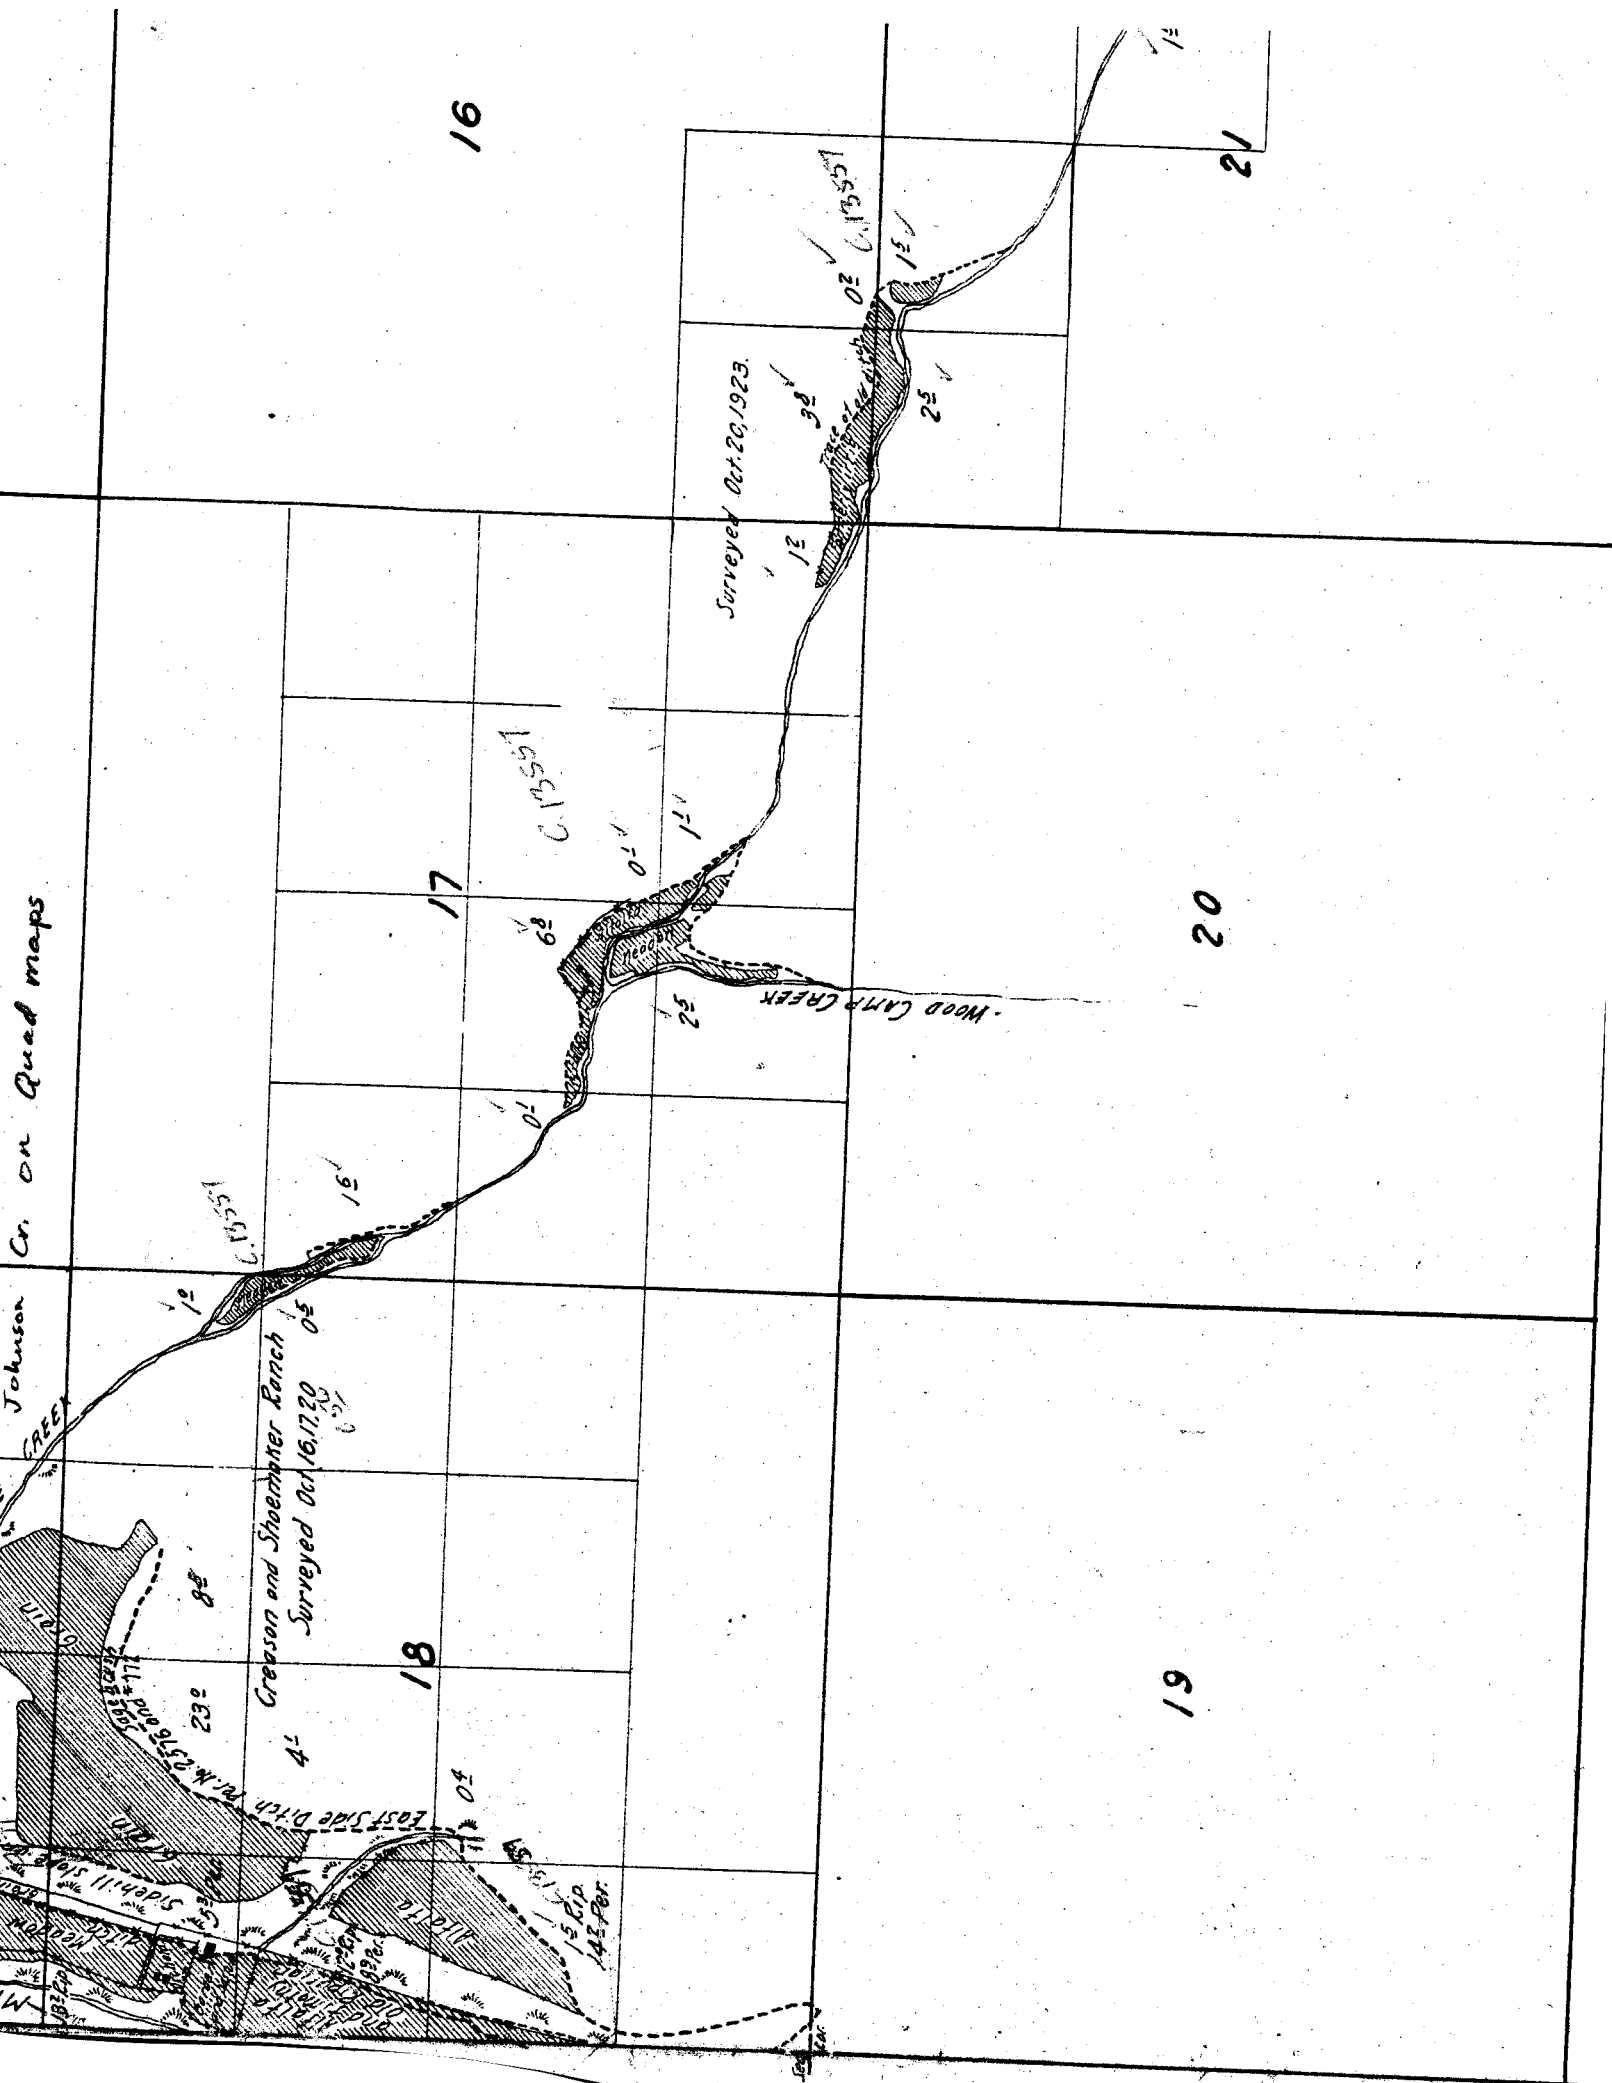

23


24

26

25

35

36

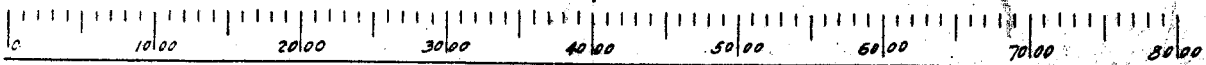

Scale of Feet.

26" x 27"