



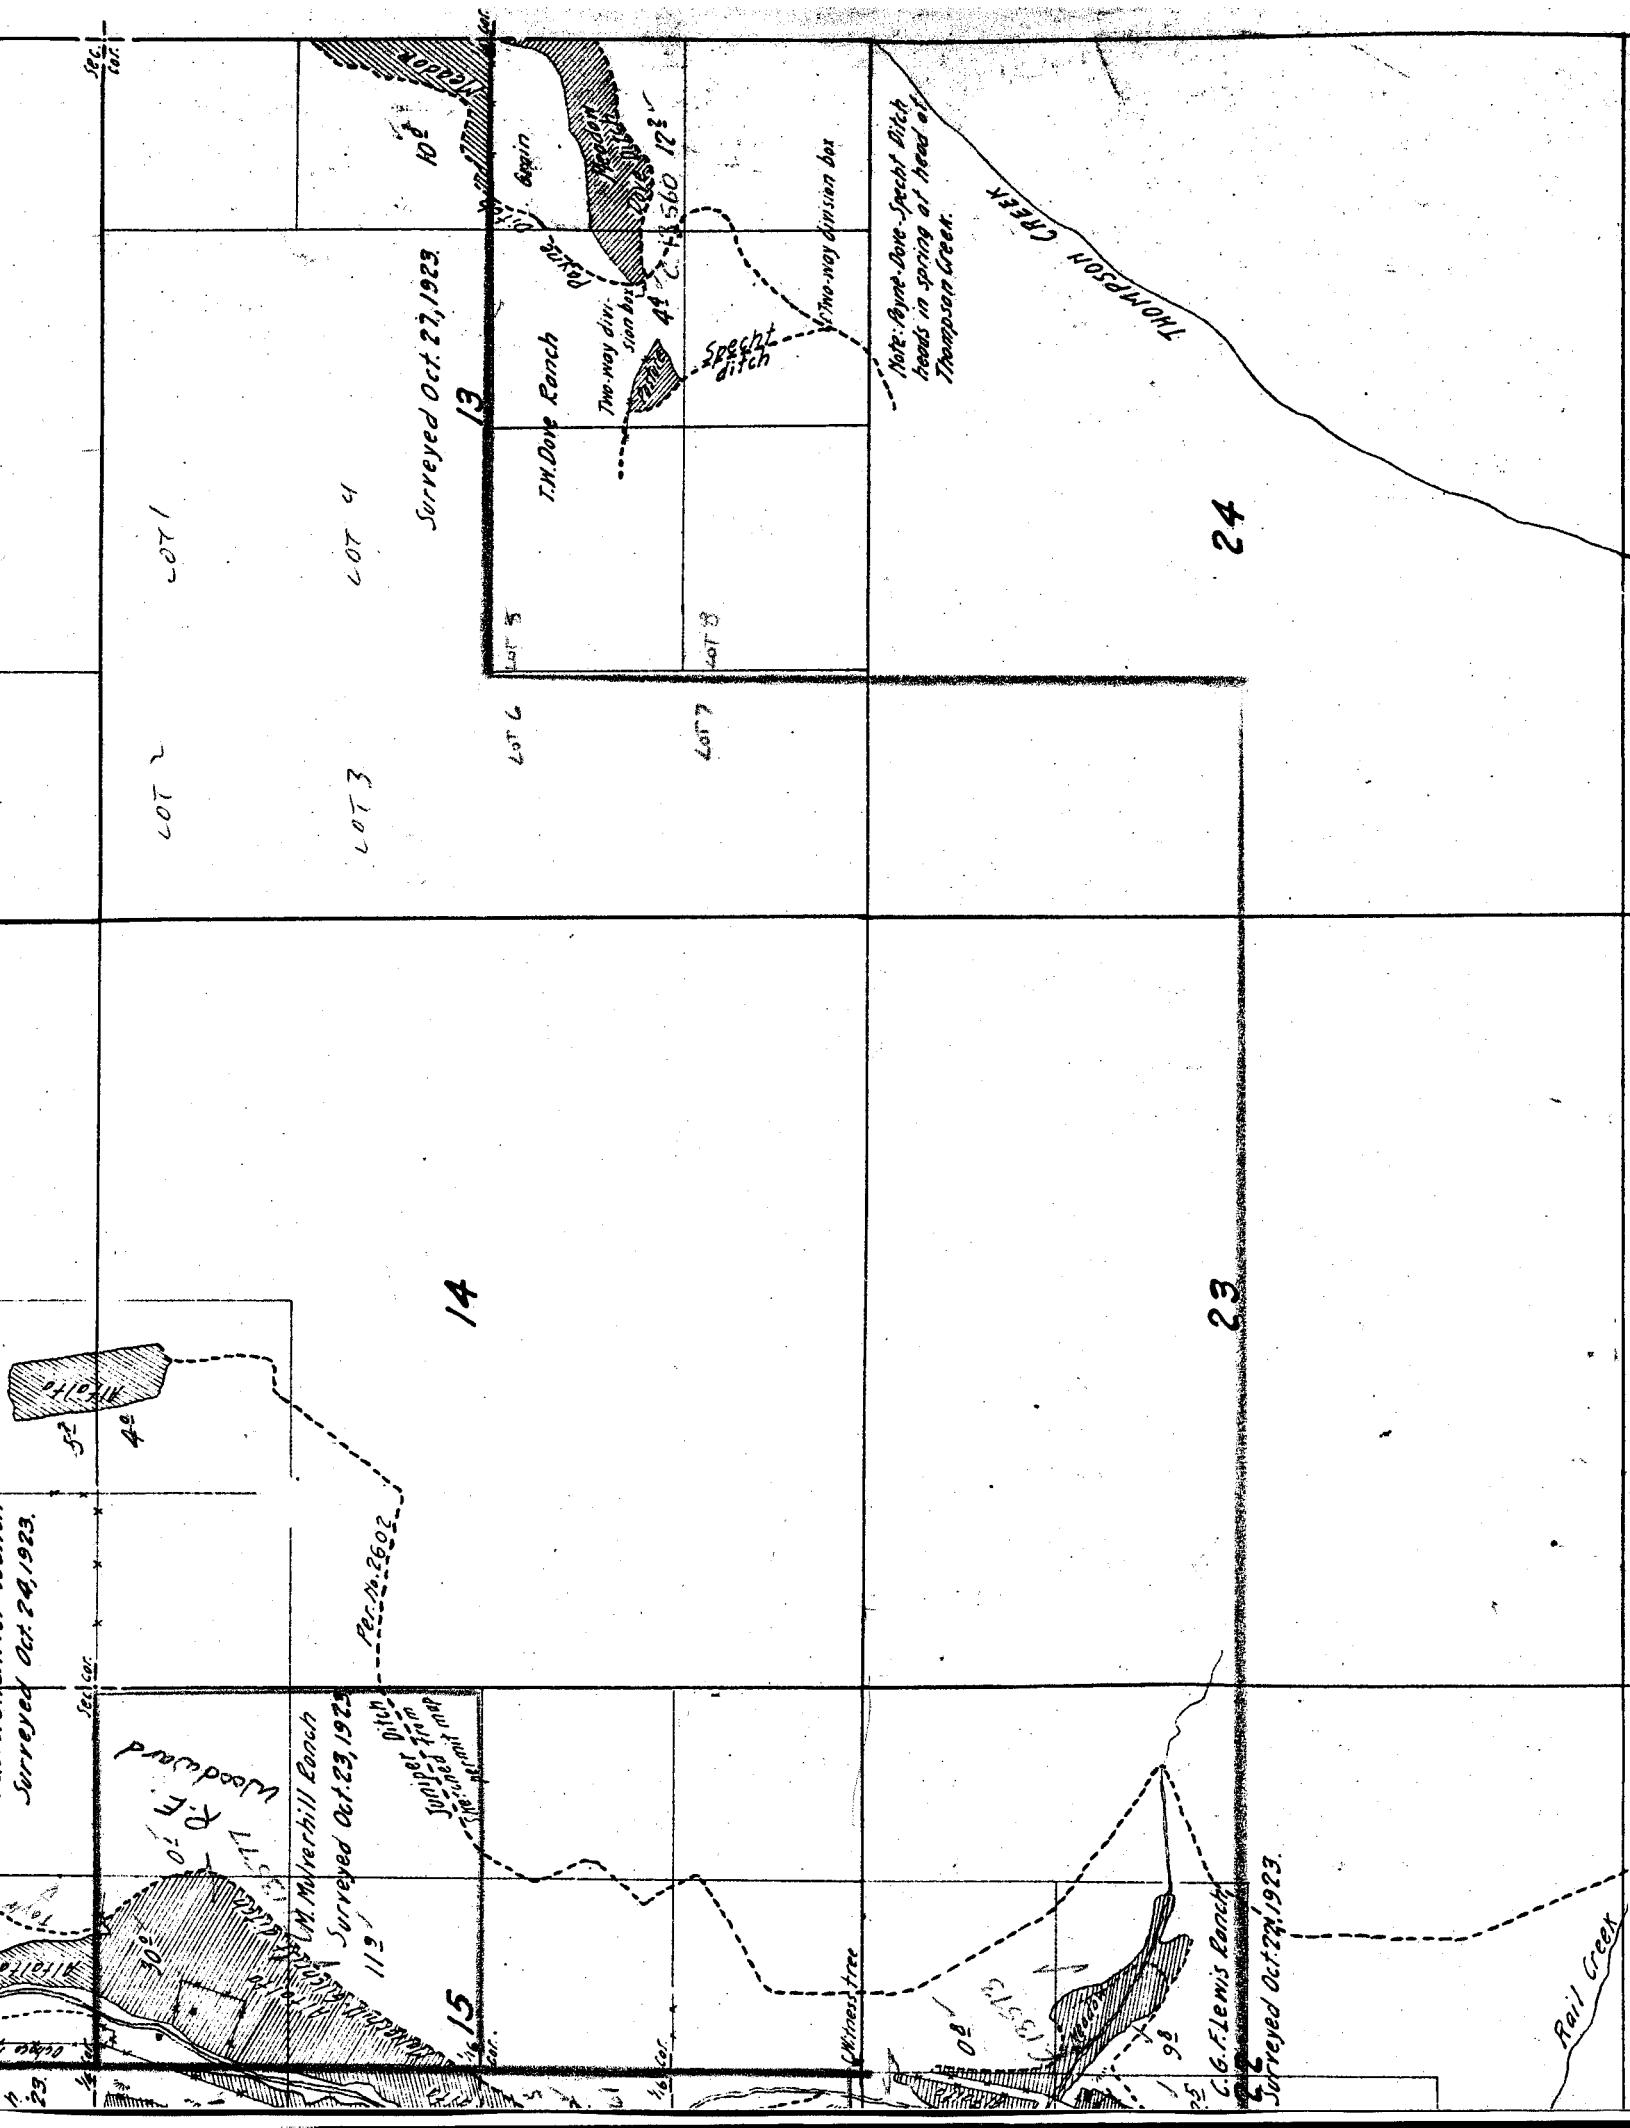

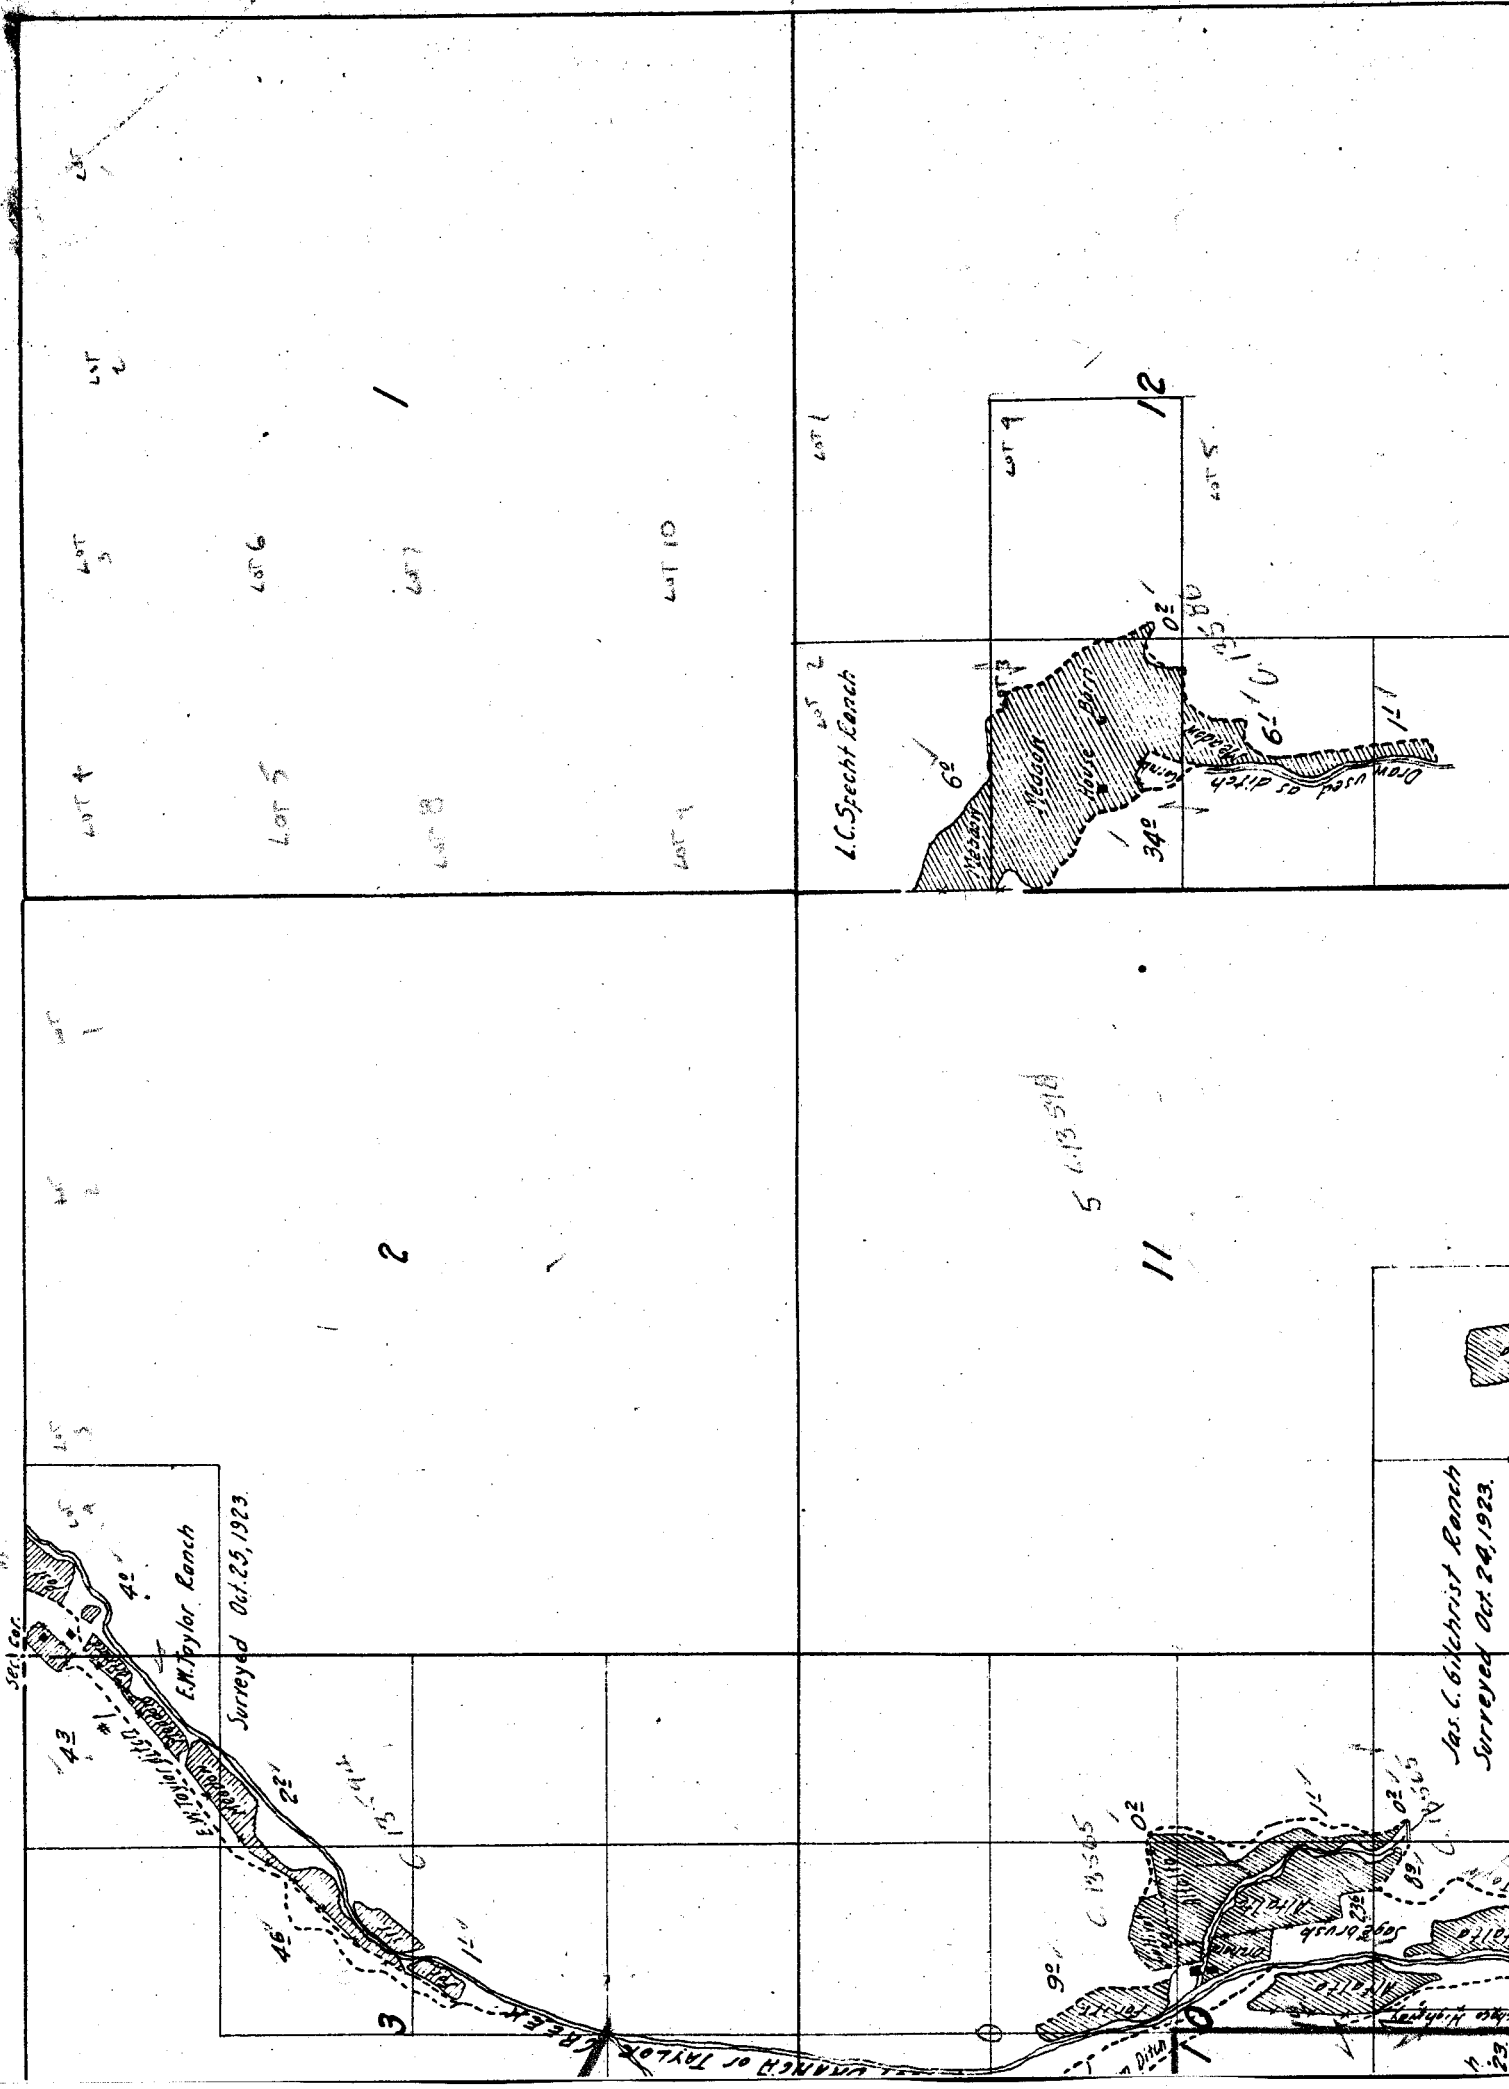

18

HEFLIN CREEK

umber

19

17

20

16

21

52
42
Sec. 22

Per. No. 2602

M. M. Verhill Ranch
Surveyed Oct. 23, 1923

119
115
168
169
1521
92

Blom-brishan ditch

Timber

Witness tree

Loc. for cattle spring

C. G. Lewis Ranch
Surveyed Oct. 24, 1923

R. D. Cannon Ranch


Timber

Taylor Creek

Rail Creek

16

21

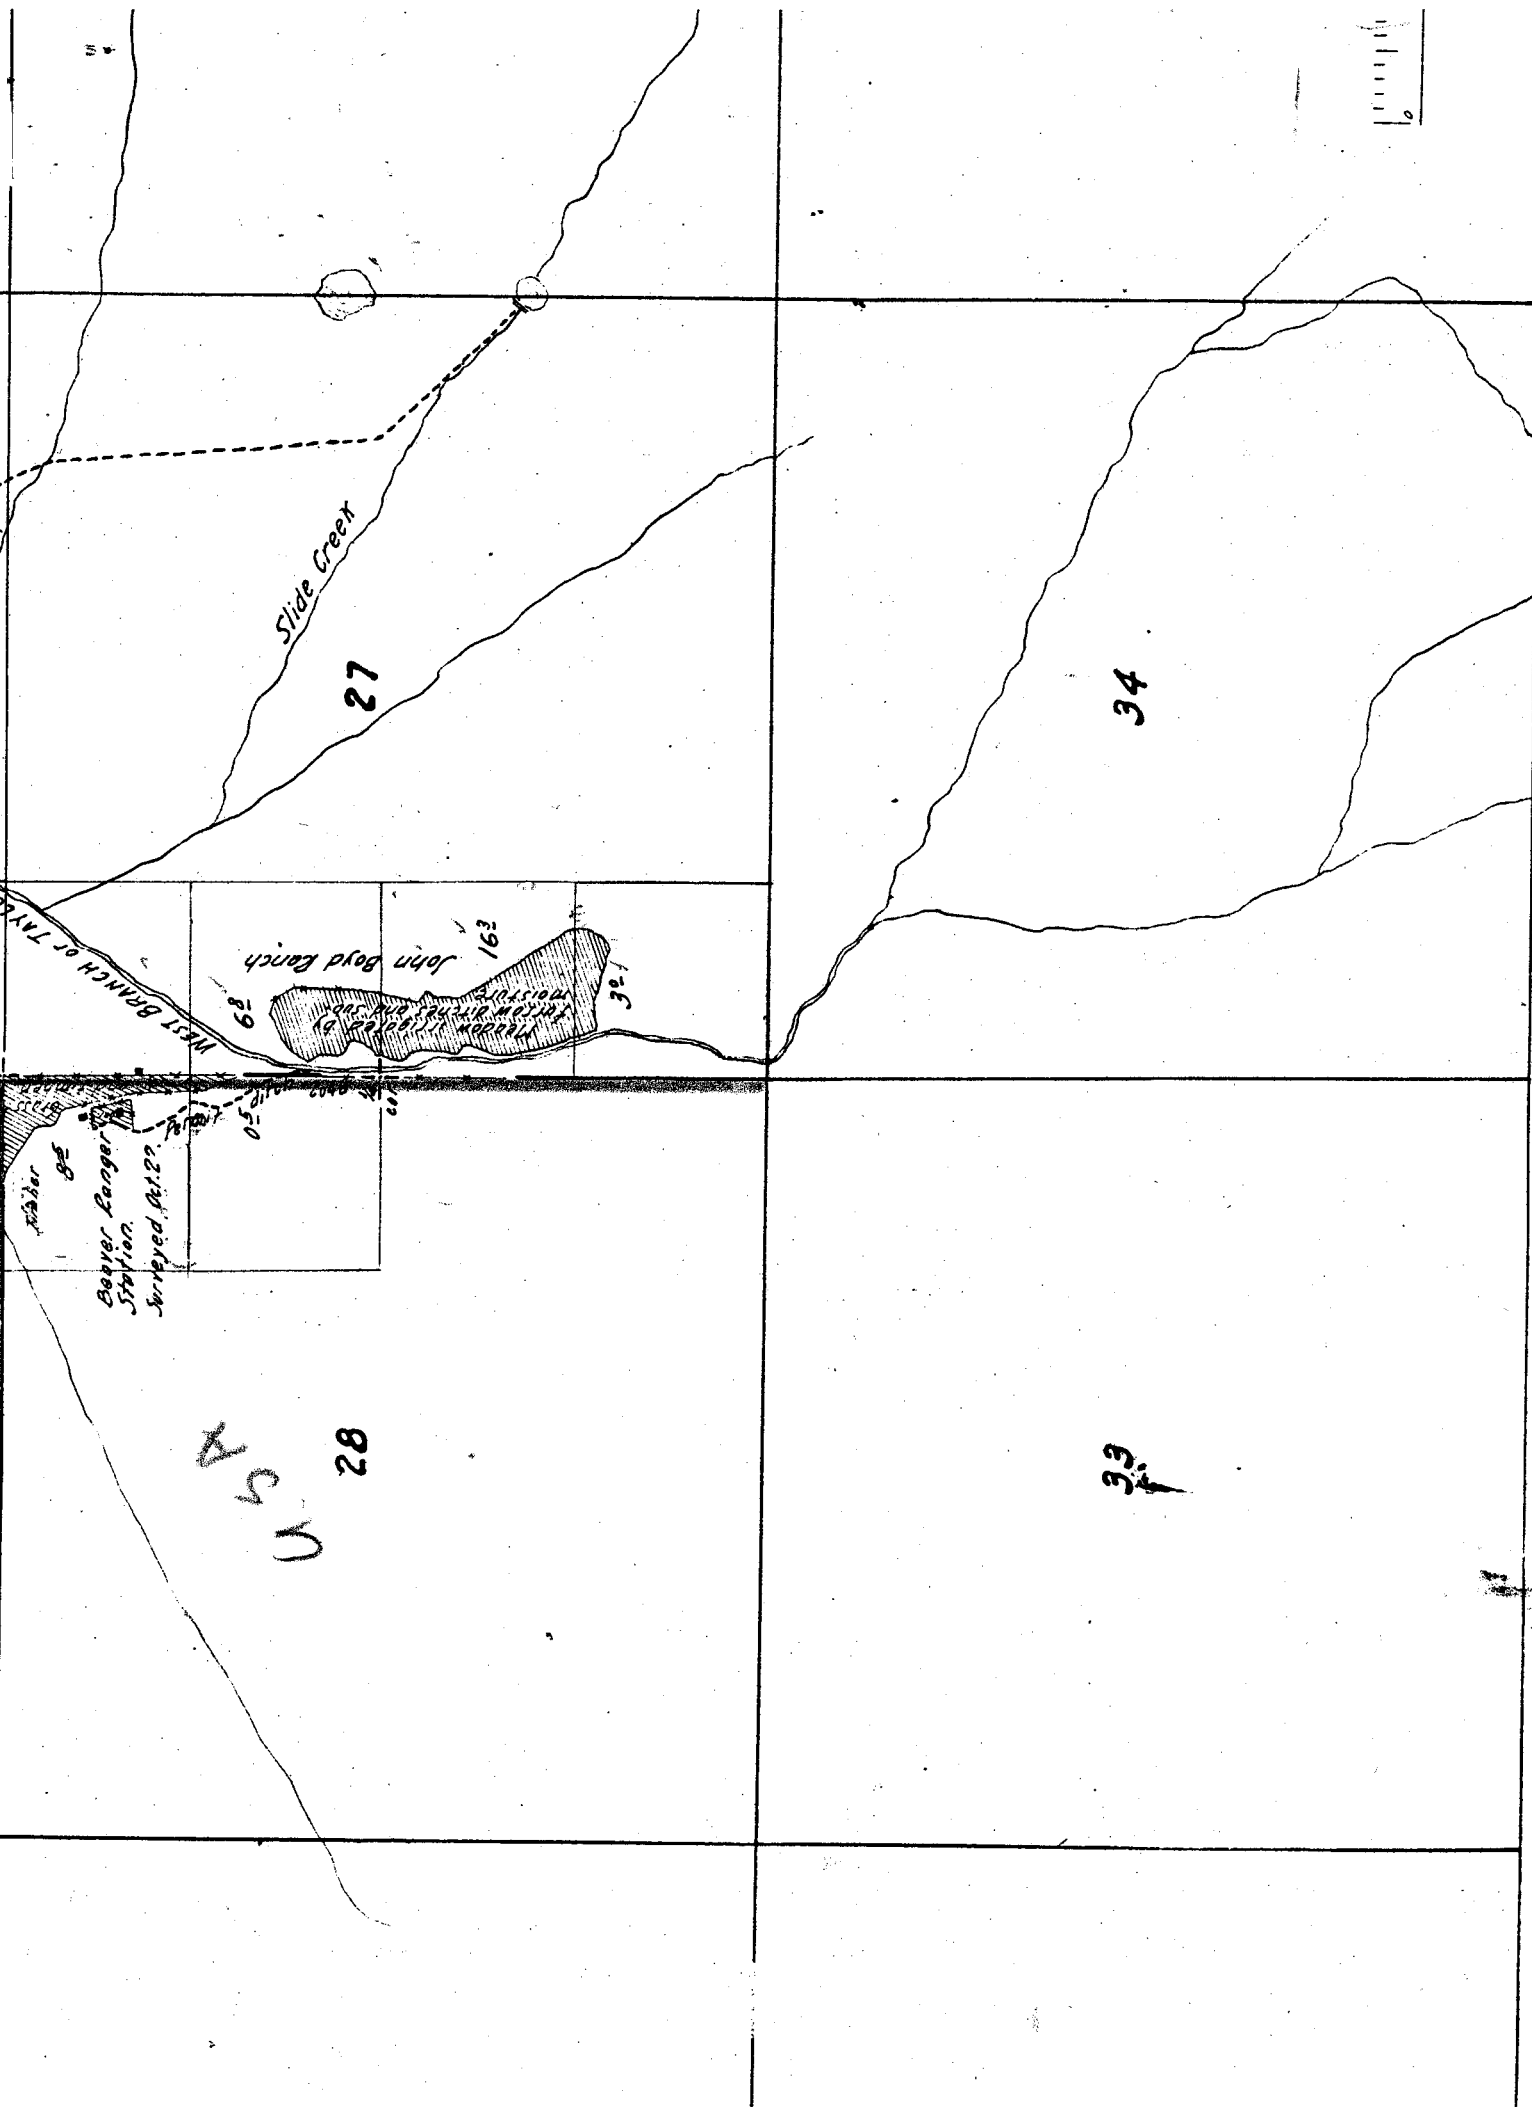

U S A 28

19

20

30

29

31

32

23

24

THOMPSON

26

25

Note: - Creeks sketched in approximate location from U.S. Township plat, U.S. Forest Service map, and permit maps, except in vicinity of irrigated areas.

35

36



Scale of Feet.

