

12


16

65

17

19

18

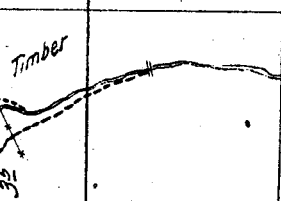


Township

4

5

6


Marvin and
L
Ranch Survey
V 25
13554

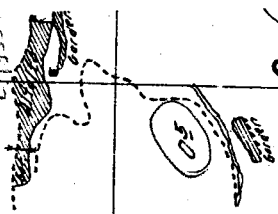

9

R.D. Johnson &
B.P.

8

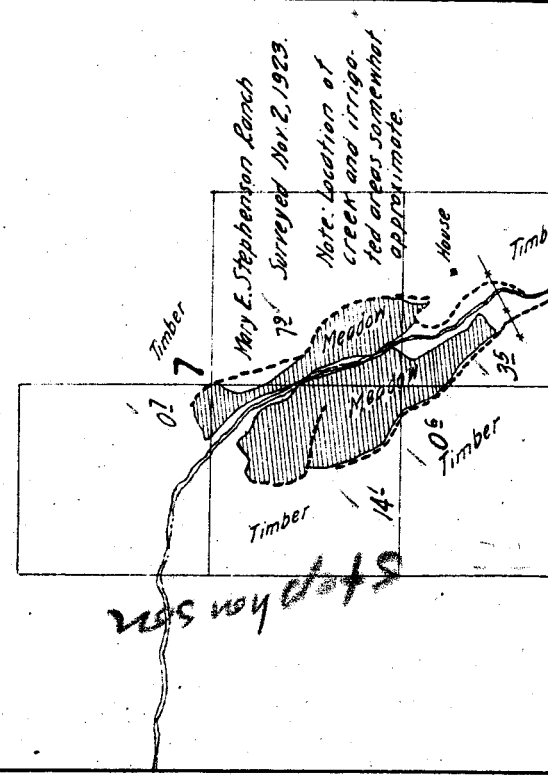

USA
28

33

Boyer Ranger Station
Surveyed Oct 22
2 P. 2046
Acres 713 (487)
(14,887)
0.5


Meadow irrigated by
furrow ditch and sub
moisture
John Boyd Ranch
Acres 162
321

WEST BRANCH OF TN
68
C. 134550

27


Slide Creek


34

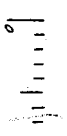


16

21

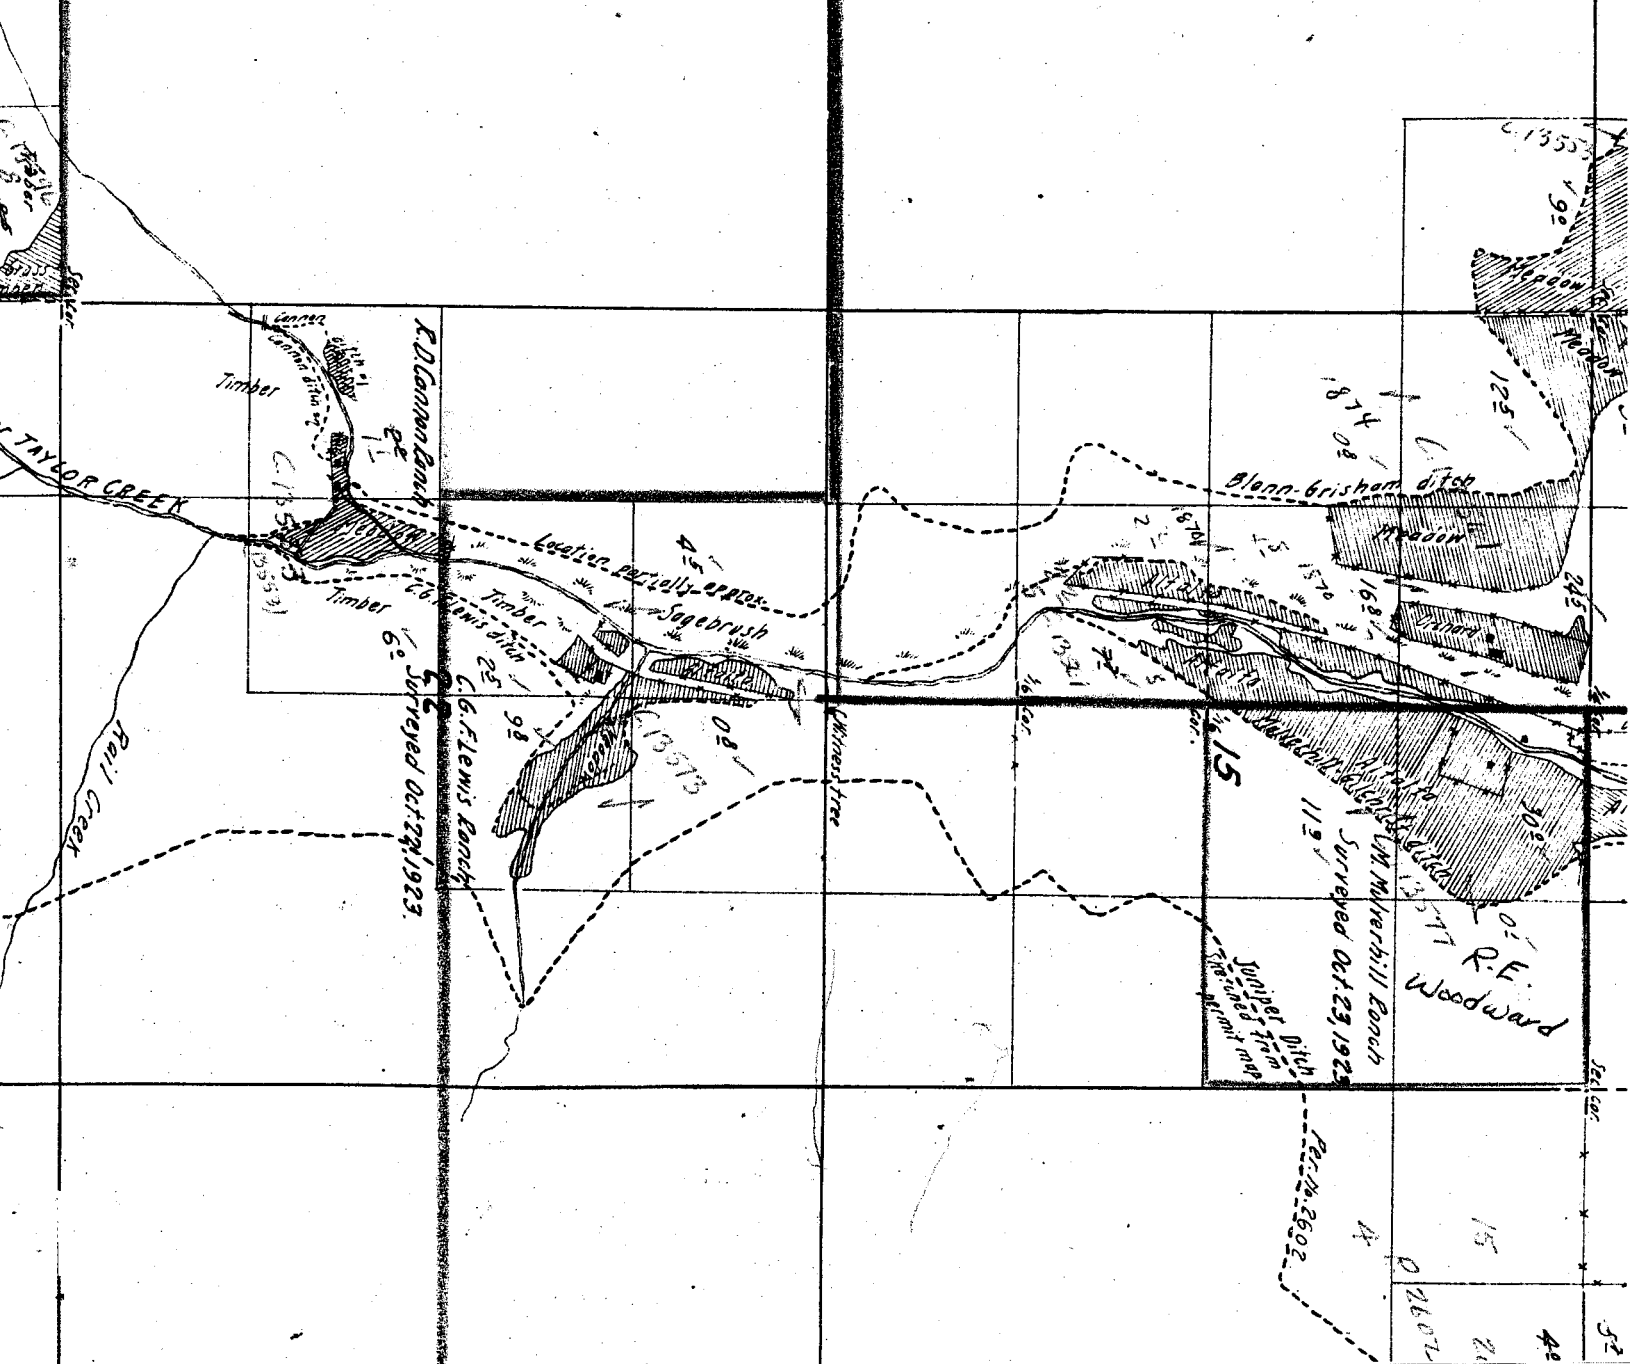

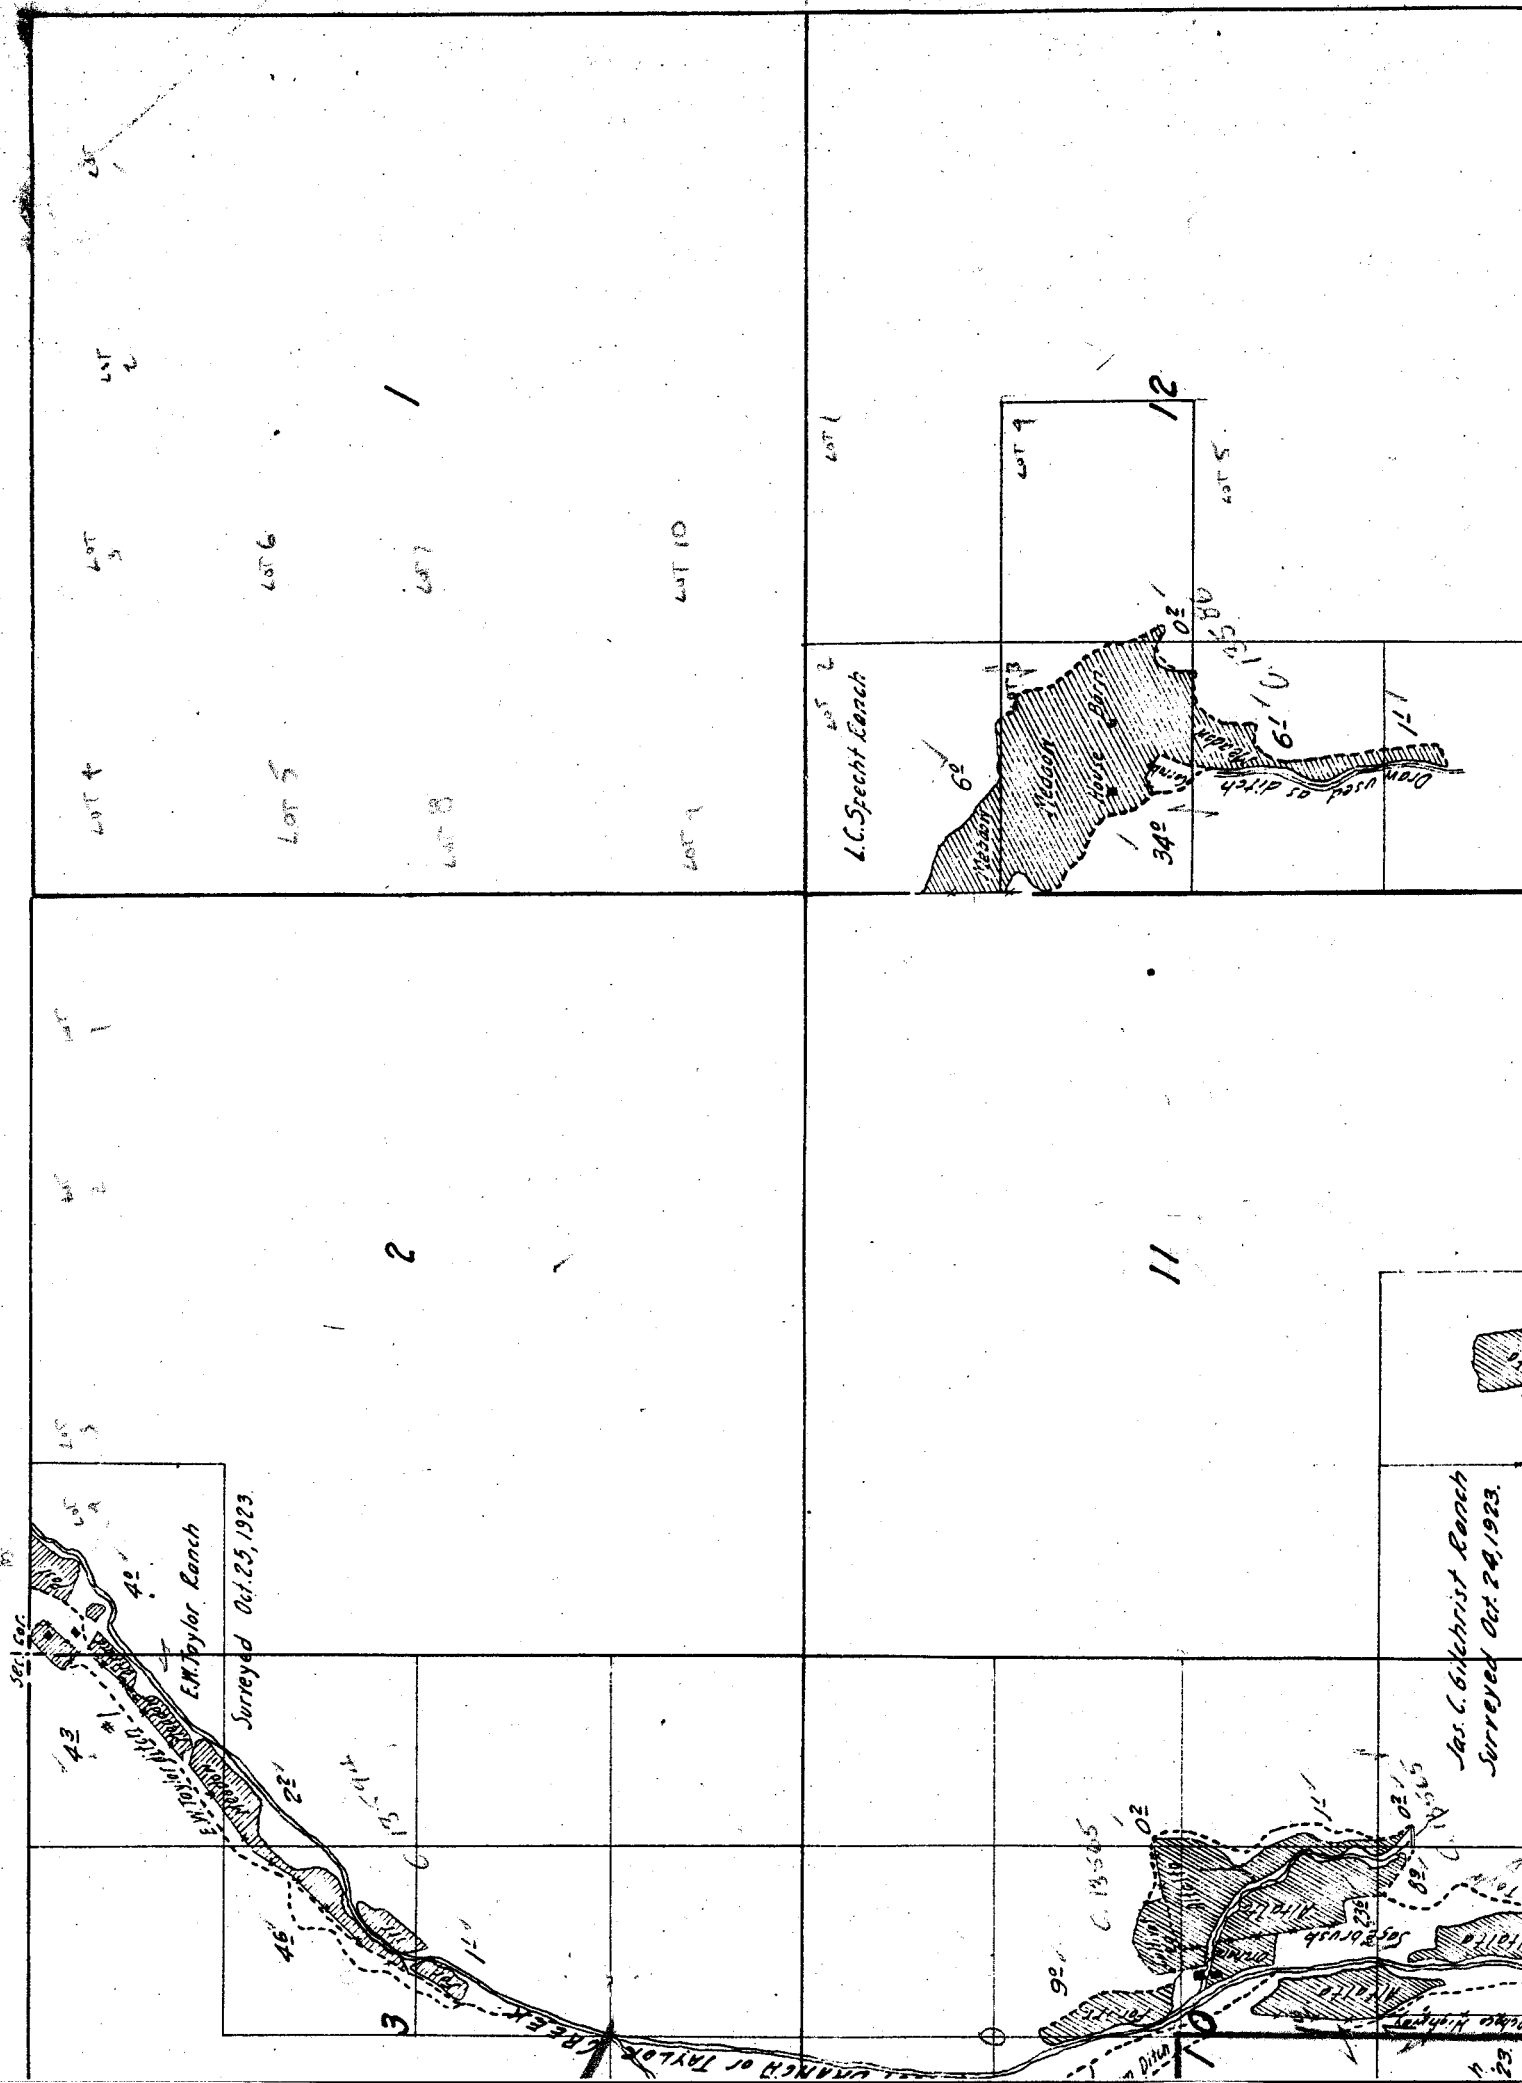

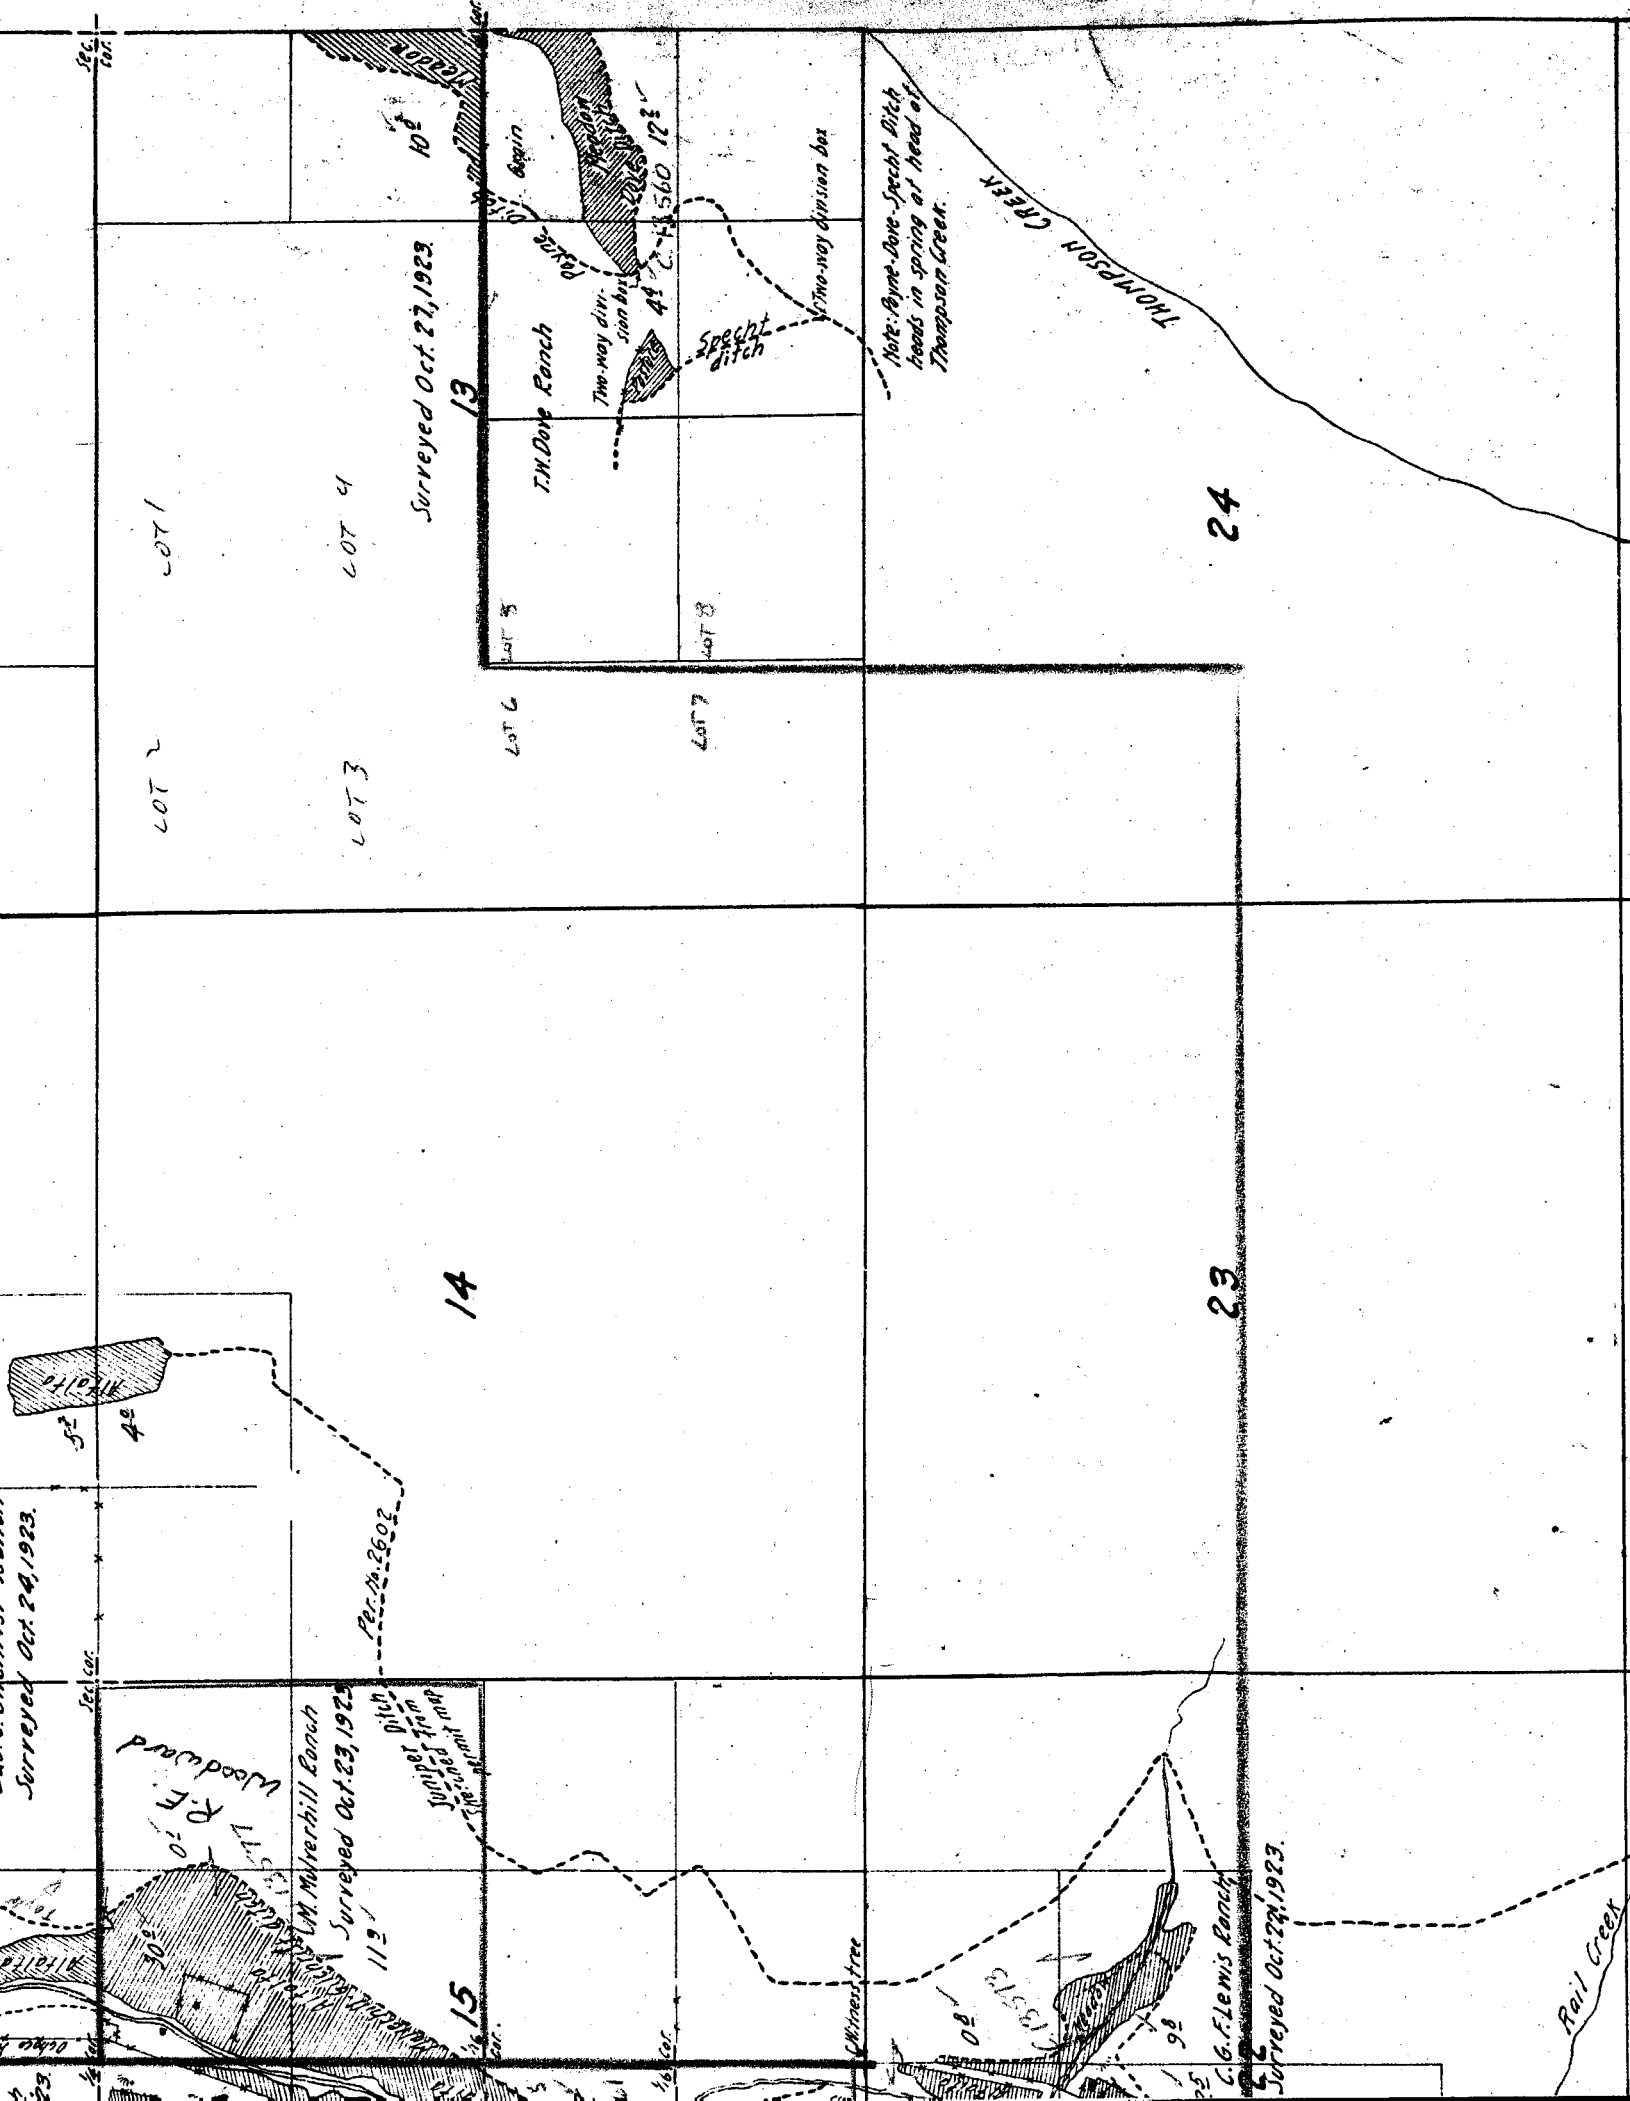

Sec.
102

LOT 1

LOT 4

Surveyed Oct. 27, 1923

13

T.H. Dove Ranch

LOT 5

LOT 6

LOT 8

LOT 7

Two-way divi-
sion box

Specht
ditch

Two-way division box

Note: Byrne Dove Specht Ditch
heads in spring at head of
Thompson Creek.

THOMPSON CREEK

24

14

Per. No. 2602

23

Surveyed Oct 24, 1923.

Sec. 102

R.F. Woodward

Surveyed Oct 23, 1923

15

112'

Whinnet tree

C.G. Lewis Ranch

Surveyed Oct 24, 1923.

Rail Creek

19

20

30

29

31

32

23

24

THOMPSON


26

25

NOTE: - Creeks sketched in approximate location from U.S. Township plat, U.S. Forest Service map, and permit maps, except in vicinity of irrigated areas.

35

36

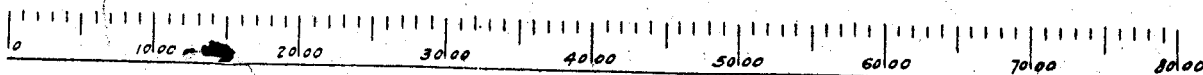

Scale of Feet.

