

2

13

24

14

23

15

22

27


26

25

34

35

36

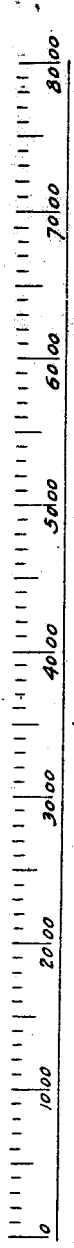

Scale of feet.

16

15

21

22

Township

10 S.

Range

21 E.

4

3

9

10

30

29

28

Sheep sheds

Ben Taylor Ranch
Surveyed Oct. 5, 8, 9, 1923

Sagebrush

104
135913

95

34

Sagebrush

BRIDGE CREEK

31

112
135912

228

01

Sagebrush


98

1/2
1/2

1/2
1/2

32

33

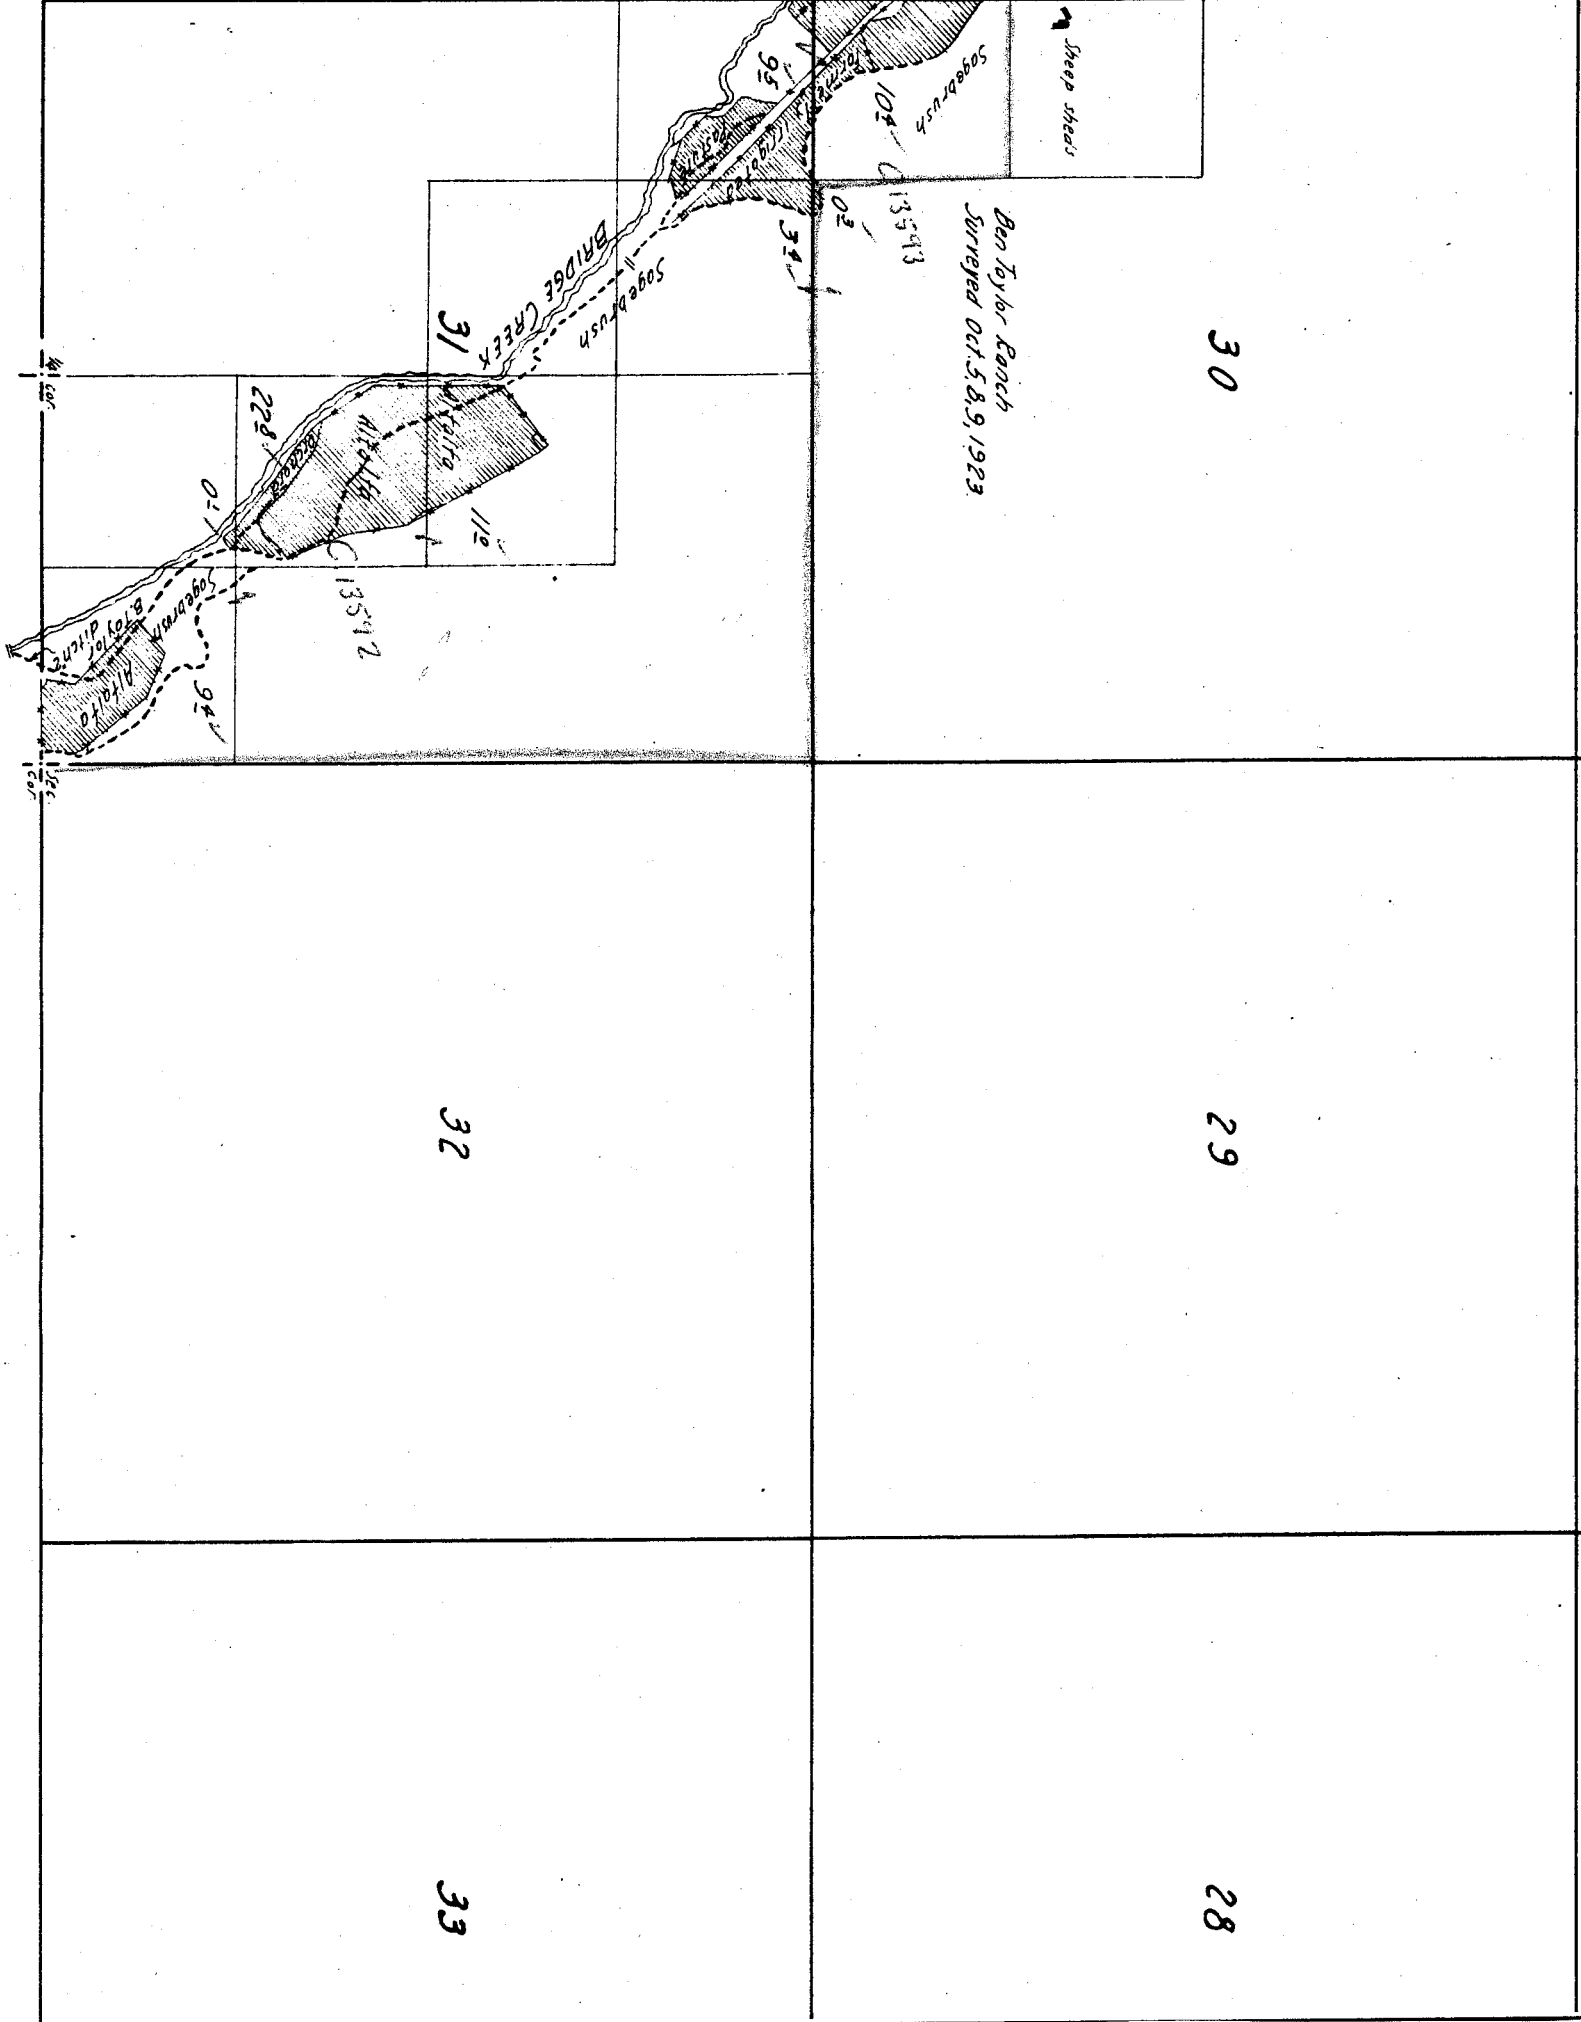

18


17

16

19

20

21

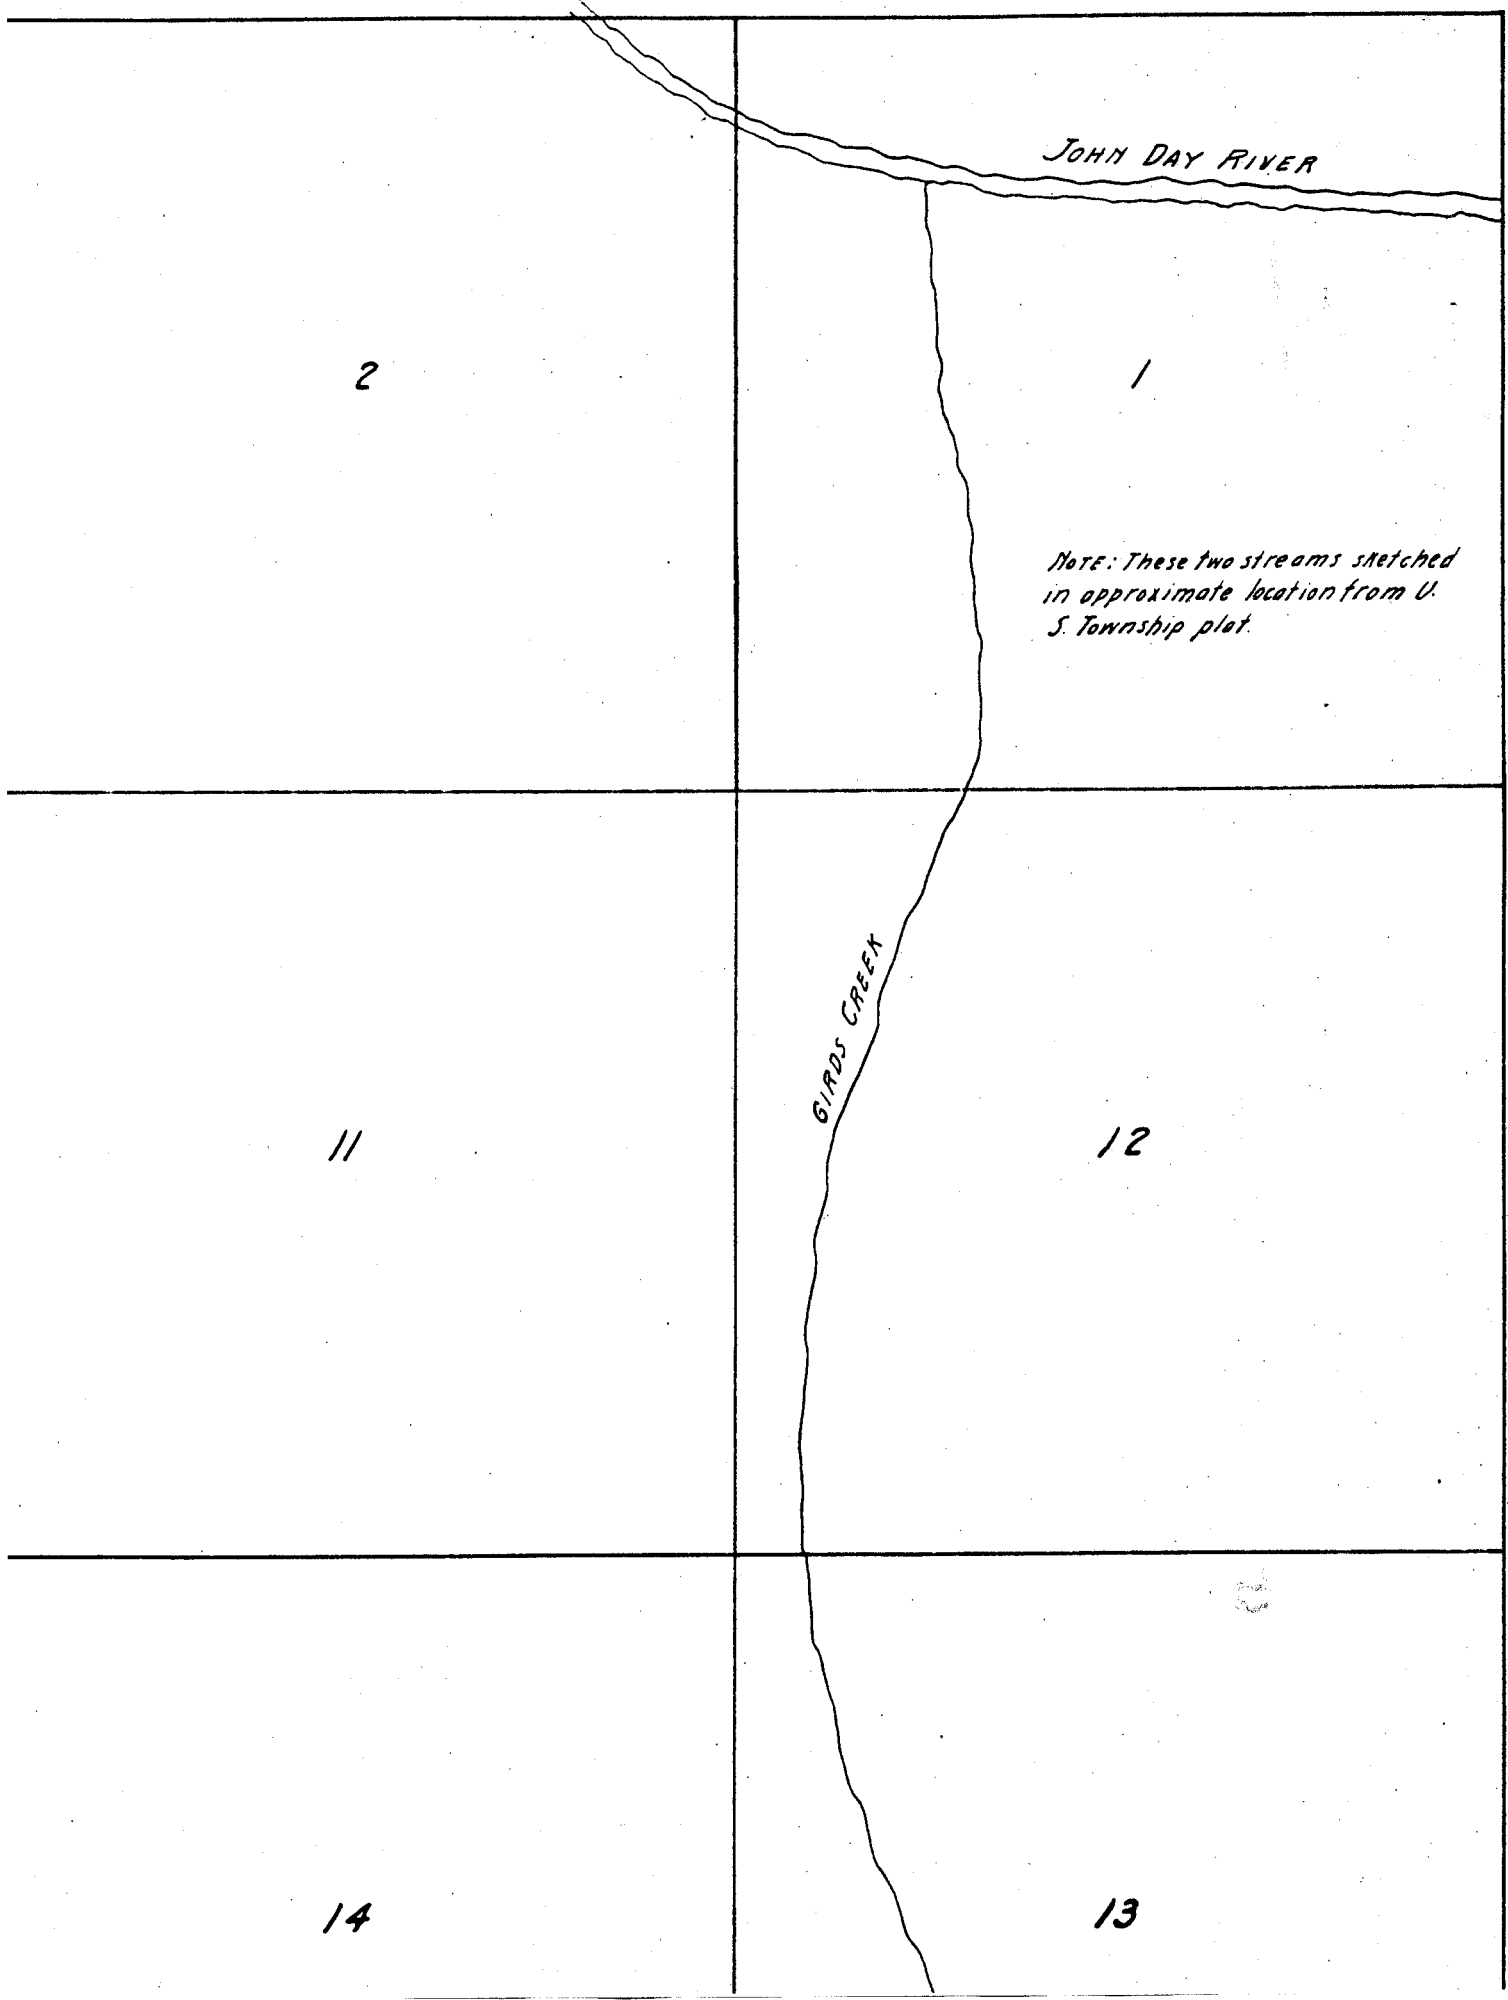

2

1

NOTE: These two streams sketched in approximate location from U. S. Township plat.

11

12

14

13

21

22

28

27

33

34

6

5

7

8

18

17

41 cor

Sec
cor

52

32

Sec 5

Ben Taylor Ranch
Surveyed Oct. 8, 9, 1923

6

96

22

5

20 1/2

42

02

05

122

42

22

92



7

8

18

17

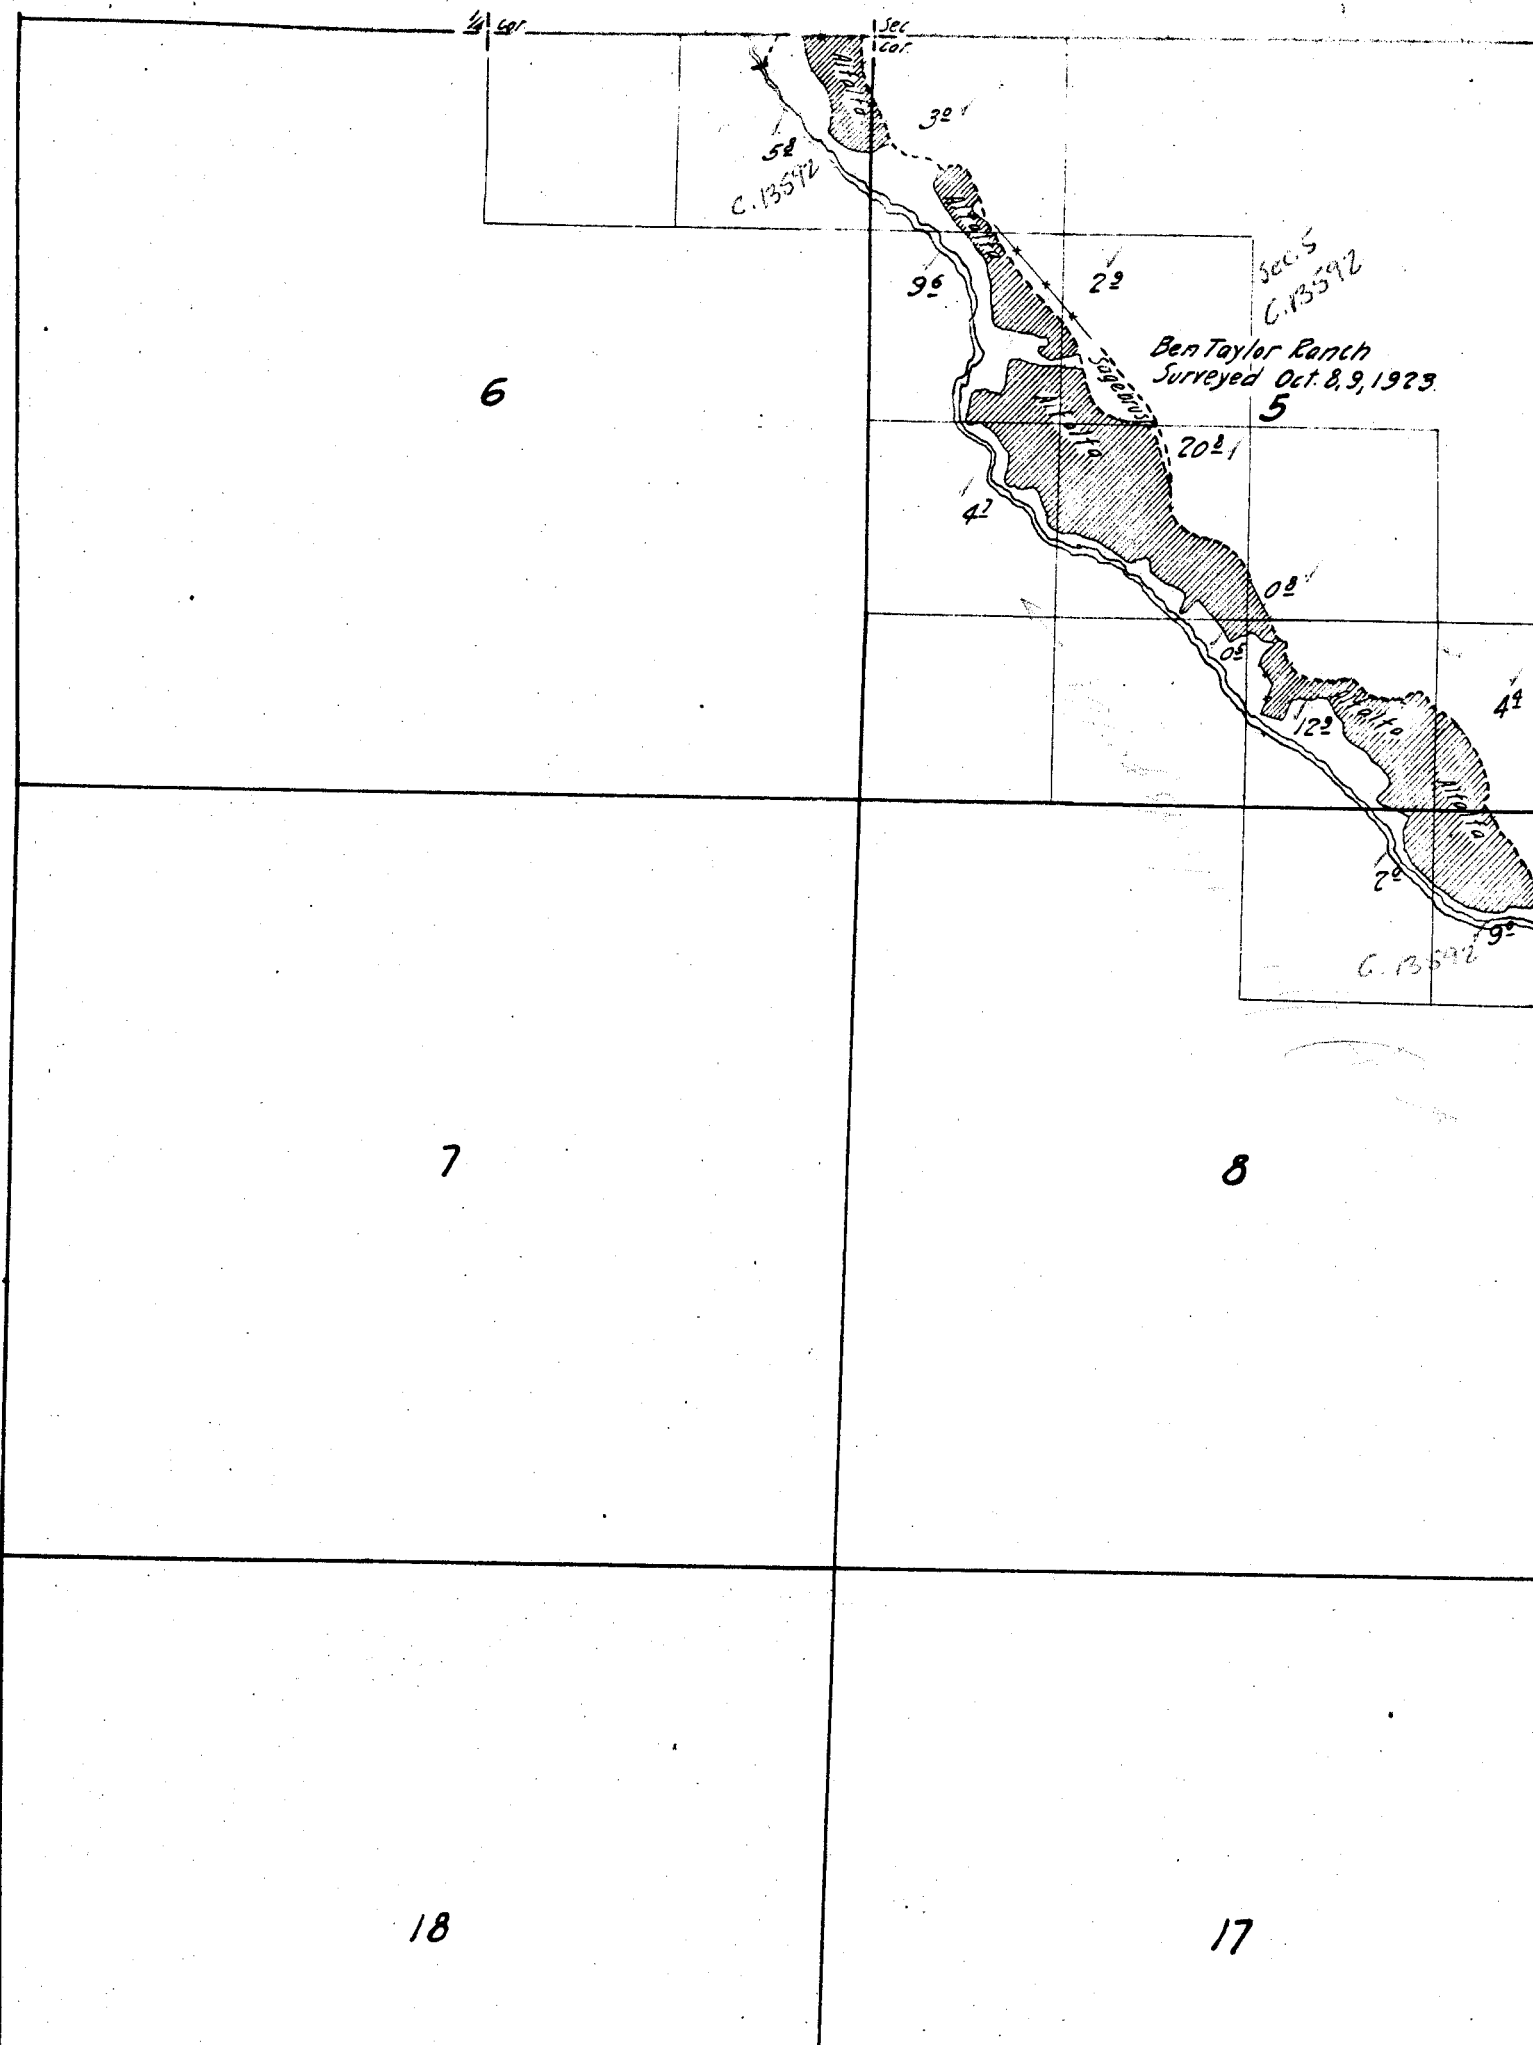

E.

6-1-1

2

1

11

12

14

13

22

Surveyed Nov. 3, 1923.
House
Flume
1/4 cor.

1st P. 5718
2nd P. 5718
Sec. cor.

L. L. Jones Ranch
Surveyed Nov. 8, 9, 1923.

28

27


Jones ditch #6
10⁰
16
10⁰
45
GABLE CREEK
52
C. 13570

17⁰

33

34

7⁰
6⁰
2⁰

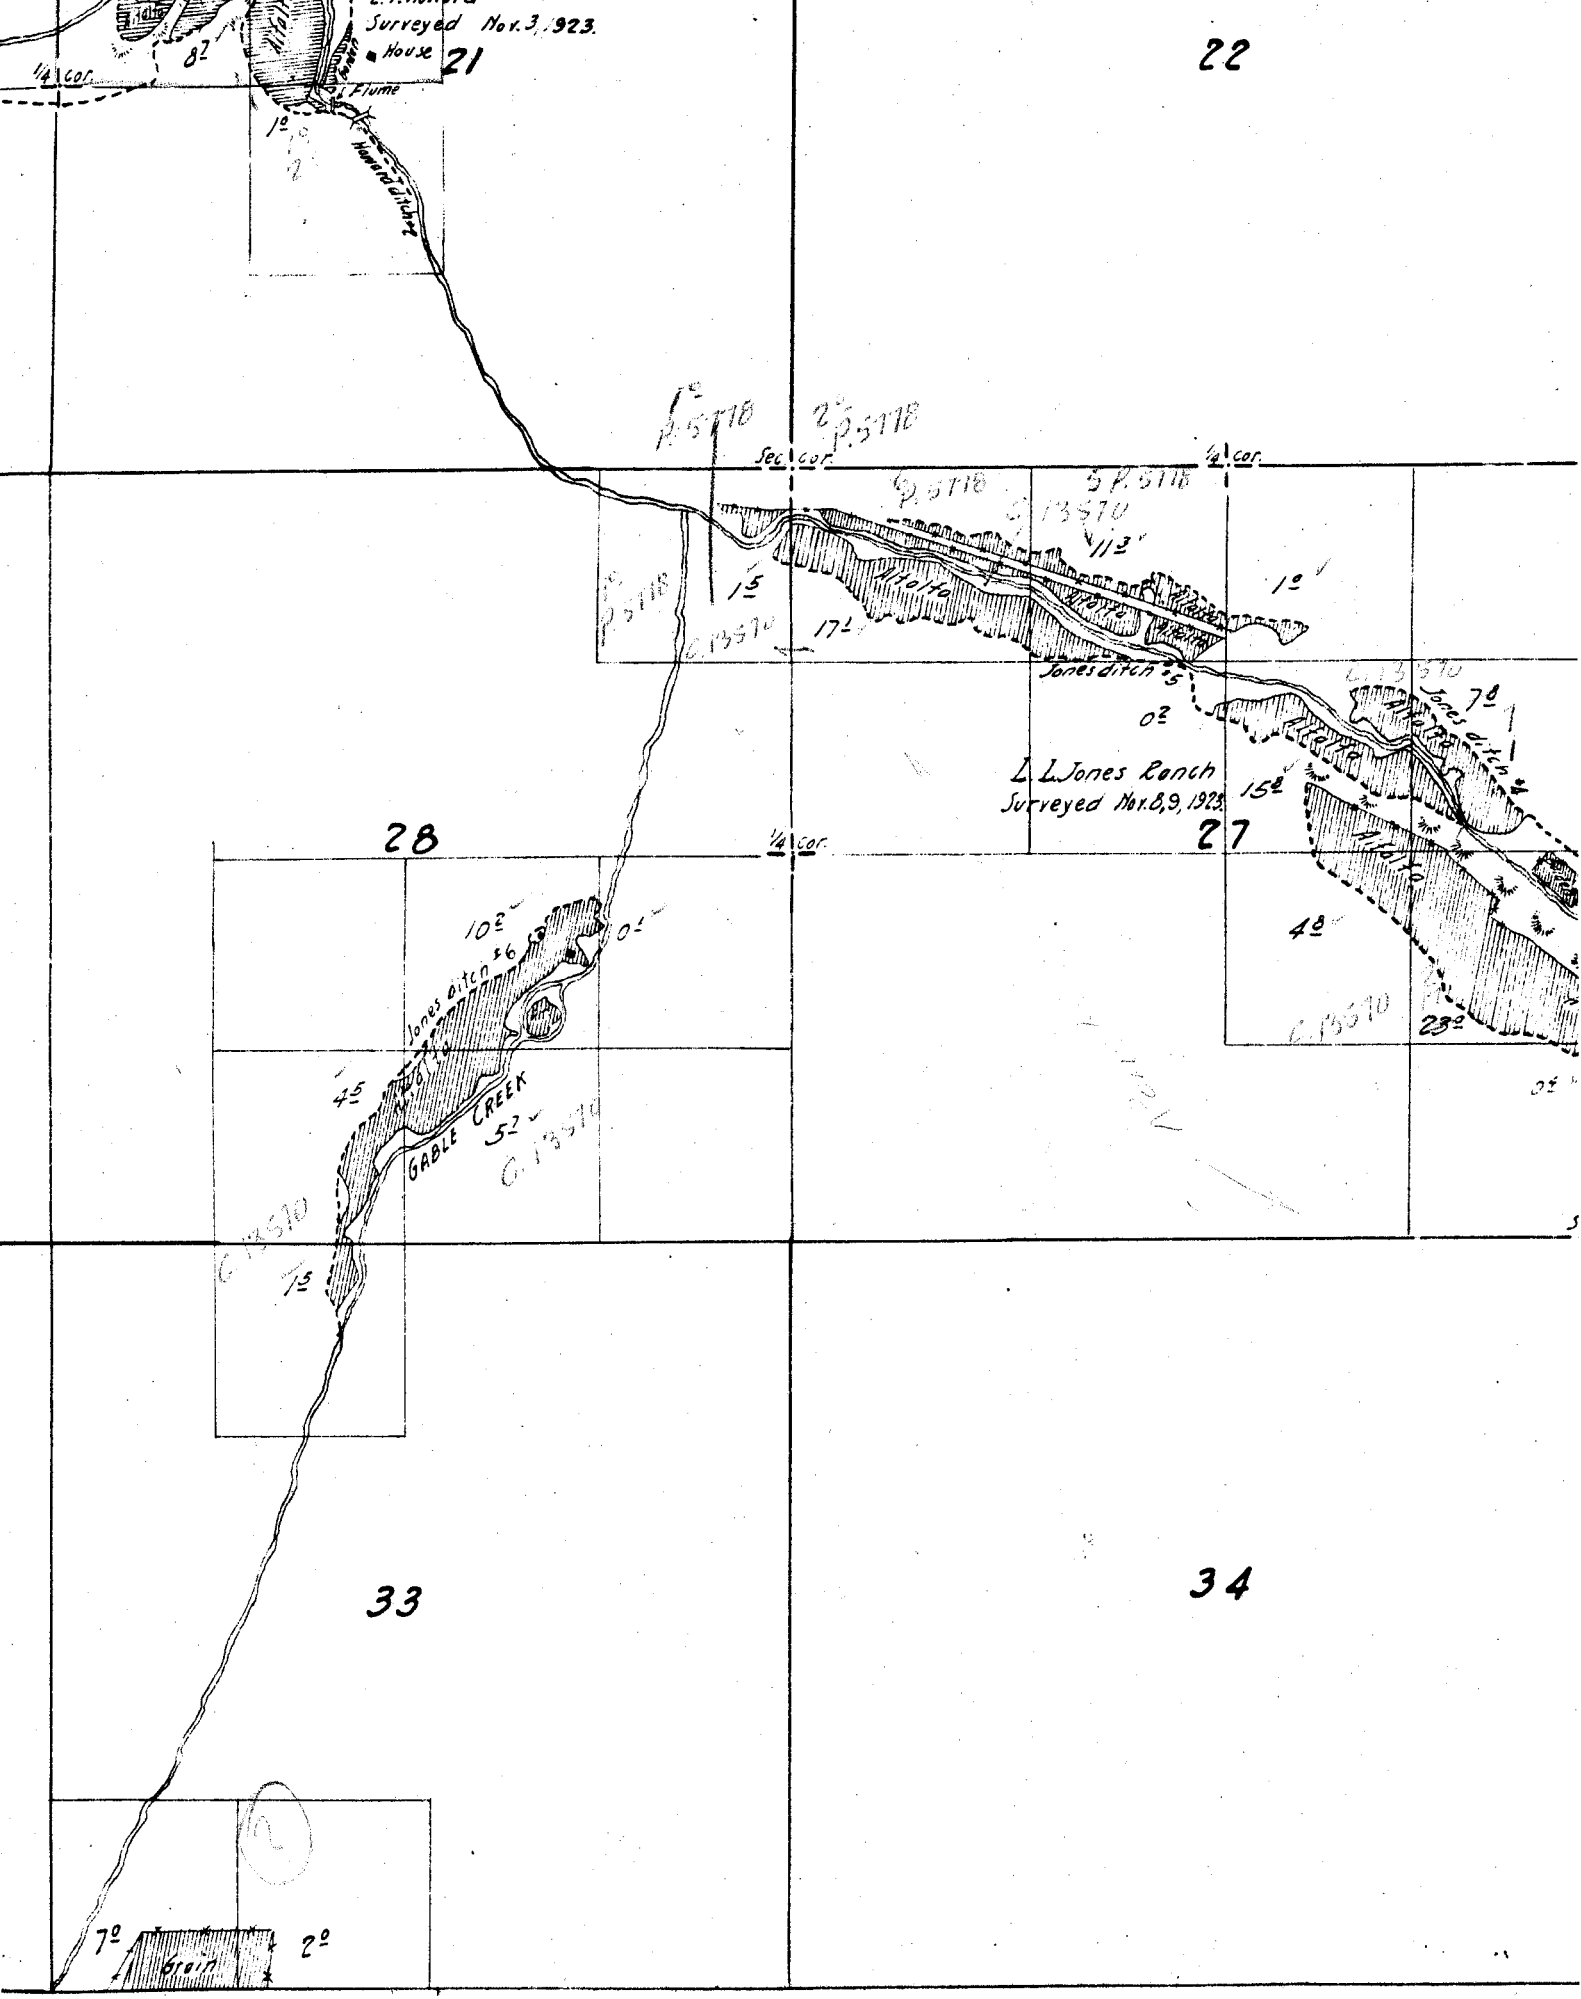


Township

11 S,

Range

21 E.

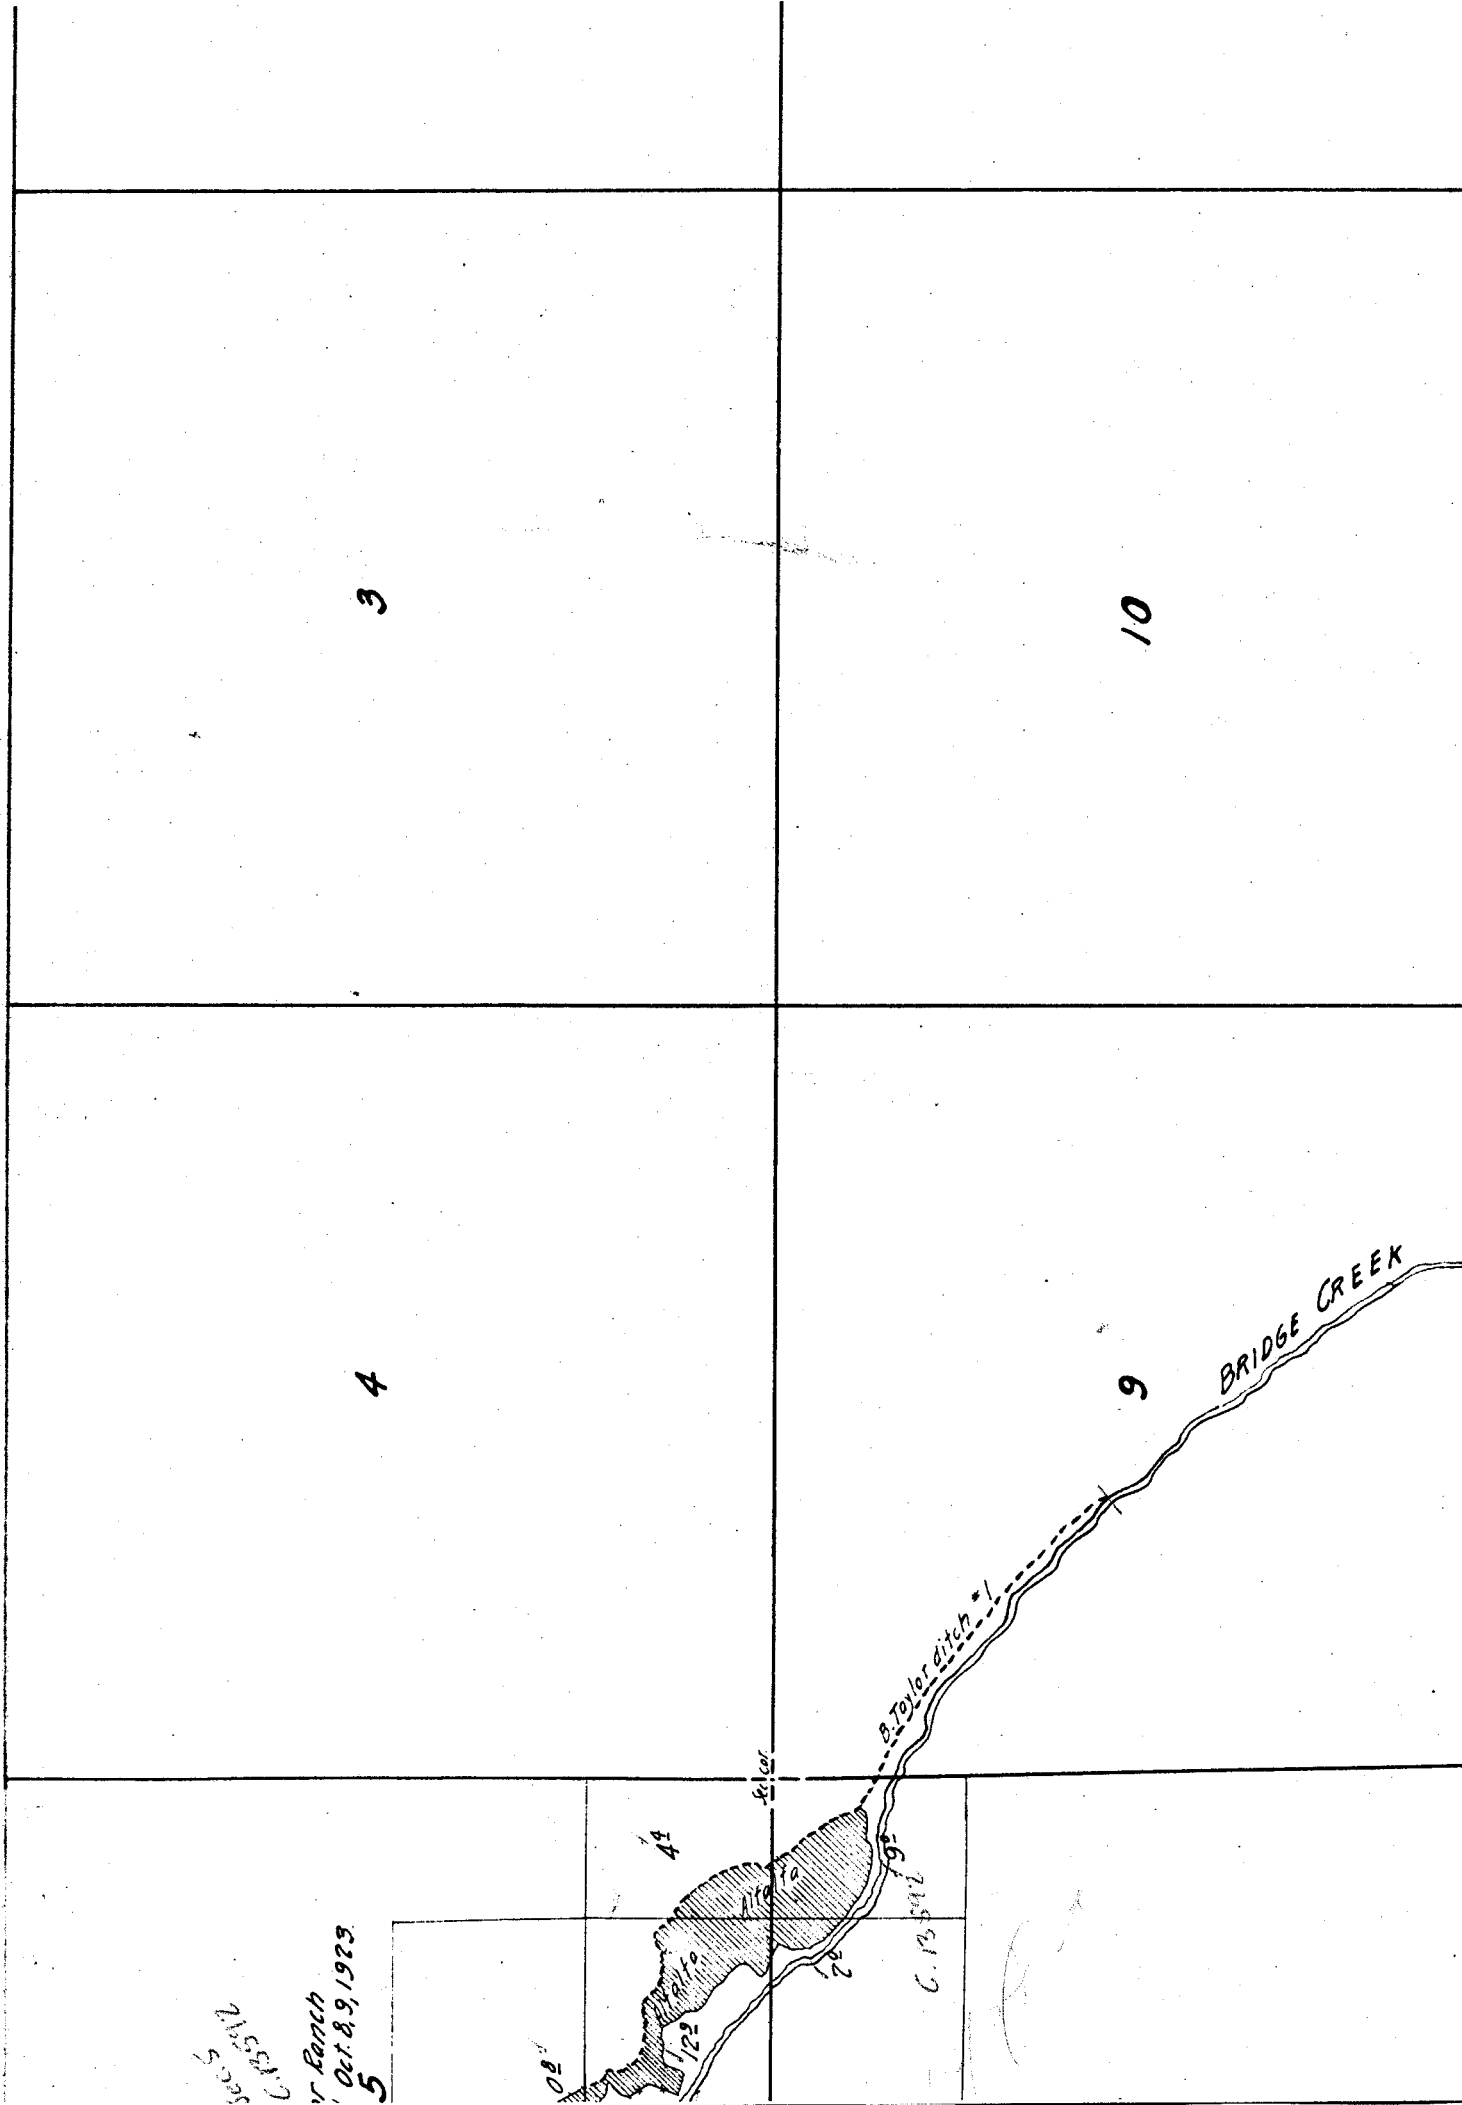

Sec 5
13592
V. Ranch
Oct. 8, 9, 1923
5

122
121
C. 13592

BRIDGE CREEK

B. Taylor ditch #1

E. car

3

10

4

9

15


22

Note: Creeks partly sketched in approximate location from U.S. Township plot.

16



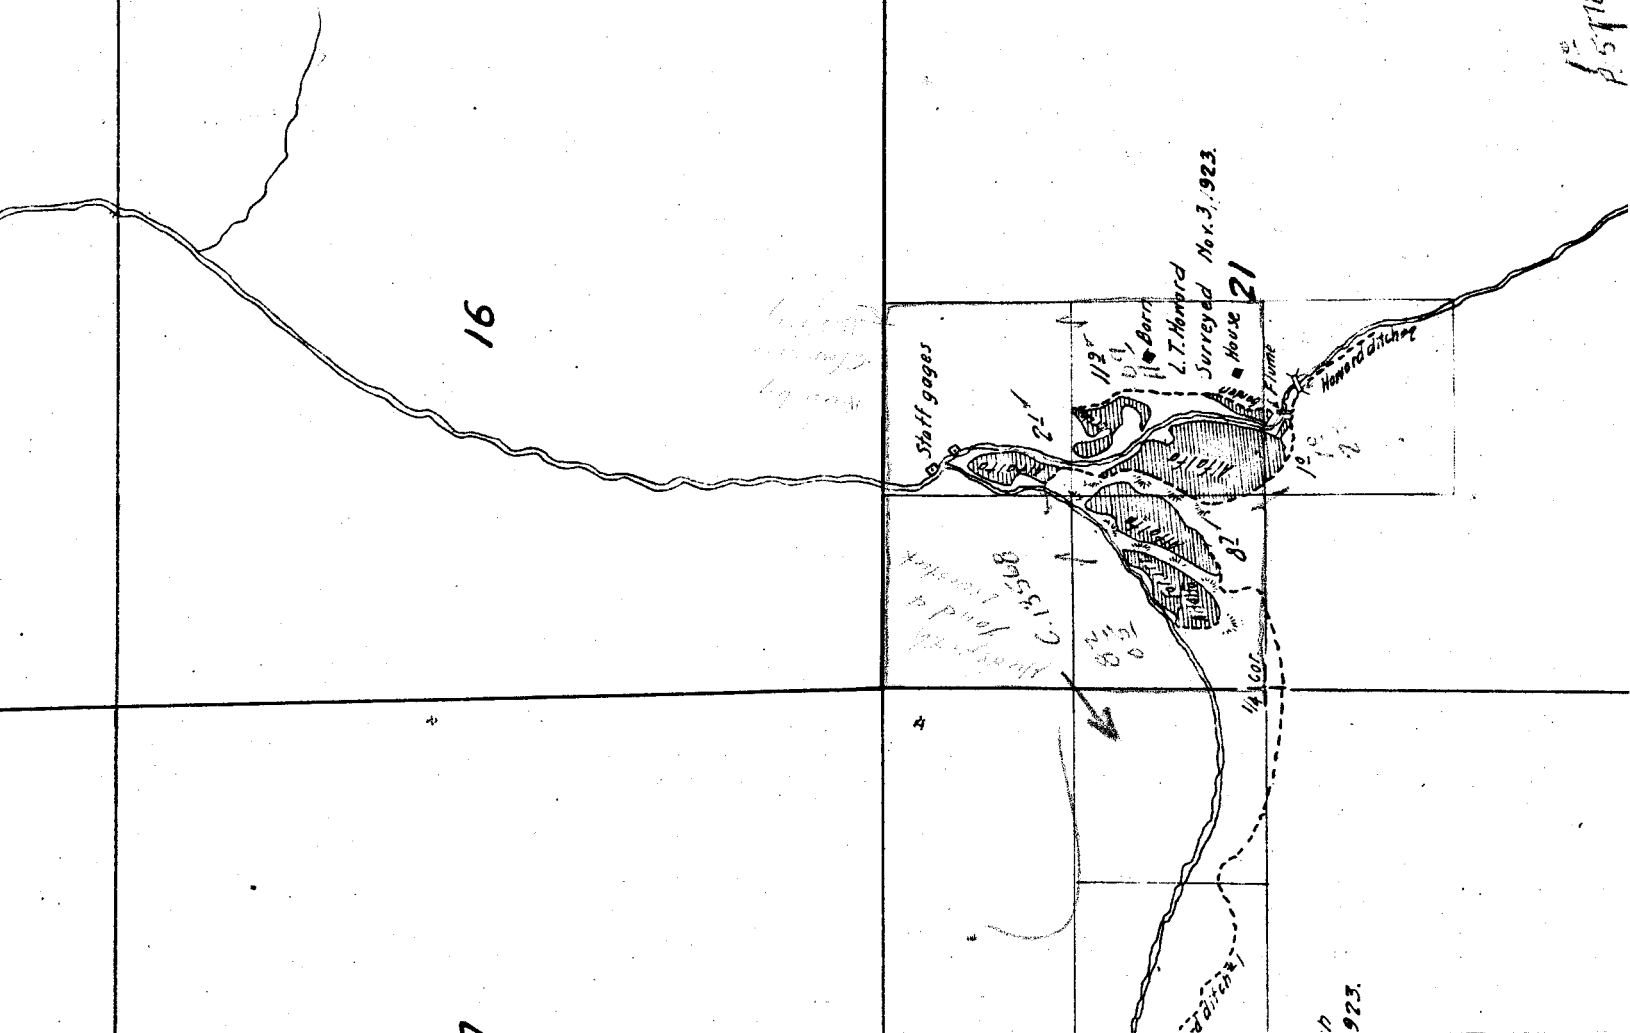

Handwritten note: L.T. Howard Surveyed Nov. 3, 1923

Stiff gages

L.T. Howard Surveyed Nov. 3, 1923

House 21

923

13

24

14


23

15

22

*'s partly sketched in approximate
from U.S. Township plot.*

41.60
58 5776

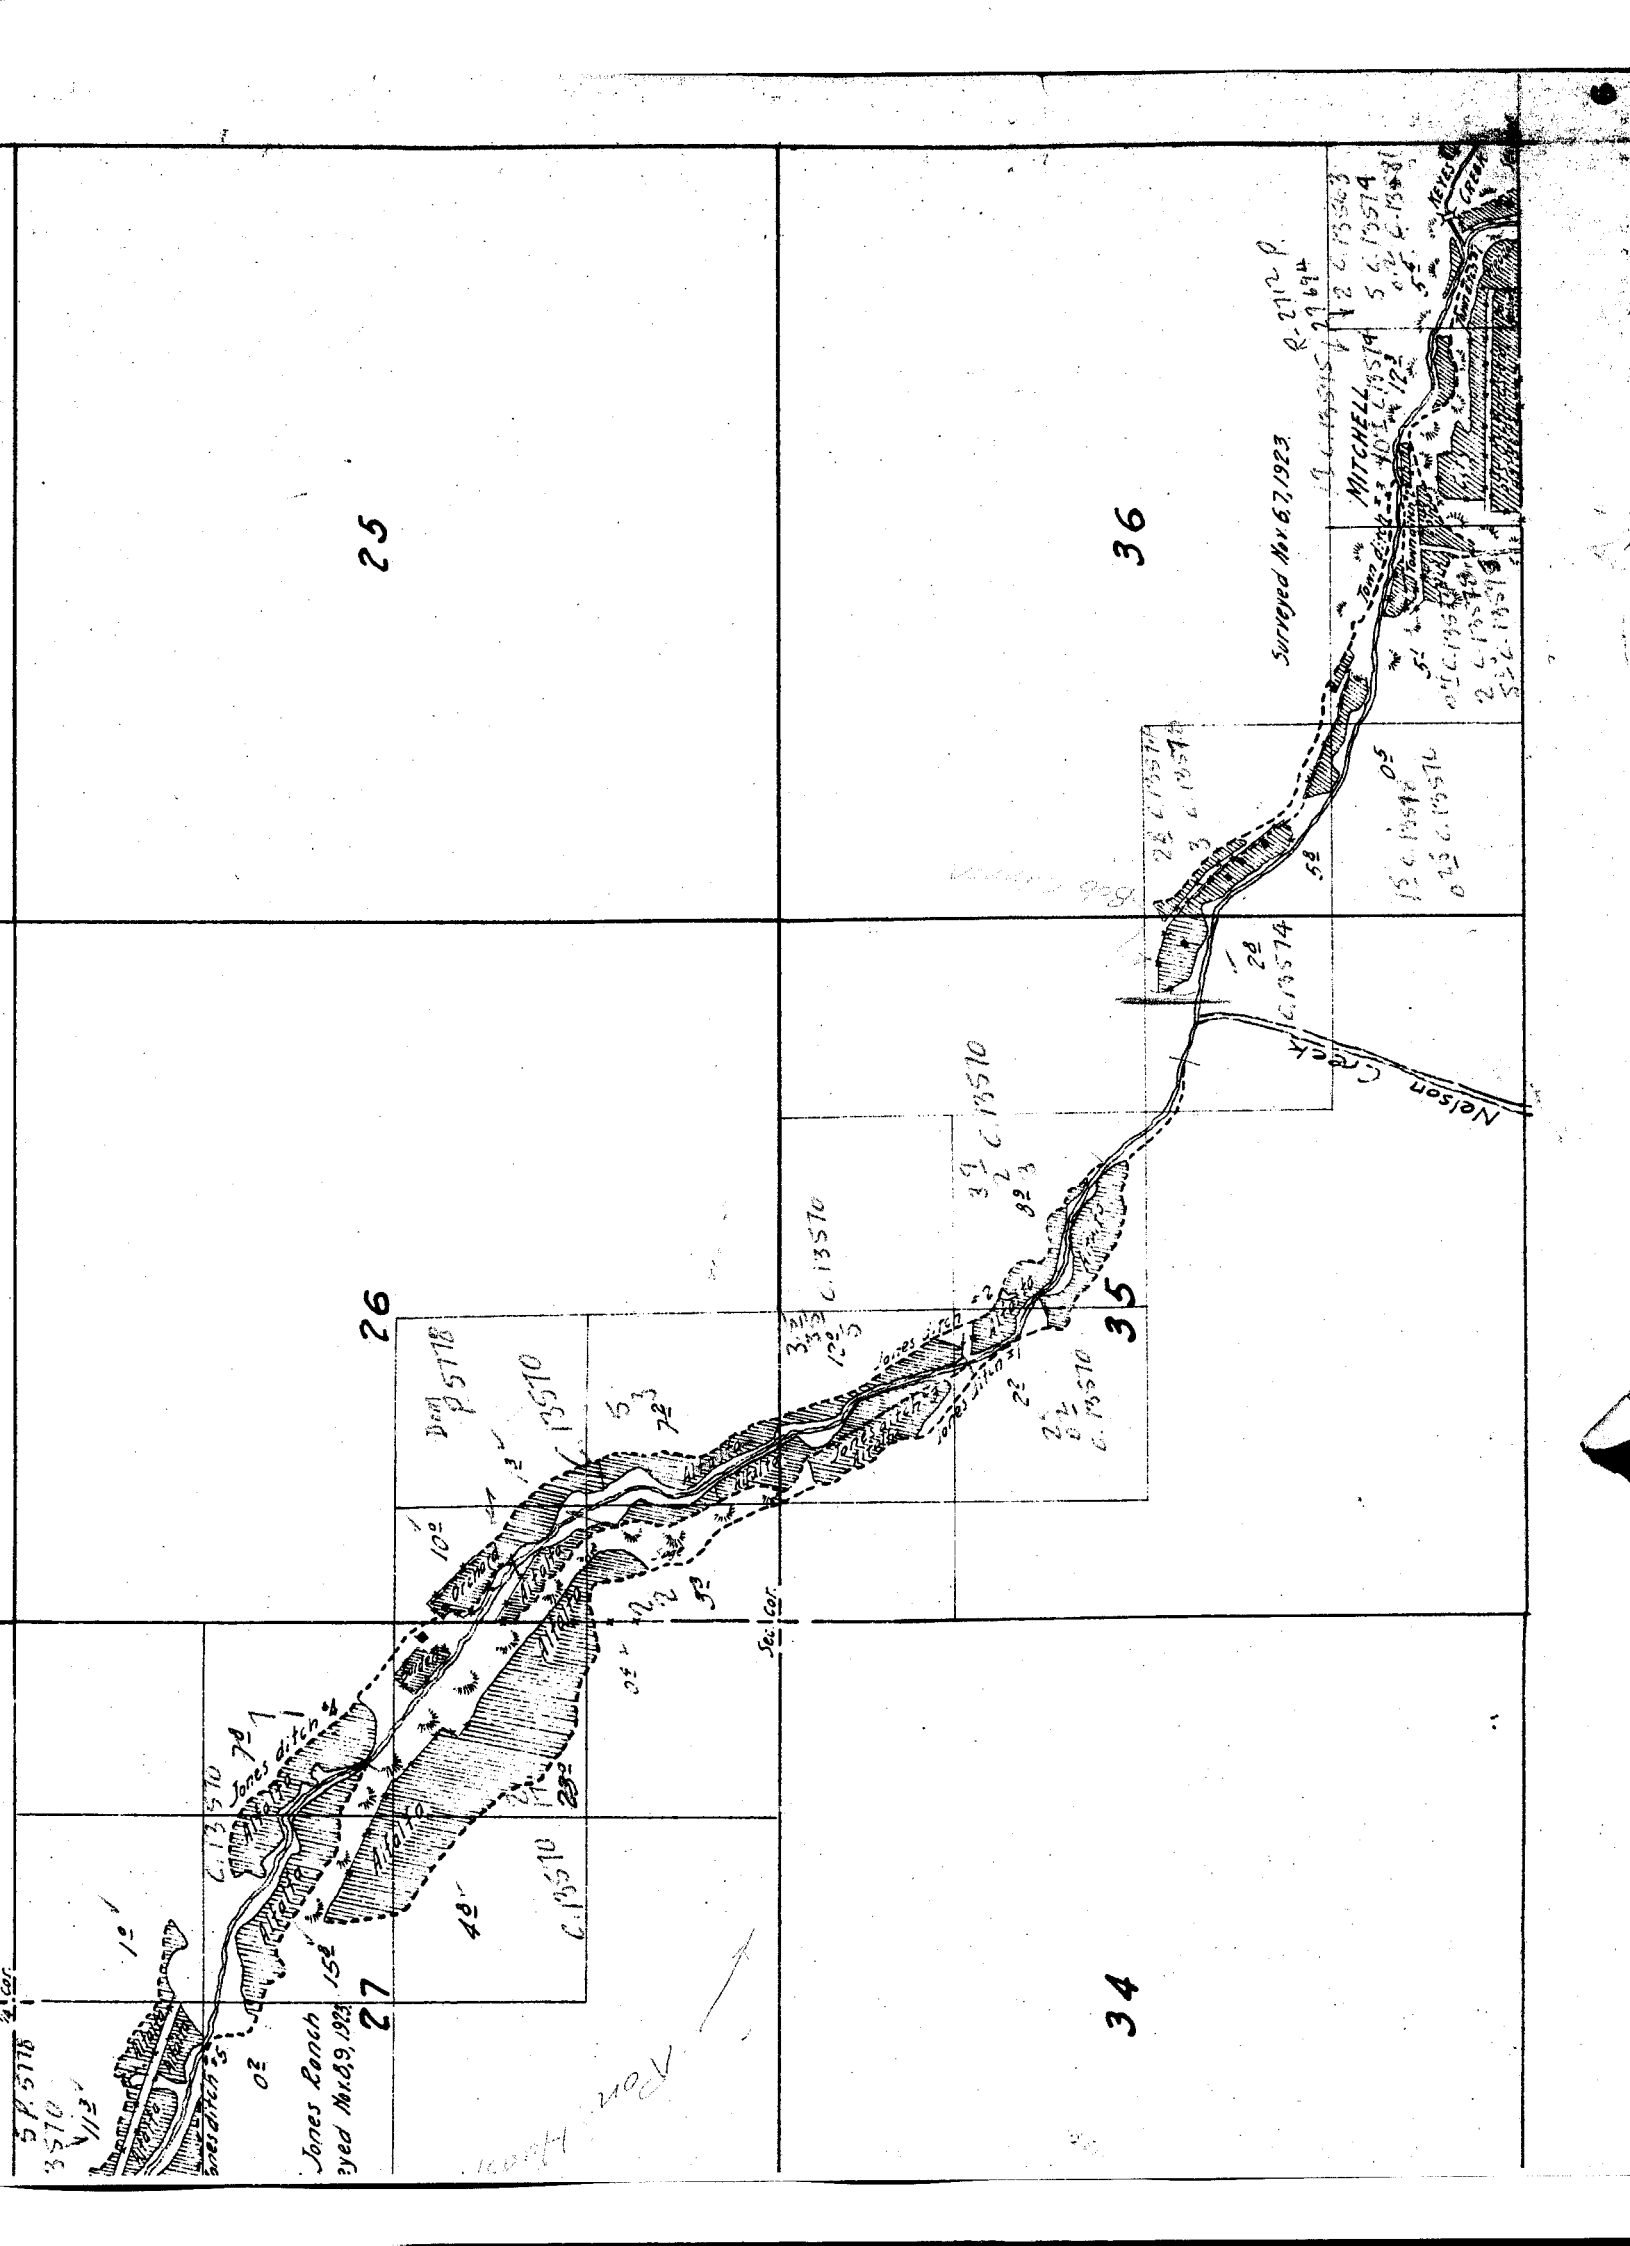

25

36

26

35

27

34

5 P. 5718
3570
113
Jones Ranch

R-212 P.
MITCHELL

Nelson Creek

From House

X 10 4335

30


29

28



31

32

33

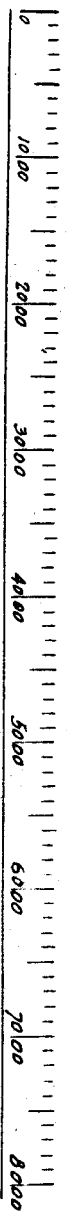


Scale of feet

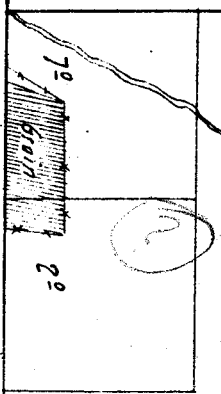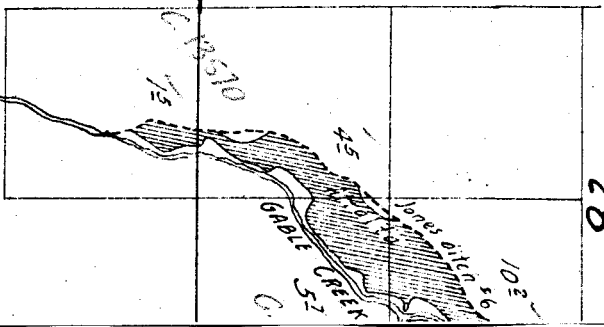

18

17

16

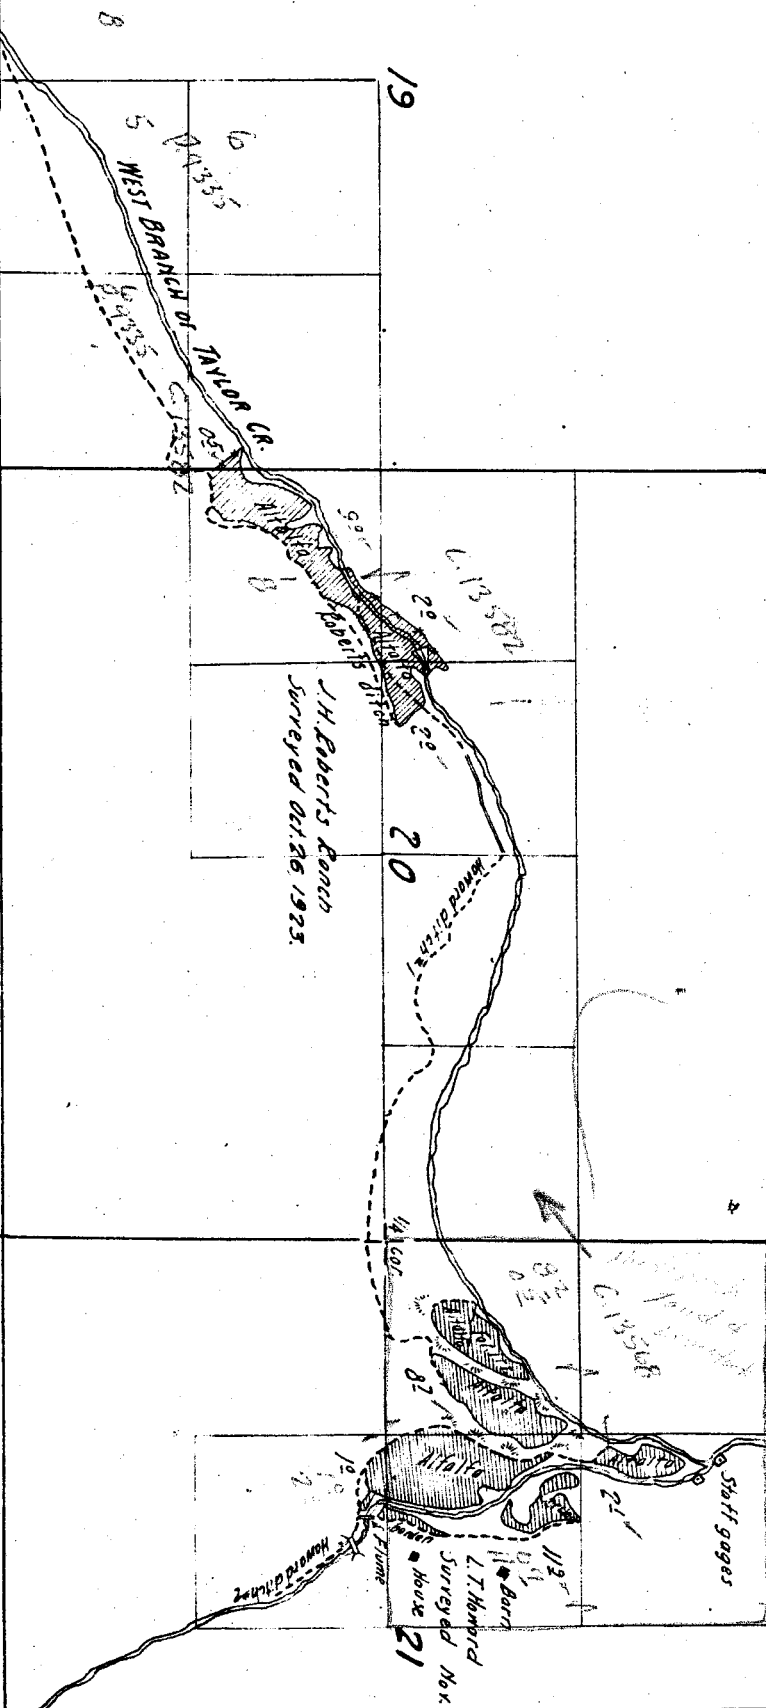

19

20

21

8

6
135.5'


H. Roberts Ranch
Surveyed Oct. 26, 1925.





Staff gages
C. 18508

house
Surveyed Nov


