


Township

10 S,

Range

20 E.

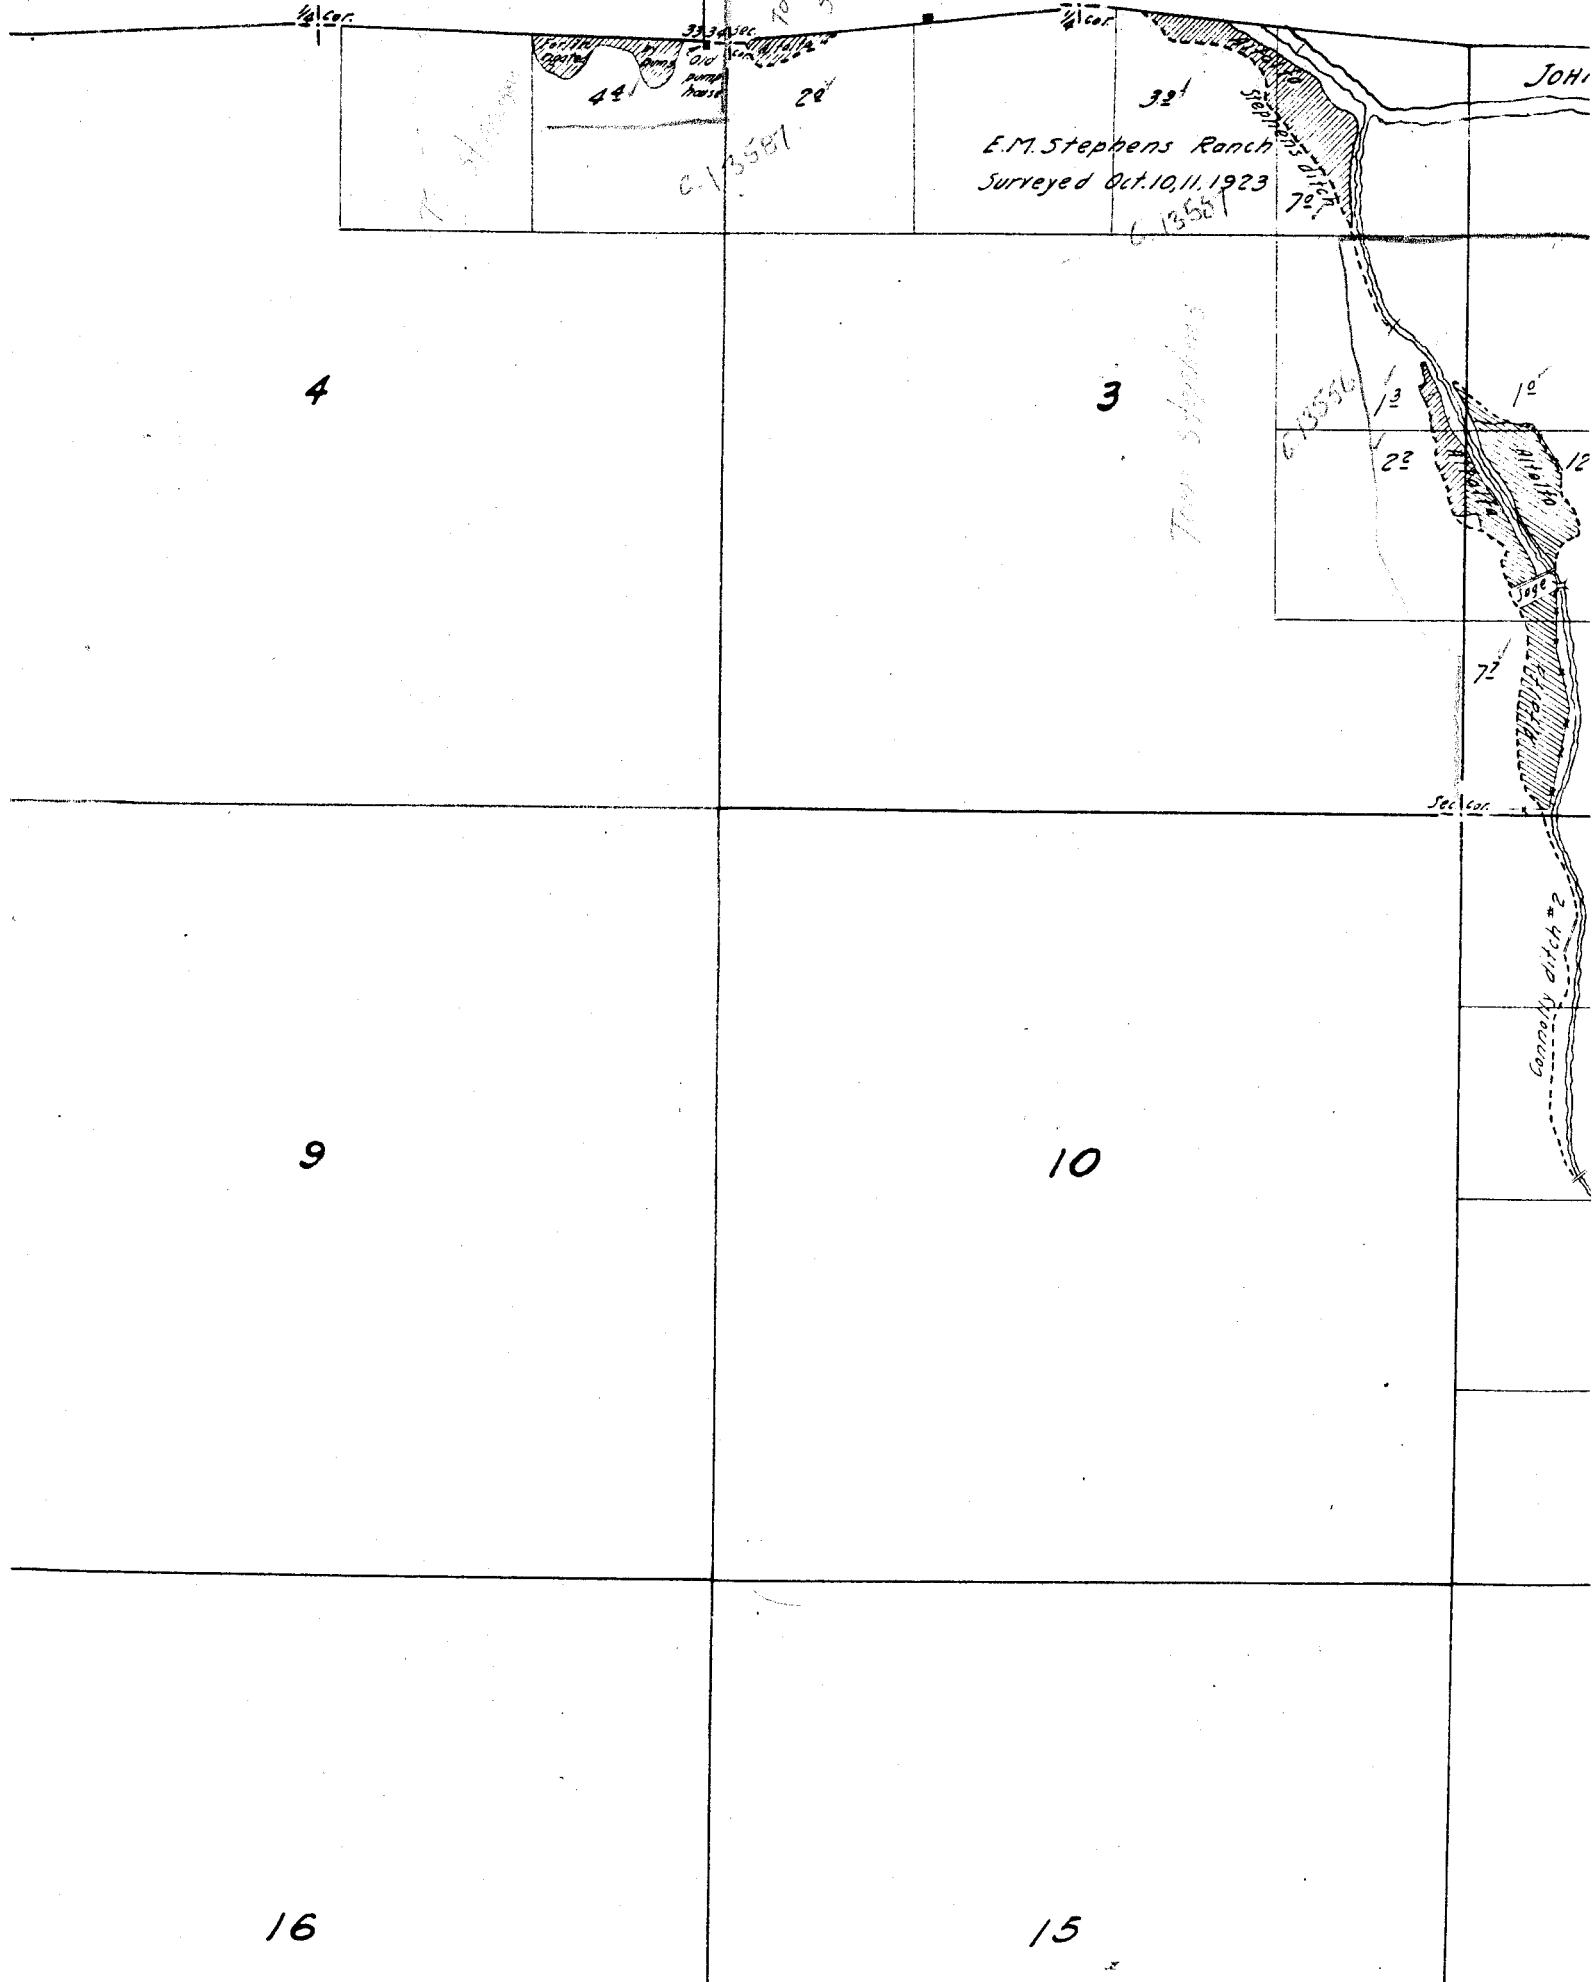

15

22

16

12

17

20

27

34

28


33

29

32

Township

1/4 Sec.

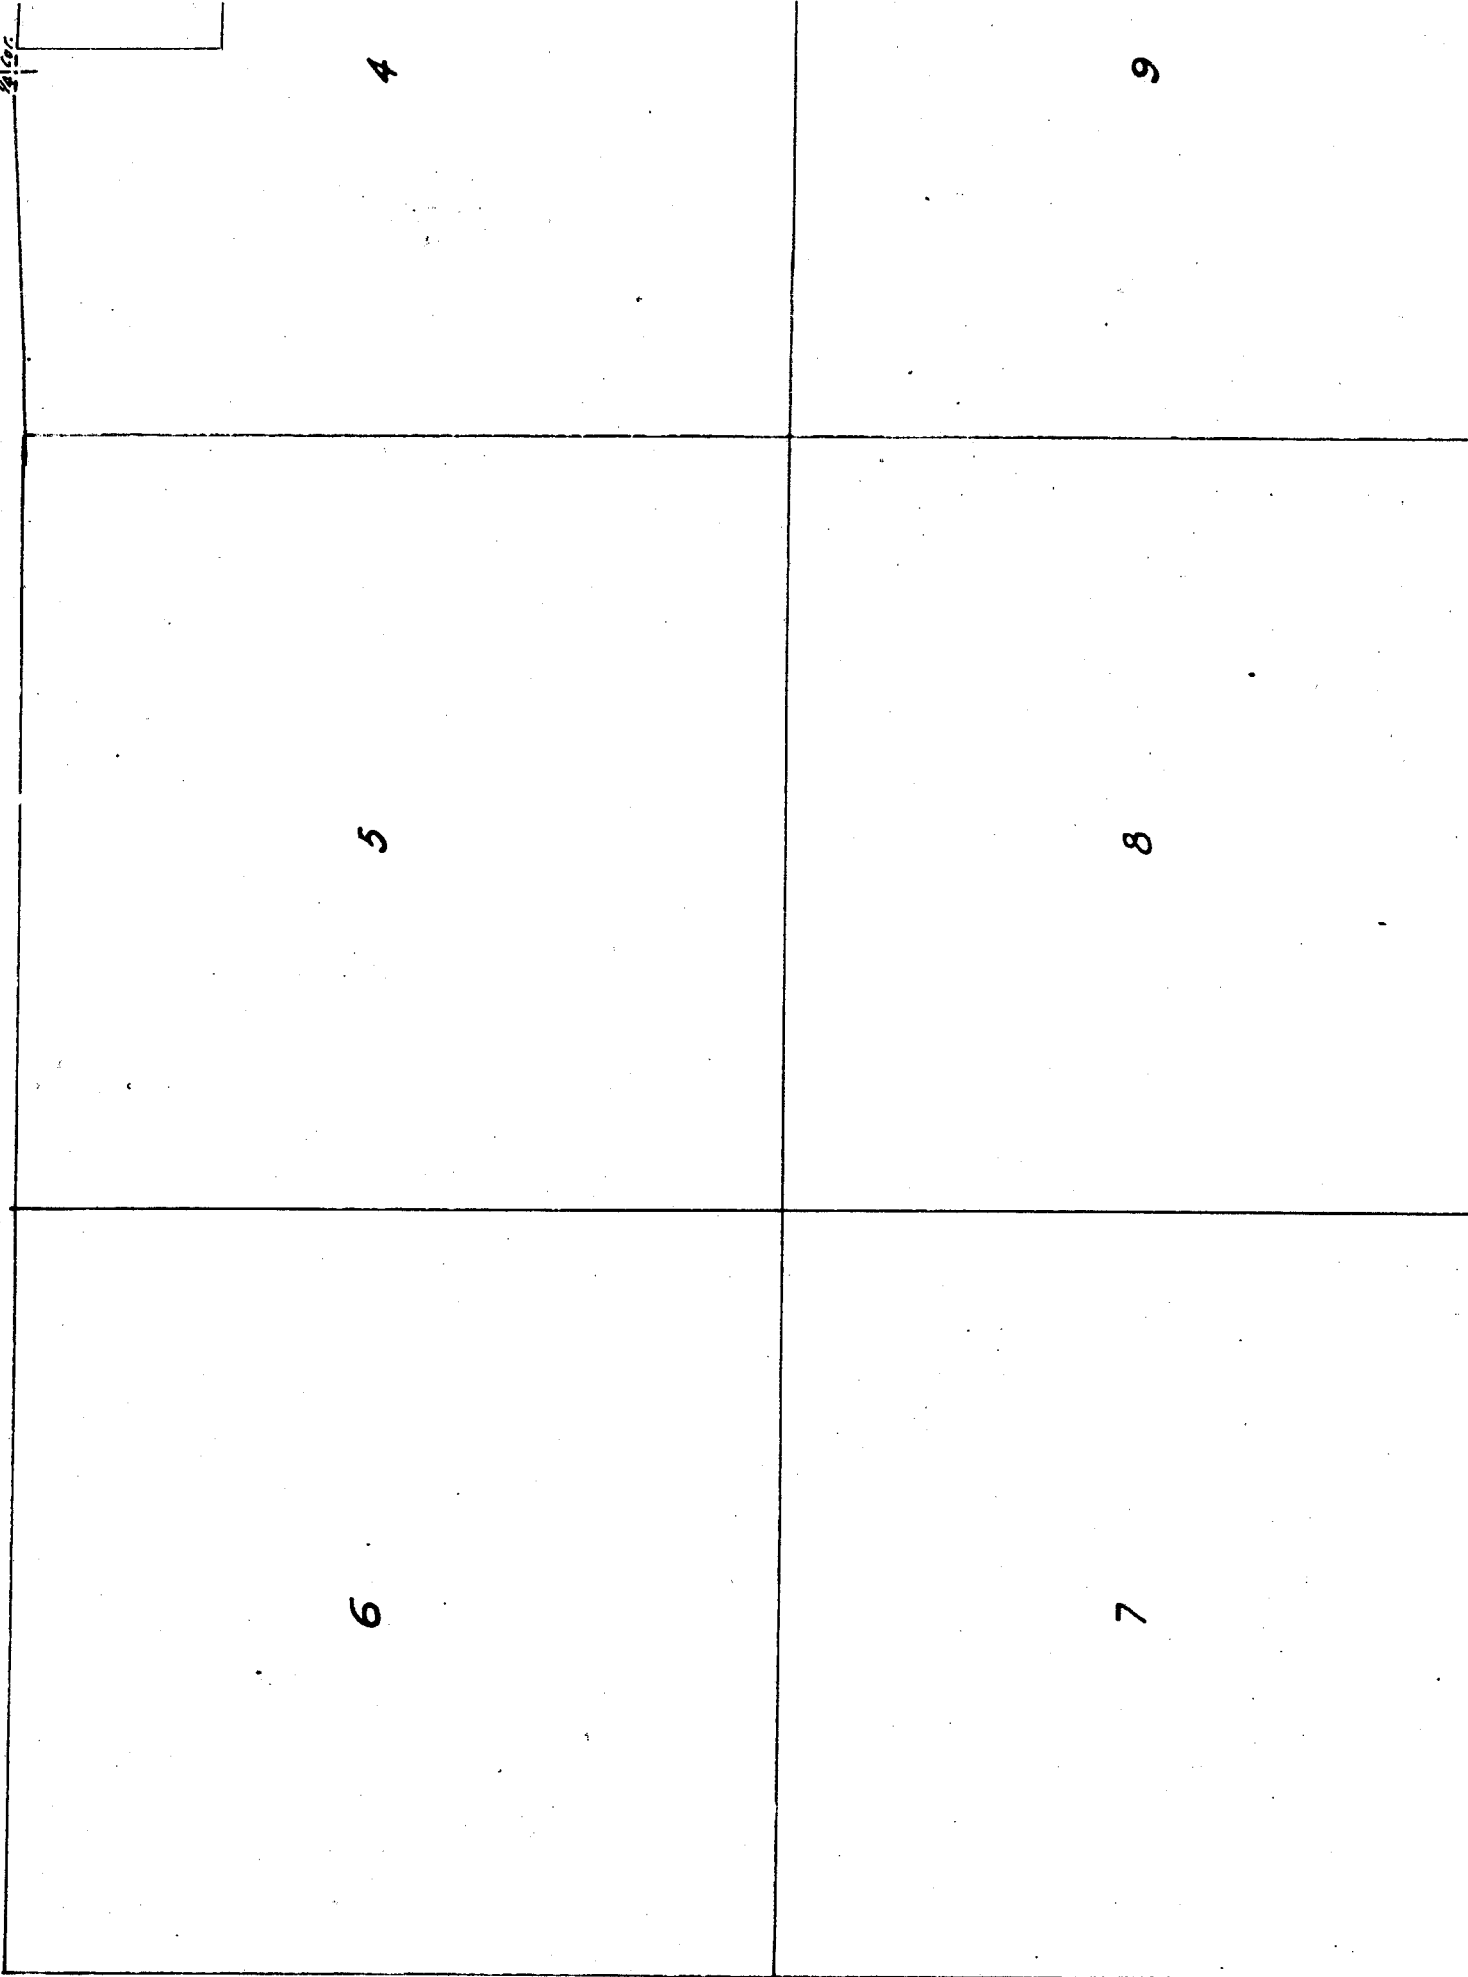

4

9

5

8

6

7

12

20

19

16

17

18

19

20

30

29

31

32

Ben Taylor Ranch
Surveyed Oct. 9, 1923. 191

23

24

C. 13575

53



12
C. 13591

133
C. 13593

Section

183
C. 13591

183
C. 13593

Ben Taylor Ranch
Surveyed Oct. 5, 8, 9, 1923

43

103
C. 13593

26

33
C. 13591

133
C. 13593

103

63


BEAR CREEK

35

36

Witness tree


C. 13593

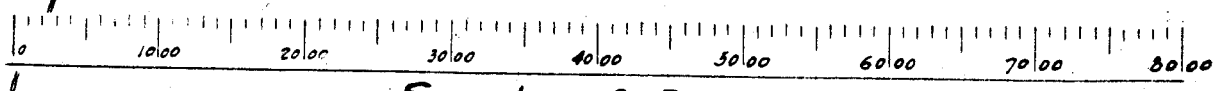

Scale of Feet

Range 20 E.

2-1-1

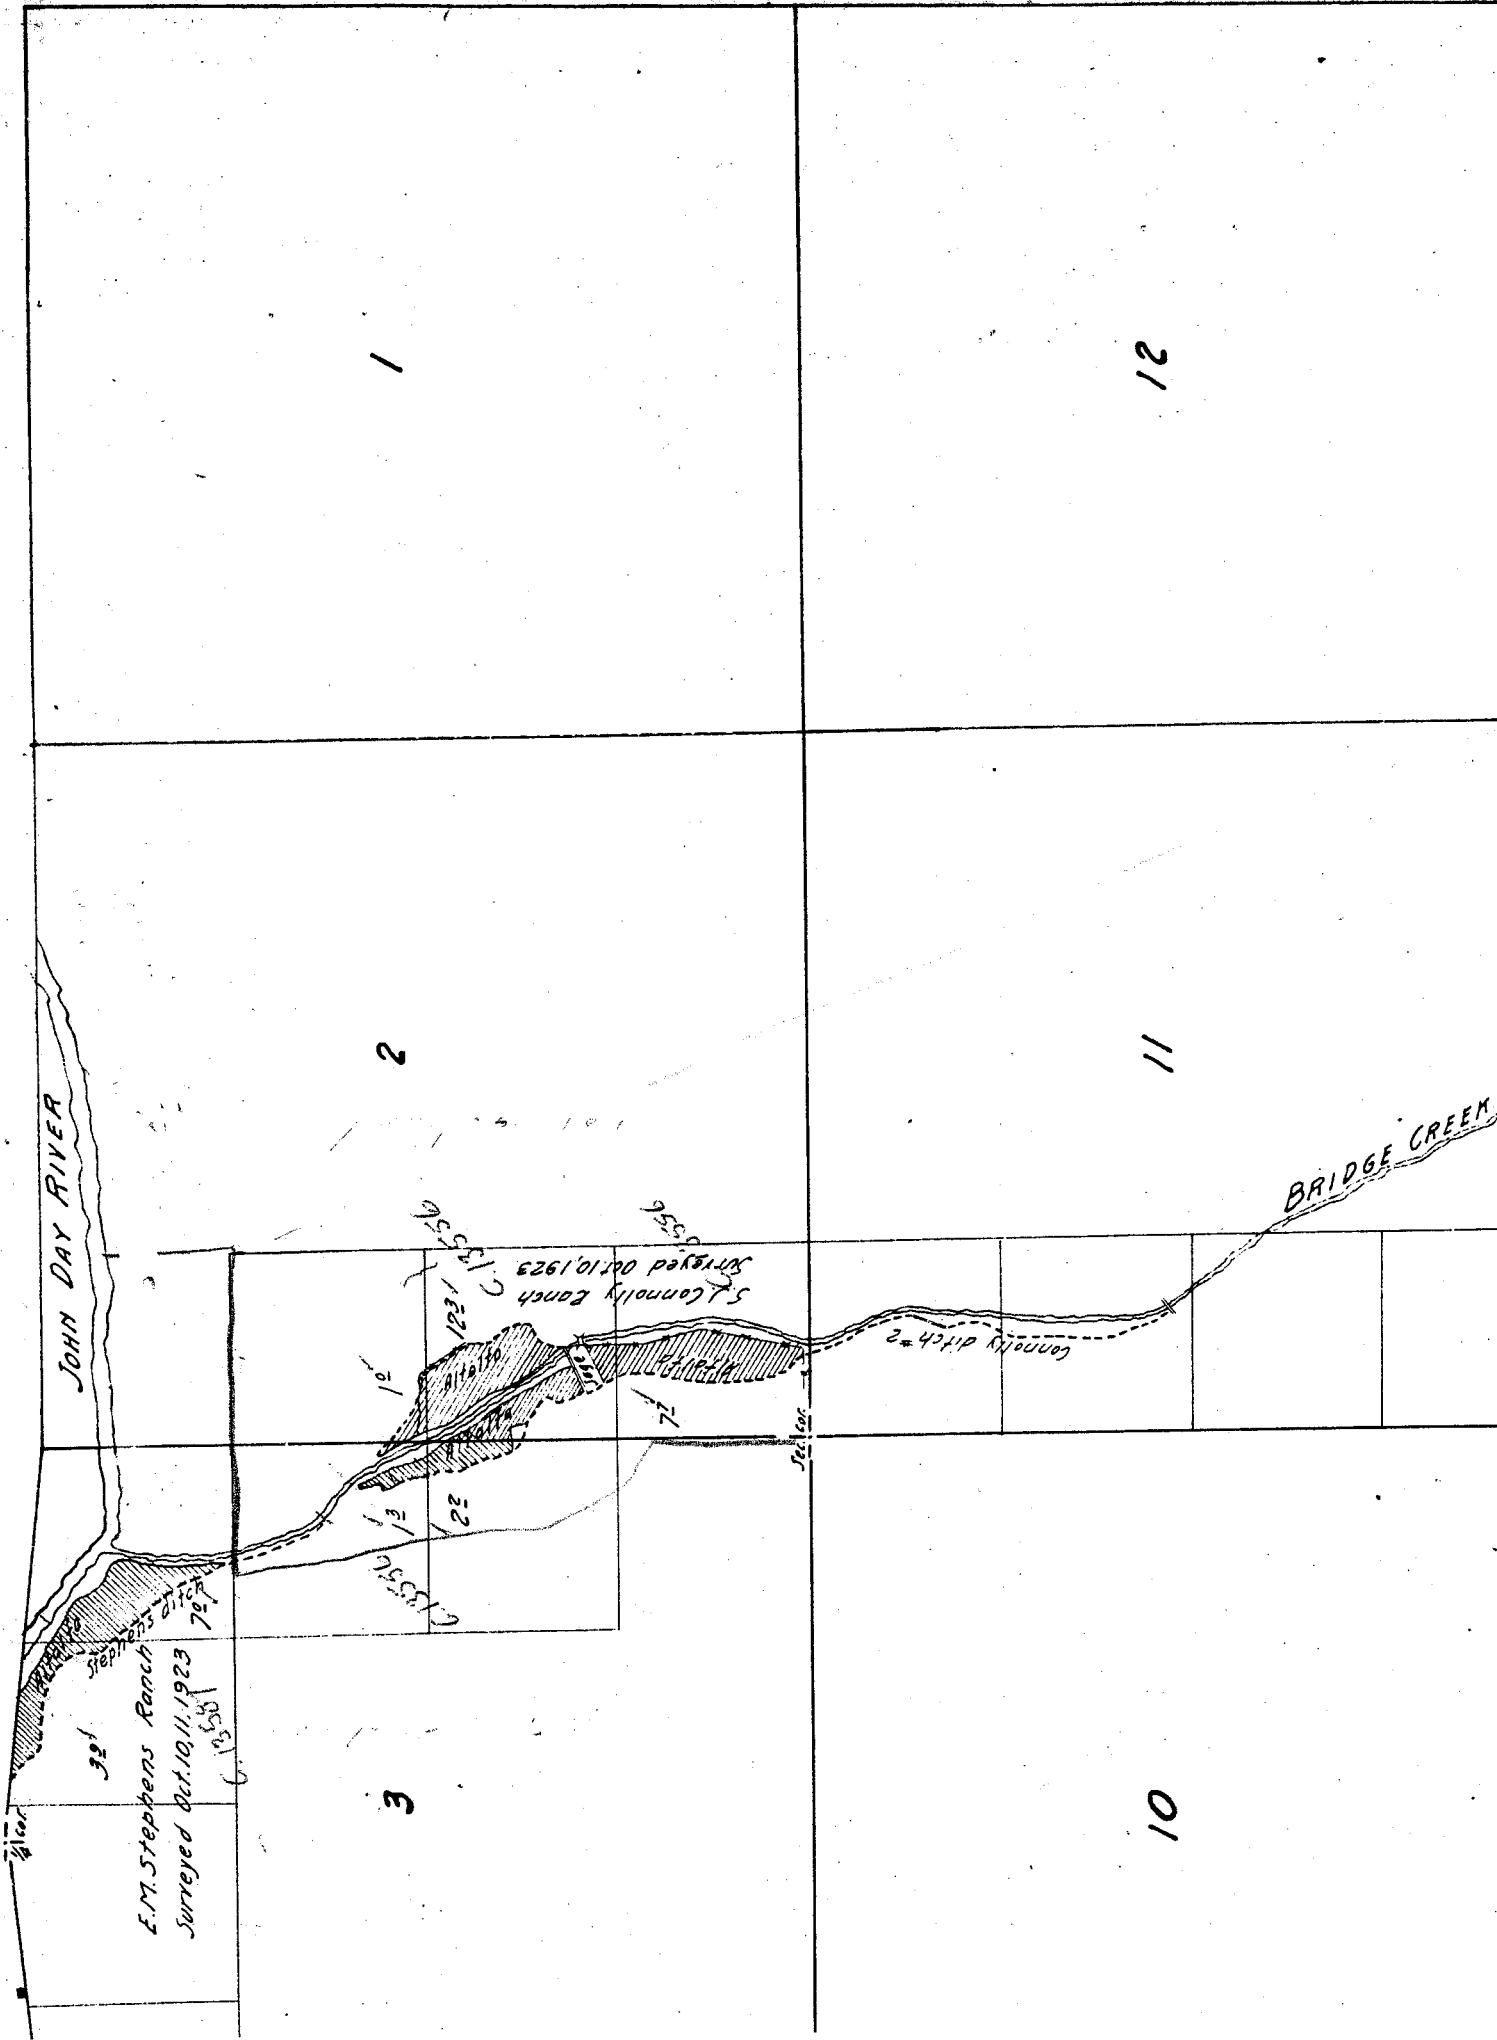

6

5

7

8

18

17

21


22

28

27

33

34

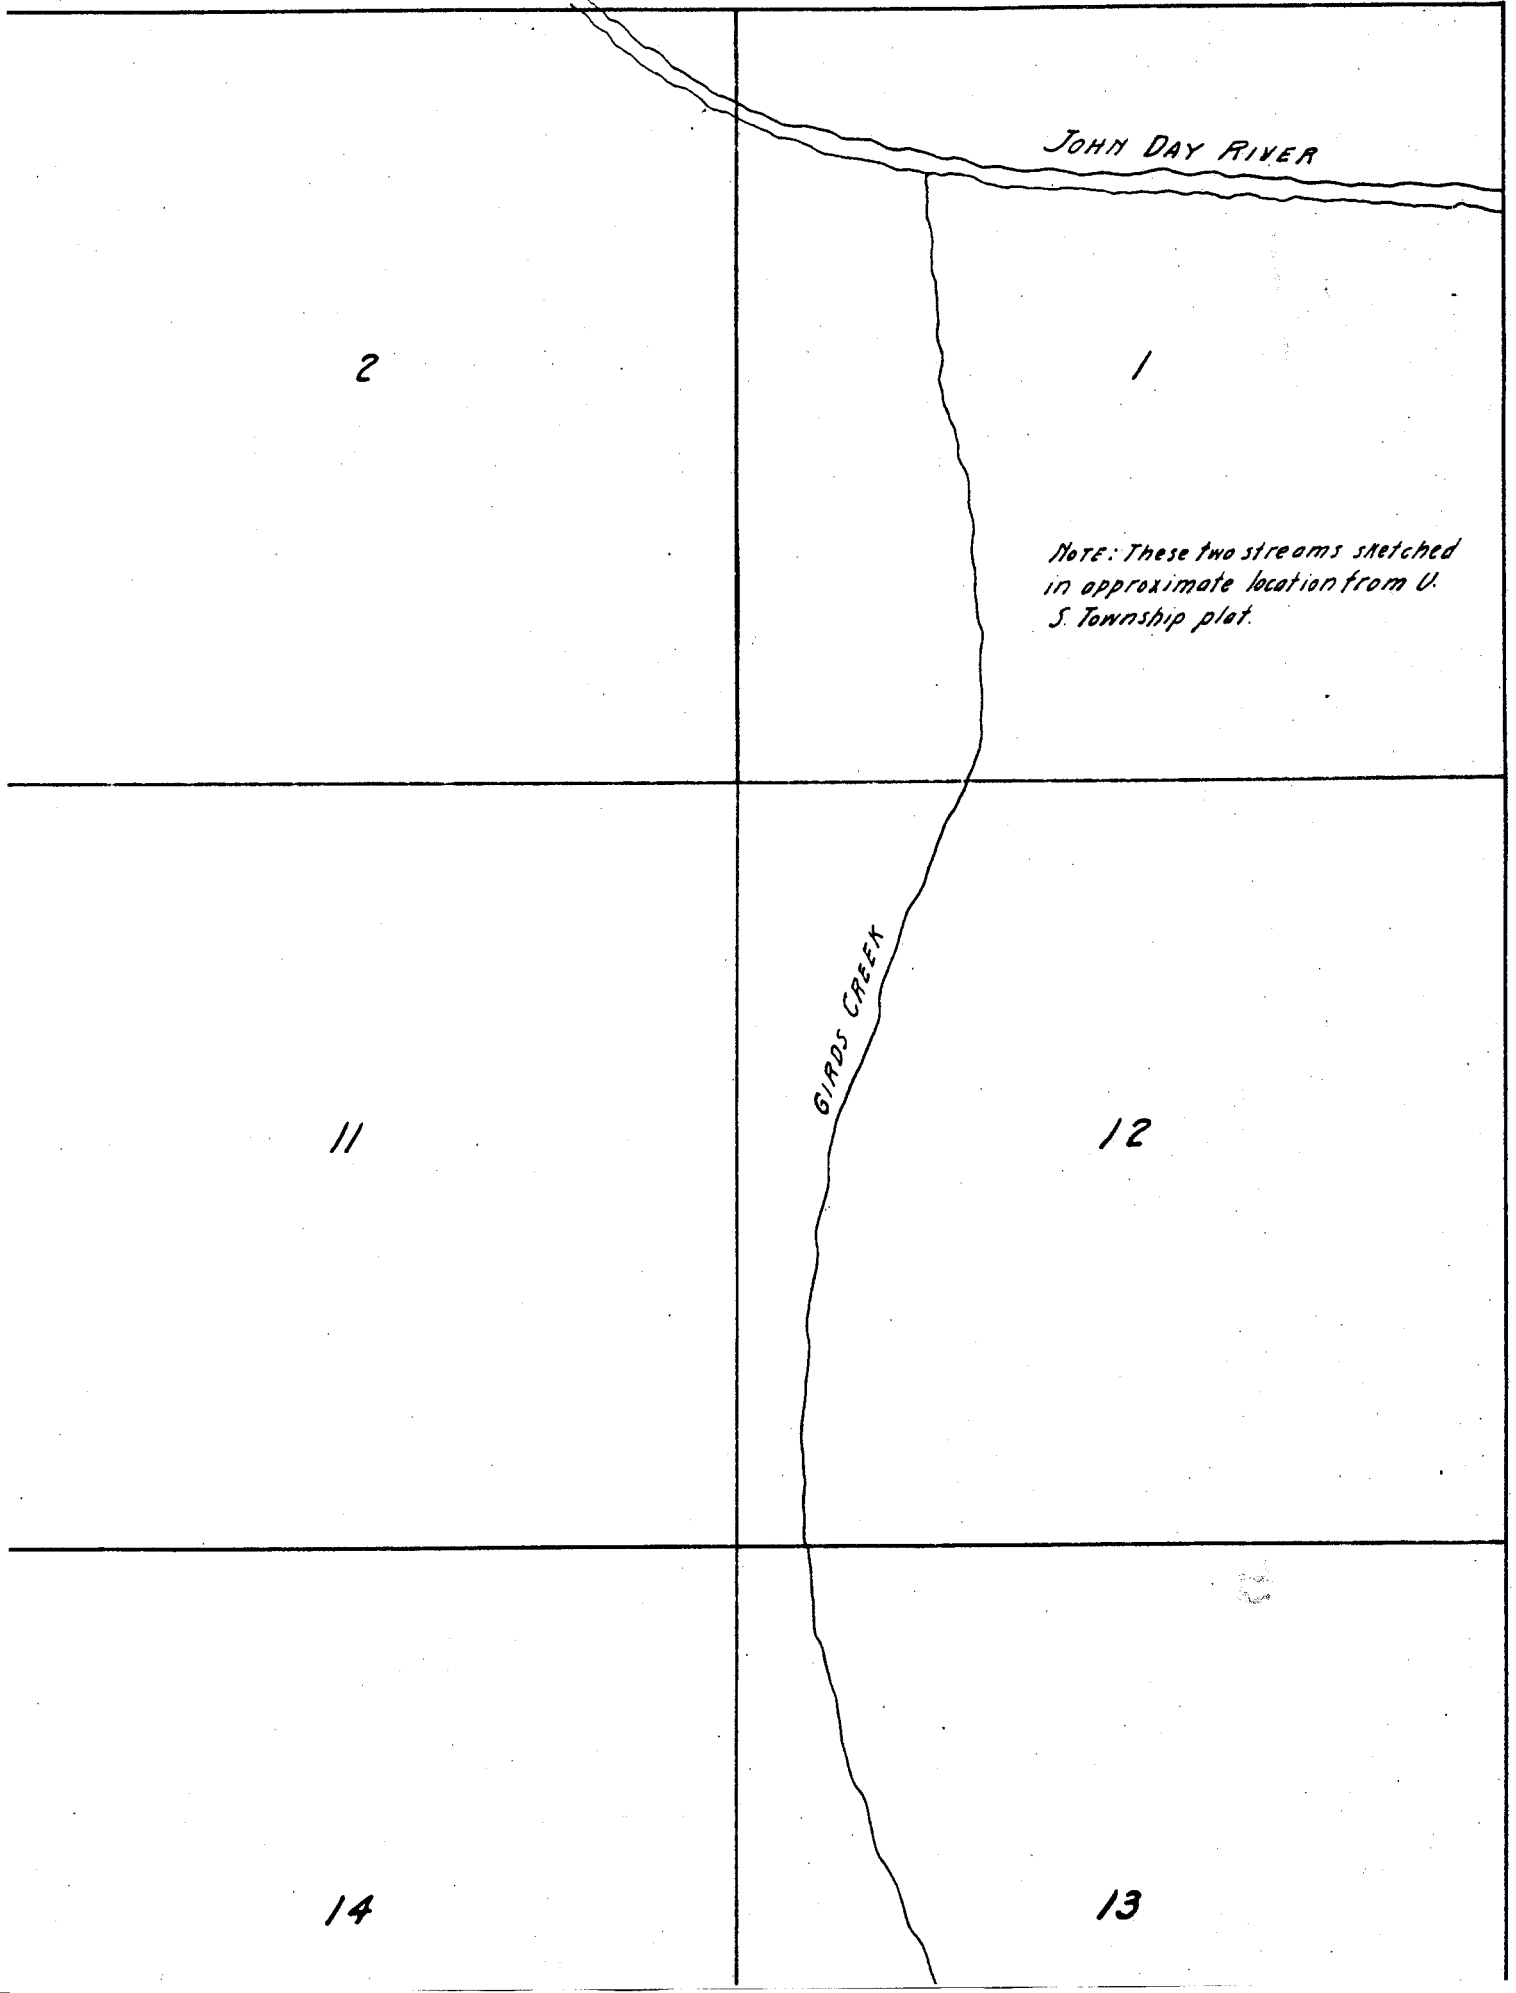

JOHN DAY RIVER

2

1

NOTE: These two streams sketched
in approximate location from U.
S. Township plat.

11

12

GIRDS CREEK

14

13

30

Sheep sheds

Ben Taylor Ranch
Surveyed Oct. 5, 8, 9, 1923

Sagebrush

102
13593

34

95

Sagebrush

31

BRIDGE CREEK

112

13592

228

011

Sagebrush

870
ditch


94

29

32

28

33

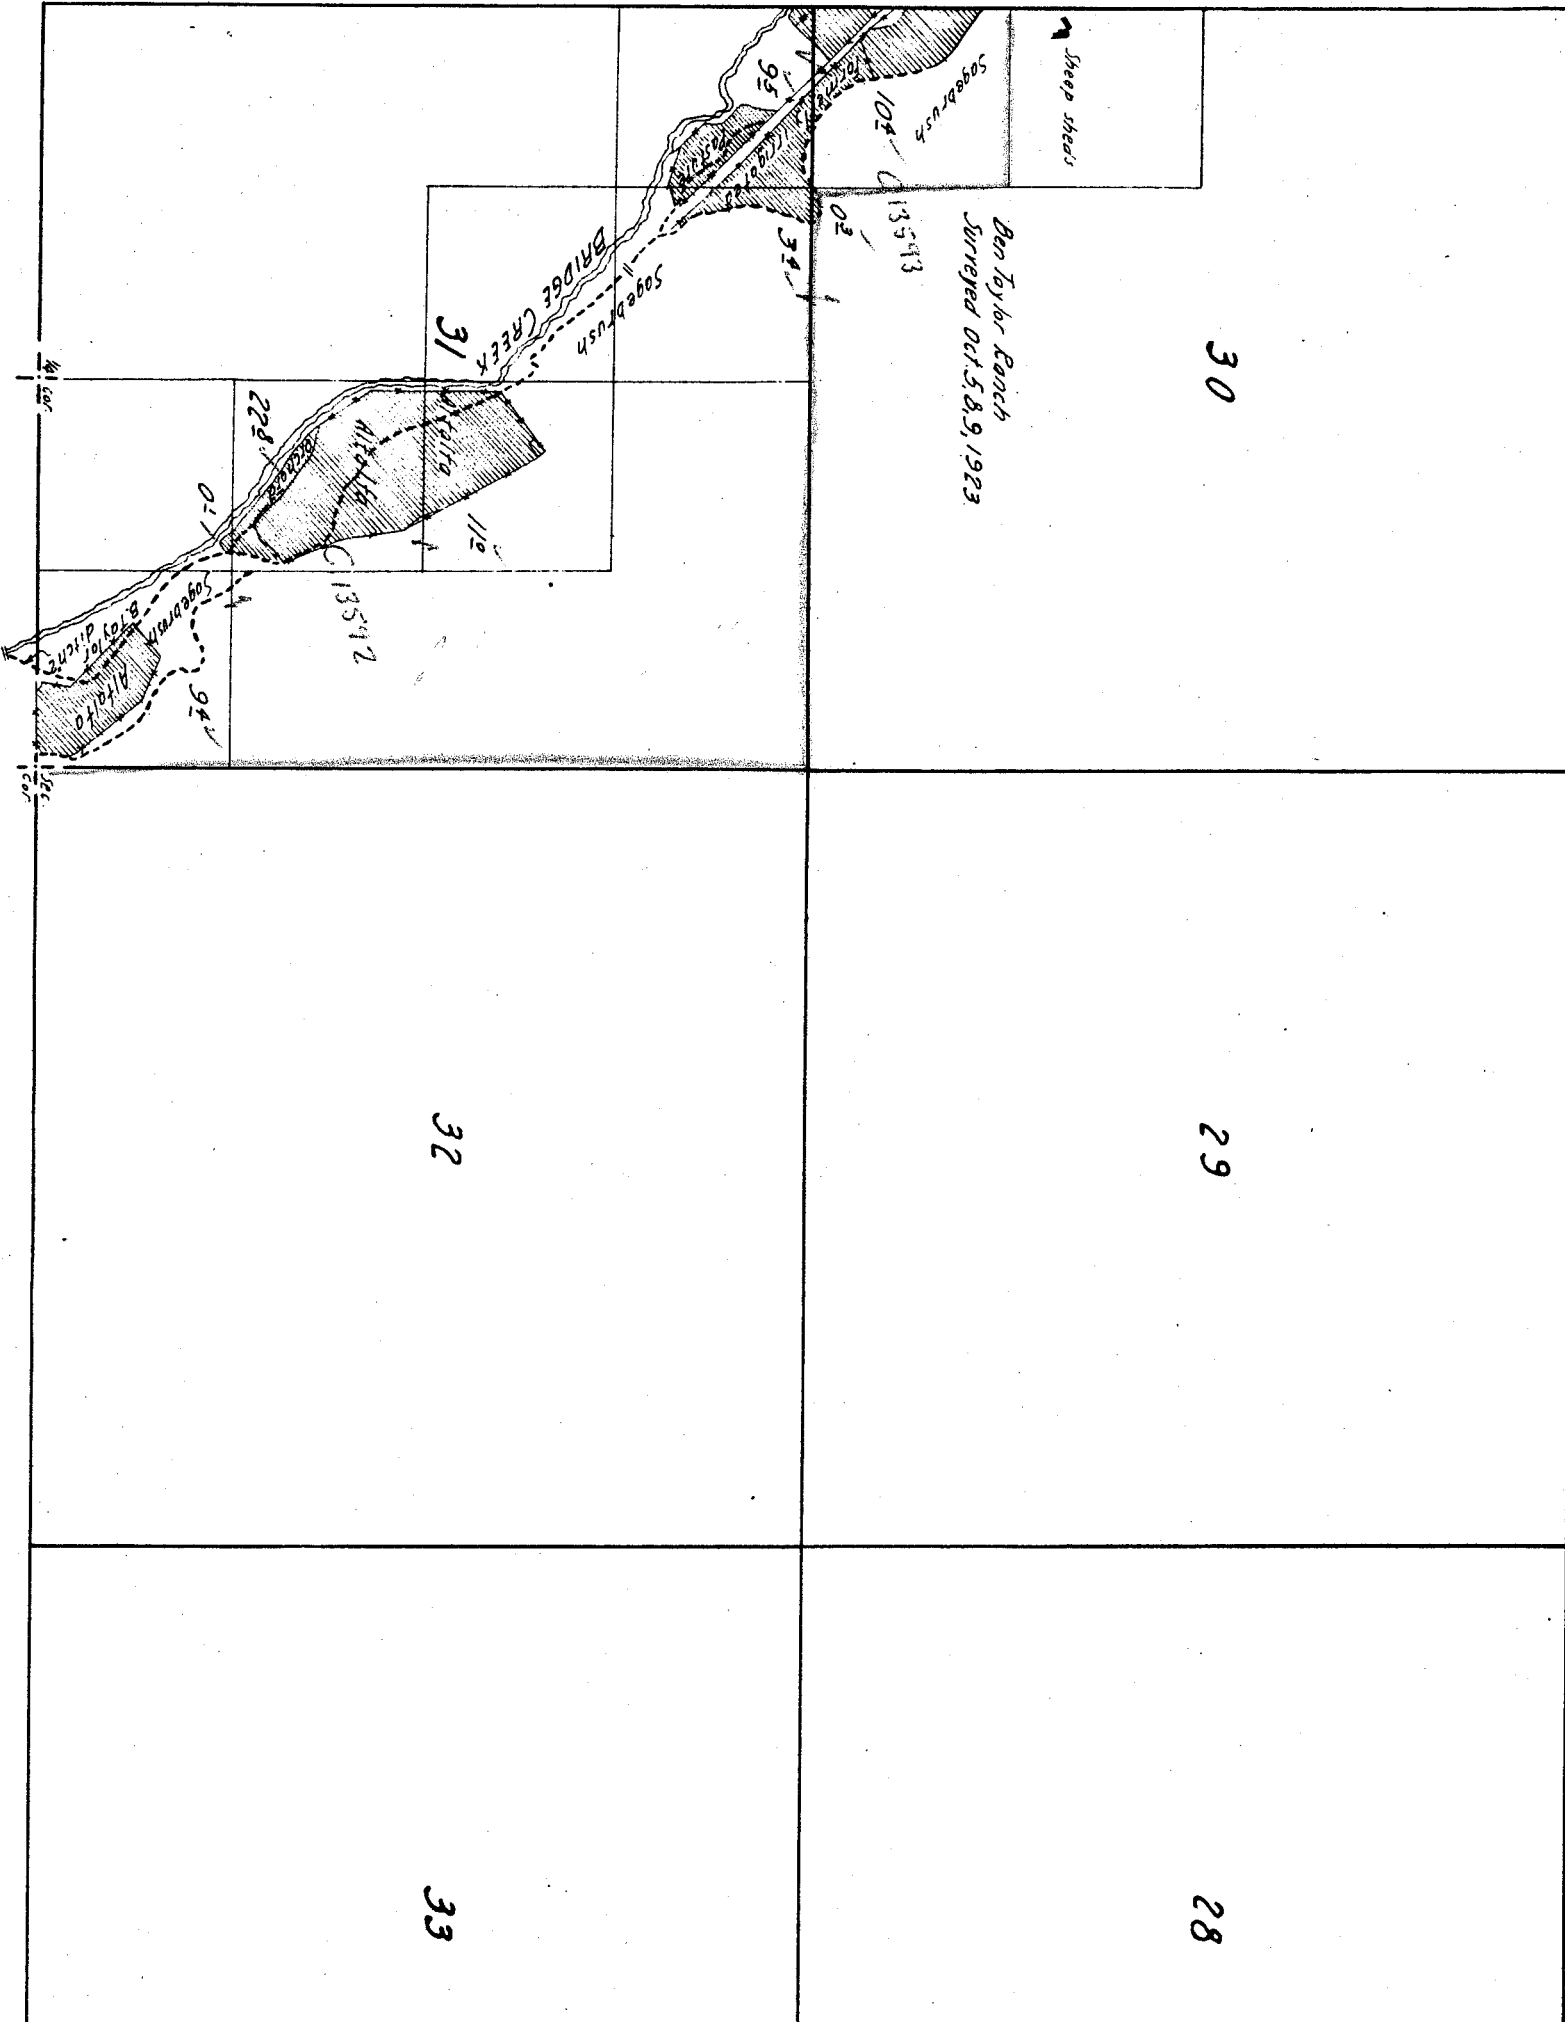

18

17

16

19

20

21

	16		
21			
	15		
		22	

Township

10 S,

Range

21 E.

4

3

9

10

27


26

25

34

35

36

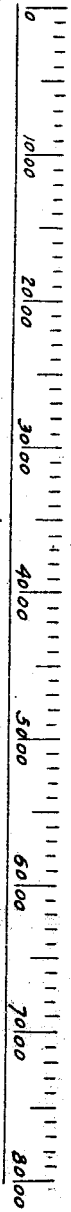

Scale of Feet

15

14

13

22

23

24

2

