


13

24

14

23

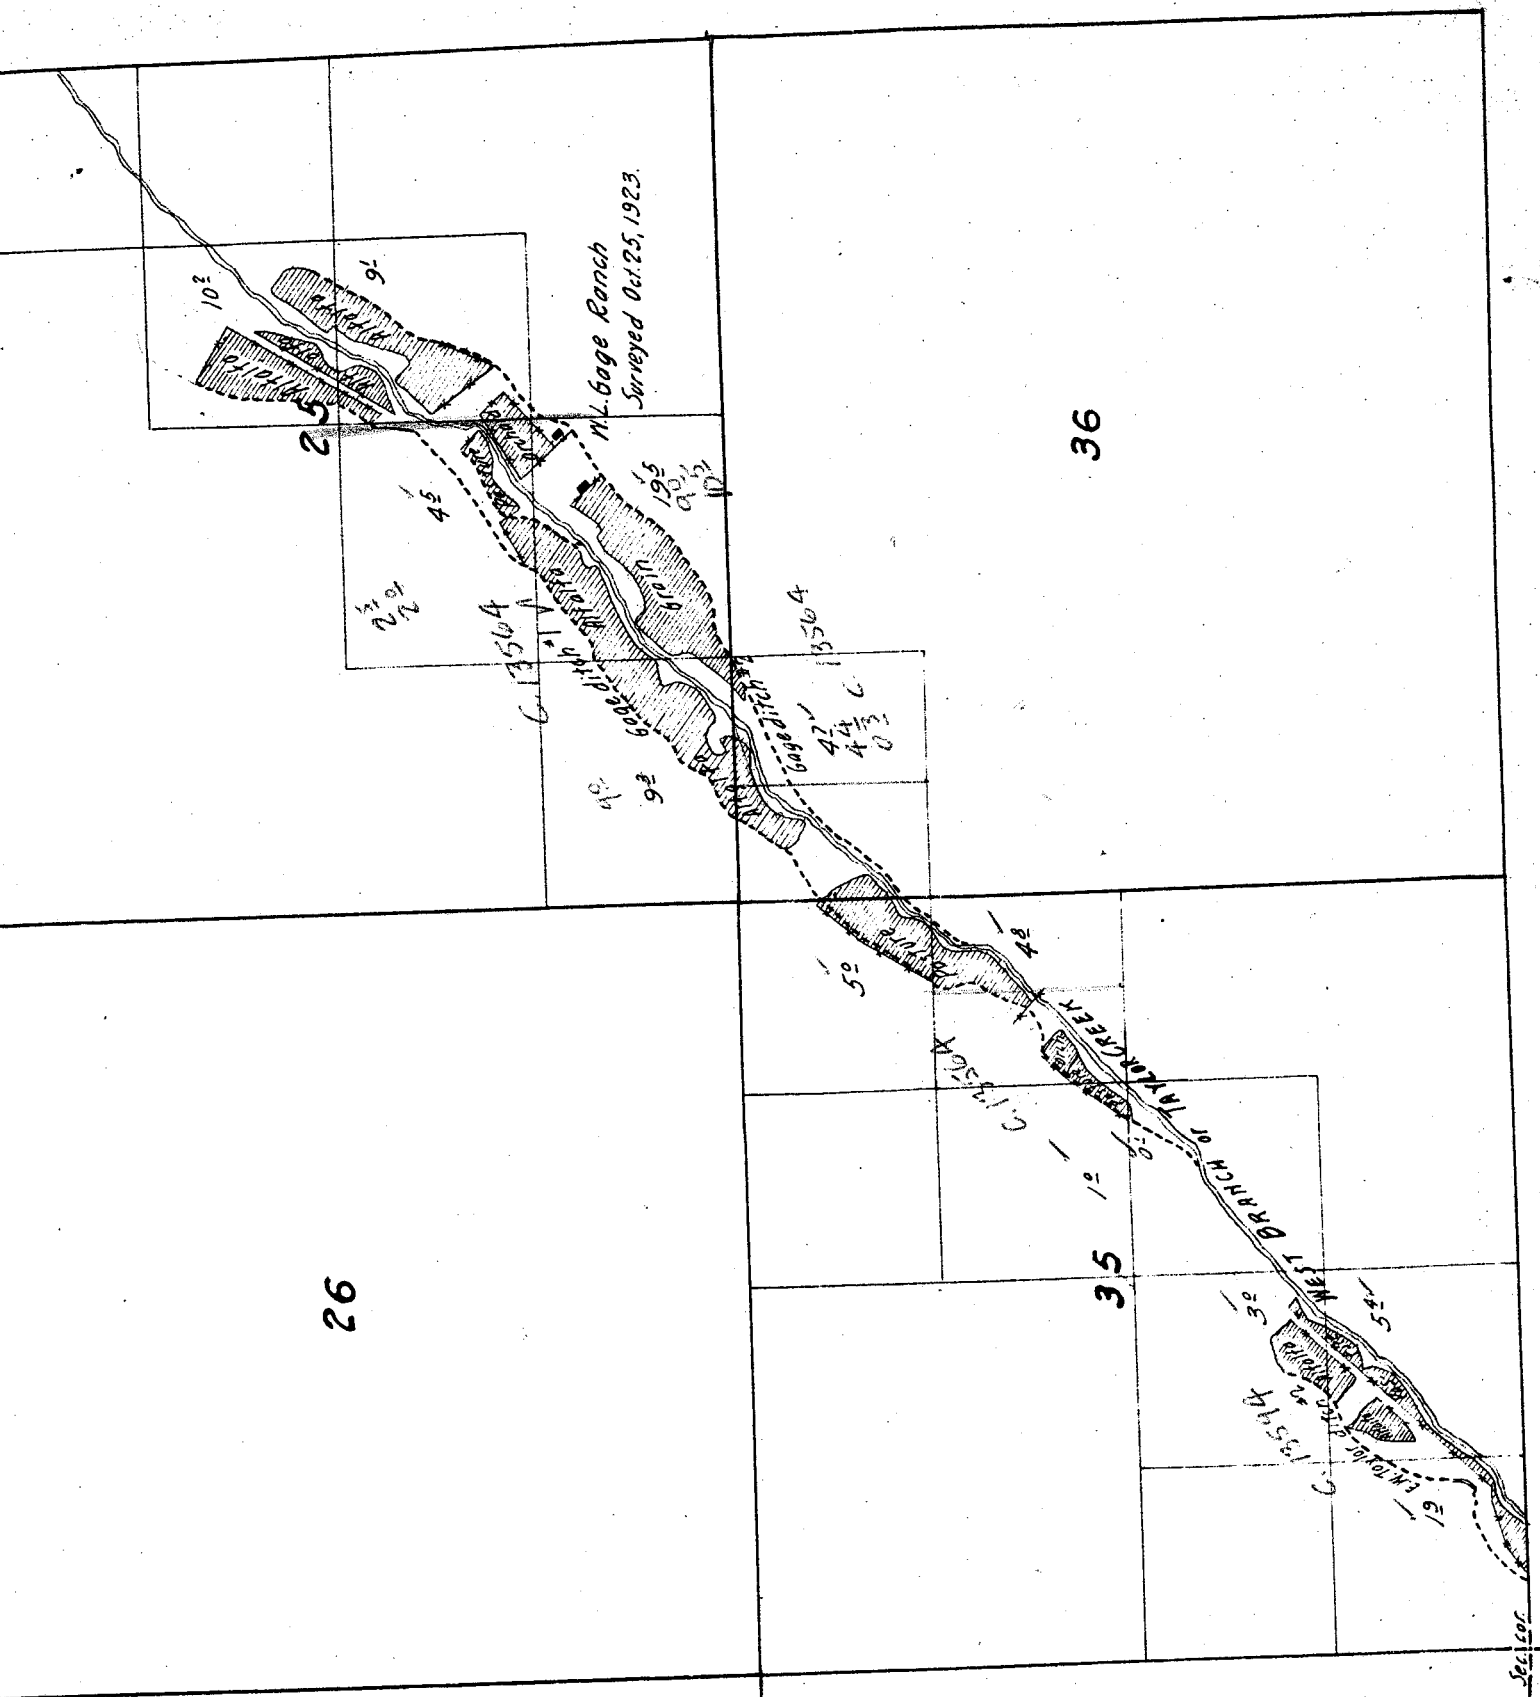

21

22

28

27

33

34

6

5

7

8

18

17

15 path land + 6.0

95
old ditch

2

1


11

12

14

13

1/5 Fitzgerald Ranch

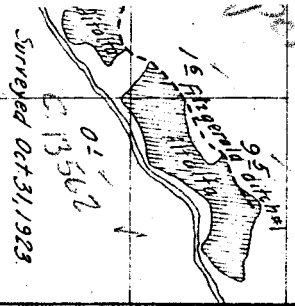

16



1/5 Fitzgerald Ranch

Section

15

21

22

Township

11 S,

Range


20 E.

4

3

*Note: Bear Creek partly sketched
in approximate location from
U.S. Township plat.*


10

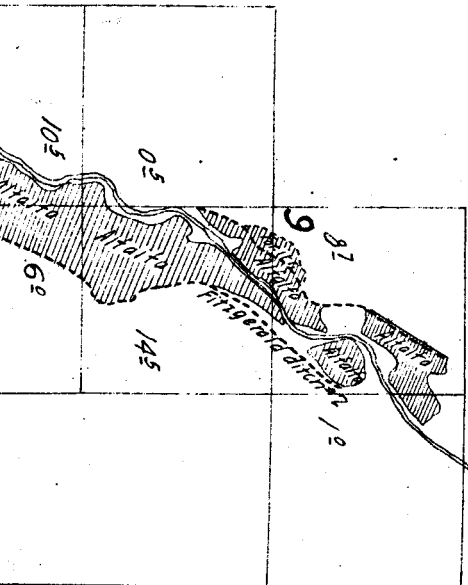



16

21

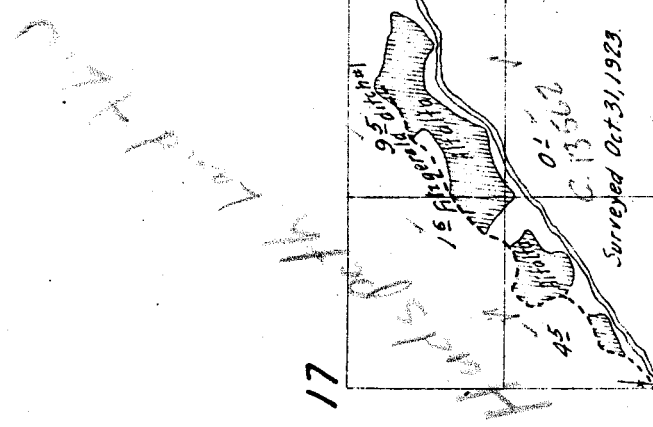

17


20

BEAR CREEK

Stephenson

61


18

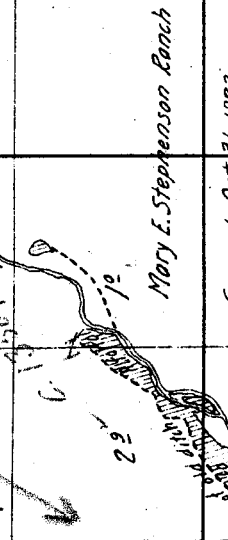


Surveyed Oct. 31, 1923

Surveyed Oct. 31, 1923.

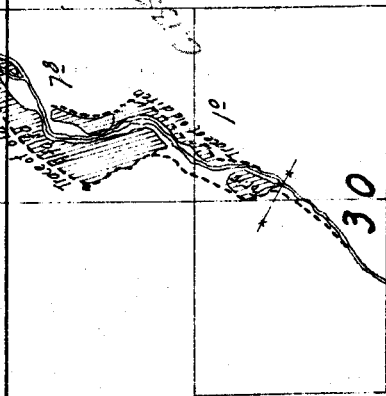

28


29

30

33

32

31

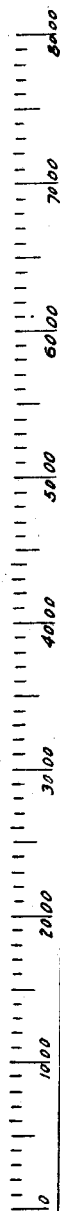

Scale of Feet