

16


15




Note: Creeks partly sketched in approximate location from U.S. Township plat.

Township 11 S, Range 21 E.

W. Ranch  
Oct 8, 9, 1923  
5

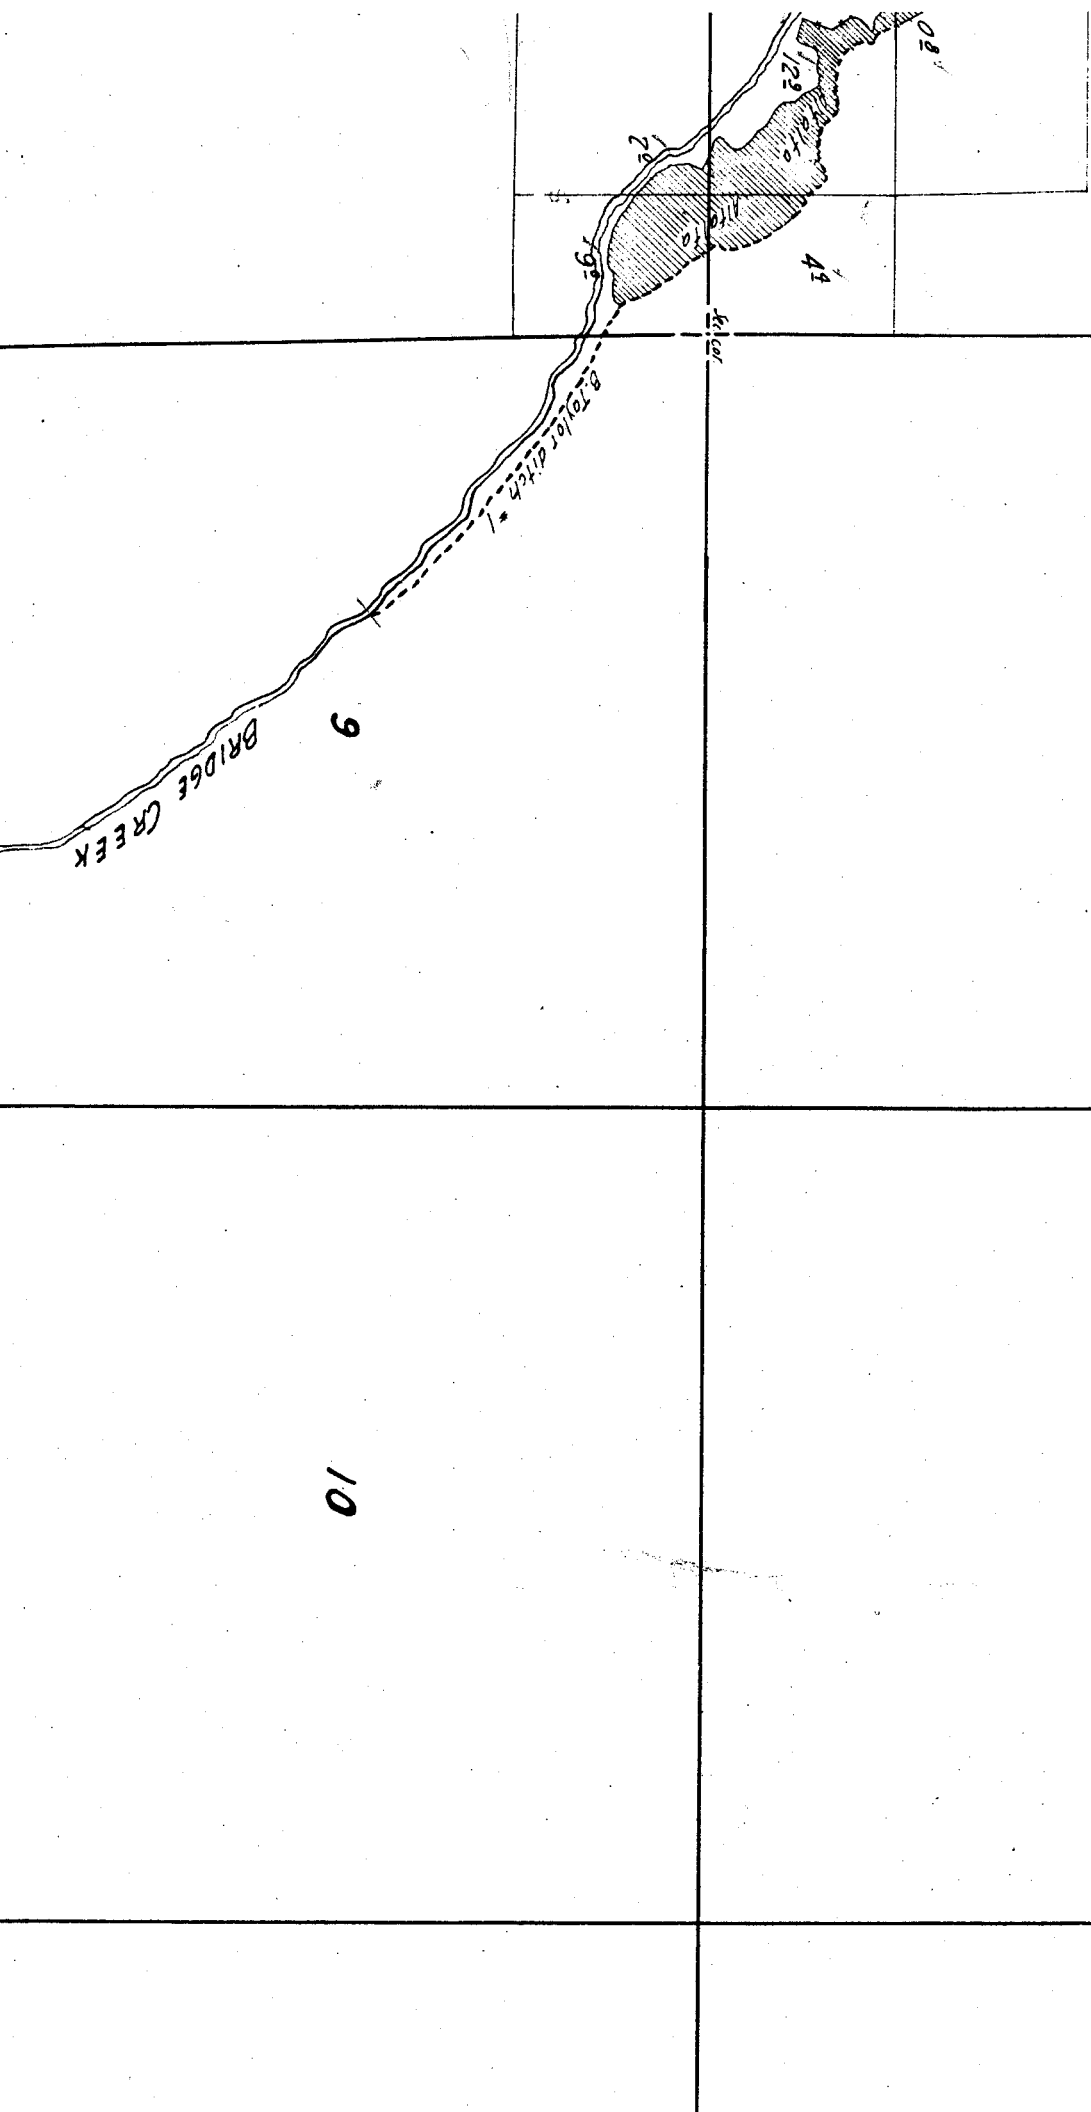

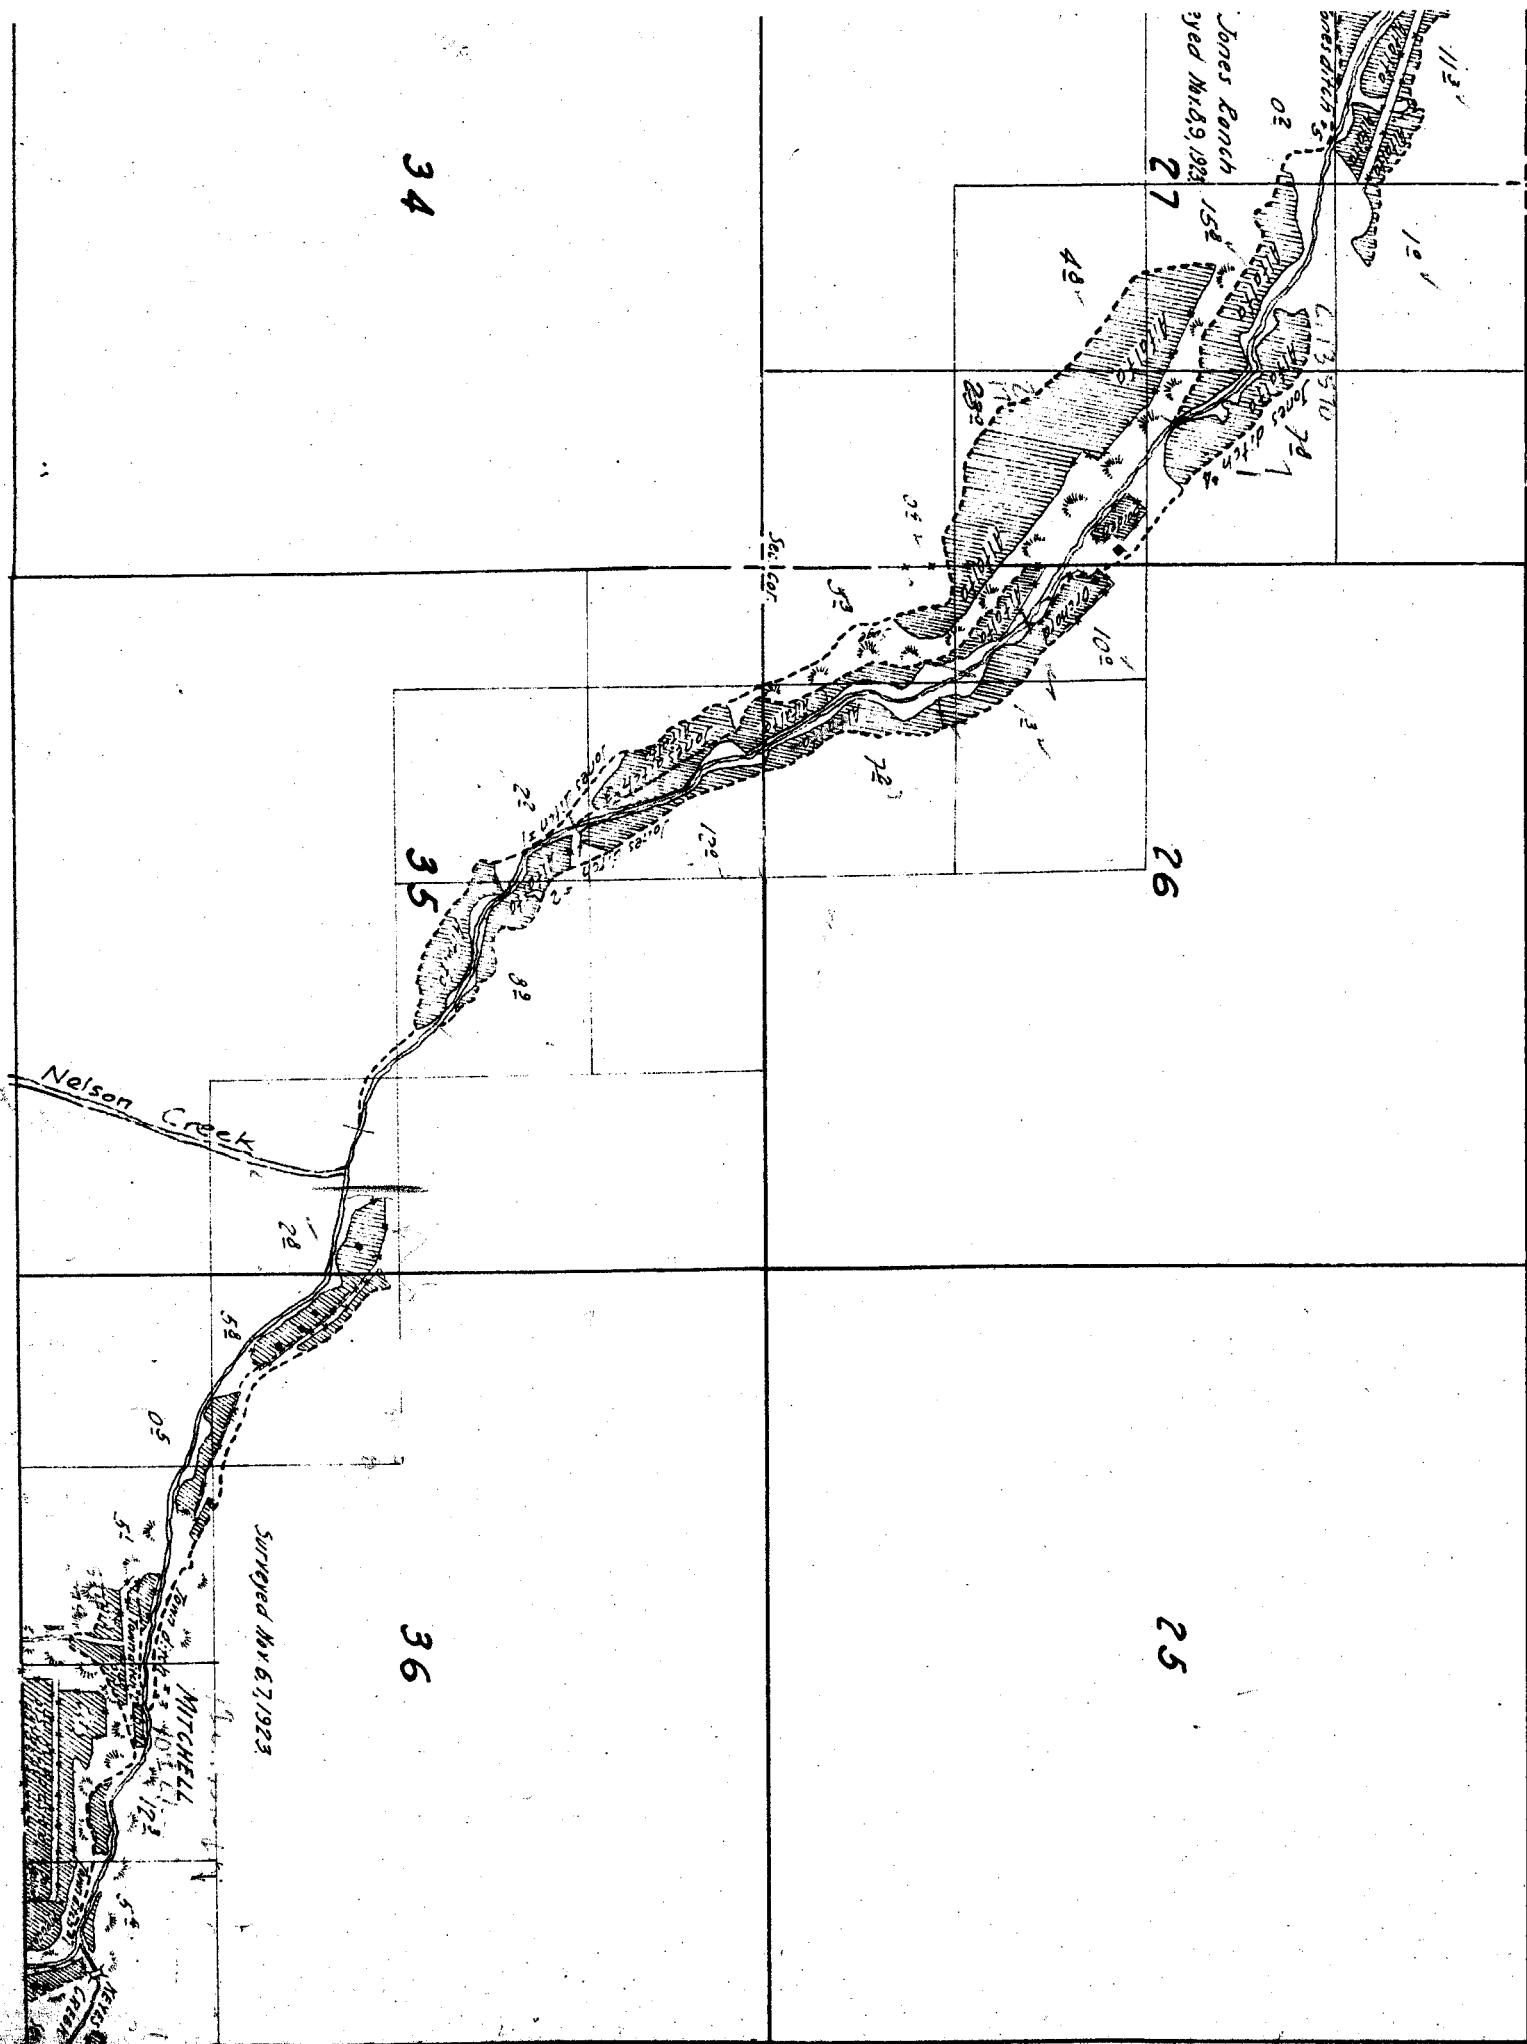

15

14

13

is partly sketched in approximate  
from U.S. Township plot.

22

23

24

24 cor

Sec 1 cor

6

7

18

32 1

96

22

Ben Taylor Ranch  
Surveyed Oct. 8, 9, 1923

5

20 1/2

42

02

05

122

410

1160

22

92

42

8

17

E.

6-1-1

2

1

11

12



14

13

21


22


28

27


33

34

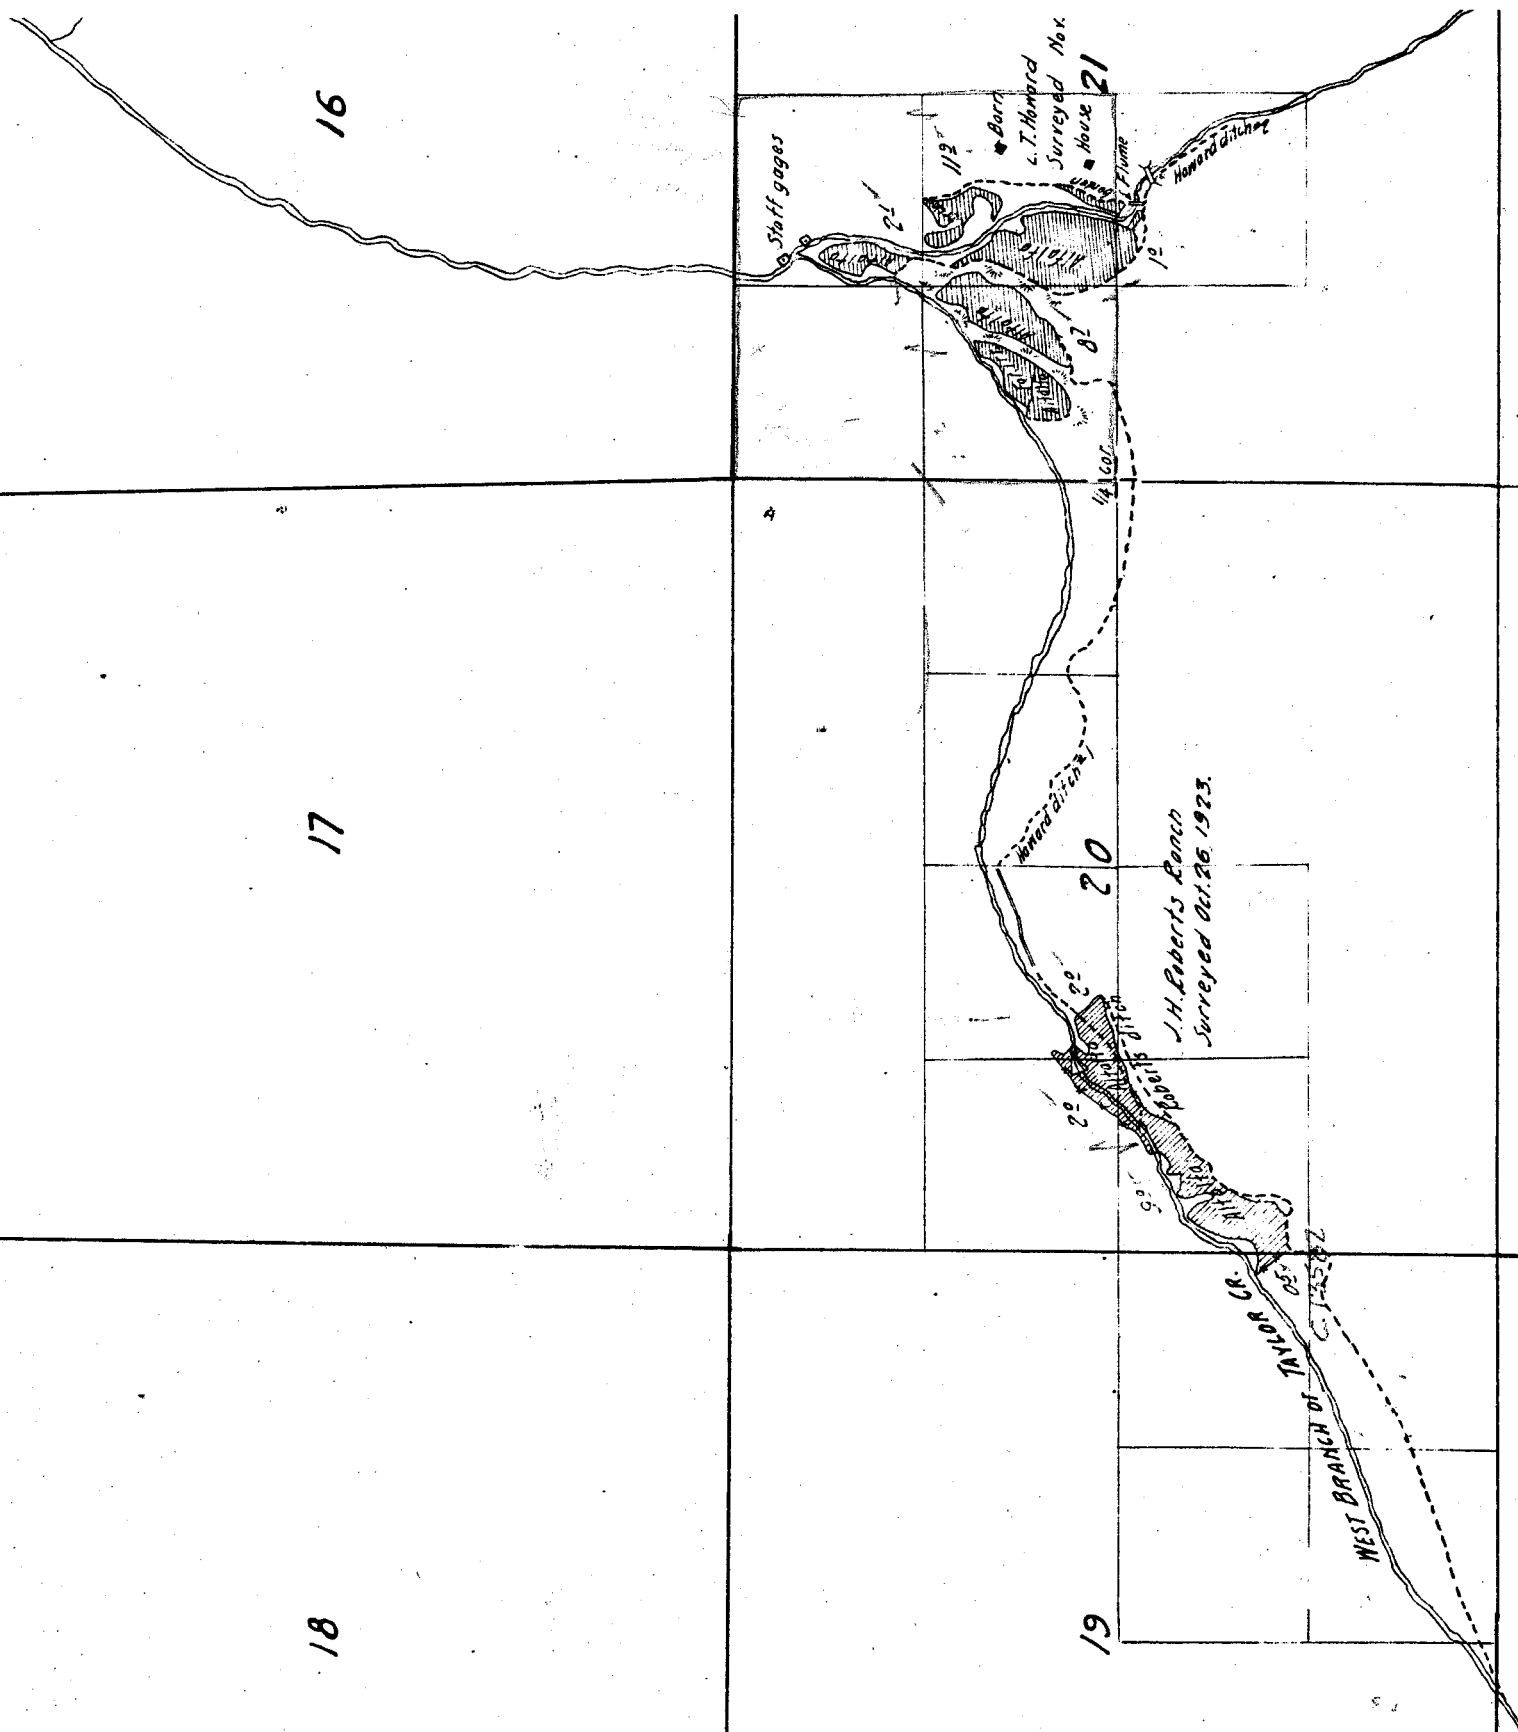

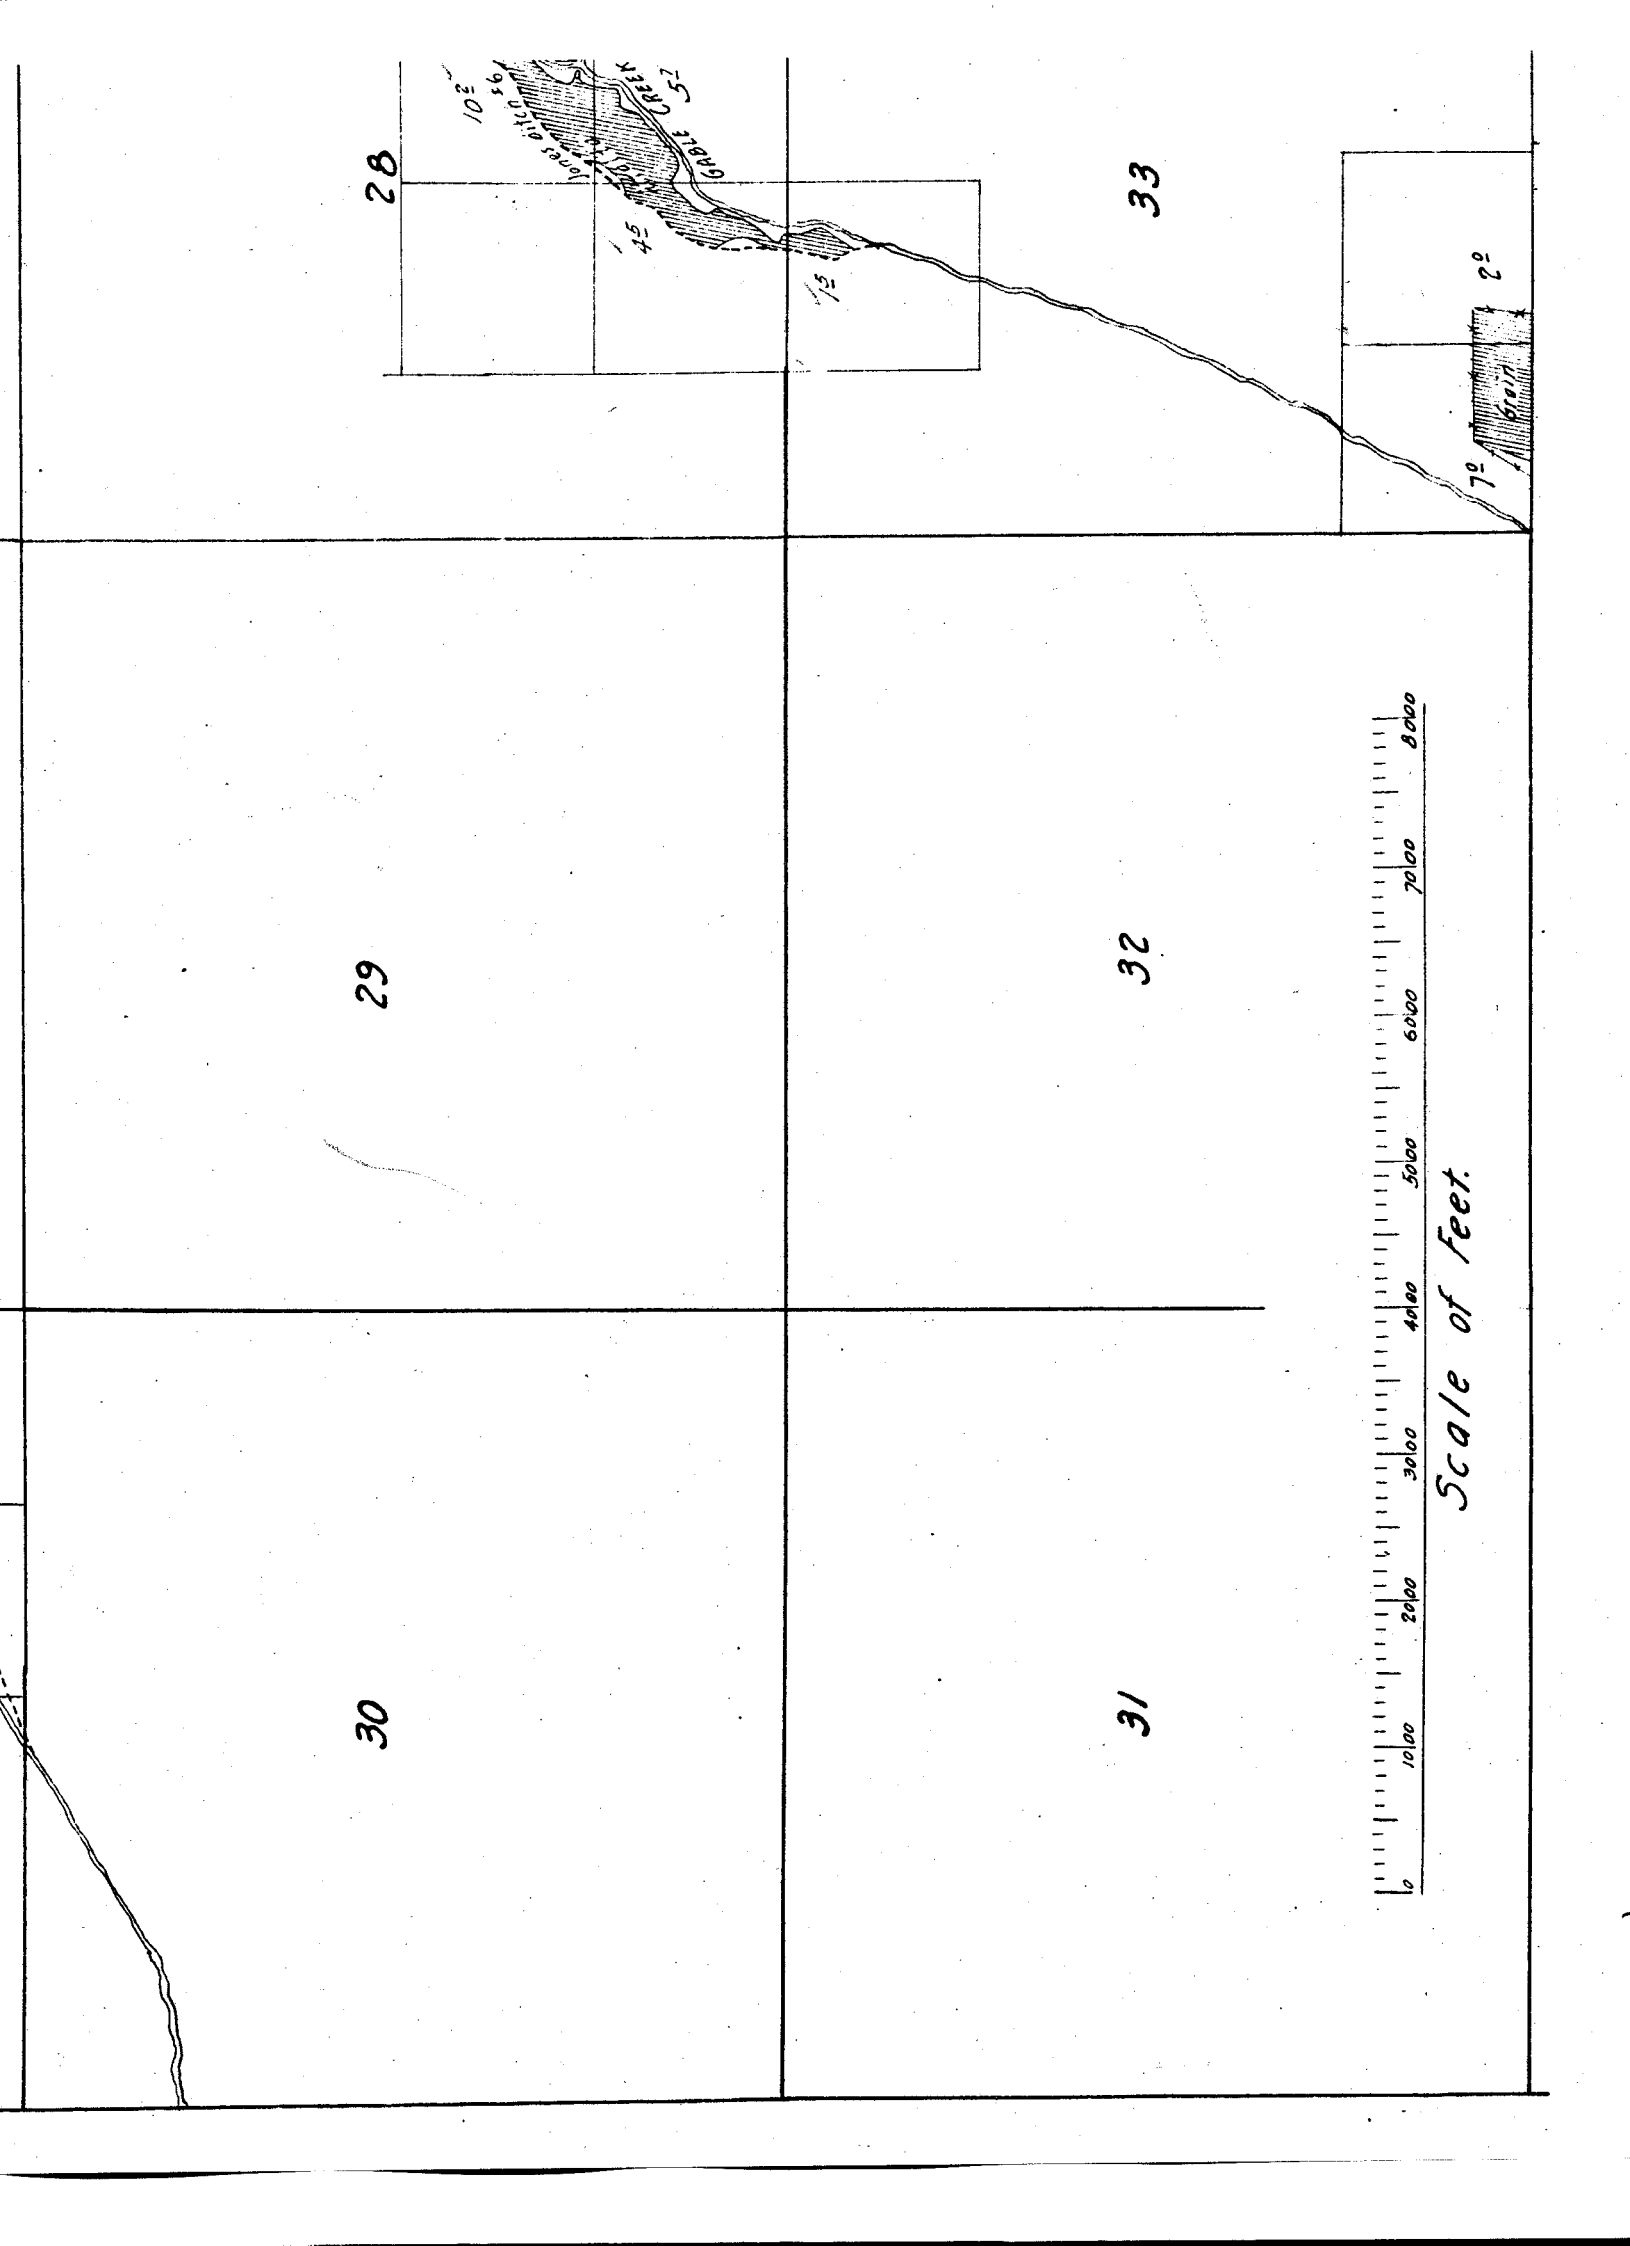



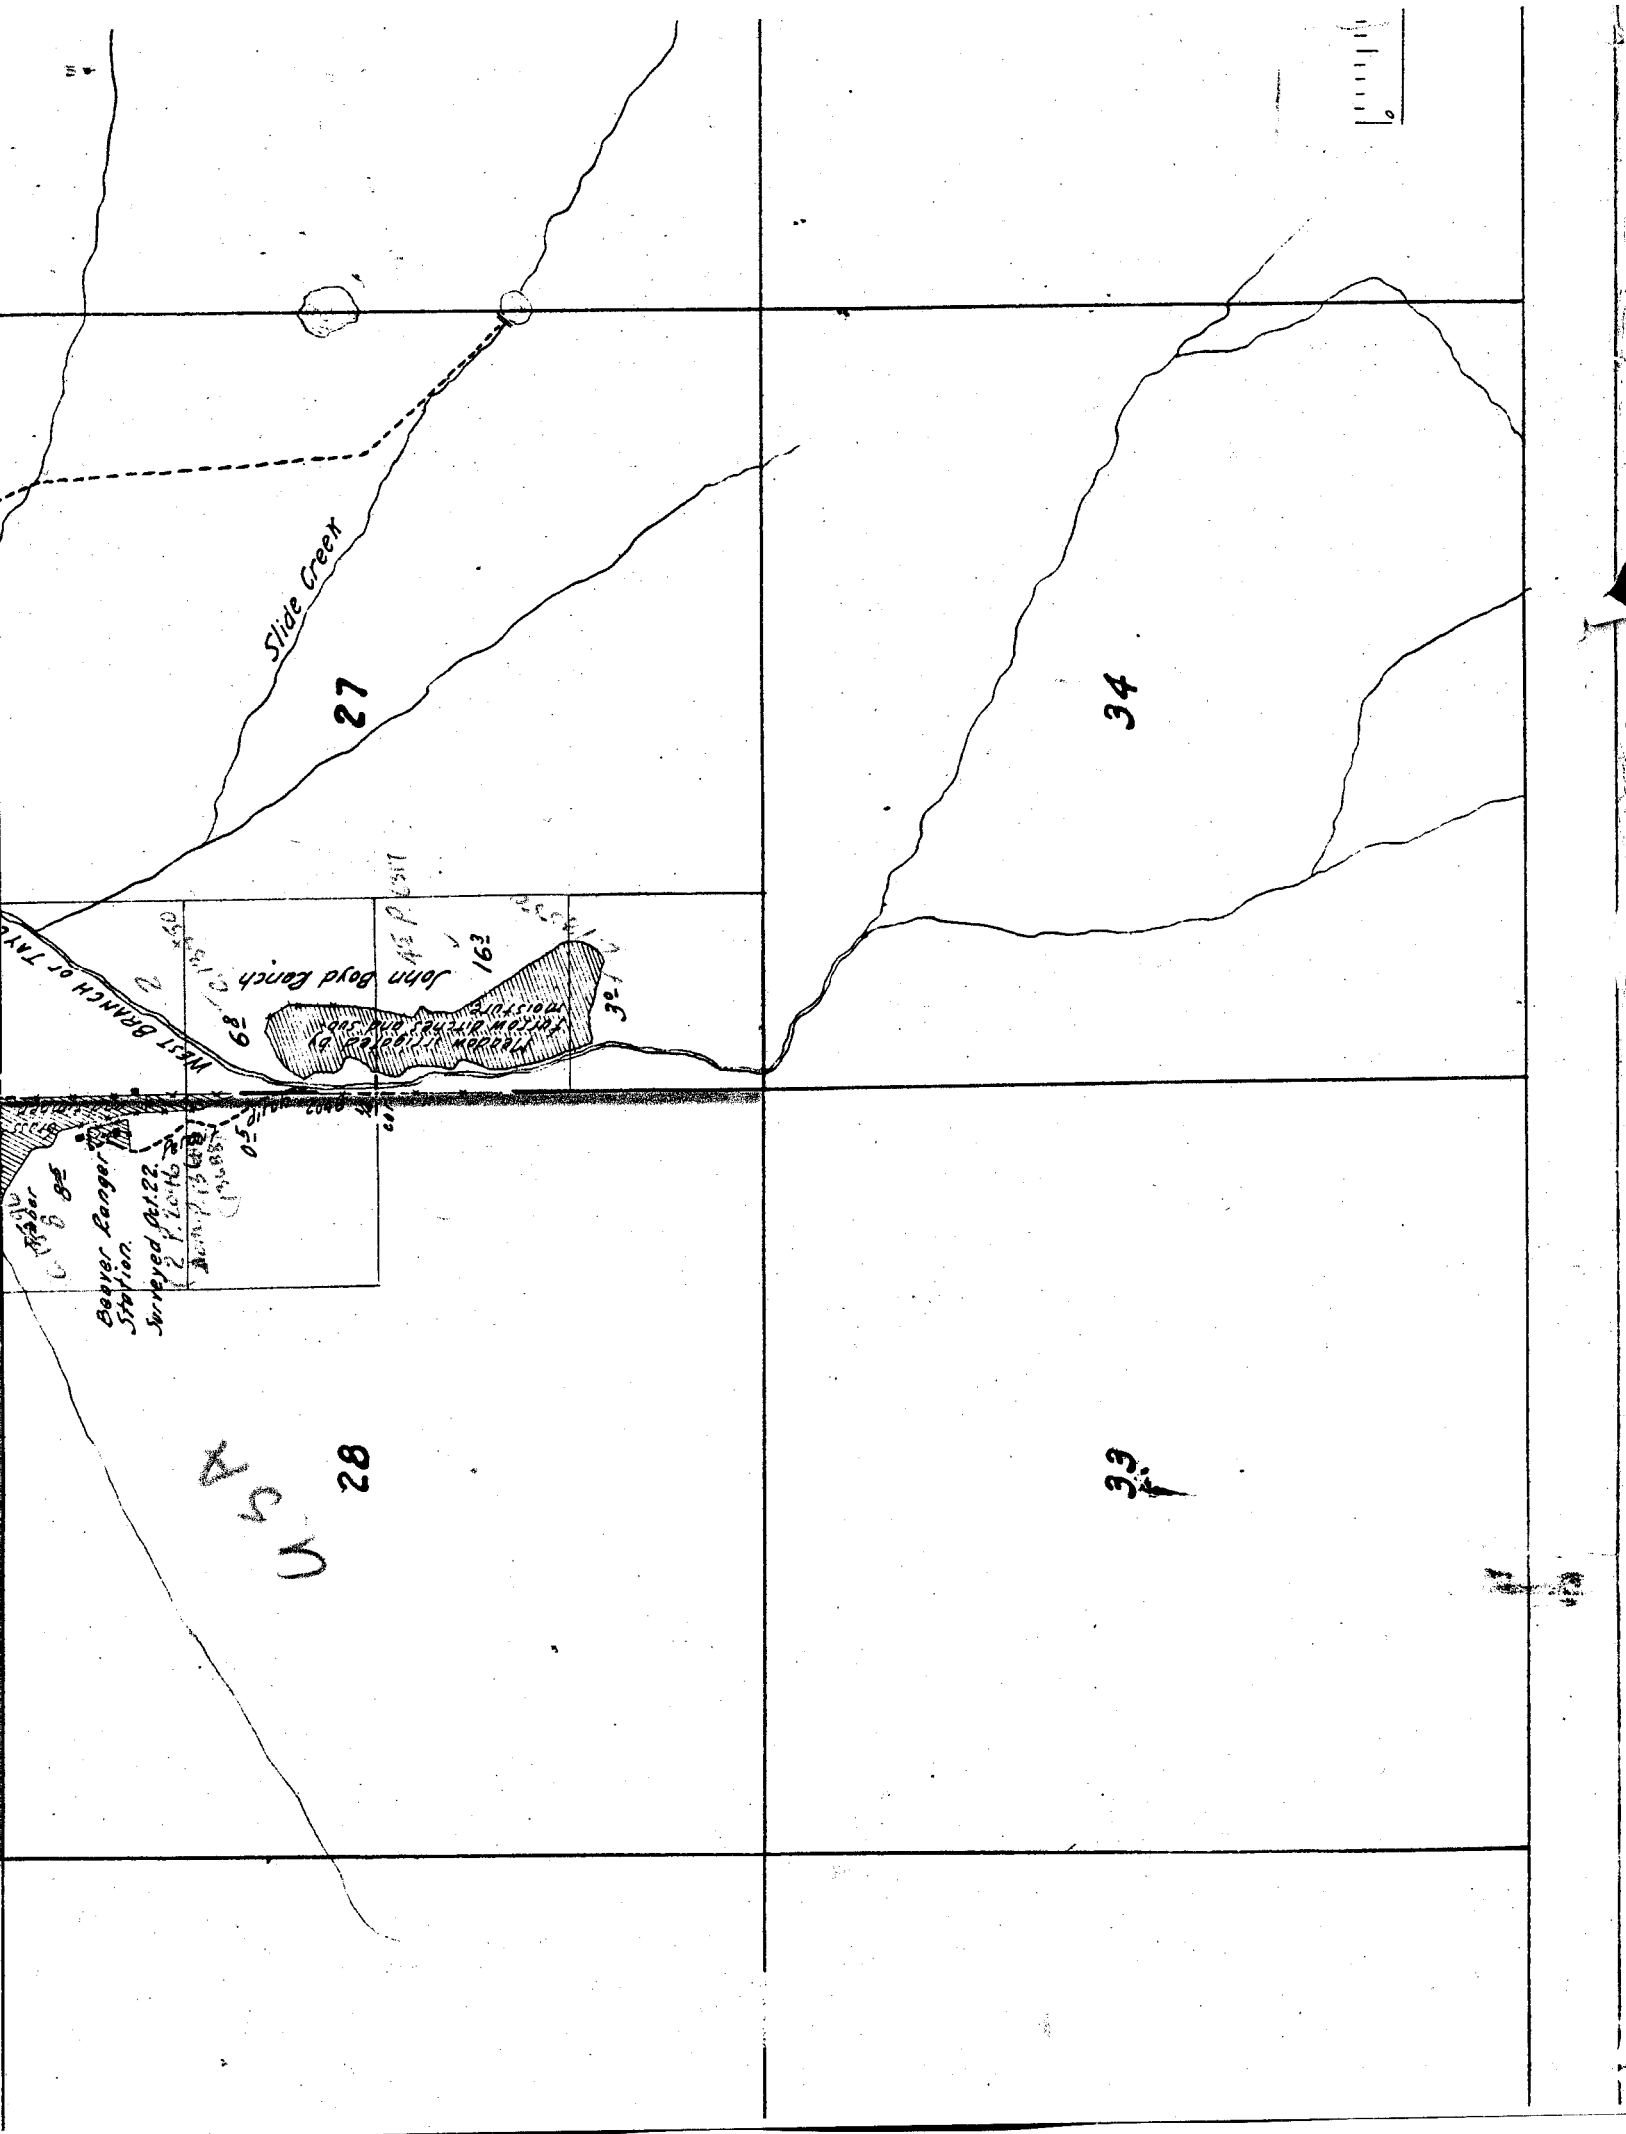

Scale bar

Slide Creek

27

34

33

28


Handwritten notes and numbers in section 28

John Boyd Ranch

Beaver Ranger Station


Scale of Feet

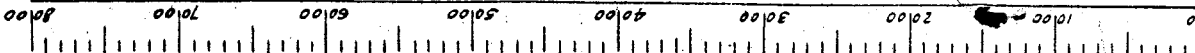

35

36

Note: - Greens sketched in approximate location from U.S. Township plat, U.S. Forest Service map, and permit maps, except in vicinity of irrigated areas.

26

25

P. 4106  
J. 26076  
U. 348.511

13  
C. 13560

M. 1 3 x 1 and


23

24

THOMPSON

12 S.

20 E

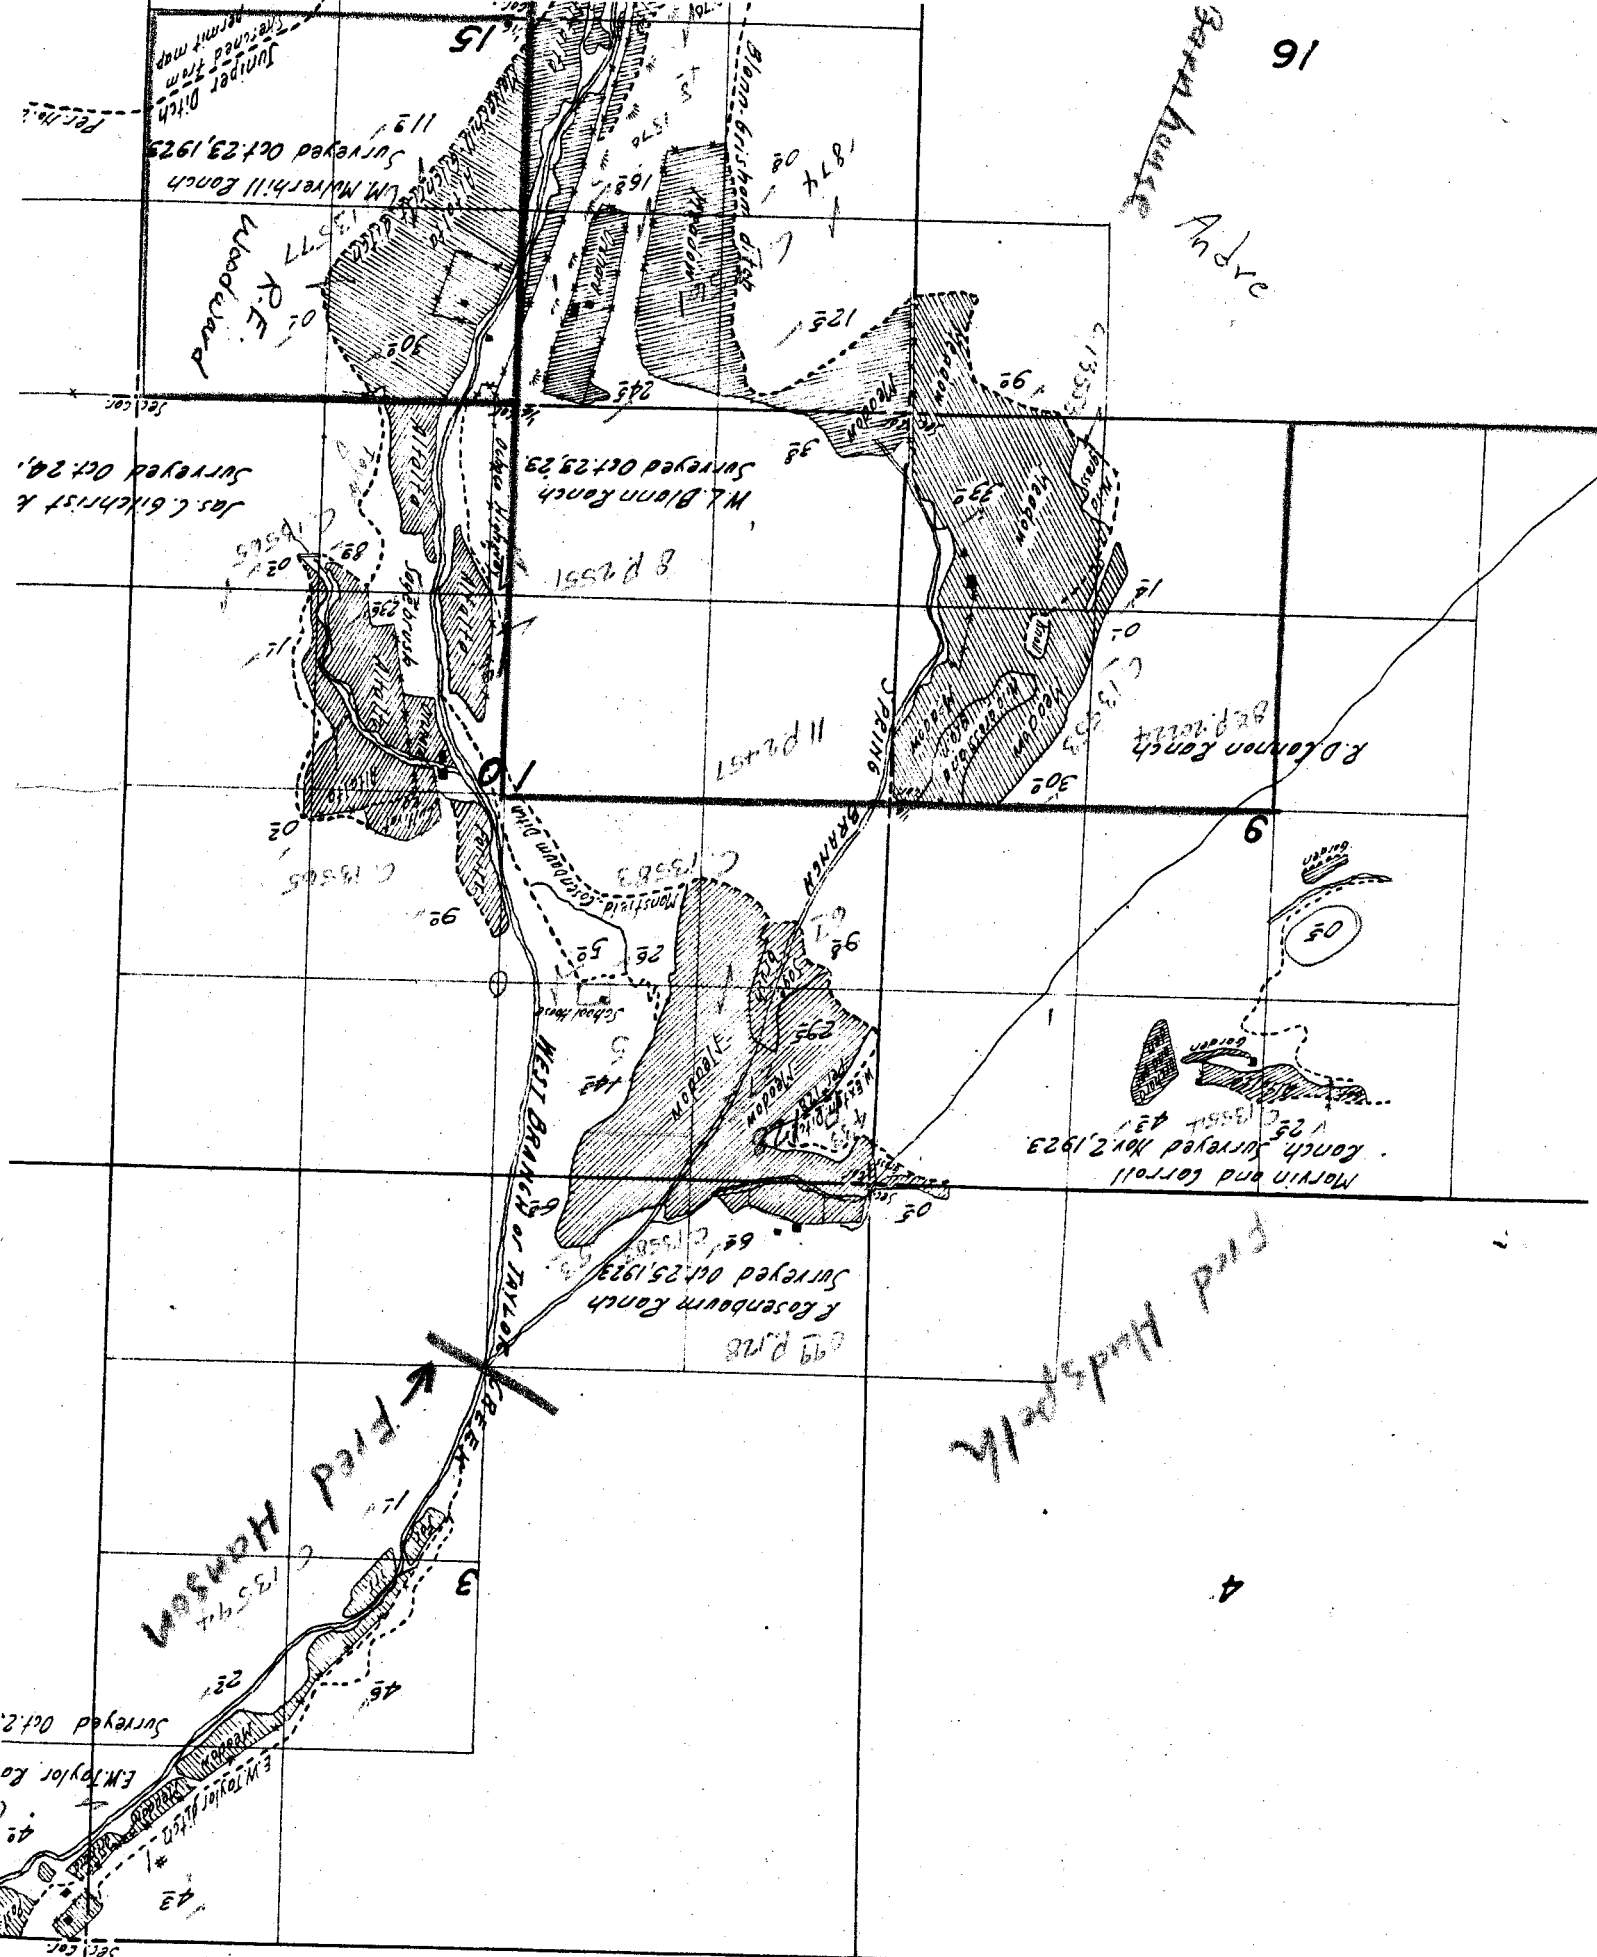

19


20

30

29

31

32

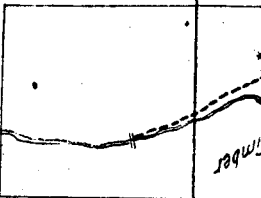

18

HEFLIN CREEK

19

17

20

16

21

# Township

9

6

4

stop hon son

Timber

14-

September

50

7  
Timber


Surveyed Nov. 2, 1923.

Note: location of creek and irrigated areas somewhat approximate.

House



Marvin and  
Ranch. Surrey  
125

*R. D. Thompson*

827.2

6

Page 20 E.

9-1-1

