



16

21

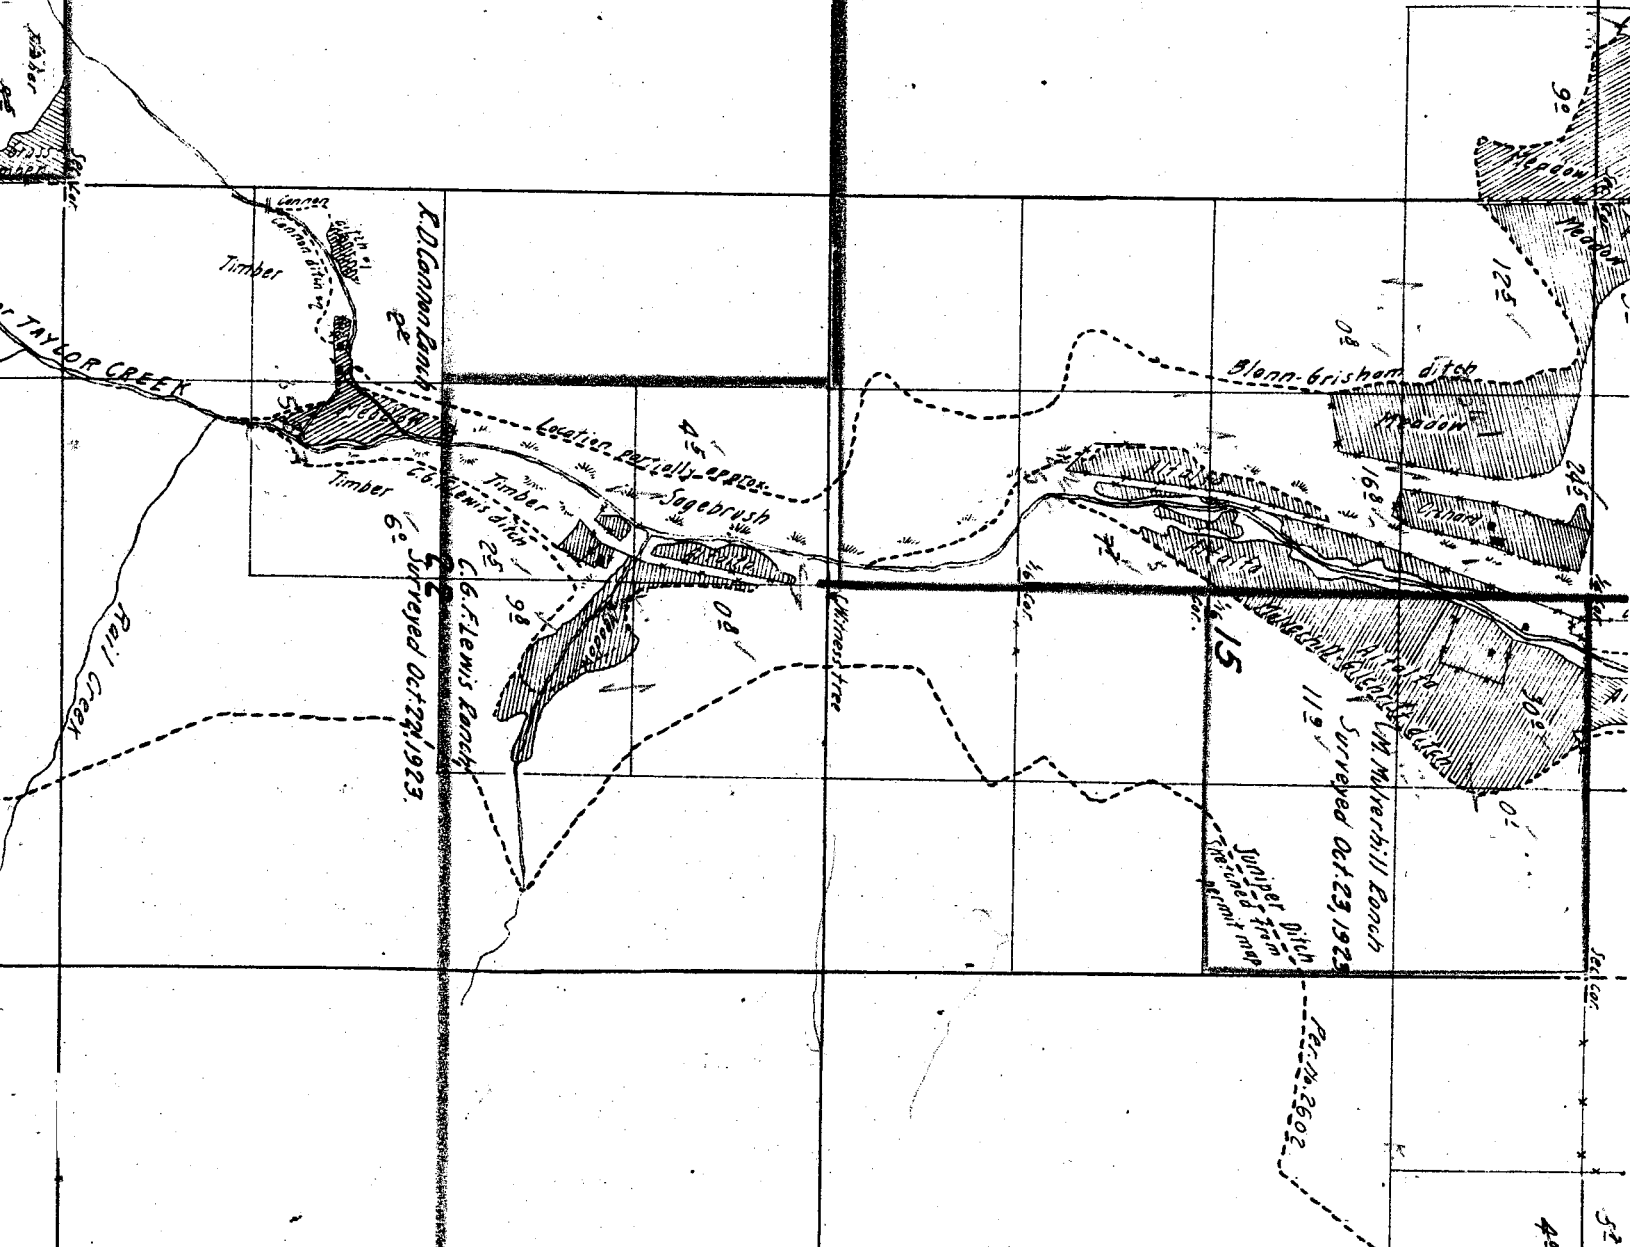

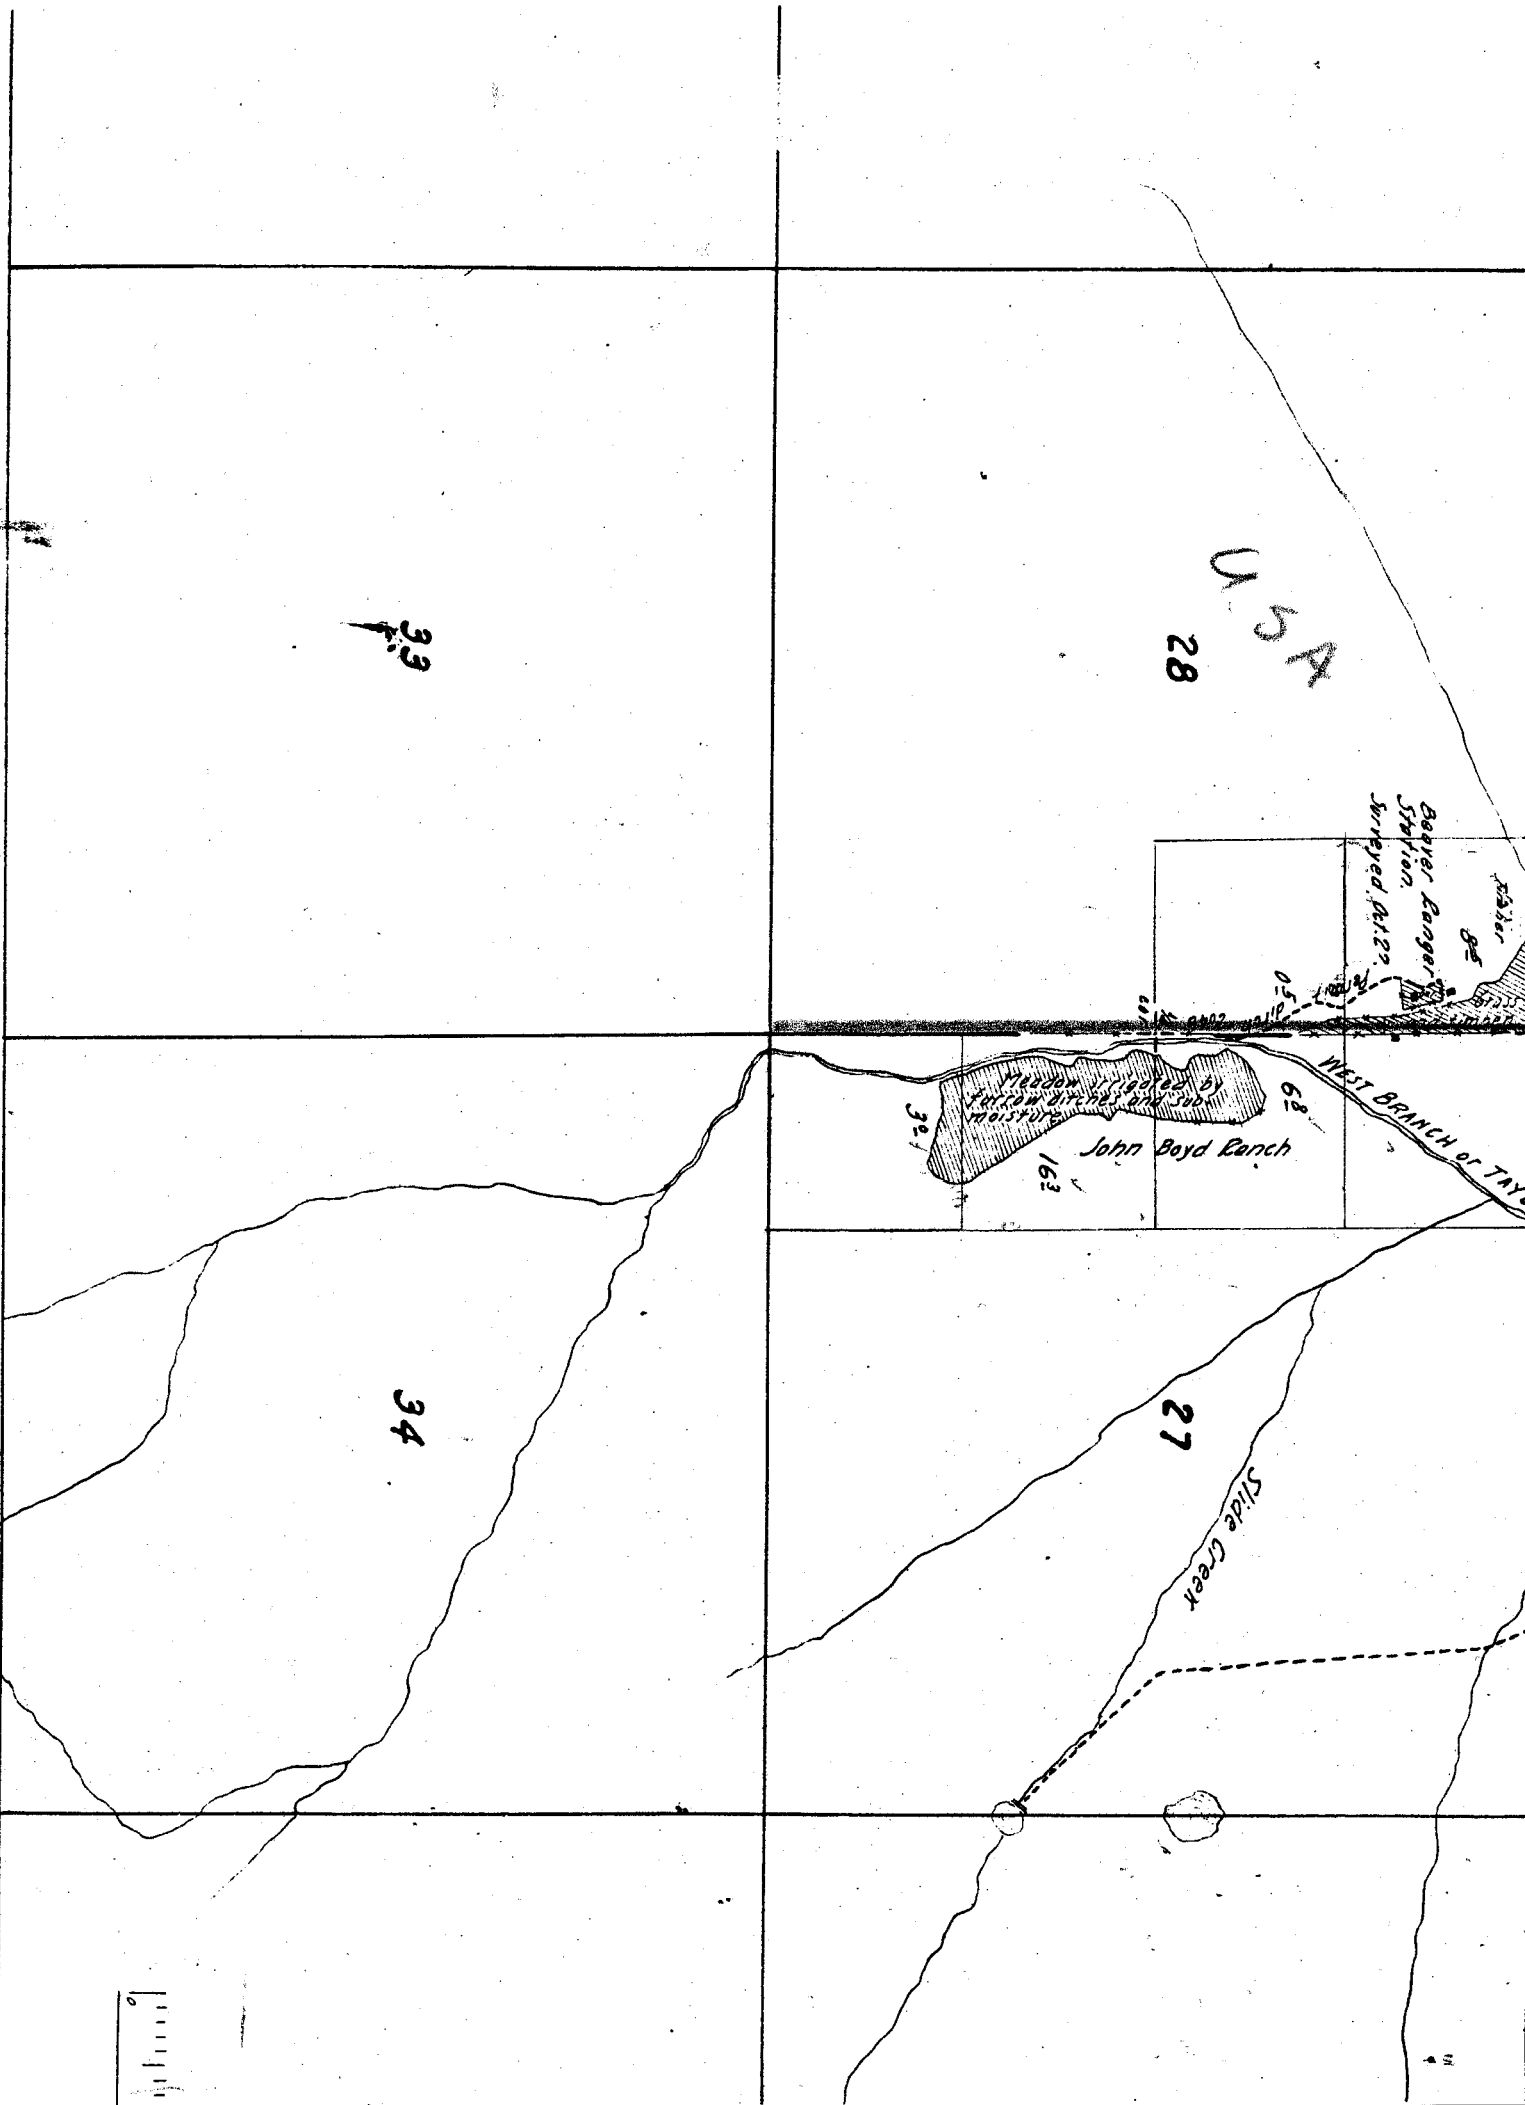

Township


6

5

4

8

9

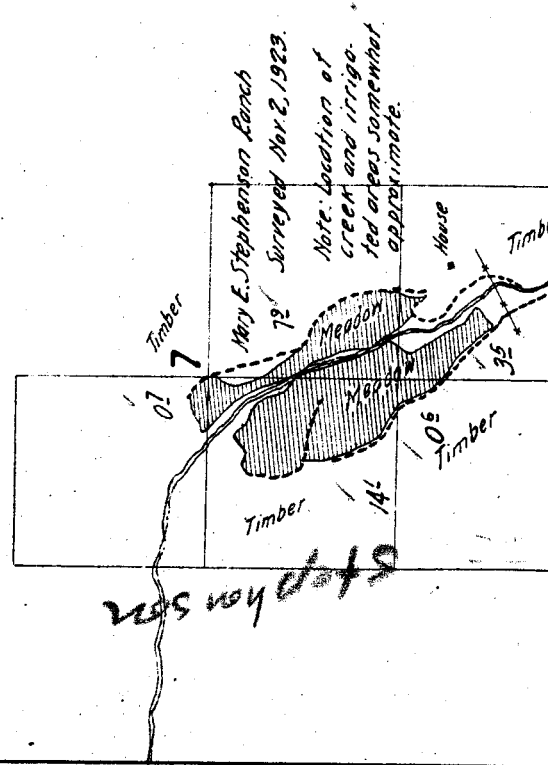

Martin and L.
 Ranch Survey
 V 25 C 13554

R.D. Cannon &

16


21

17


20

18



19

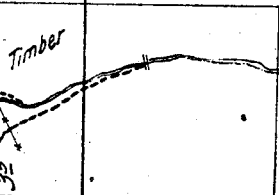

HEFLIN CREEK

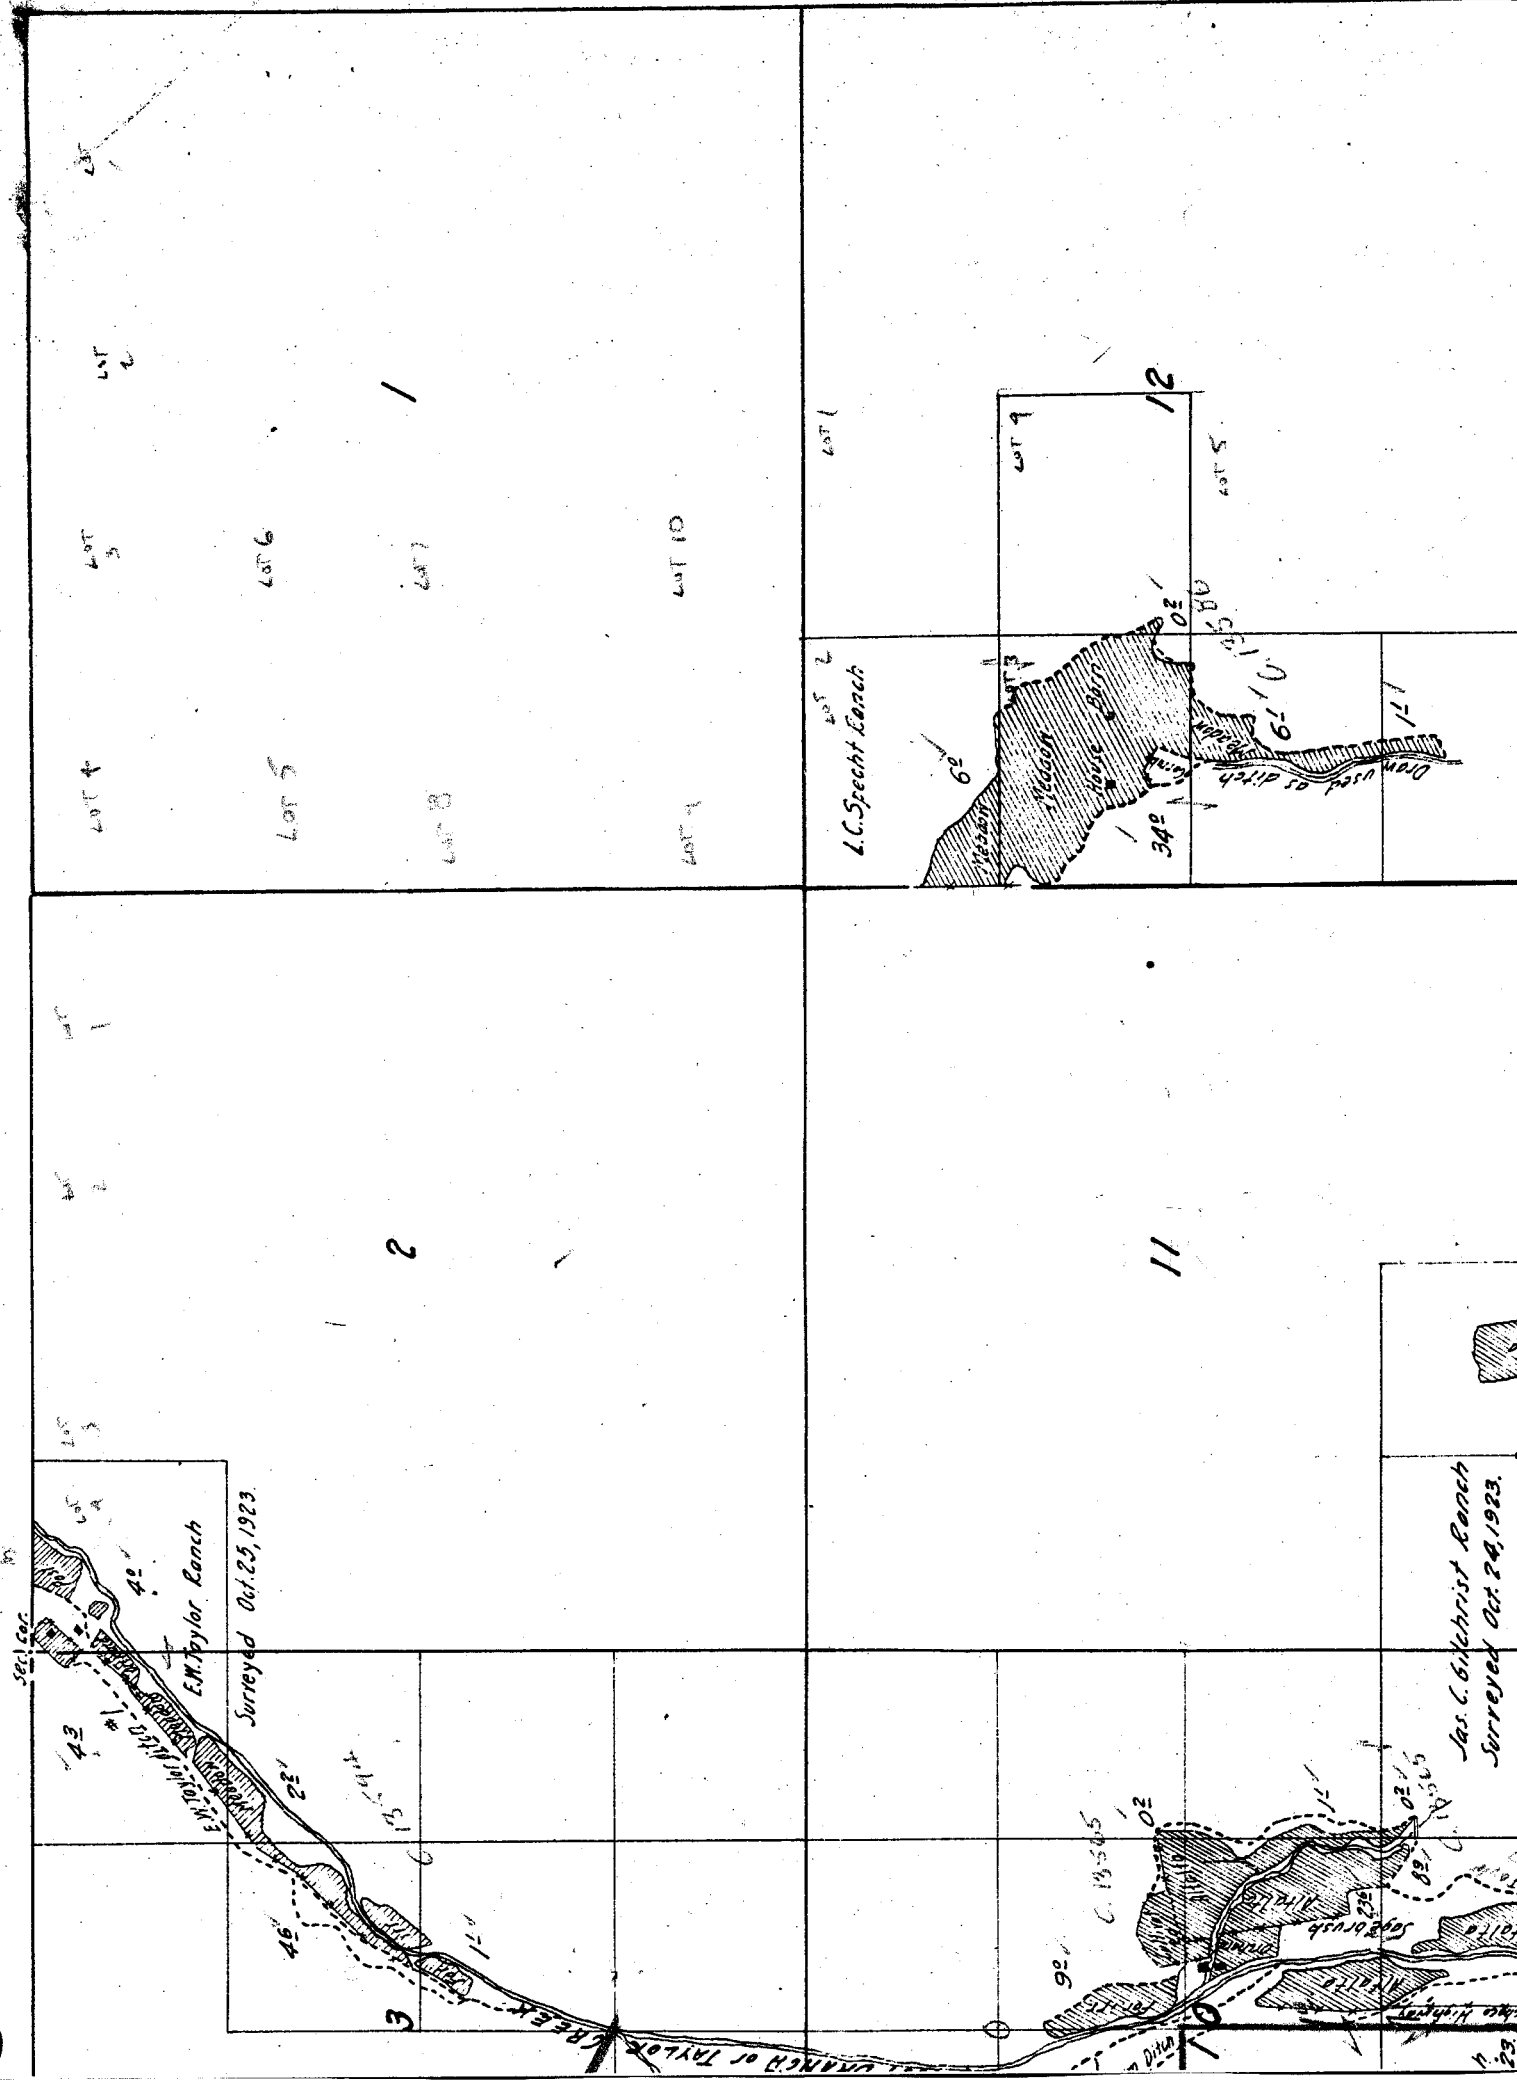

Surveyed Oct 24, 1923.

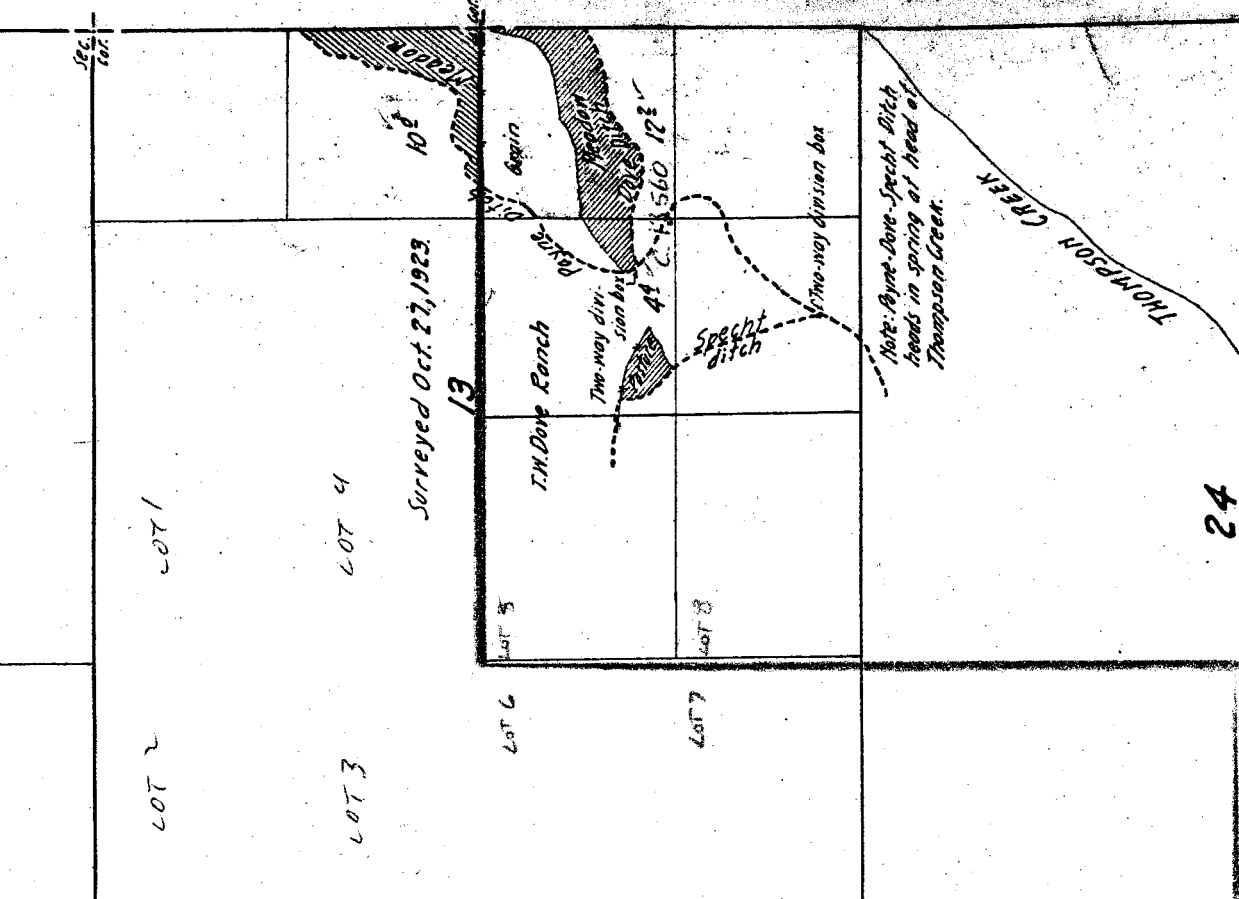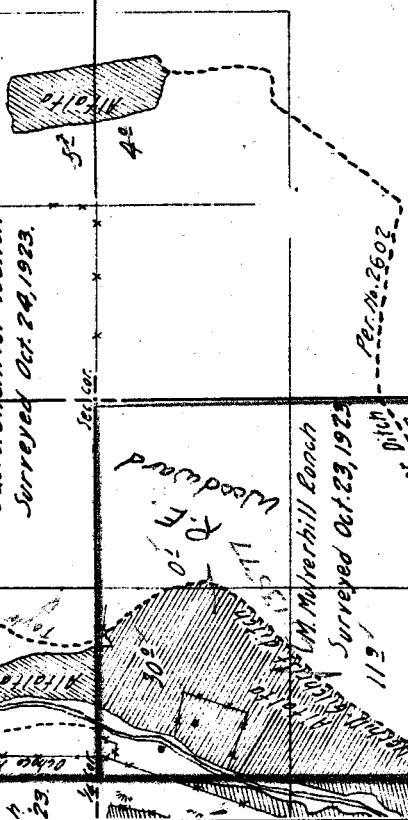

23

24

Surveyed Oct 24, 1923.

C.G. Lewis Ranch

Rail Creek

23

24

THOMPSON


26

25


Note:- Greys sketched in approximate location from U.S. Township plat, U.S. Forest Service map, and permit maps, except in vicinity of irrigated areas.

35

36

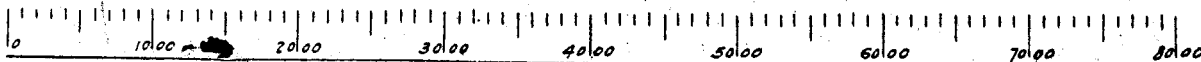

Scale of Feet.

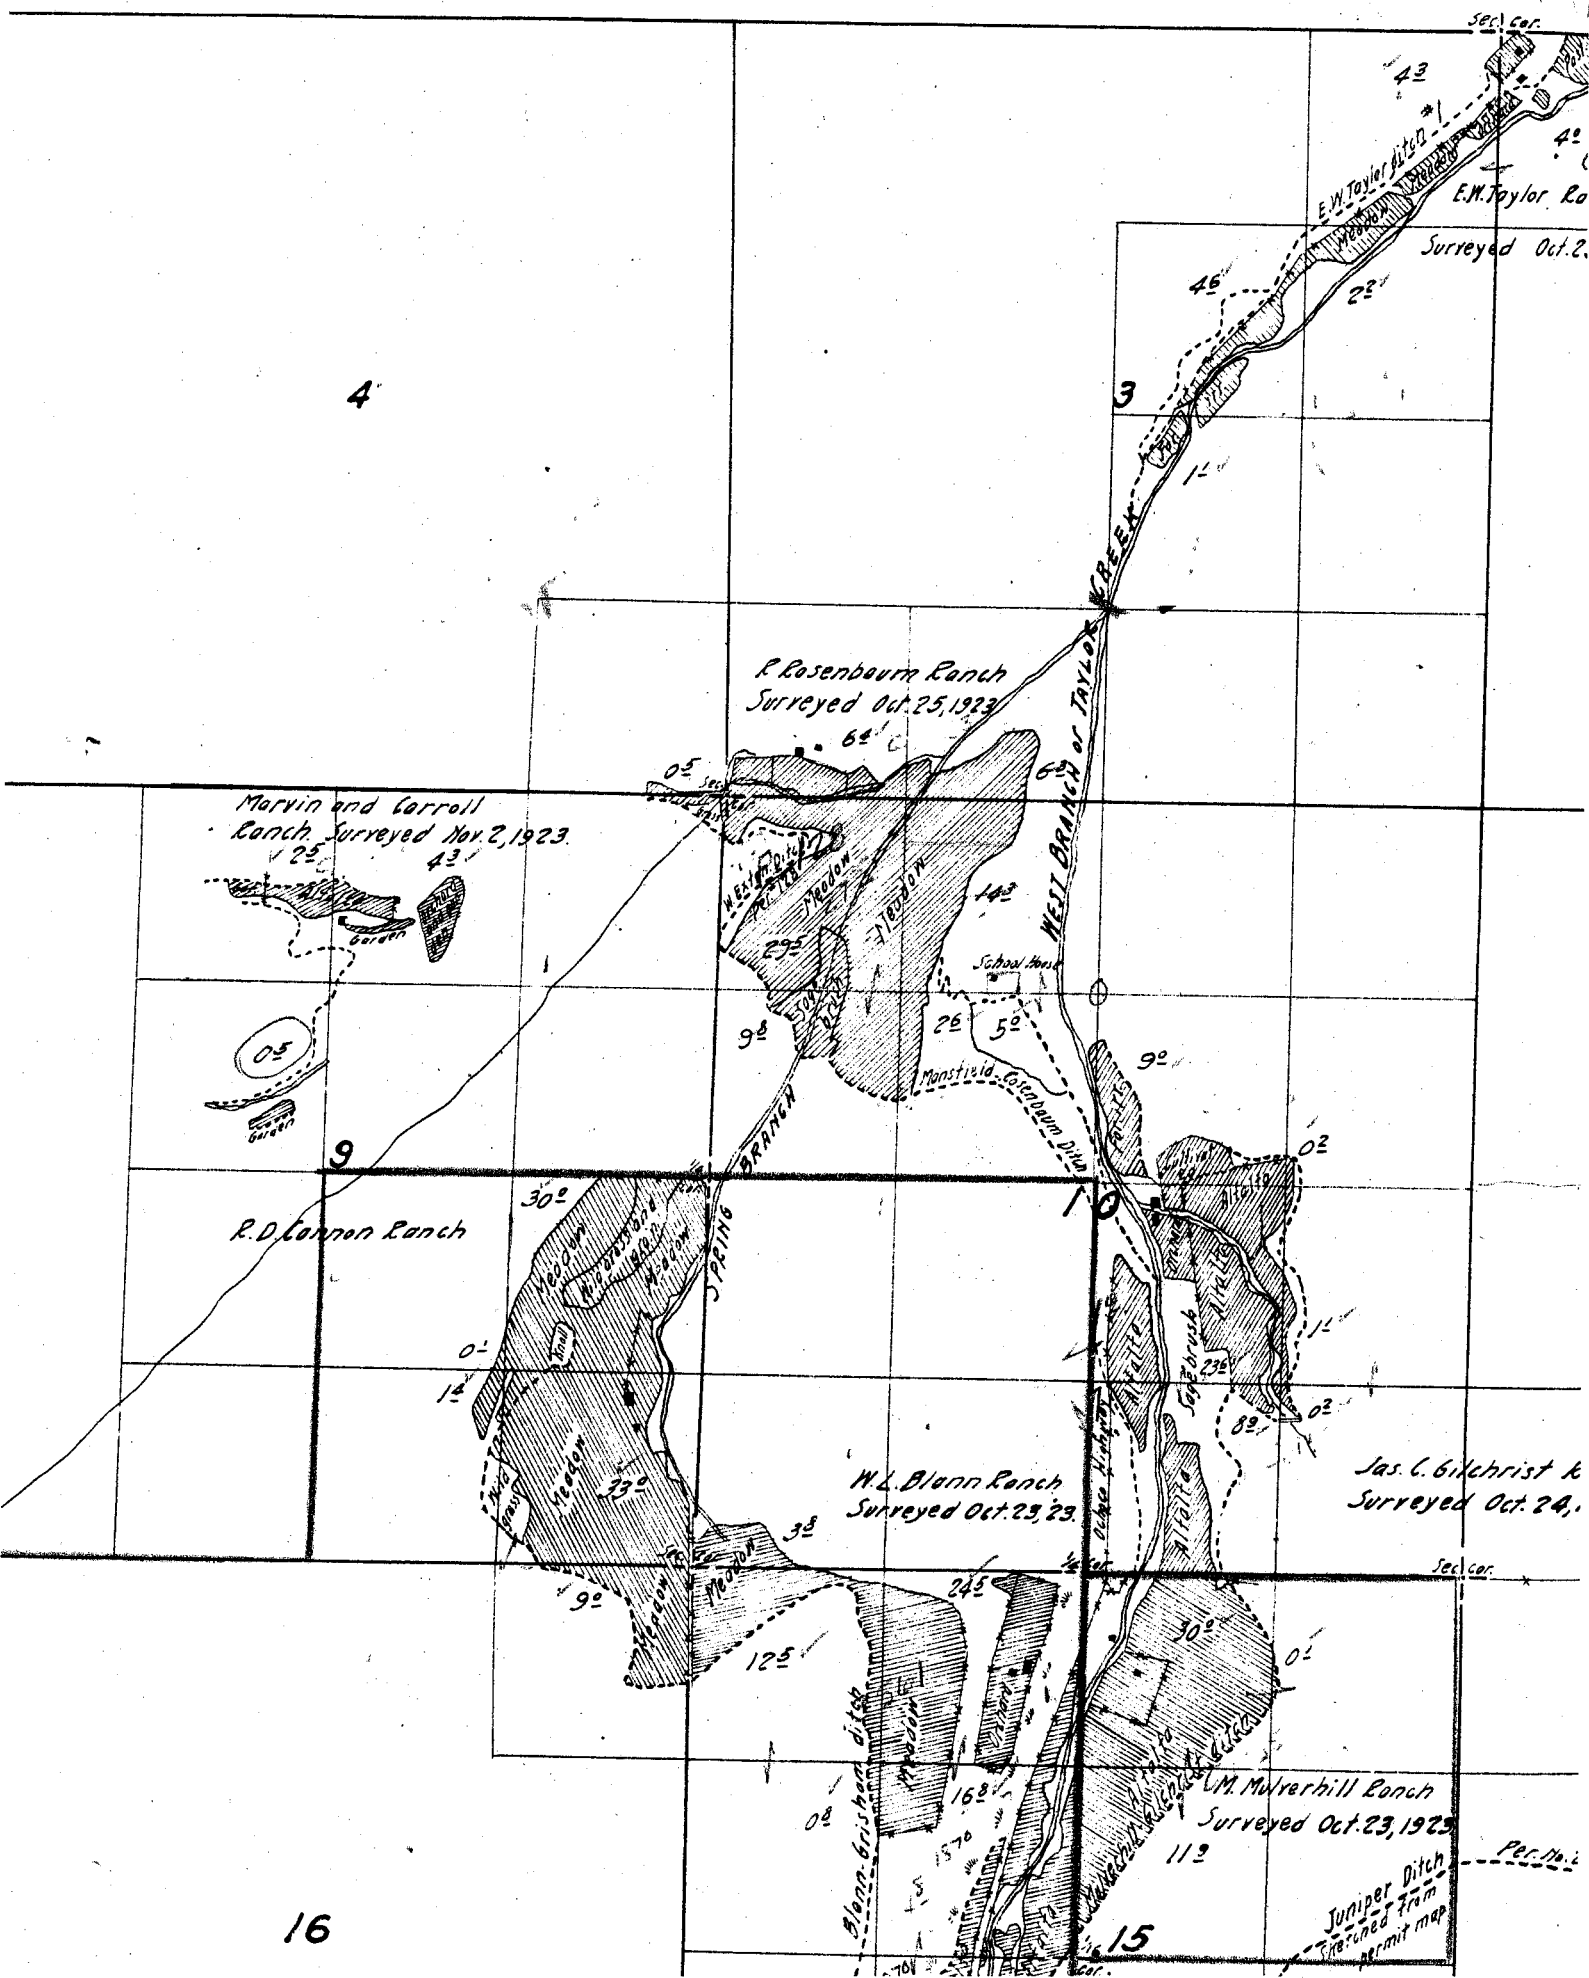

32

31

29

30

20

19