




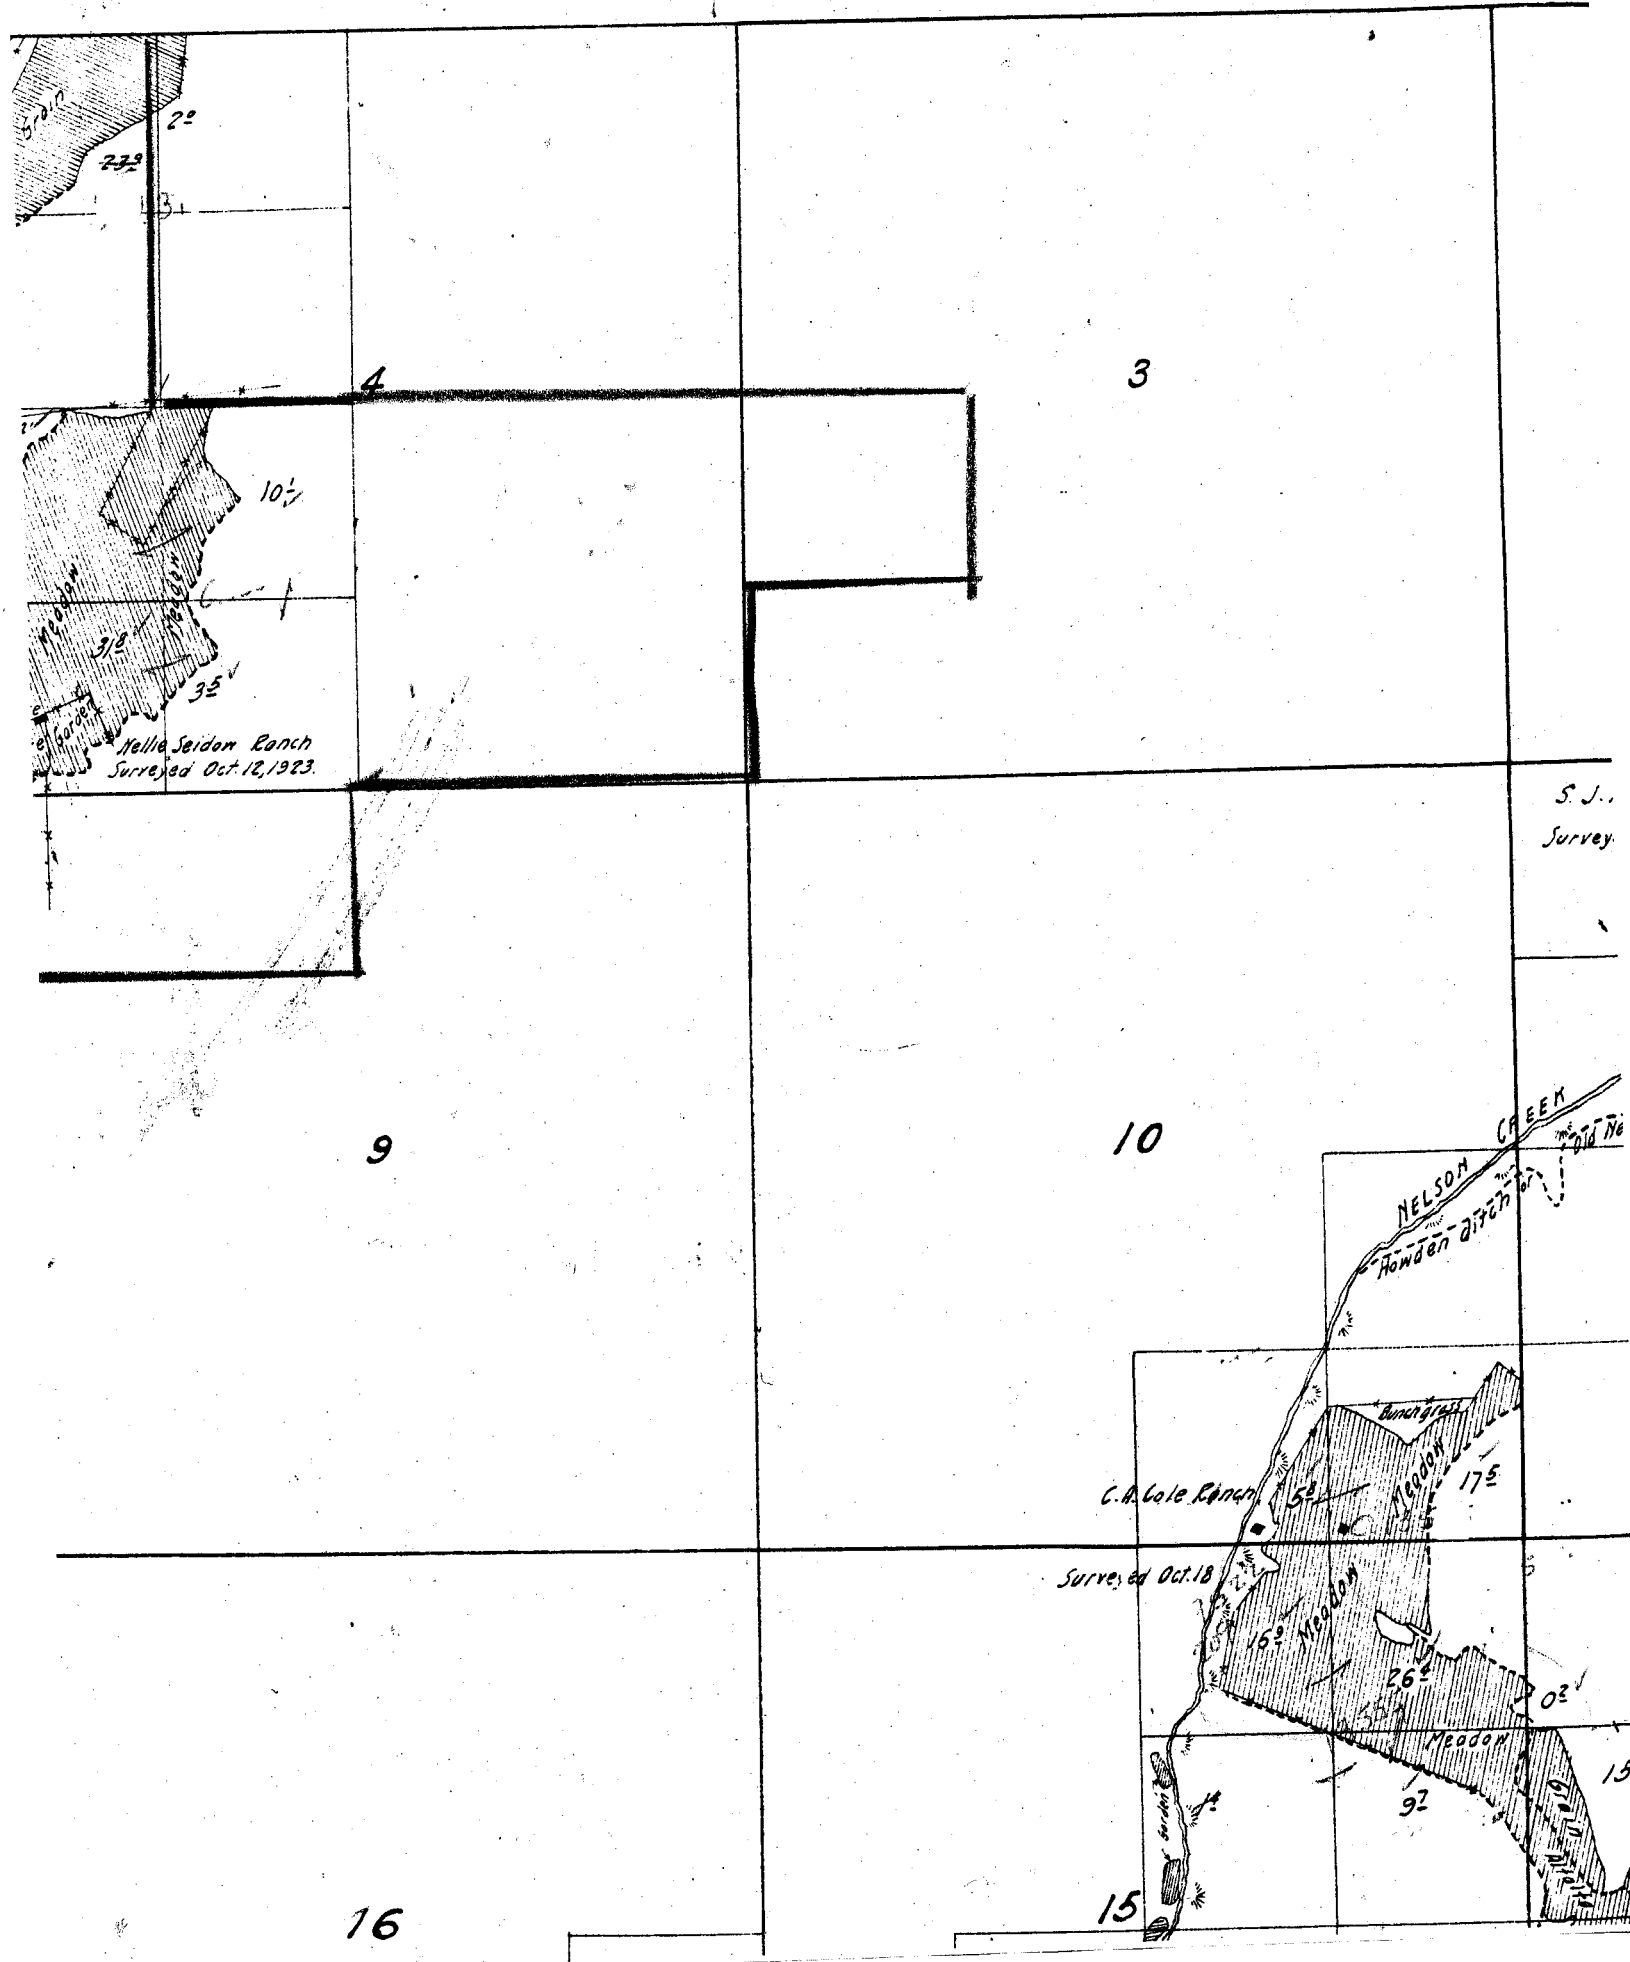


1101

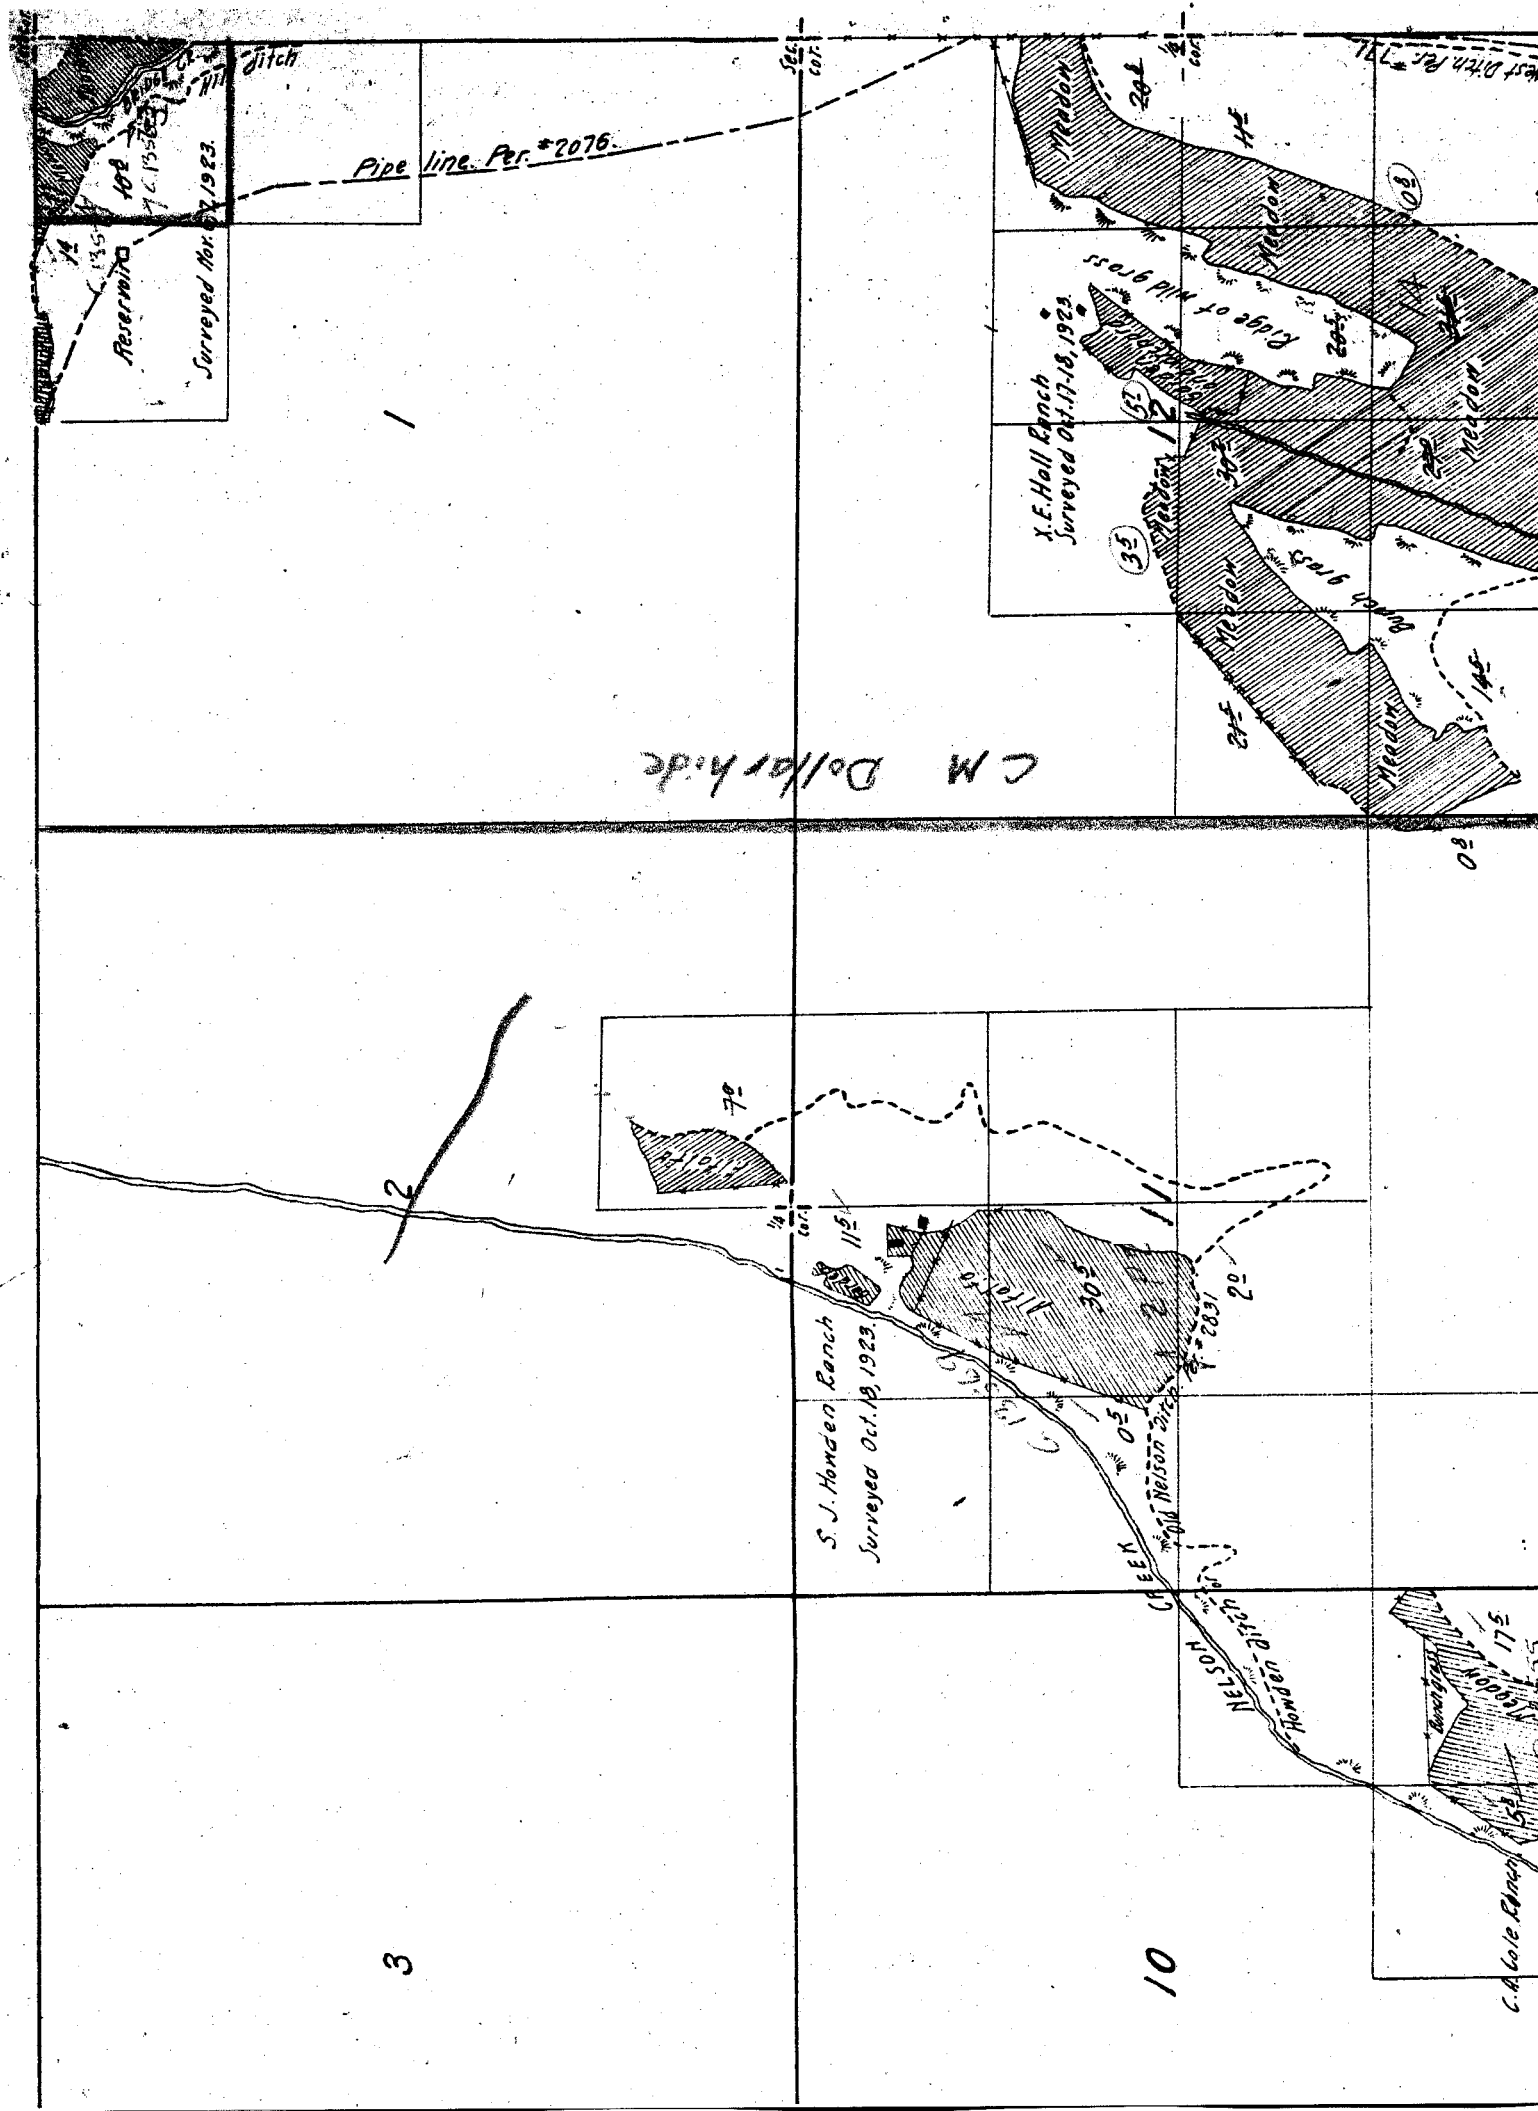

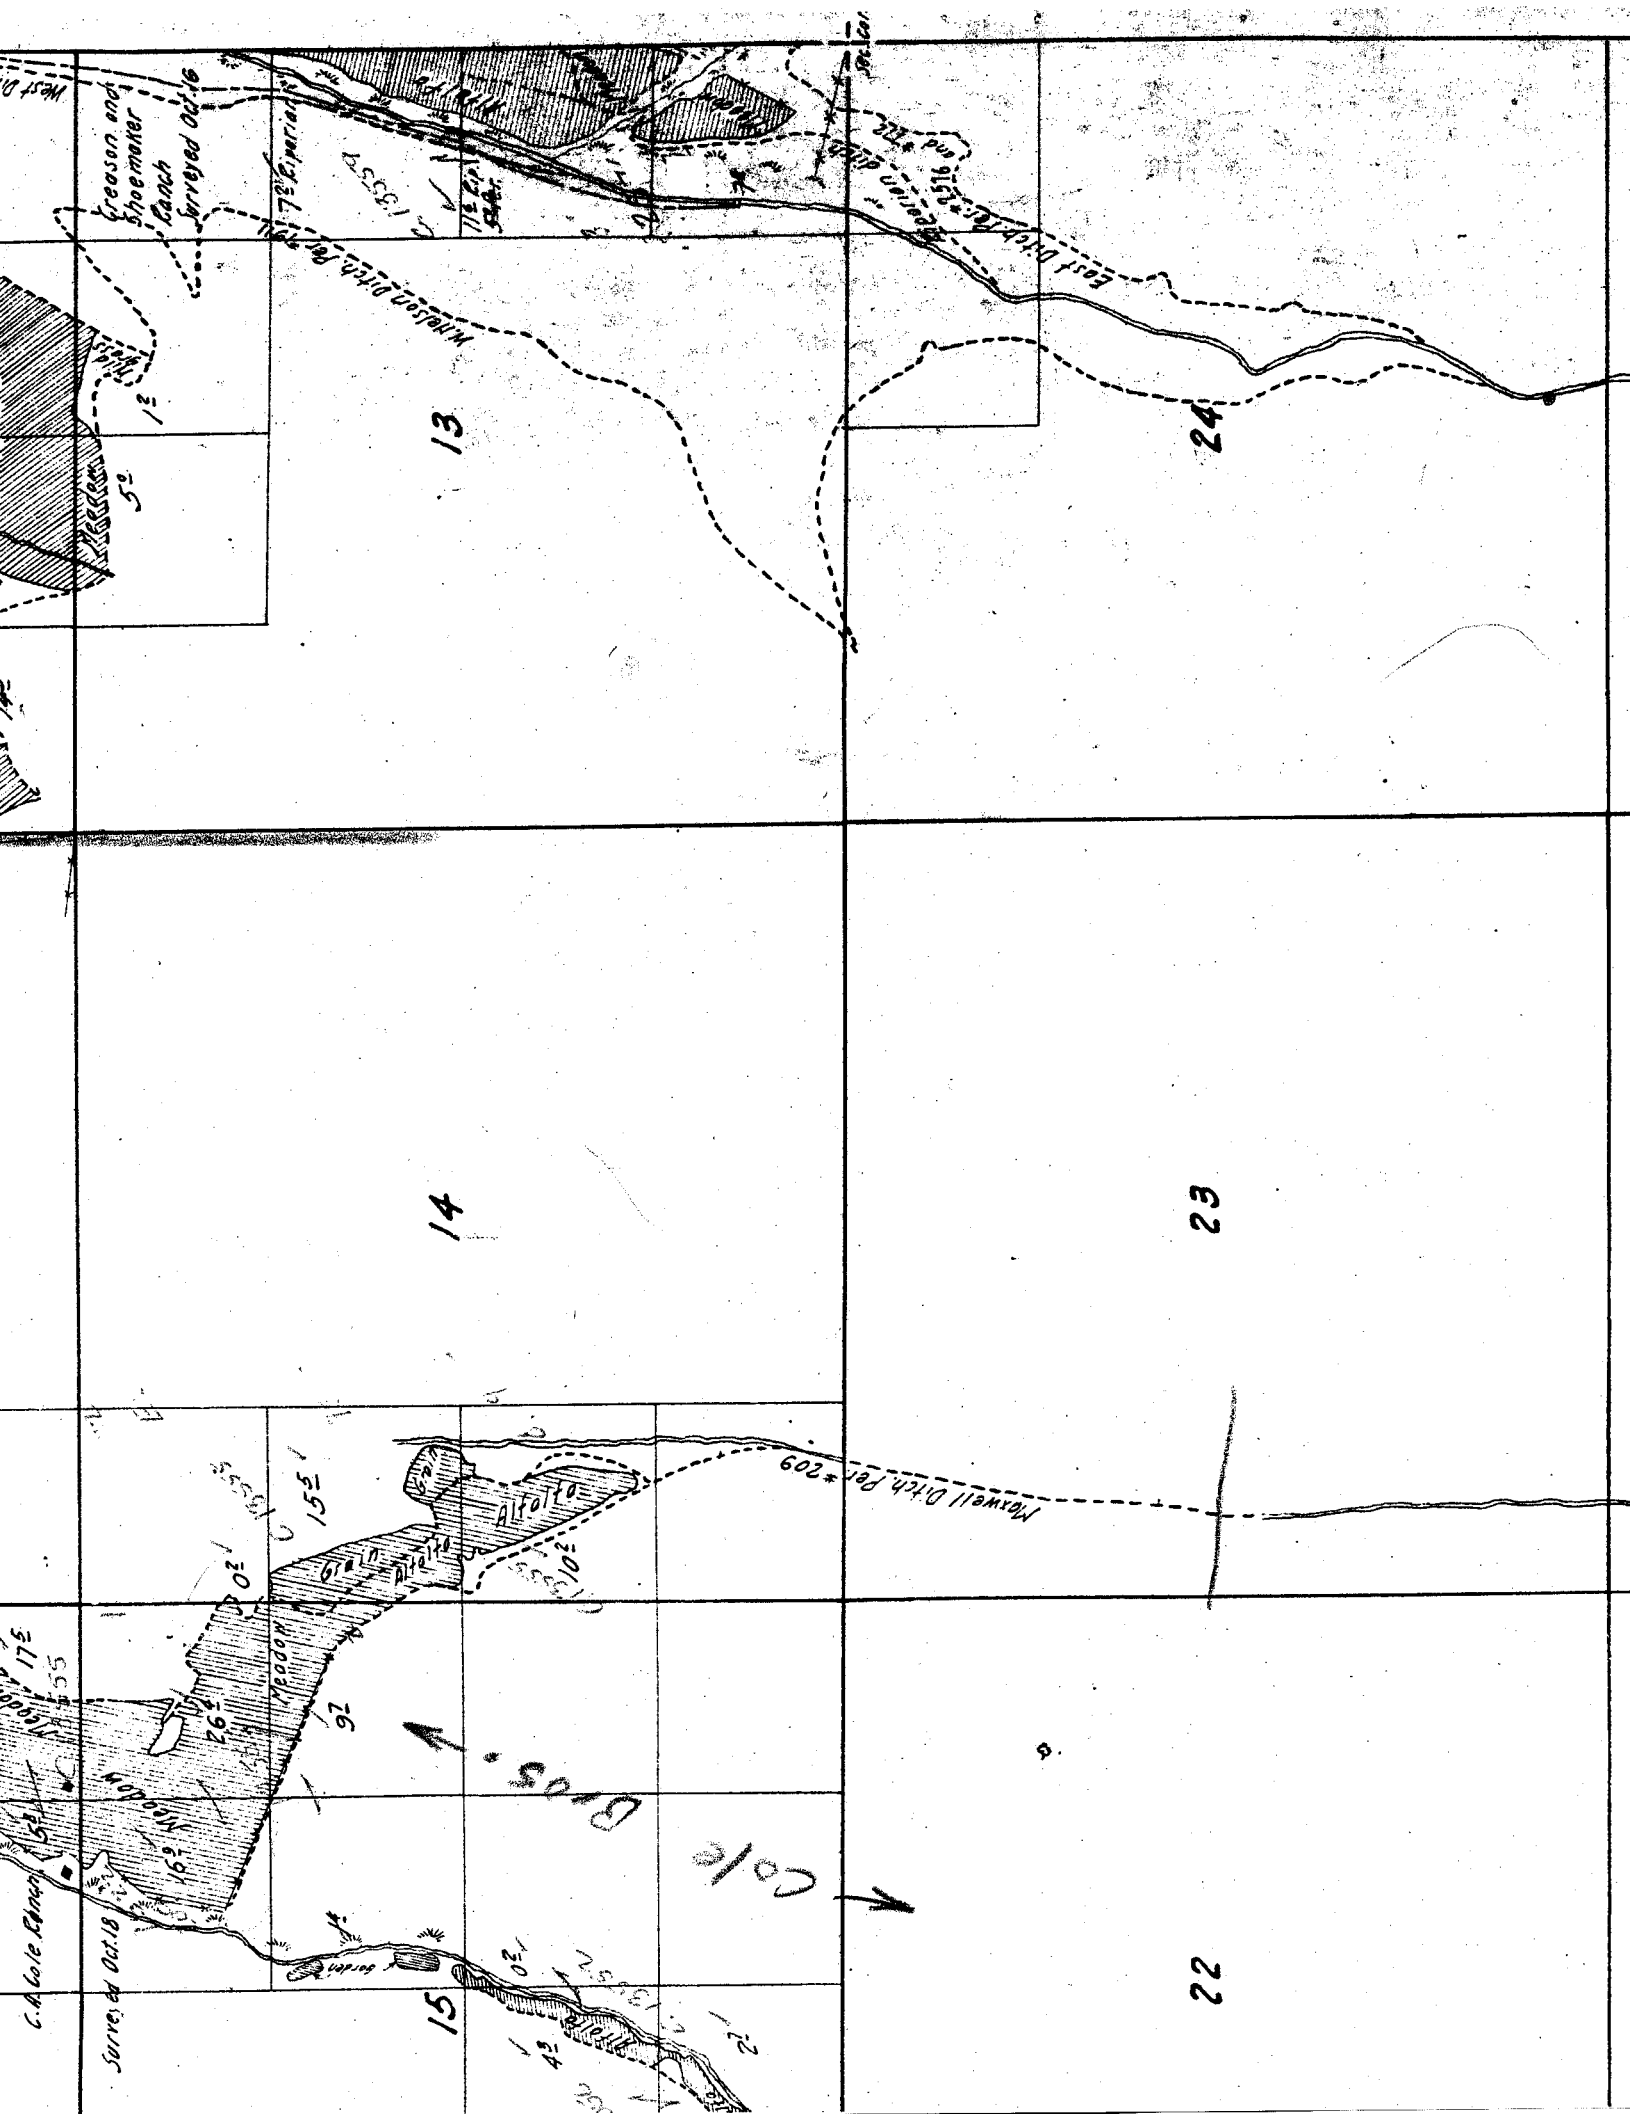

[illegible]

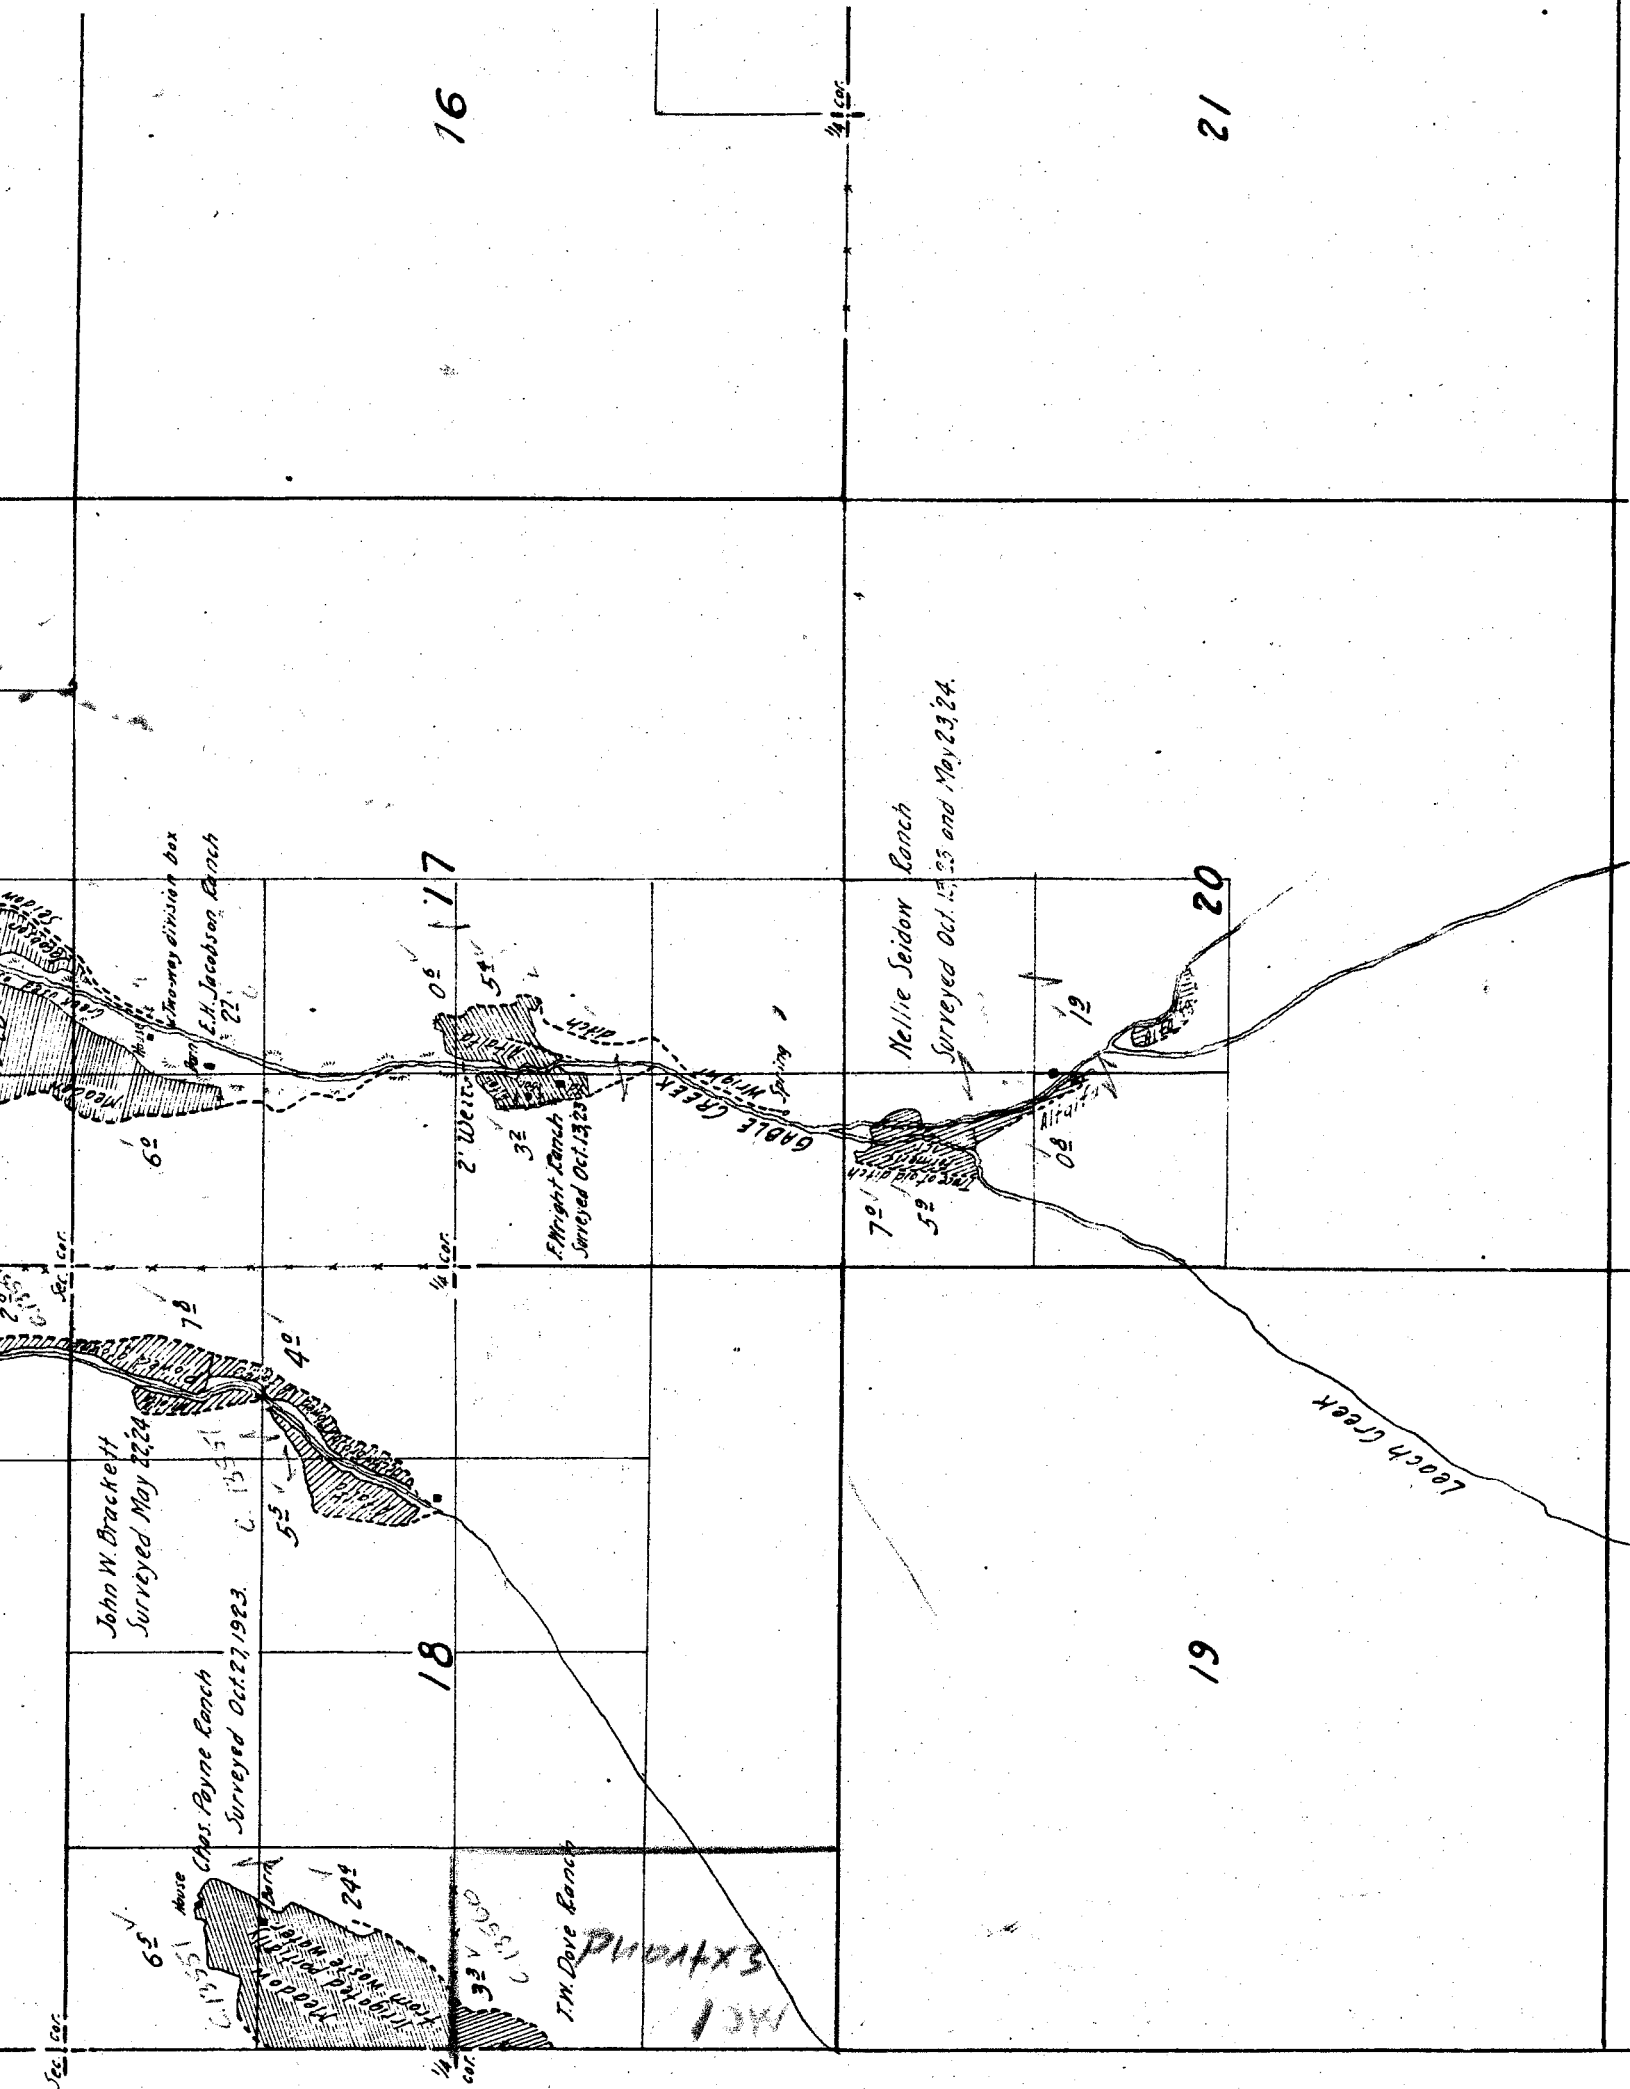

19

20

Leach Creek

30

29

31

32

23

24

26

25

MILL CREEK

35

36

*Note: - Creeks sketched in approximate location
from U.S. Township plats or from Forest Service
map except in vicinity of irrigated areas.
Permit ditches plotted in approximate location
from permit maps except in vicinity of irriga-
ted areas.*

*Scale of Feet.*

G.W. Nelson Reservoir
Per #462

28

27

33

34

Maxwell Creek

1000 ft

12324

16

21


22

1/100



Nelson and Campbell
Fence
Surveyed Oct. 19, 1923, E. 1/4

6 ft. Nelson ditch
Per. #4325

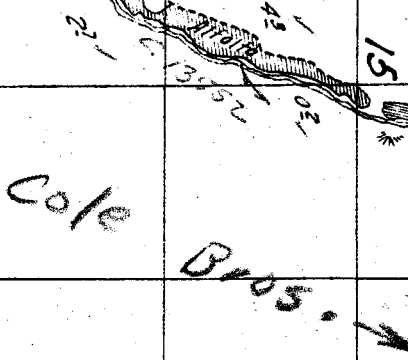

Cole Bros.

Maxwell Ditch, Per. #209

Surveyed Oct. 18

