




S. , Range 26 E. W. M.

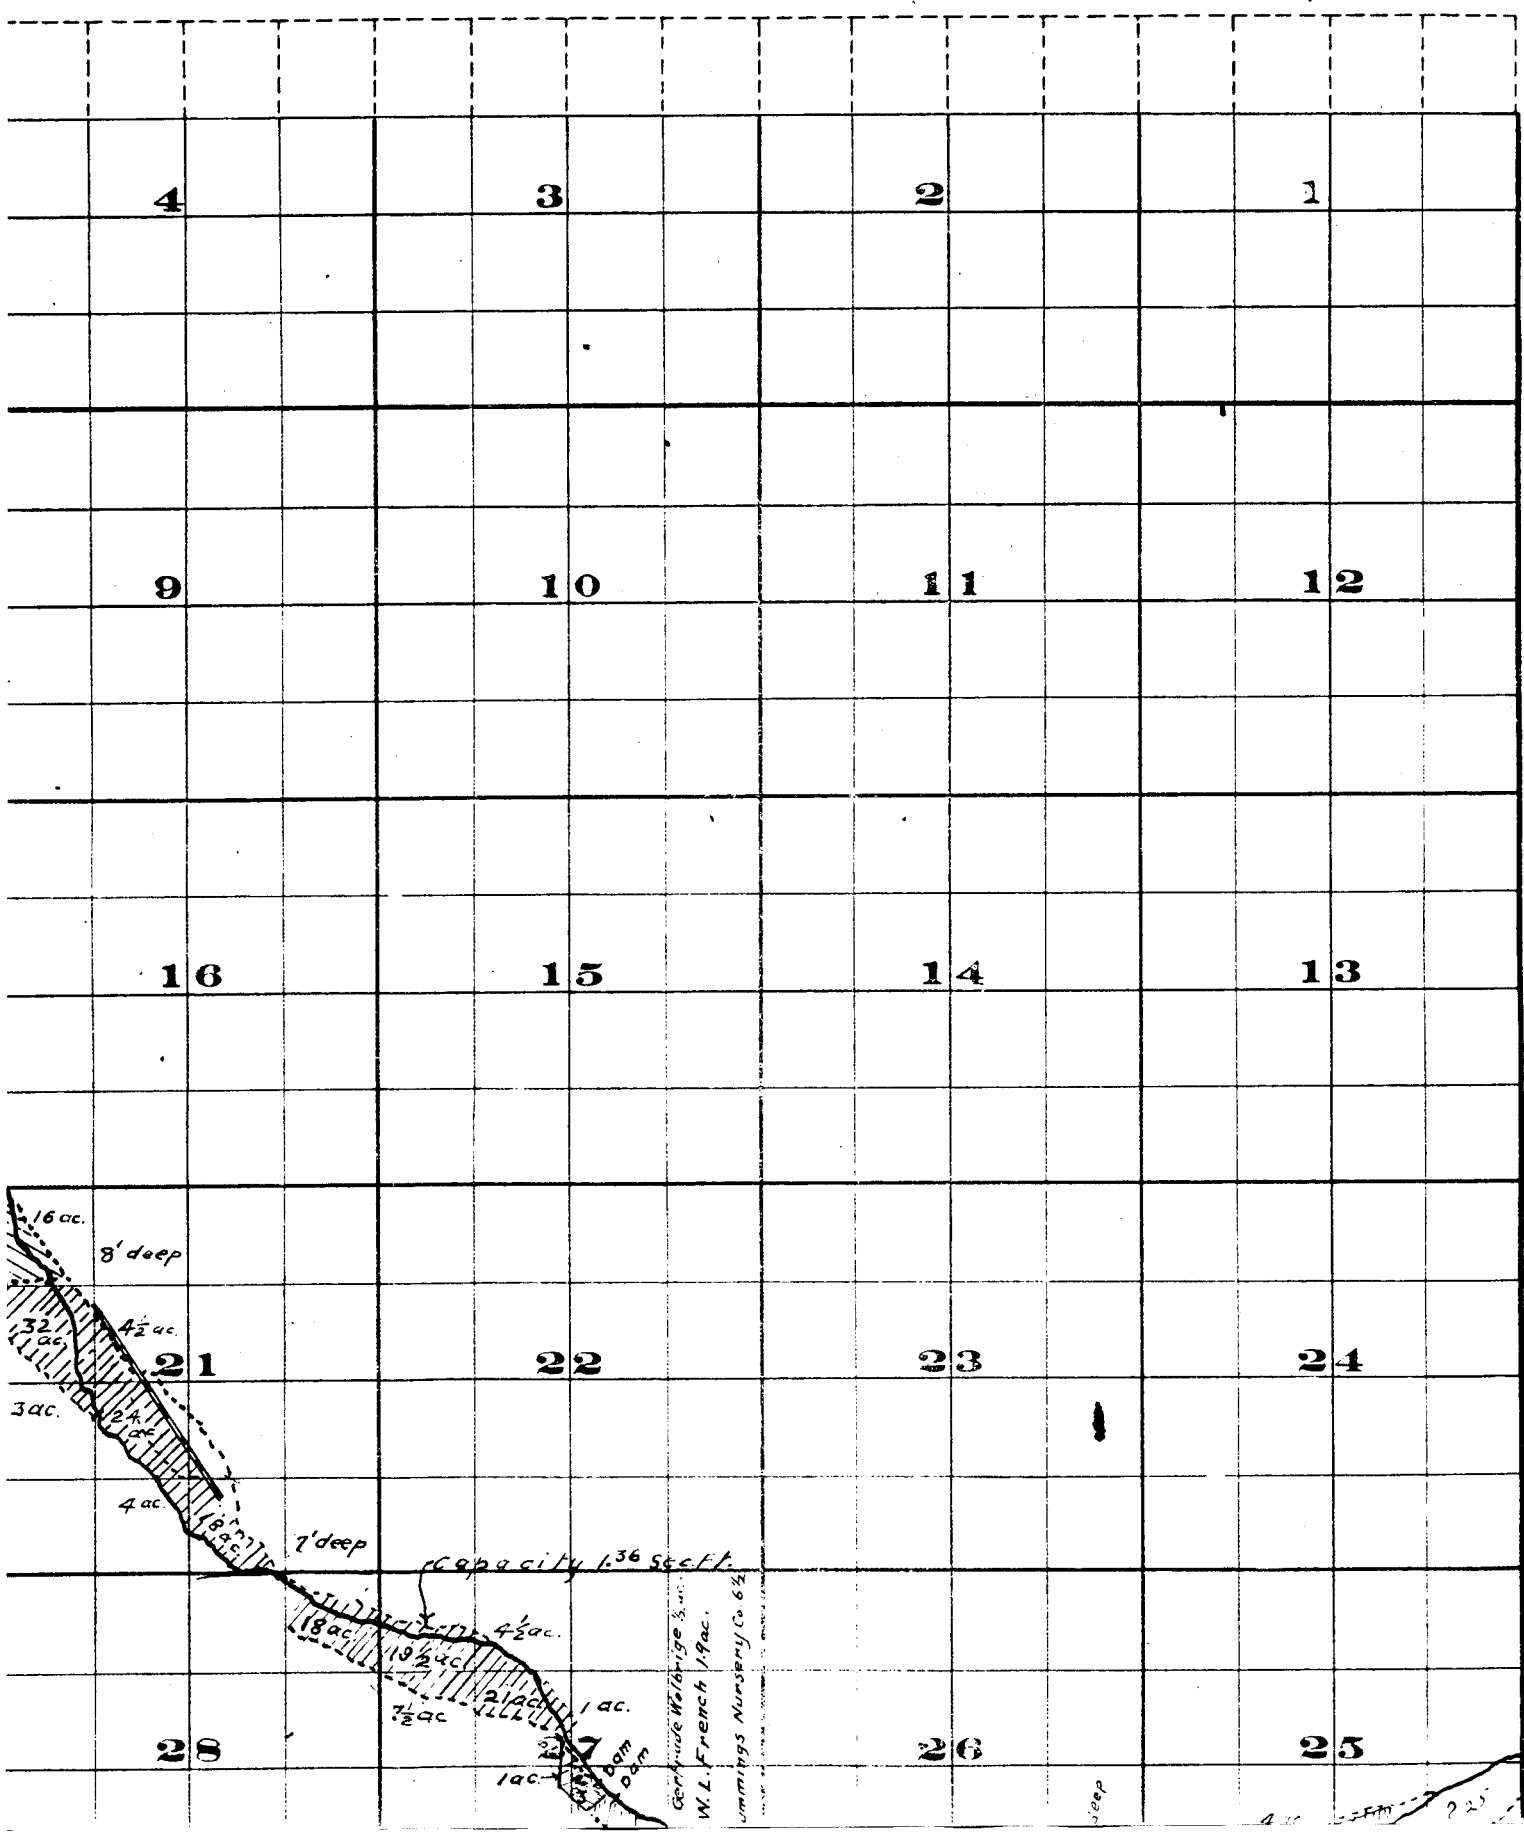

# Township 2 S.

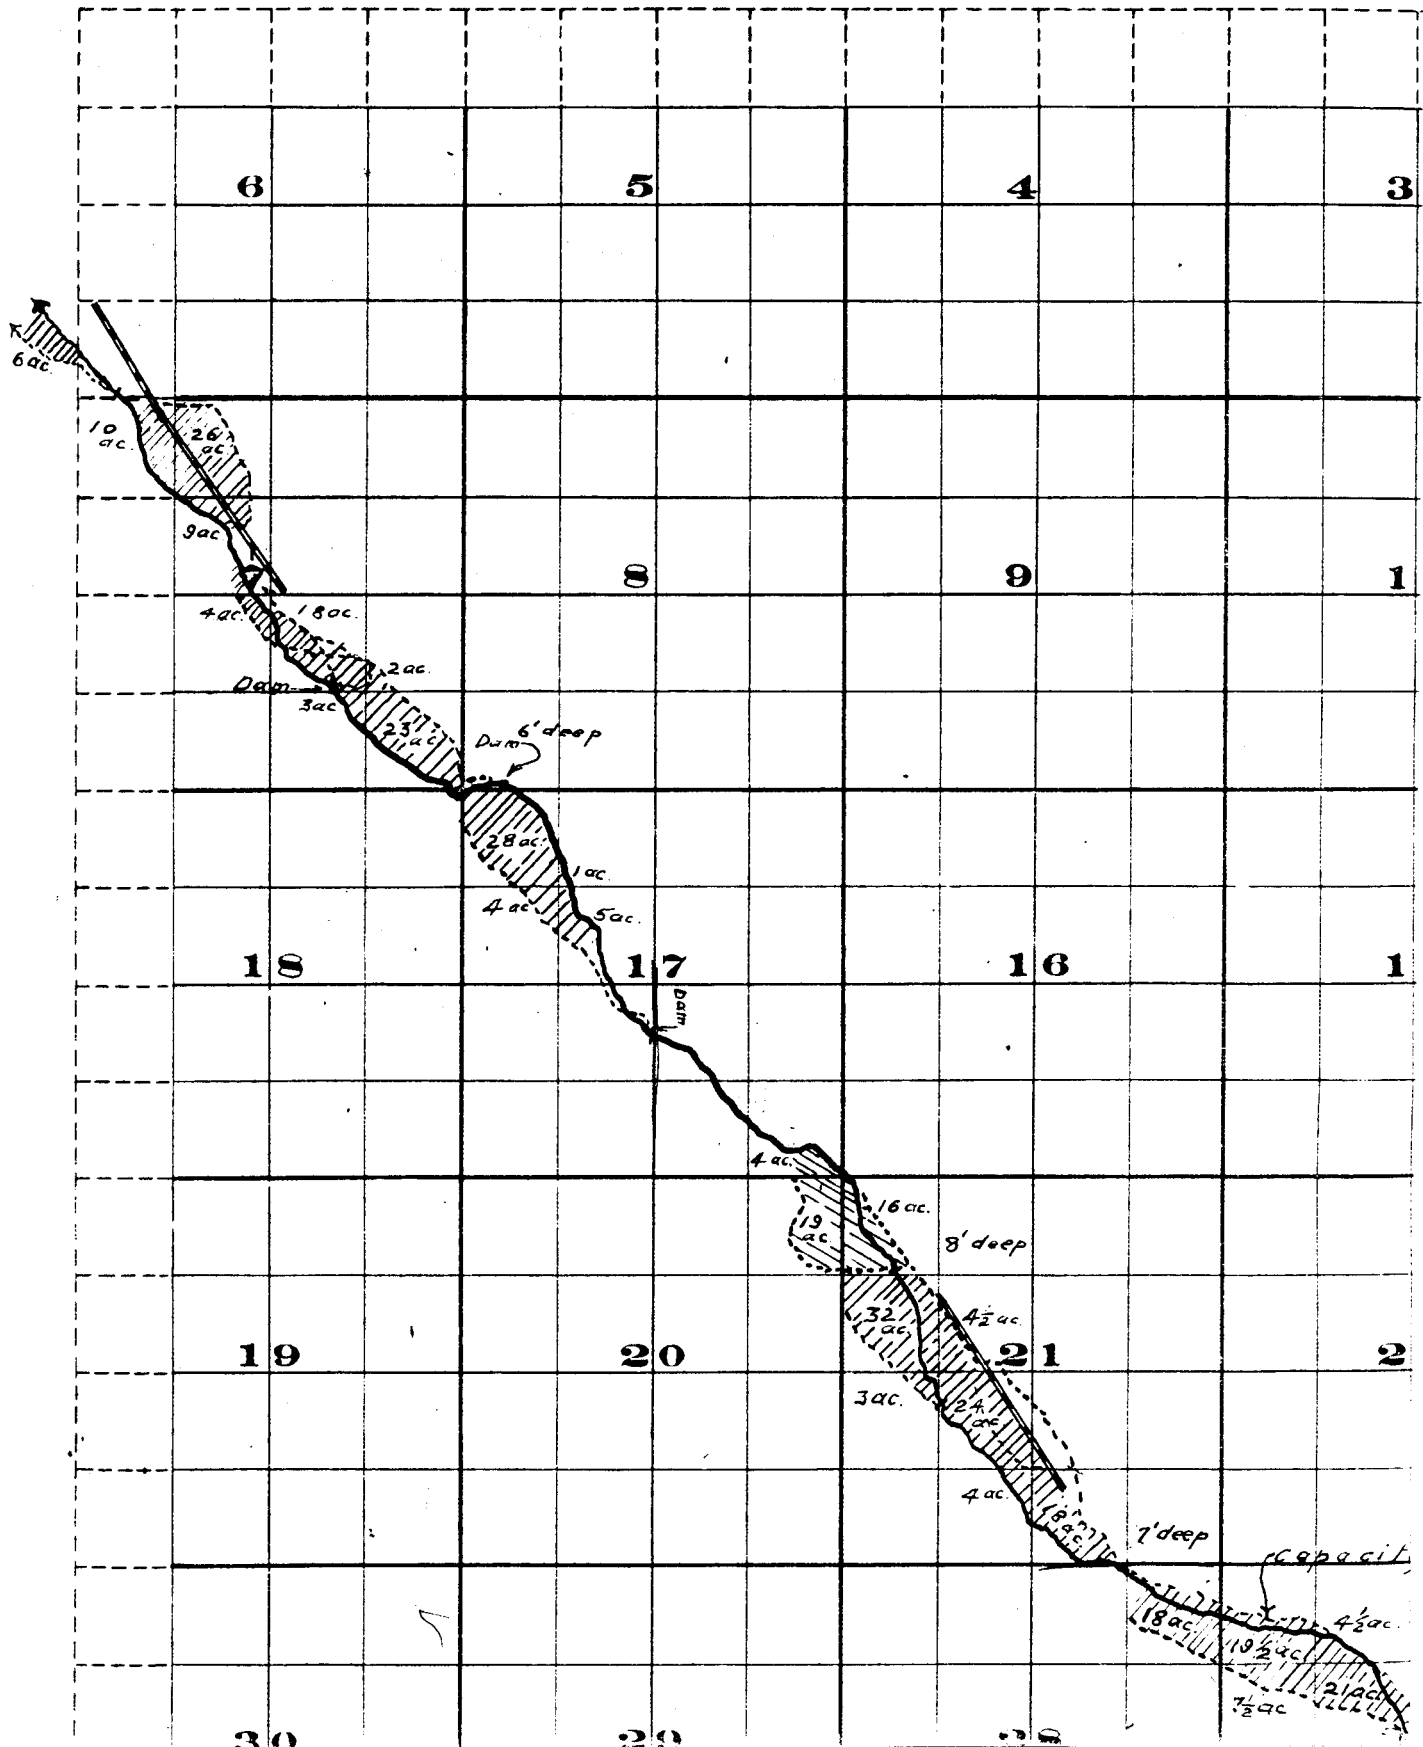

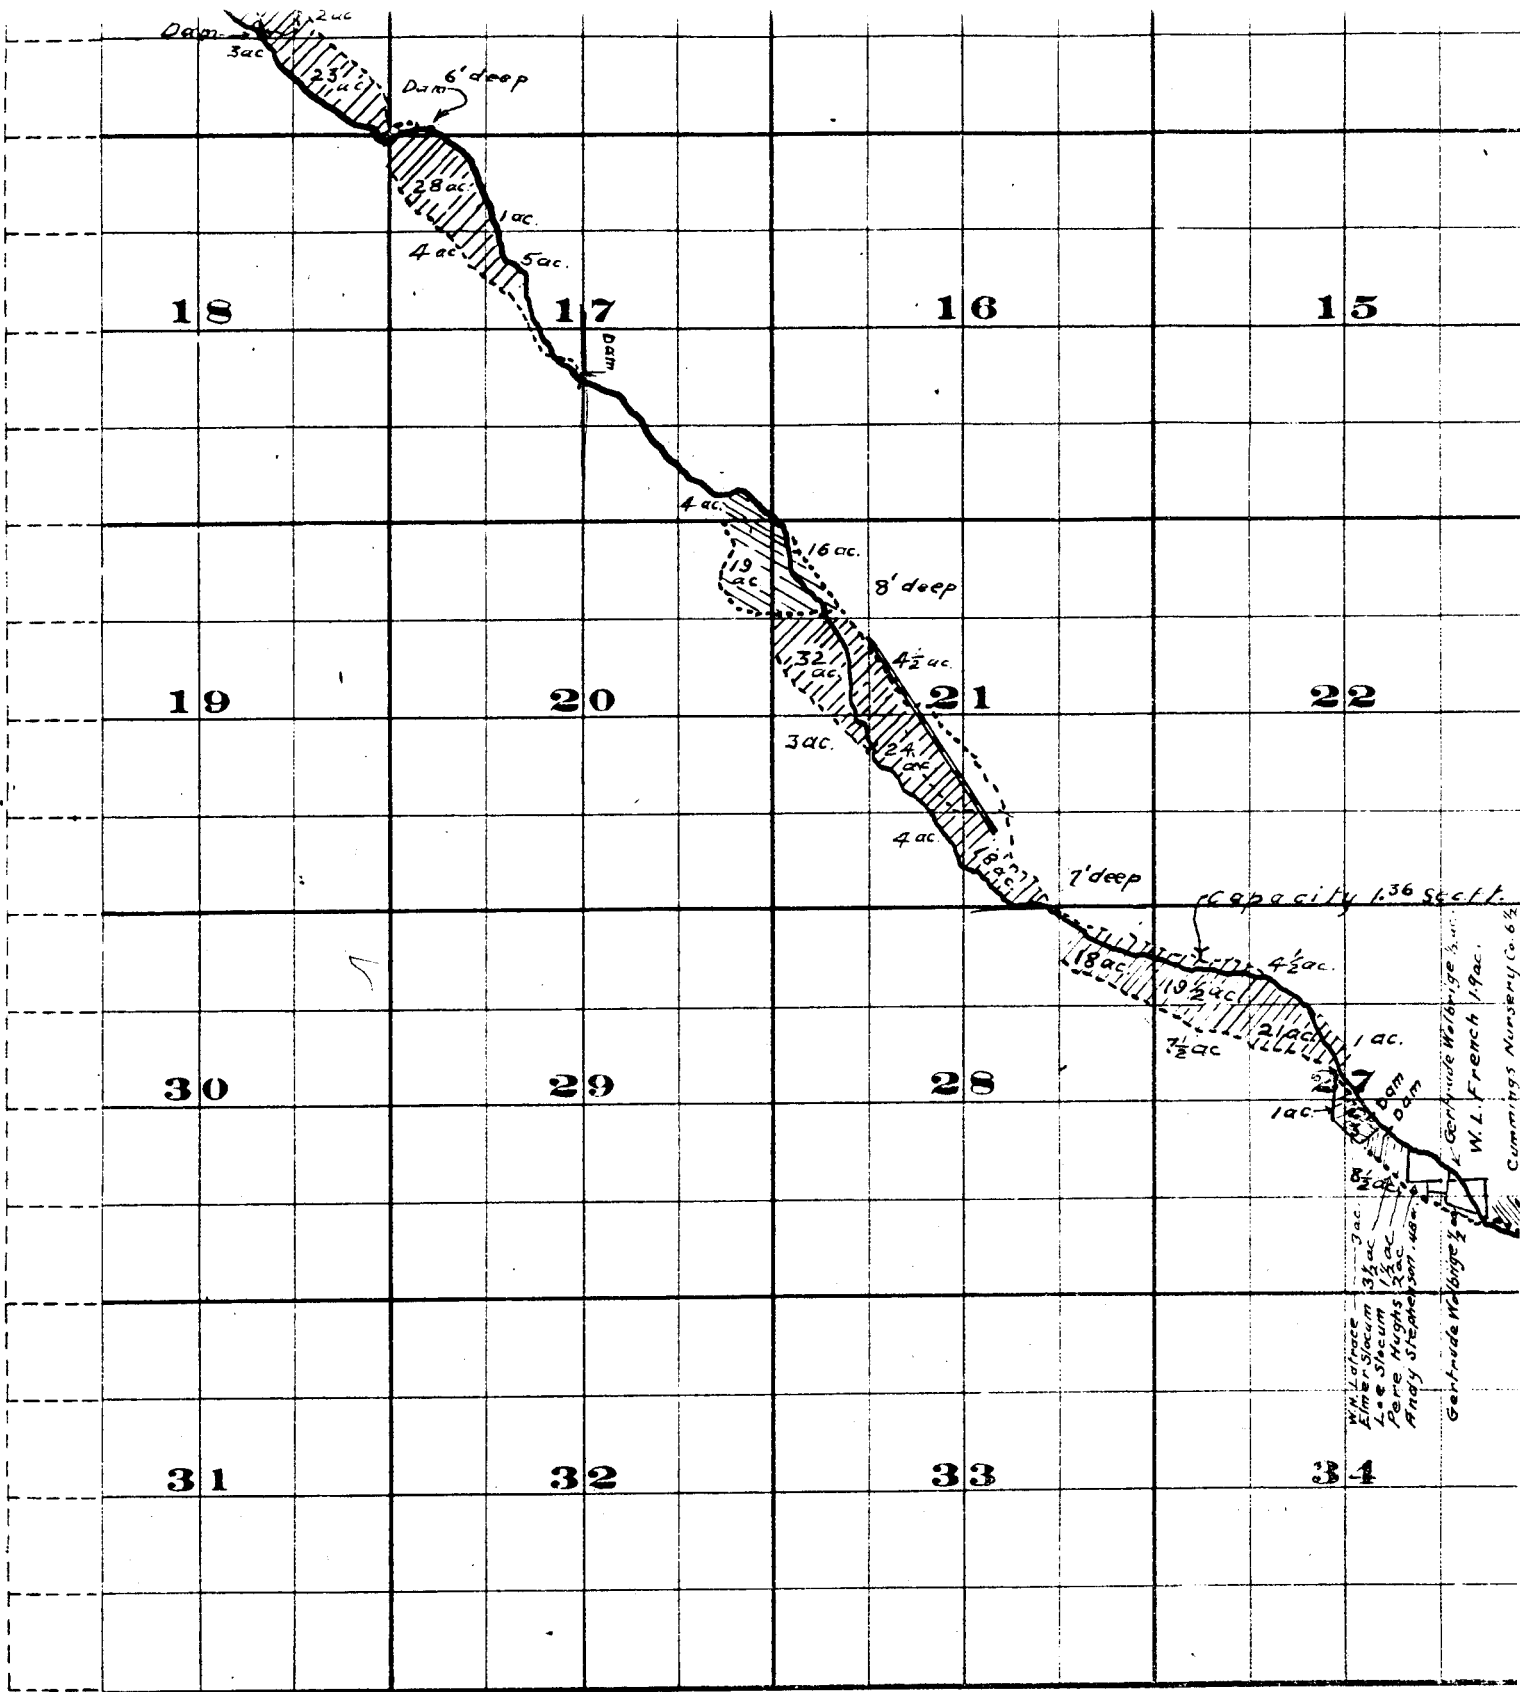


THE S. A. BRISTOL CO., PRINTERS & BOUNDERS CHATTANOOGA, TENN.

Surveyed by R.D. Cooper July 1909

John H. Lewis - State Engineer.

Examined July 14, 1909.



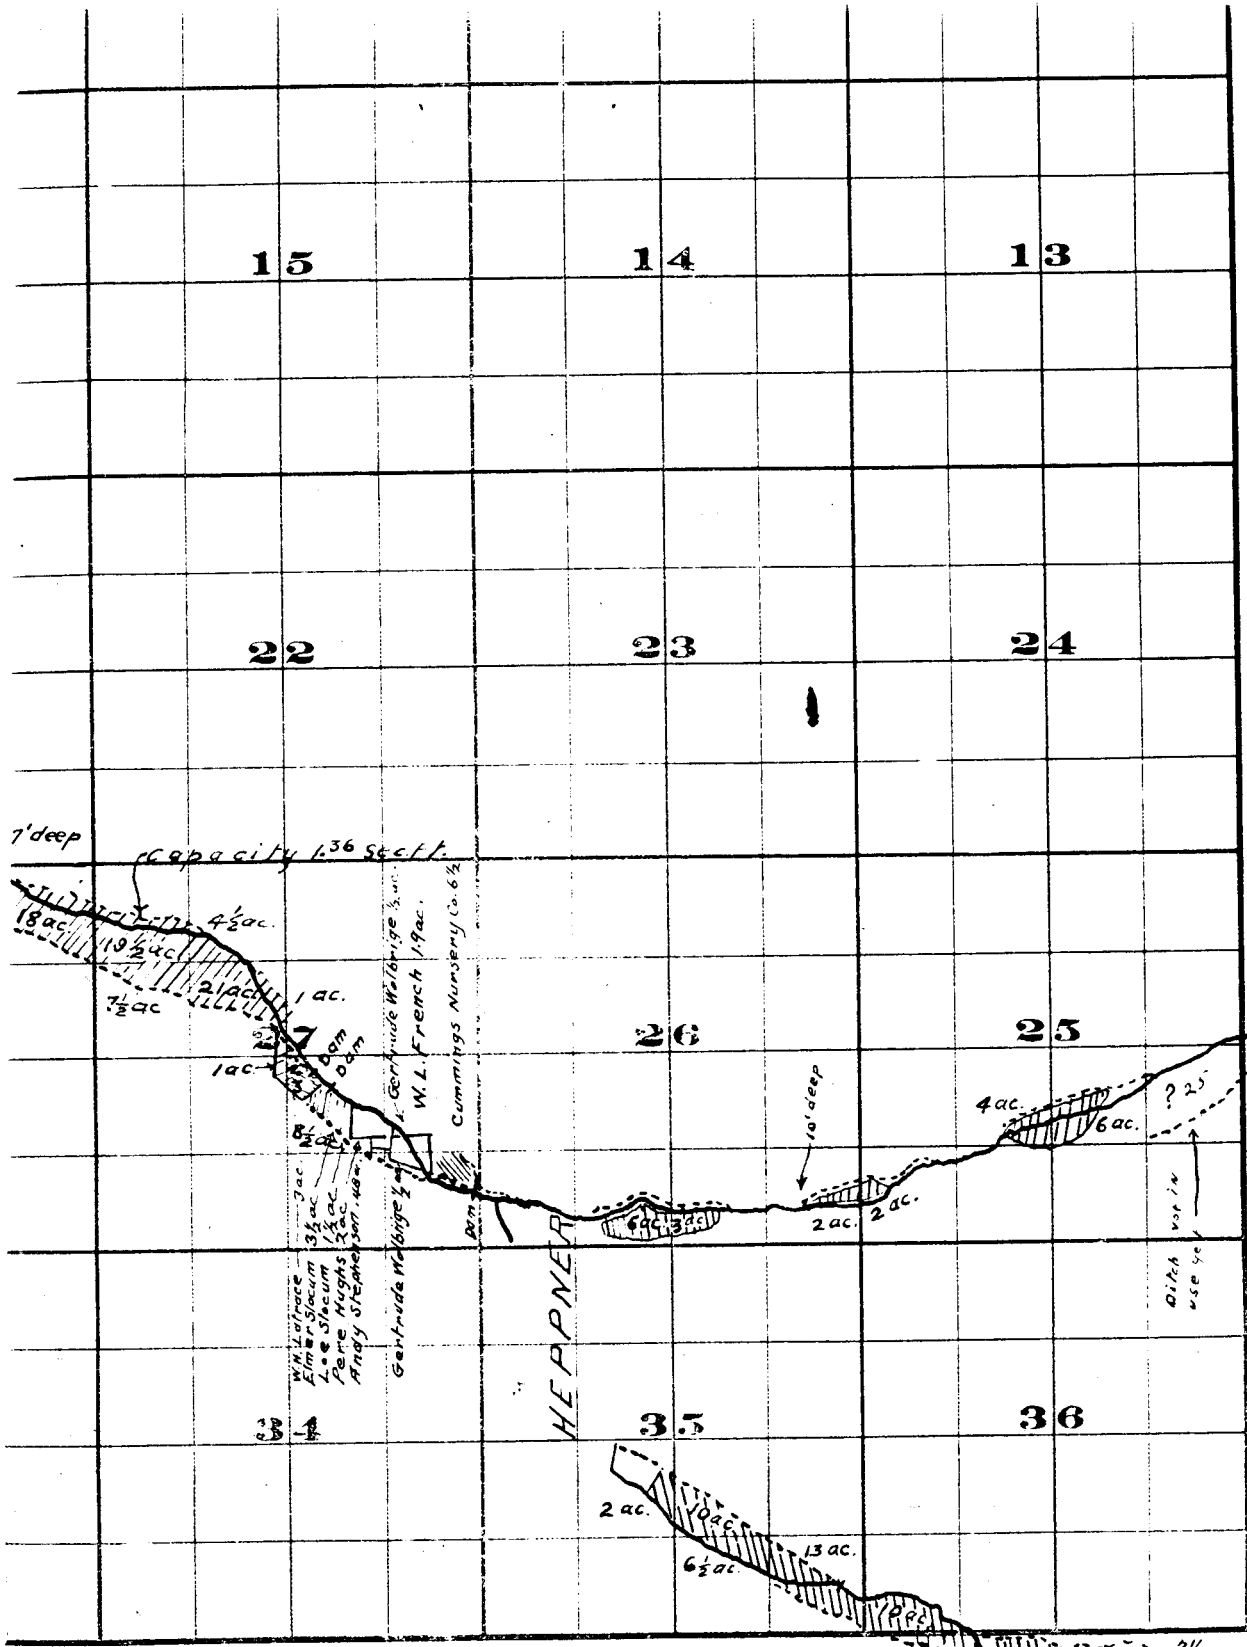

Willow Creek Adjudication

Part 3 S. 26  
 2 S. 26