


Showing 160 A. of Sect. 8.
T. 11. S. R. 15 E

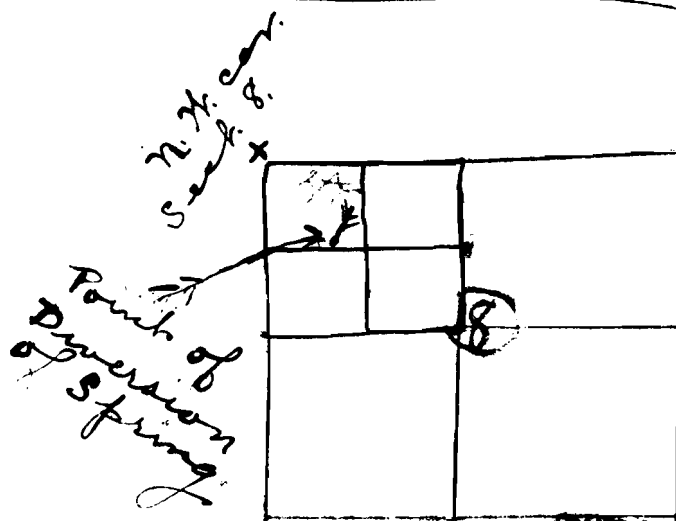

OFFICE OF THE ENGINEER

RECEIVED

JUN 14 1912

WATER DIVISION

Application No. 3015

Permit No. 1665