


SECTION

TOWNSHIP 42, RANGE 111, W. M.

North

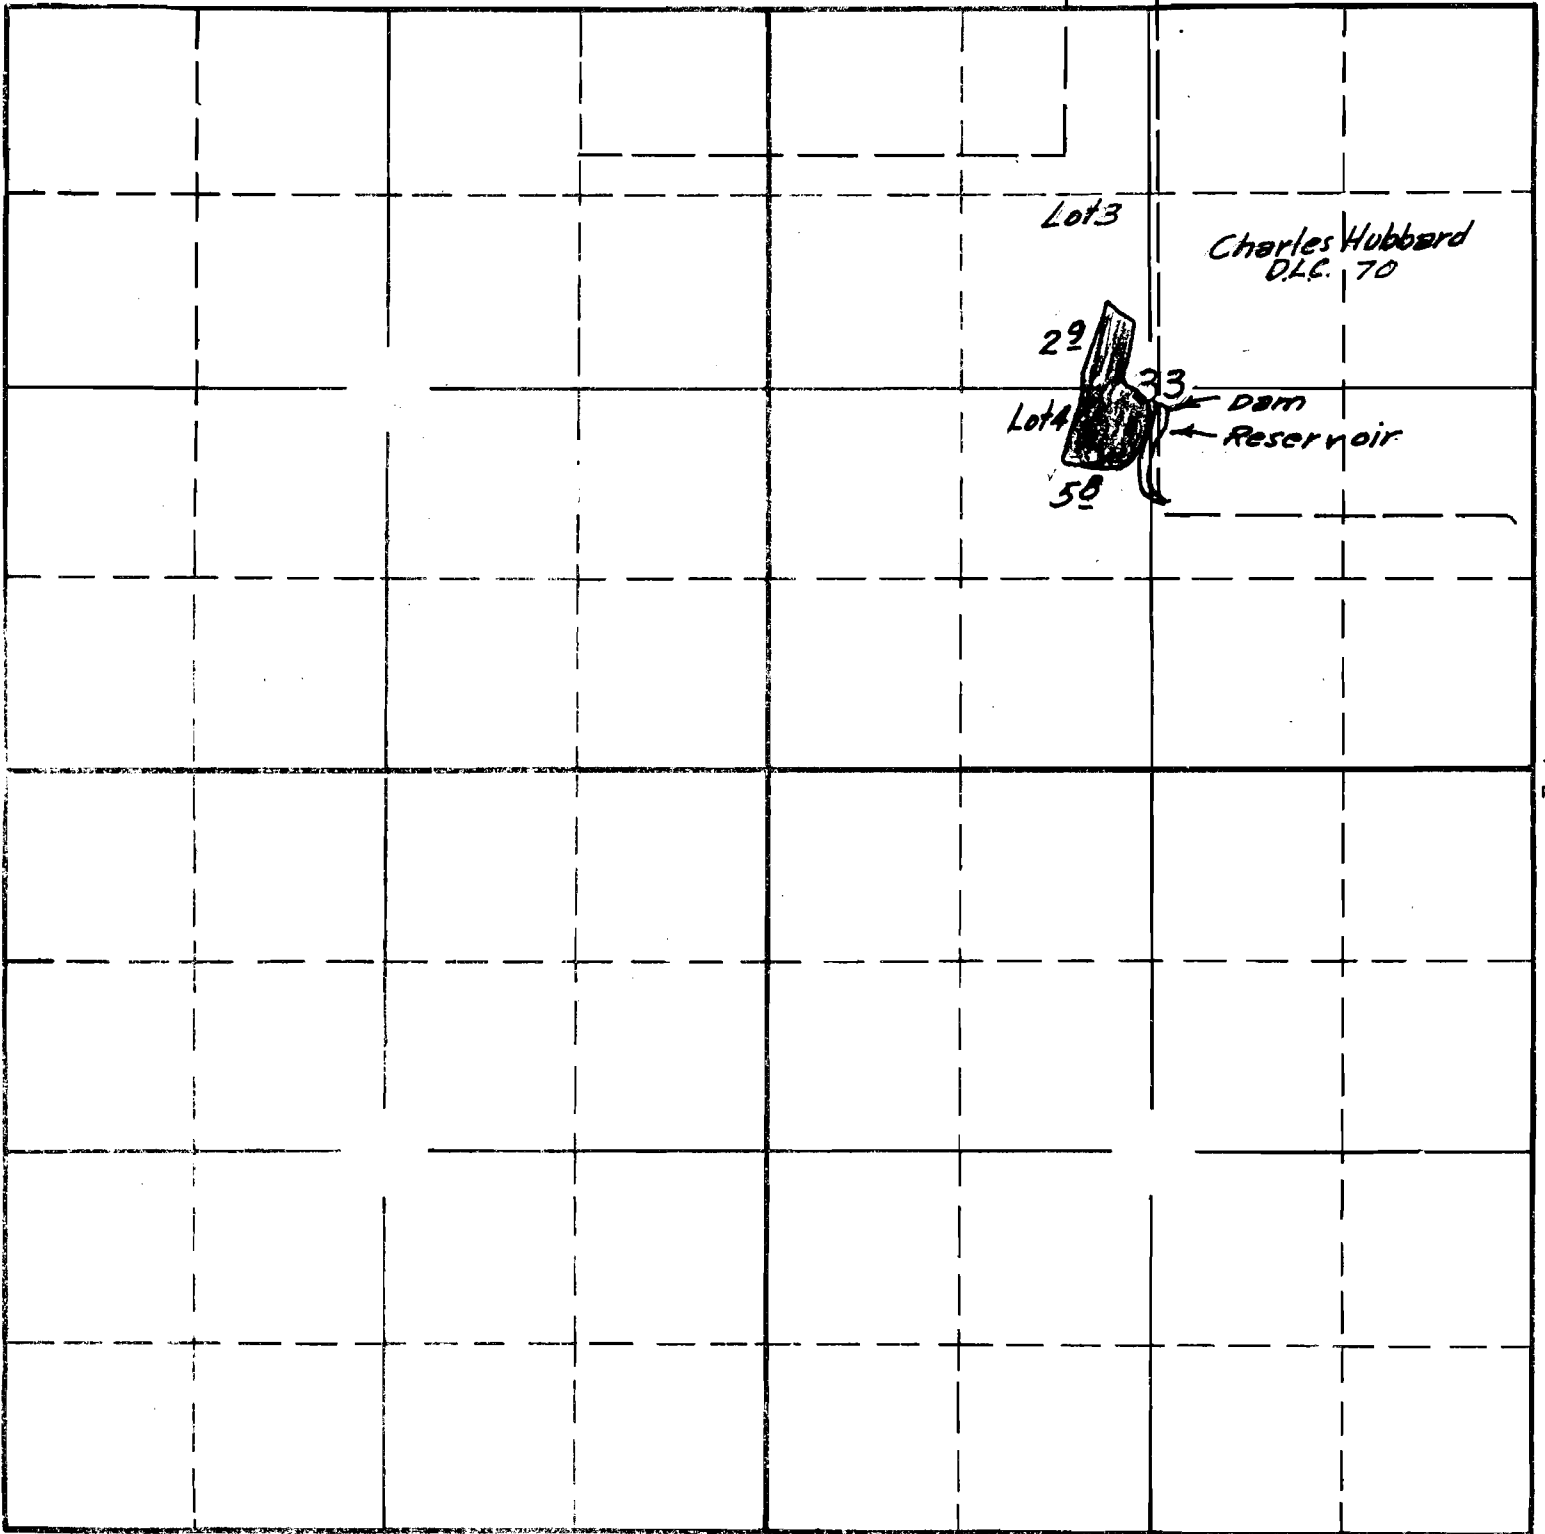

West

East

Surveyed May 23 1940 *C.H.B.*

South

APPLICATION No. *R15805*
 15802
 PERMIT No. *R681*
 11673