


TOWNSHIP 55, RANGE 3E, W. M.

North

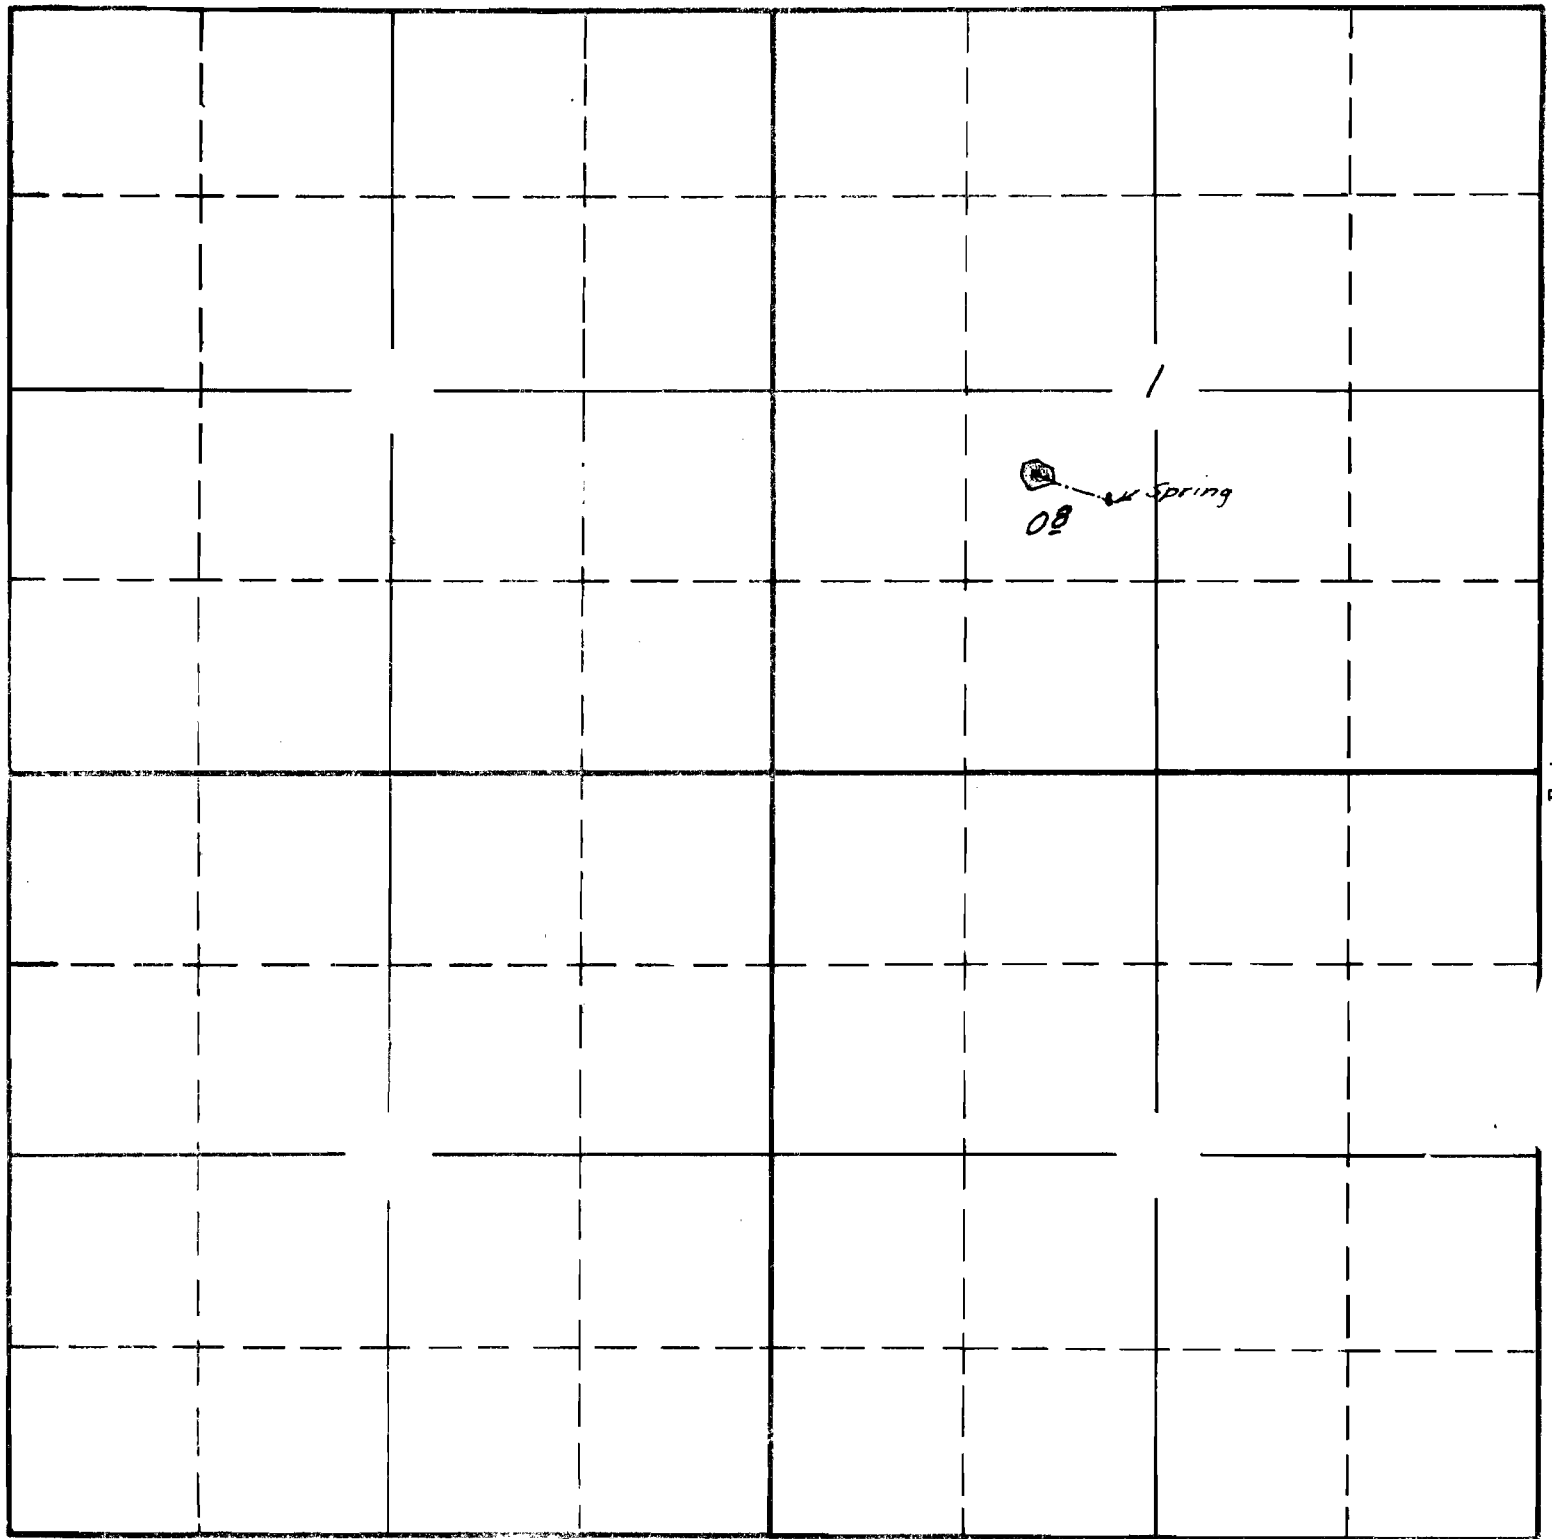

South

Surveyed May 27, 1940 Cal.


APPLICATION No. 15109

PERMIT No. 11162

Sec. 1

TOWNSHIP 5 S, RANGE 3 E, W. M.

North

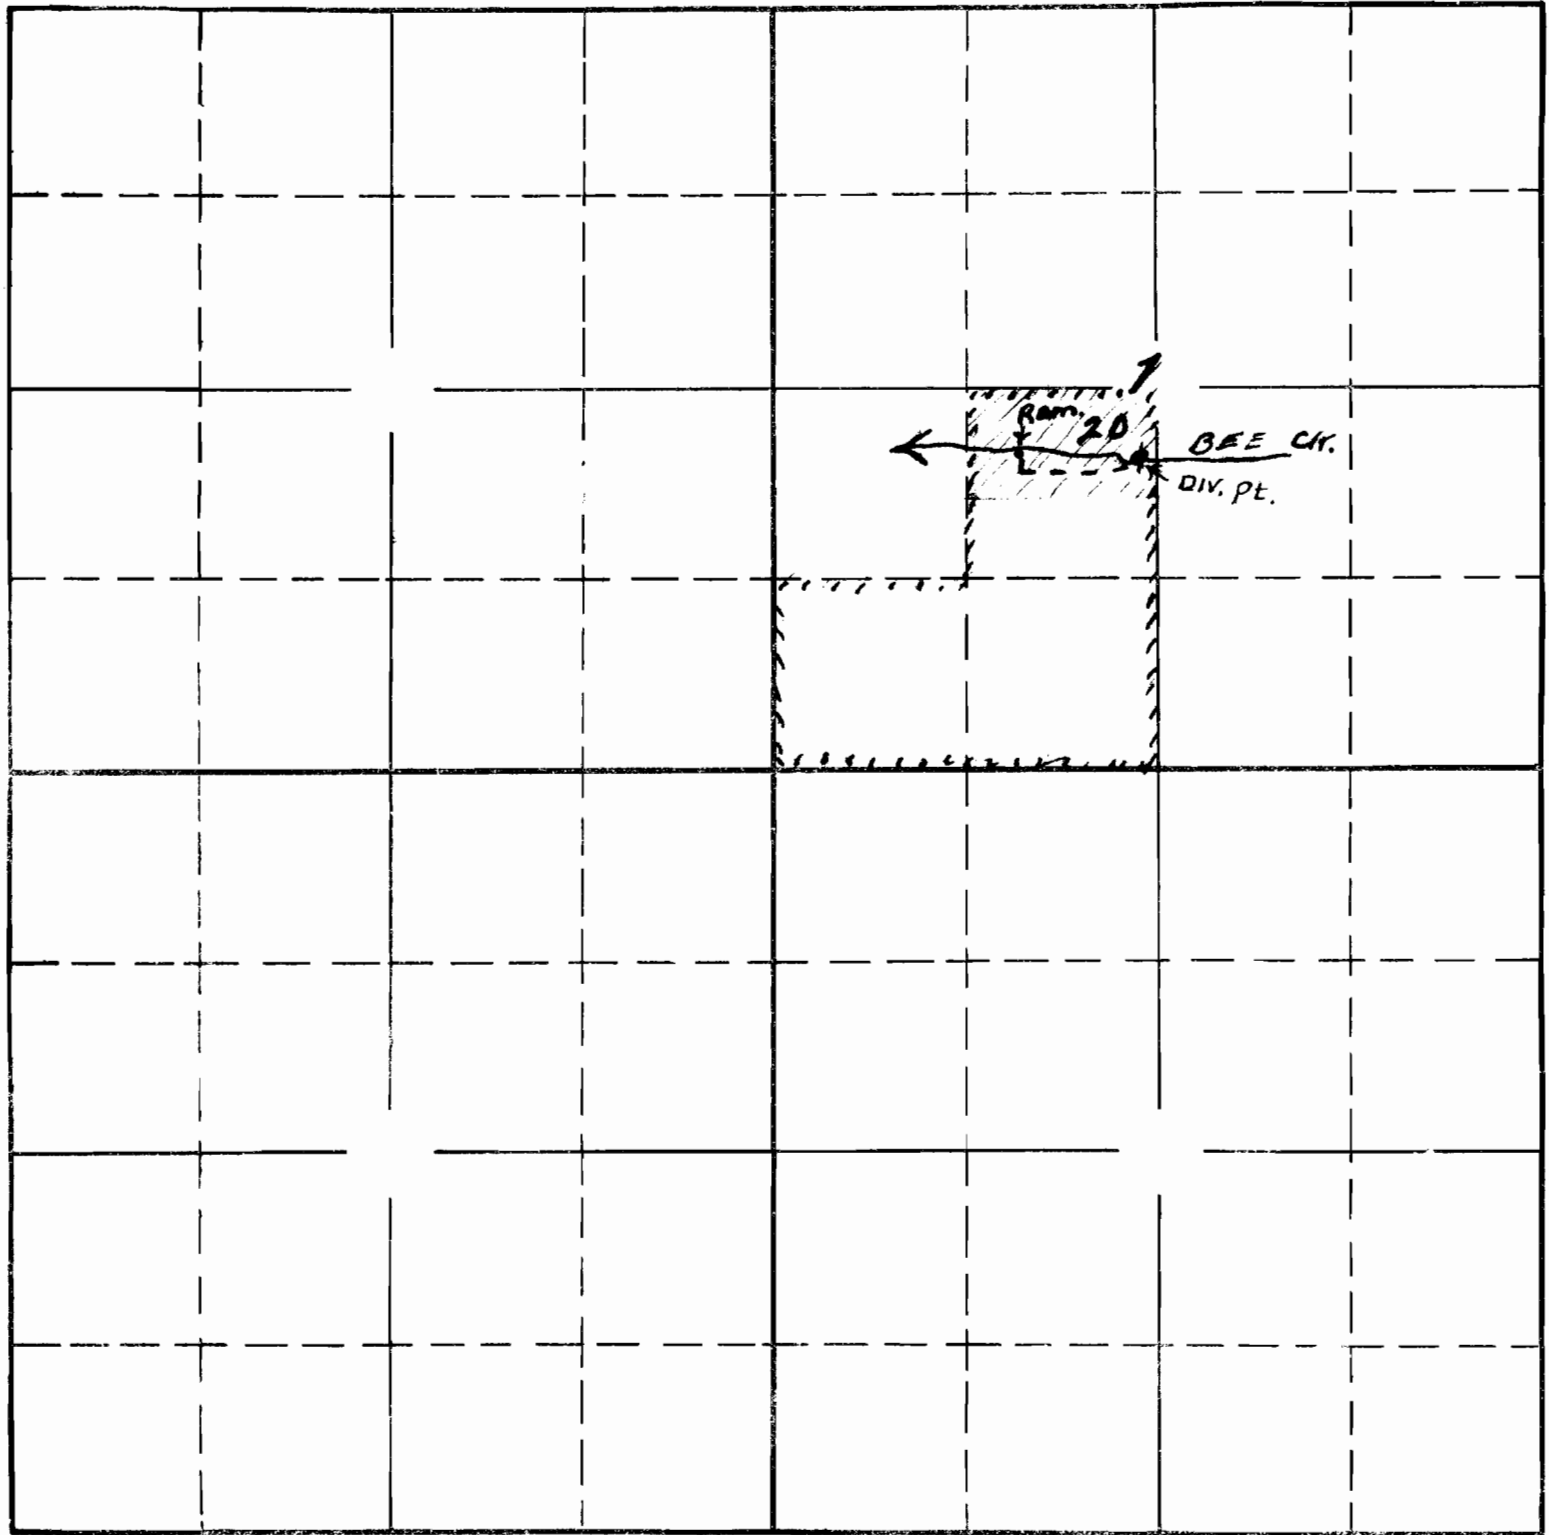

South

APPLICATION No. 15109
PERMIT No. 11162