


SECTION

P-11920

C-13702

TOWNSHIP 16S, RANGE 24E, W. M.

North

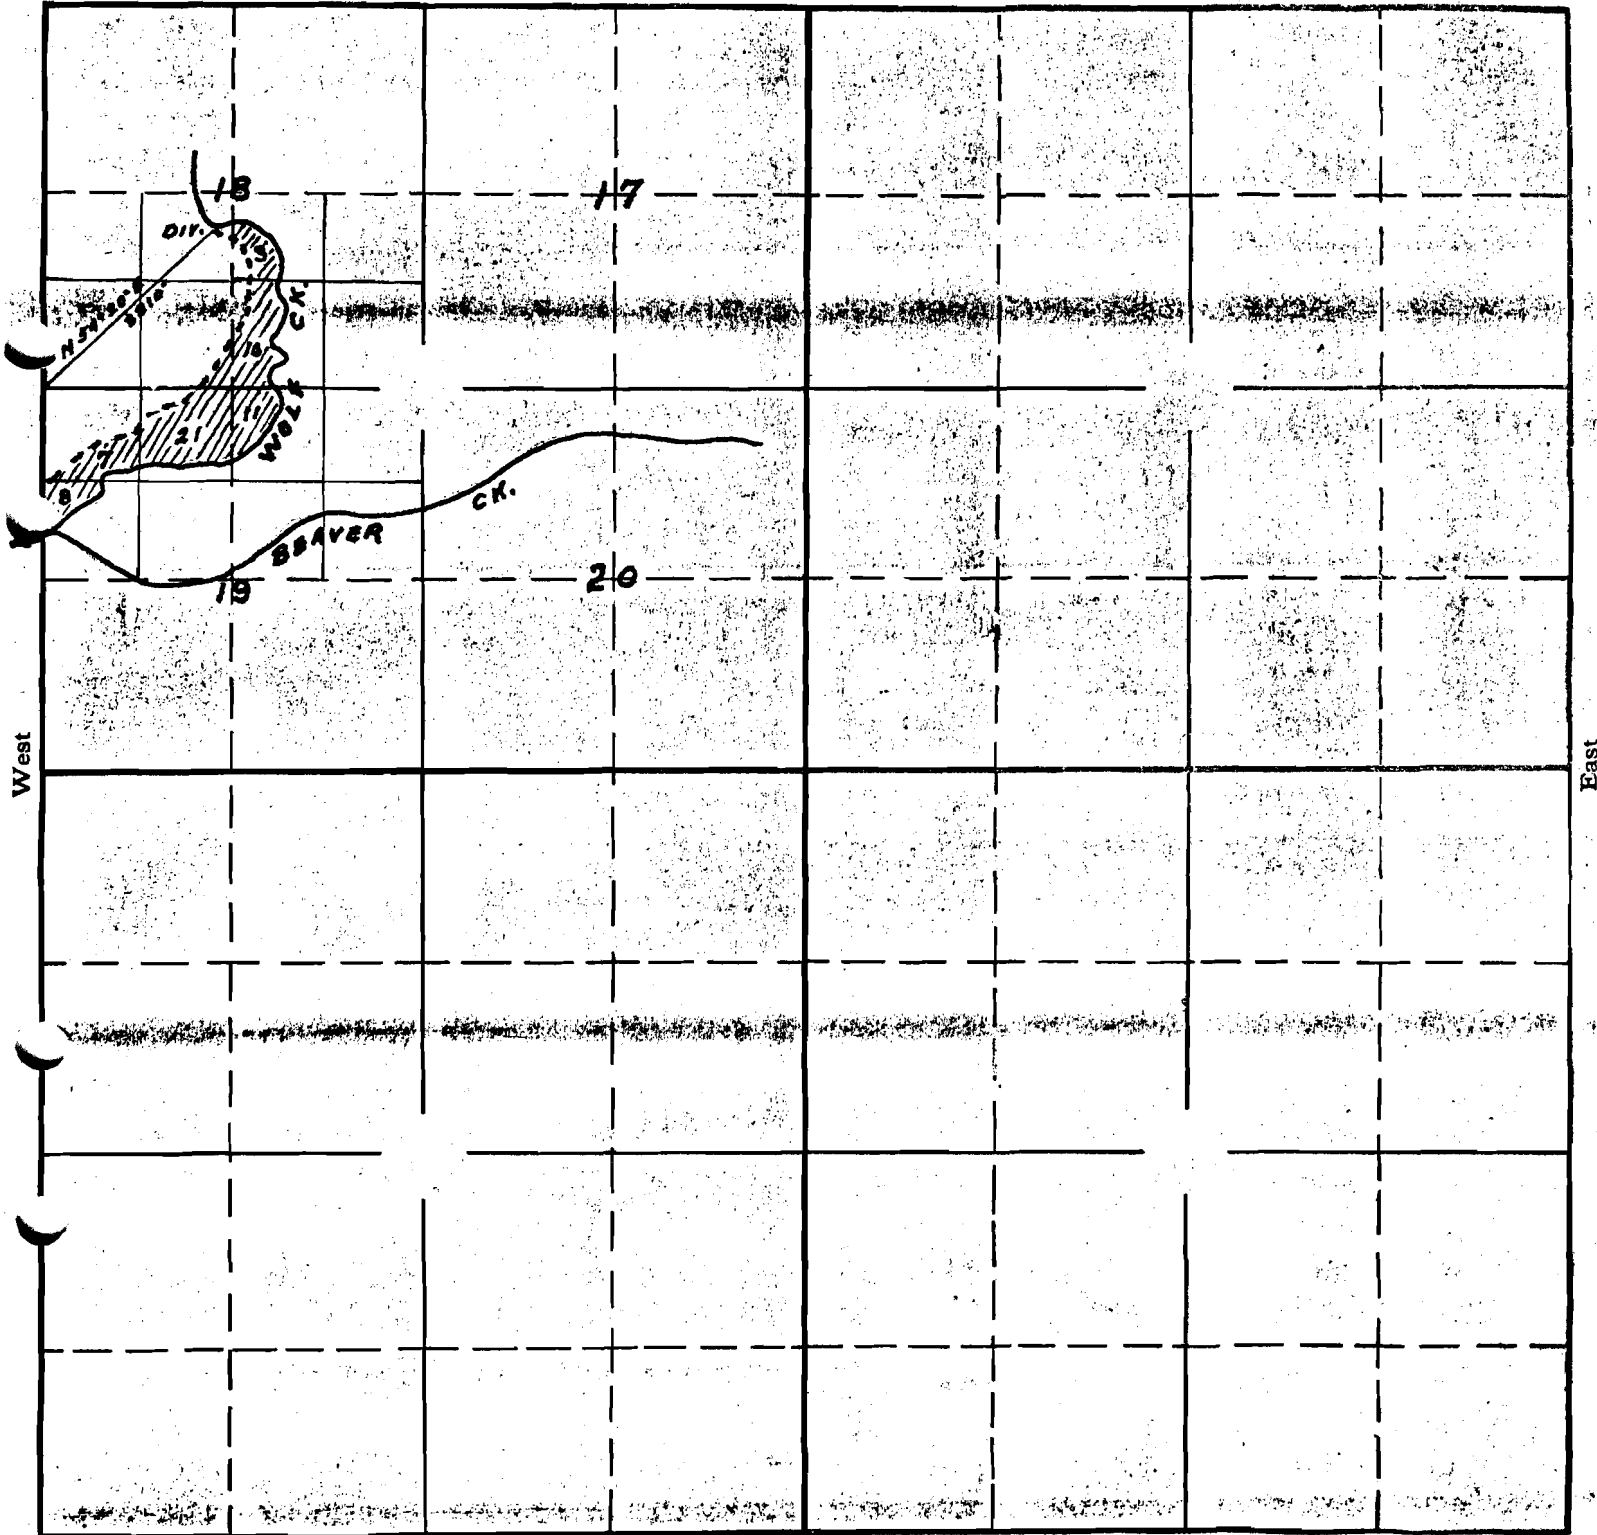

Copied from applicant's sketch

10/17/35-

South

5-6-UK

APPLICATION No. 16101


PERMIT No. 11920

#1

SECTION

TOWNSHIP 16S, RANGE 24E, W. M.

North

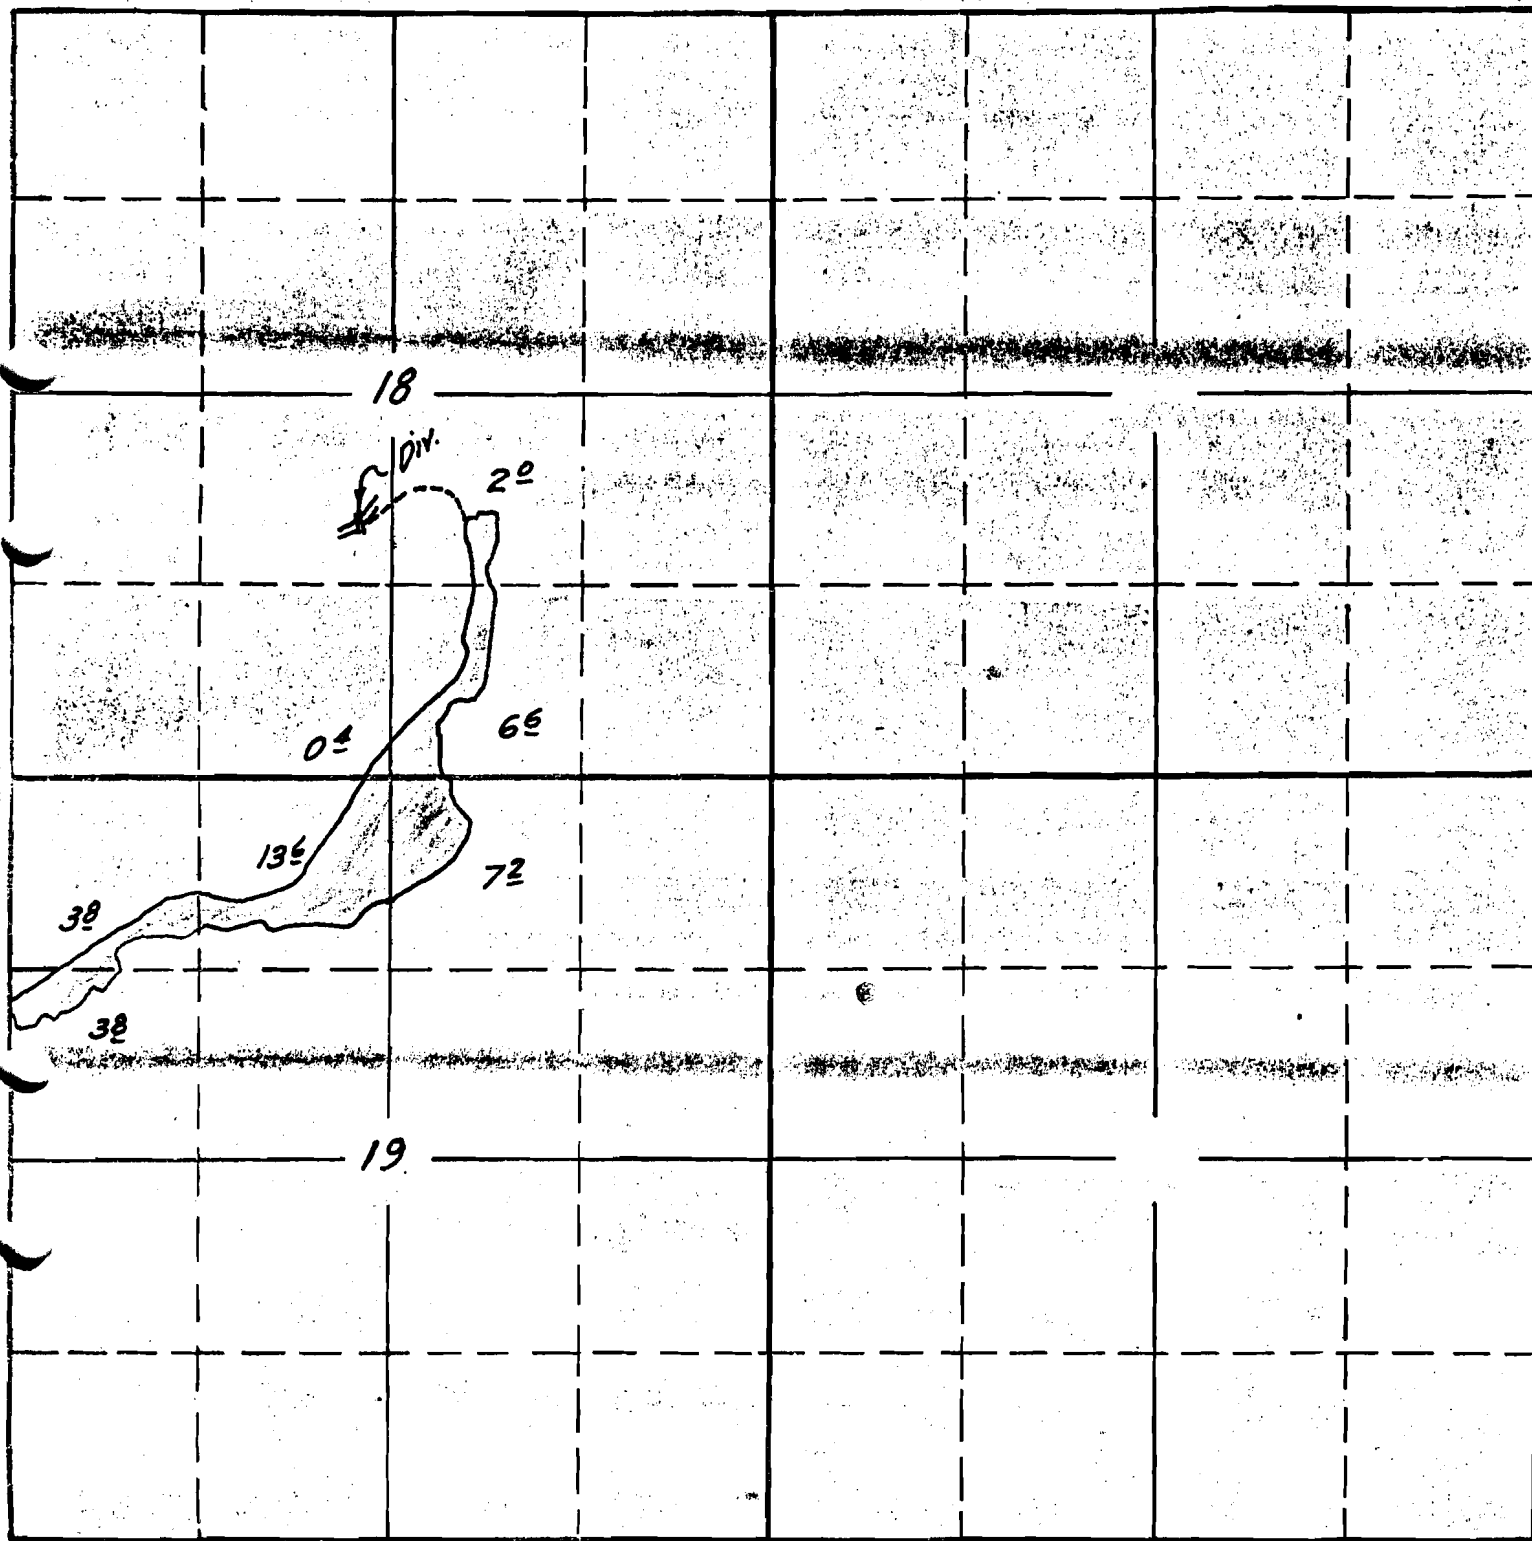

Surveyed by Chester A. Cummings  
Sept 23 1940

South

APPLICATION No. 16101

PERMIT No. 11920