


SECTION


TOWNSHIP 13 S, RANGE 10 W, W. M.

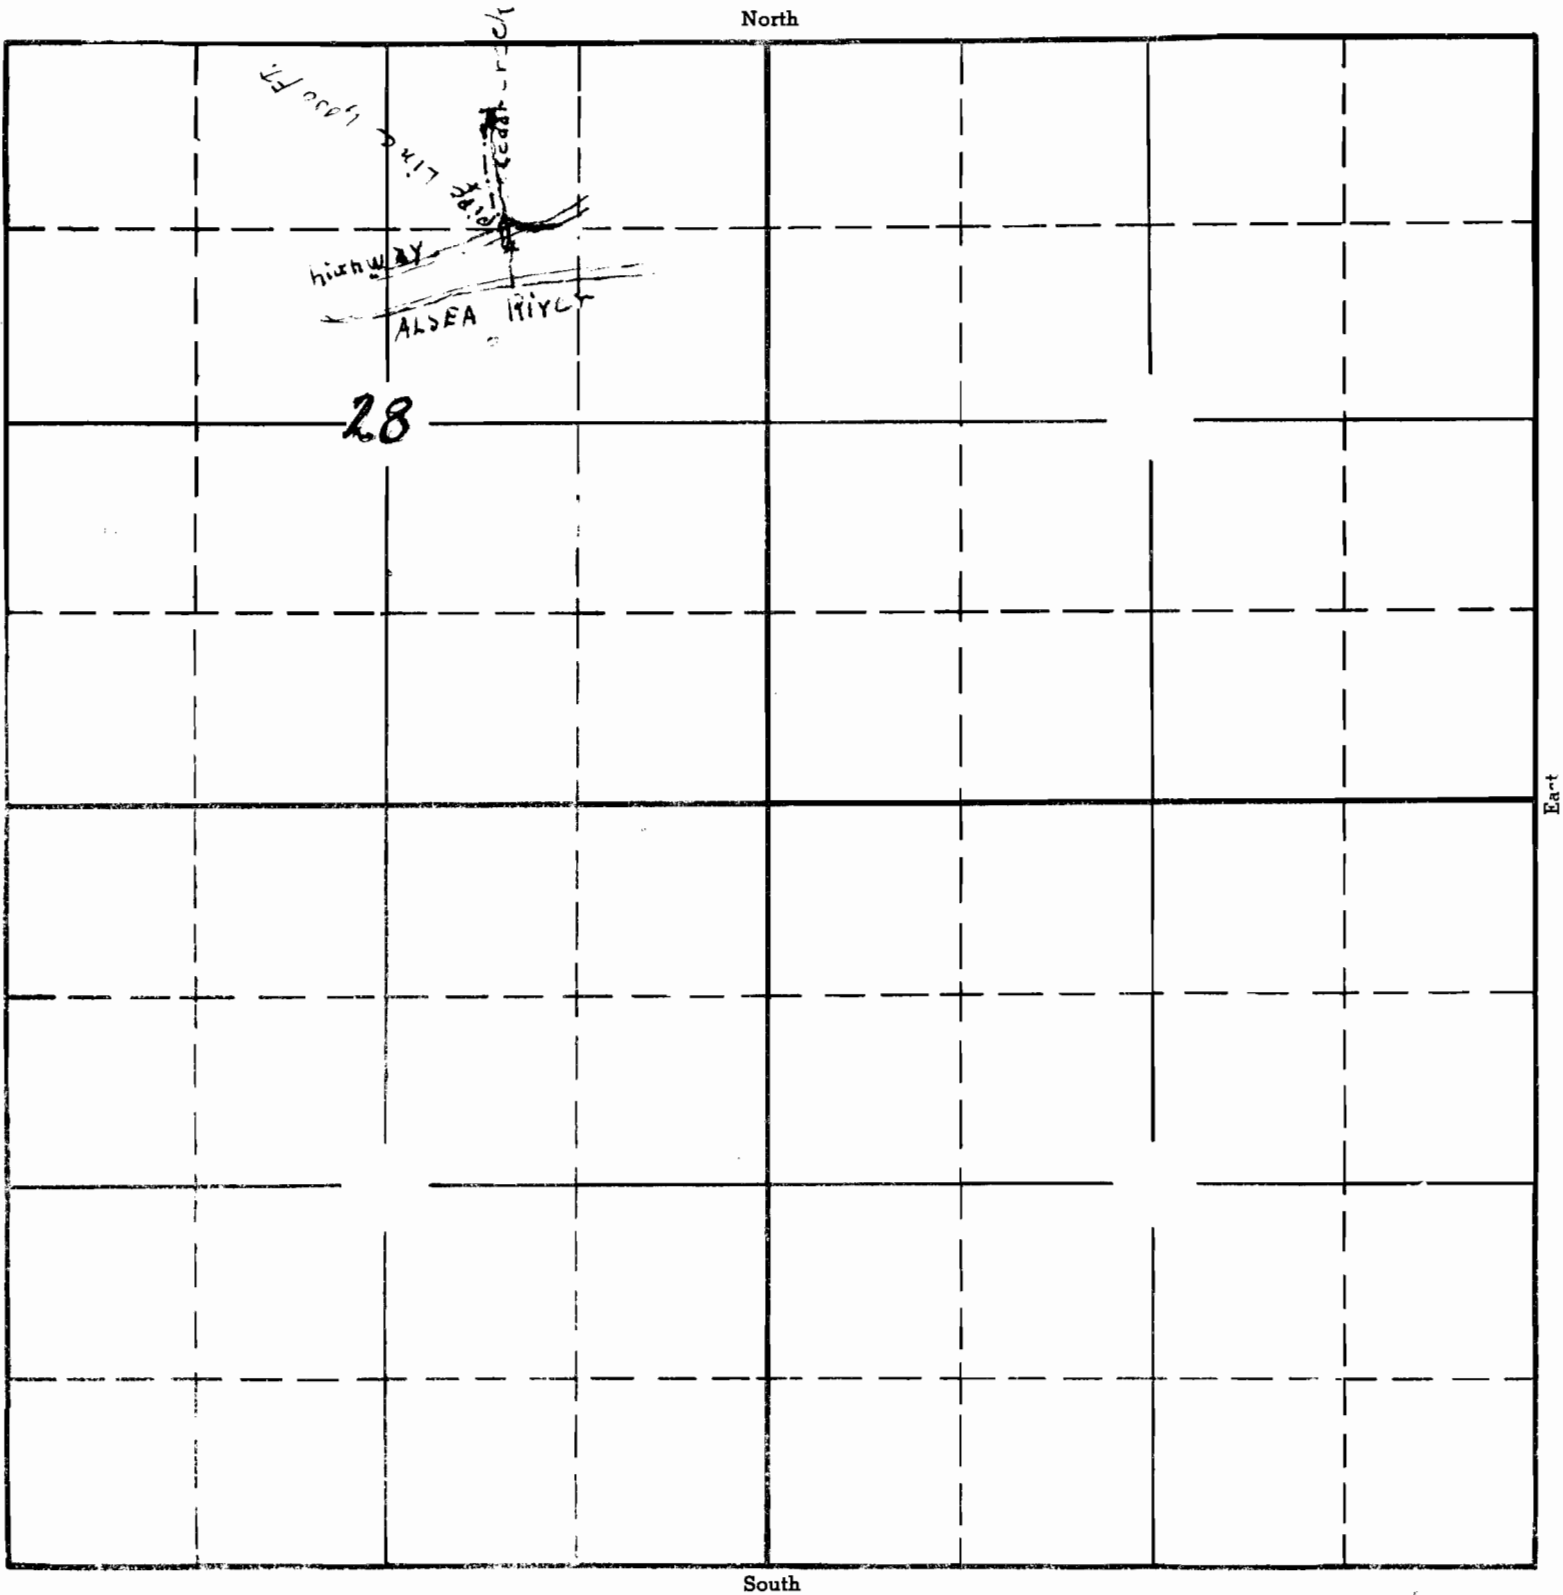

APPLICATION No. 17060  
PERMIT No. 12751

TOWNSHIP 135 , RANGE 10W , W. M.

North

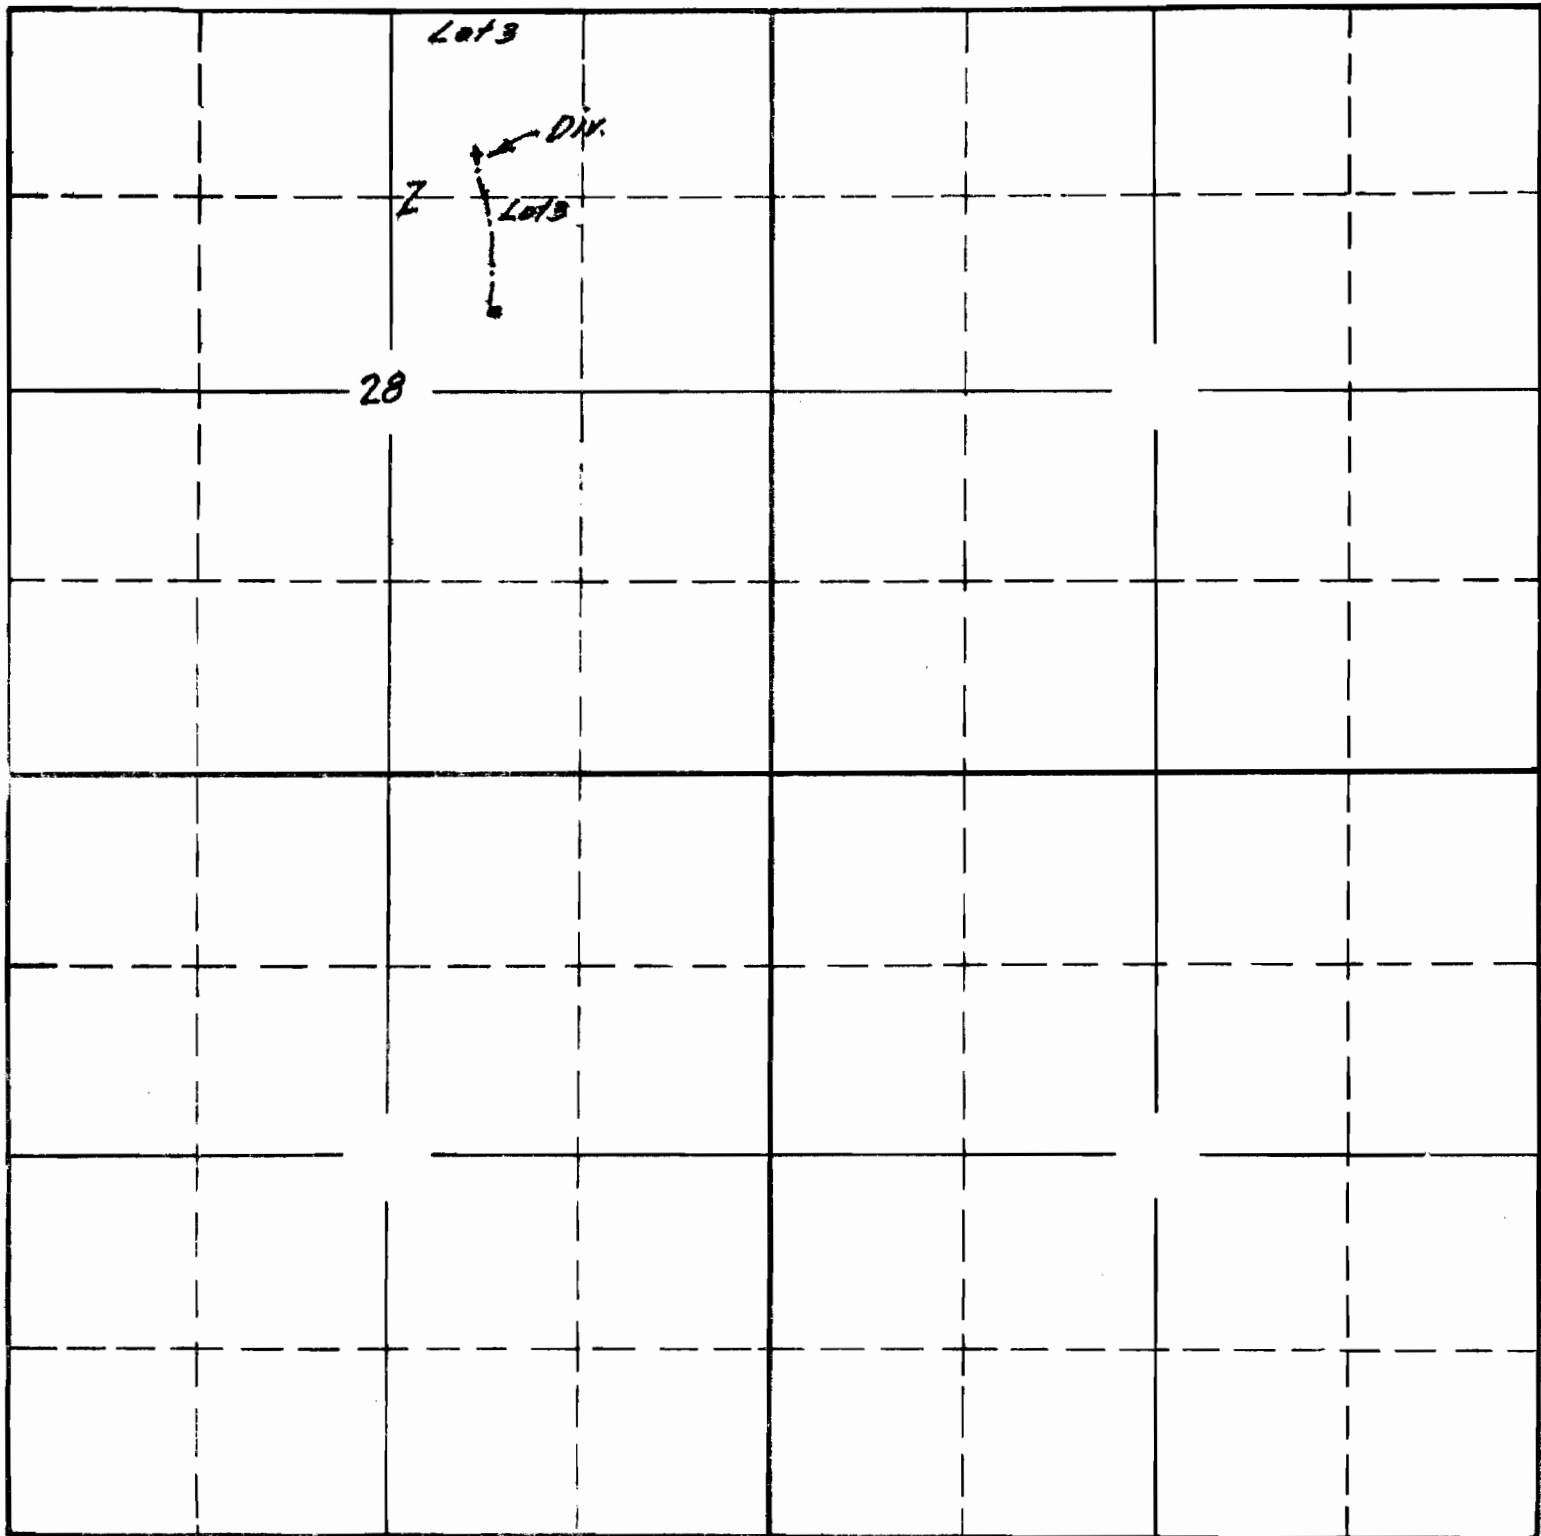

Surveyed June 29 1980 C.A.C.

South

APPLICATION No. 17060

PERMIT No. 12751