


SECTION

TOWNSHIP 45, RANGE 4E, W. M.

North

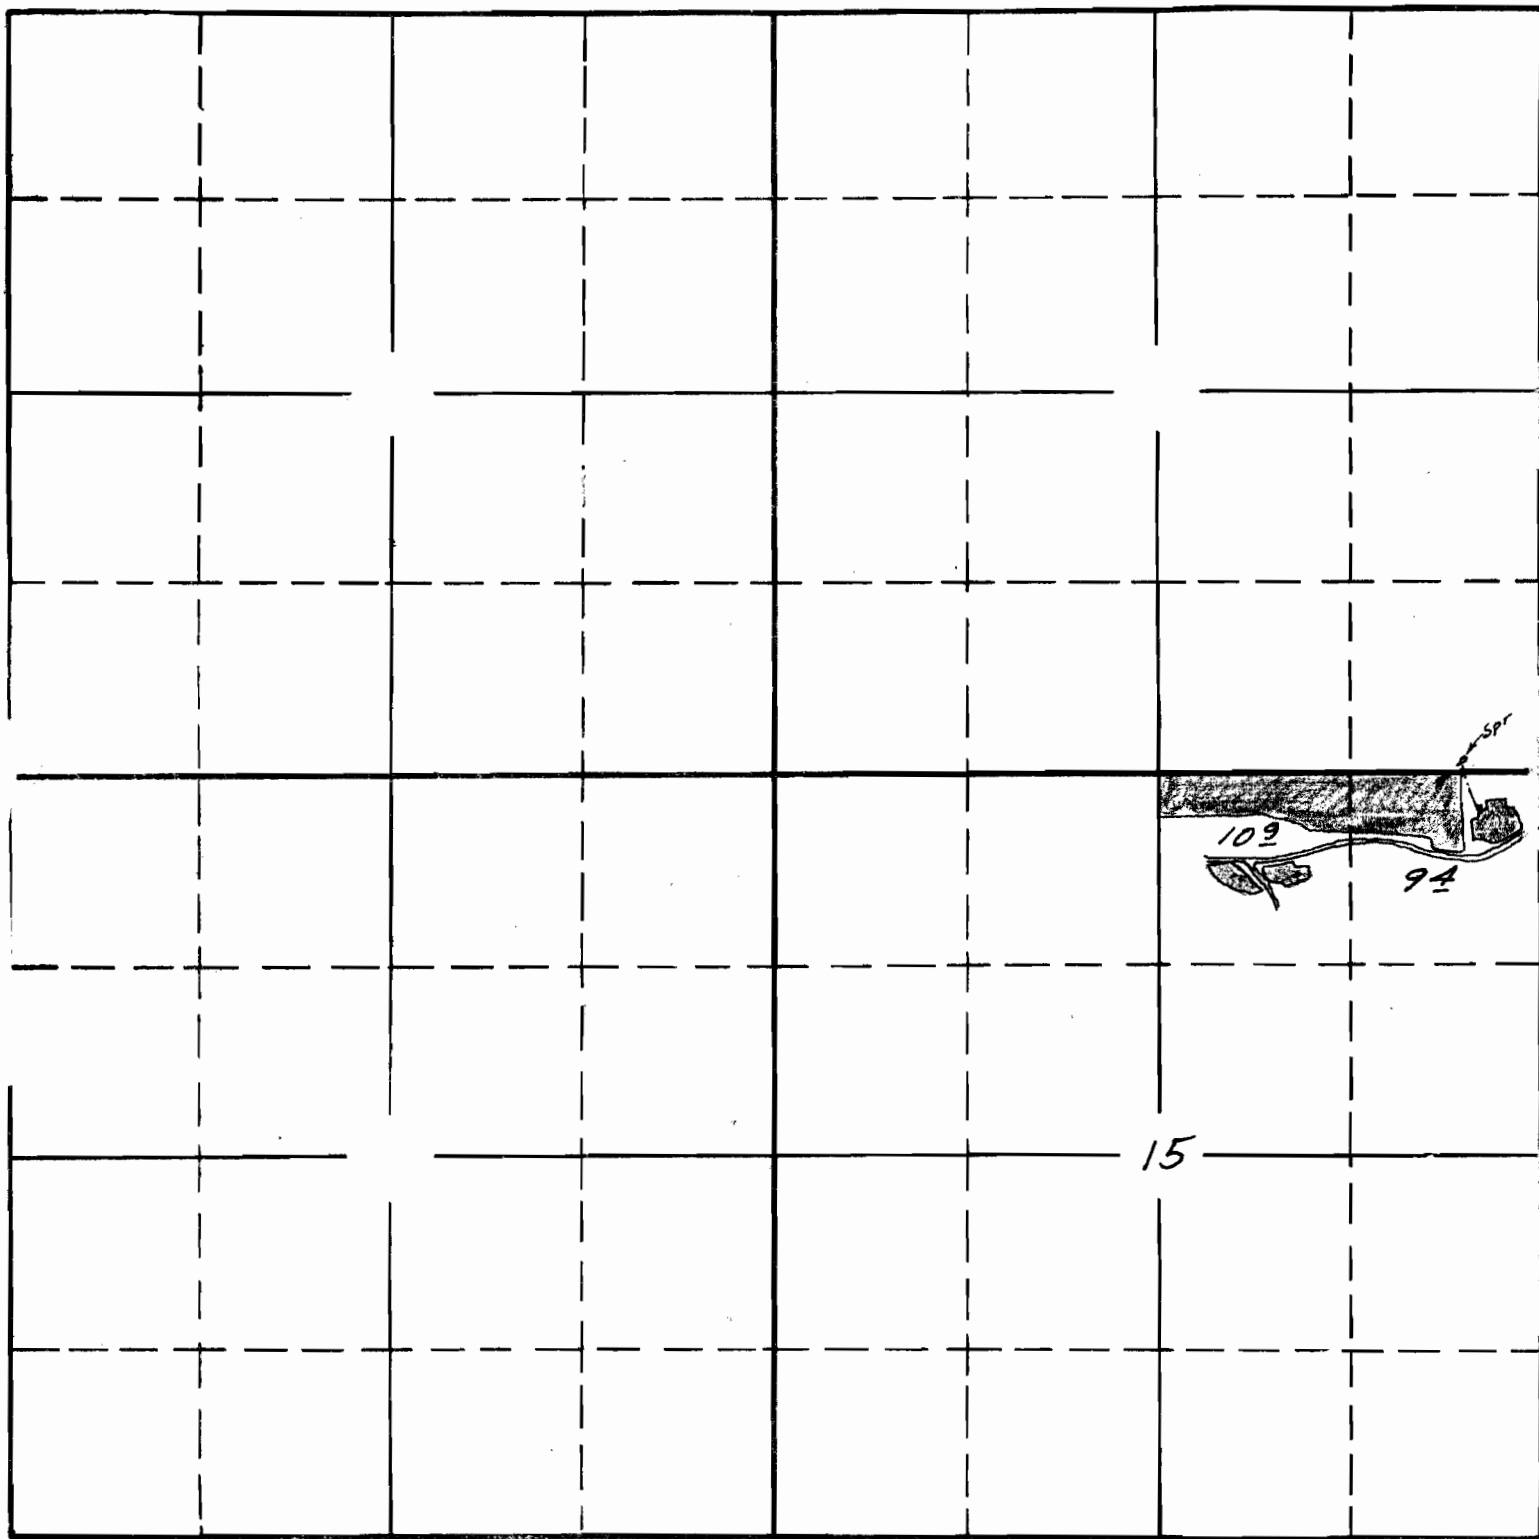

*Surveyed May 27 1940 C.D.B.*

South

APPLICATION No. 17343

PERMIT No. 13054