

SECTION


P 13094

13740

13S

TOWNSHIP 14S, RANGE 31E, W. M.

North

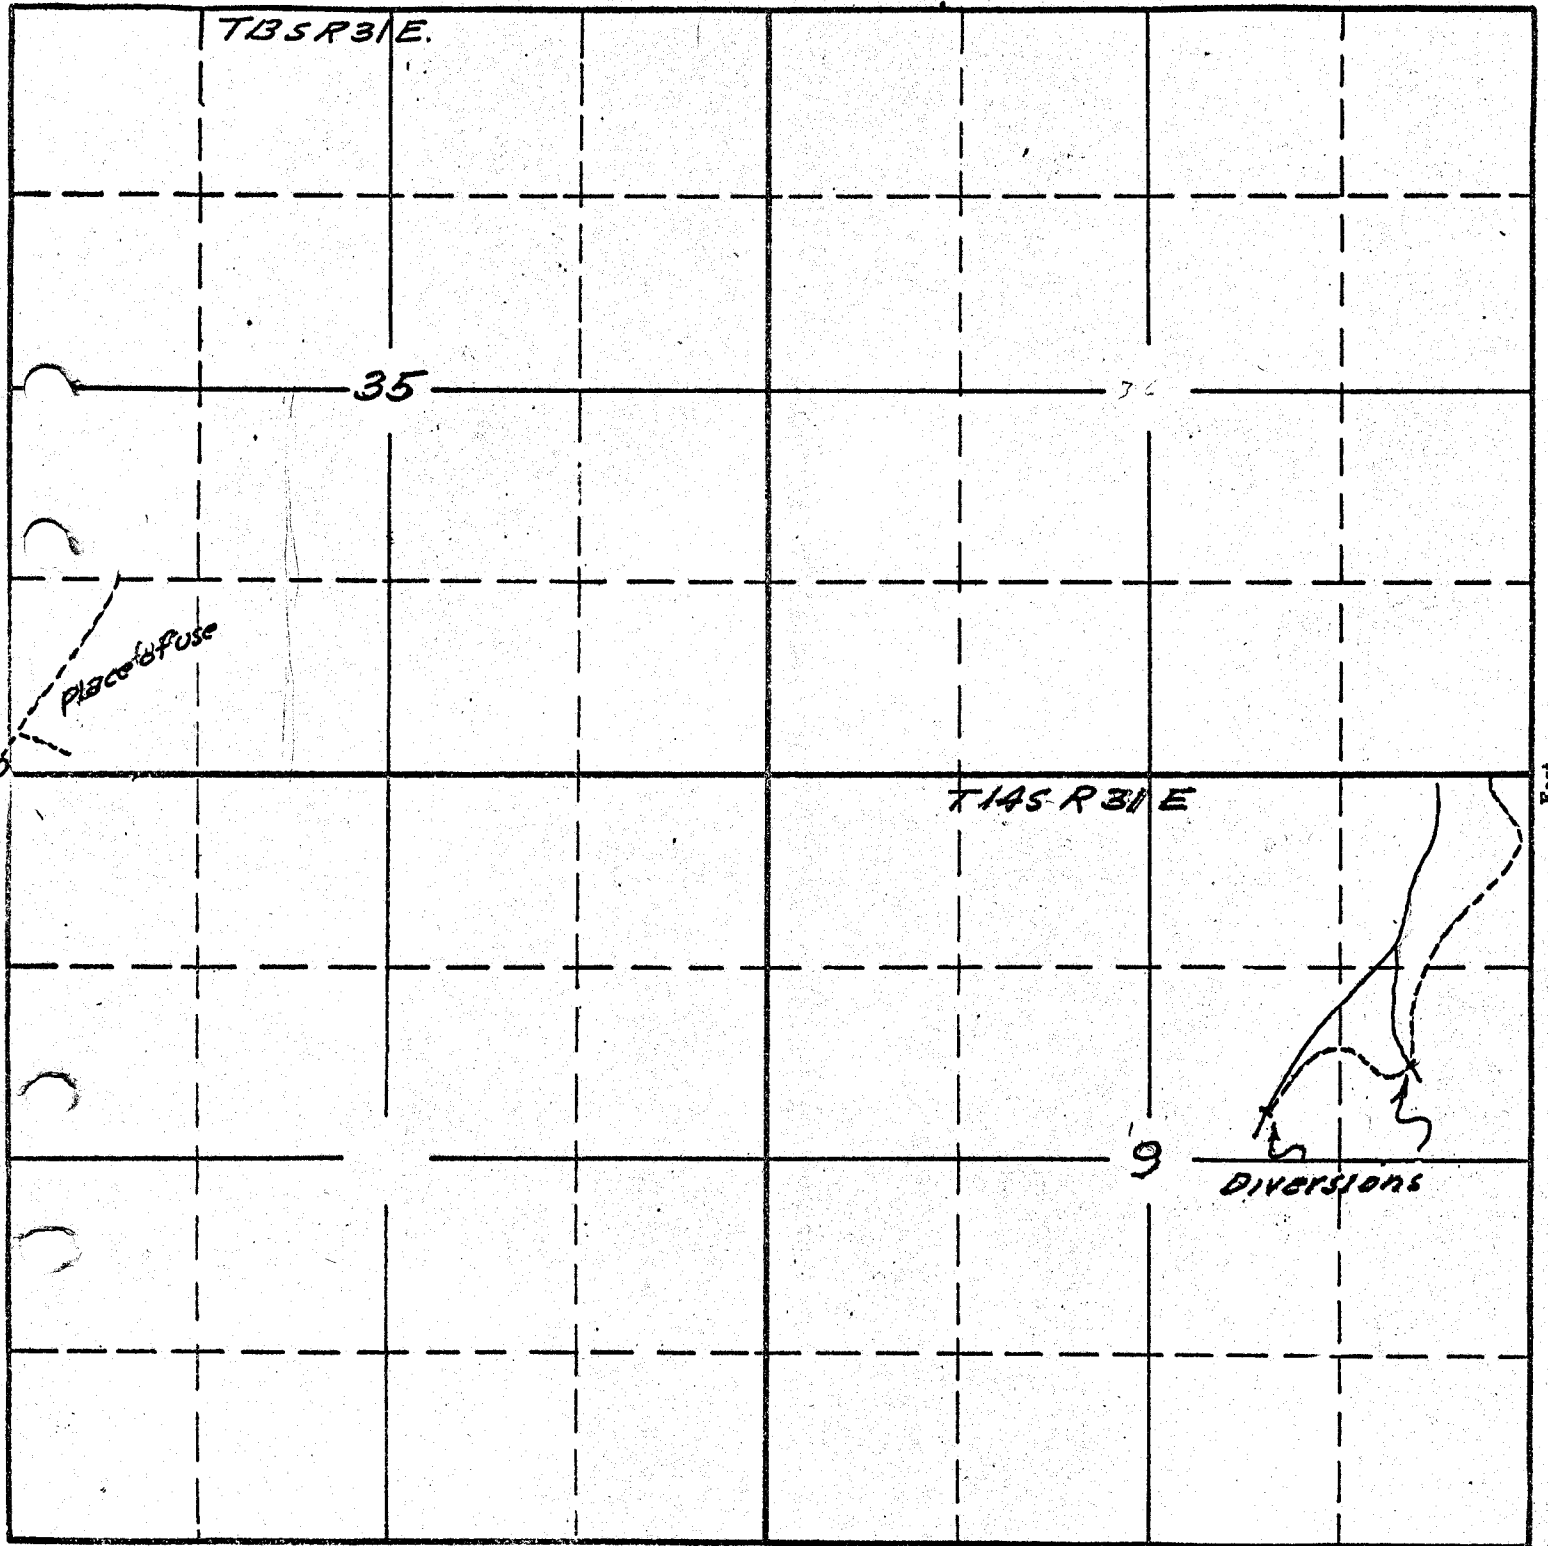

Surveyed Sept 16 1940 E.A.G.

South

APPLICATION No. 17394

PERMIT No. 13094