


7
DEC

TOWNSHIP 45 , RANGE 4W , W. M.

North

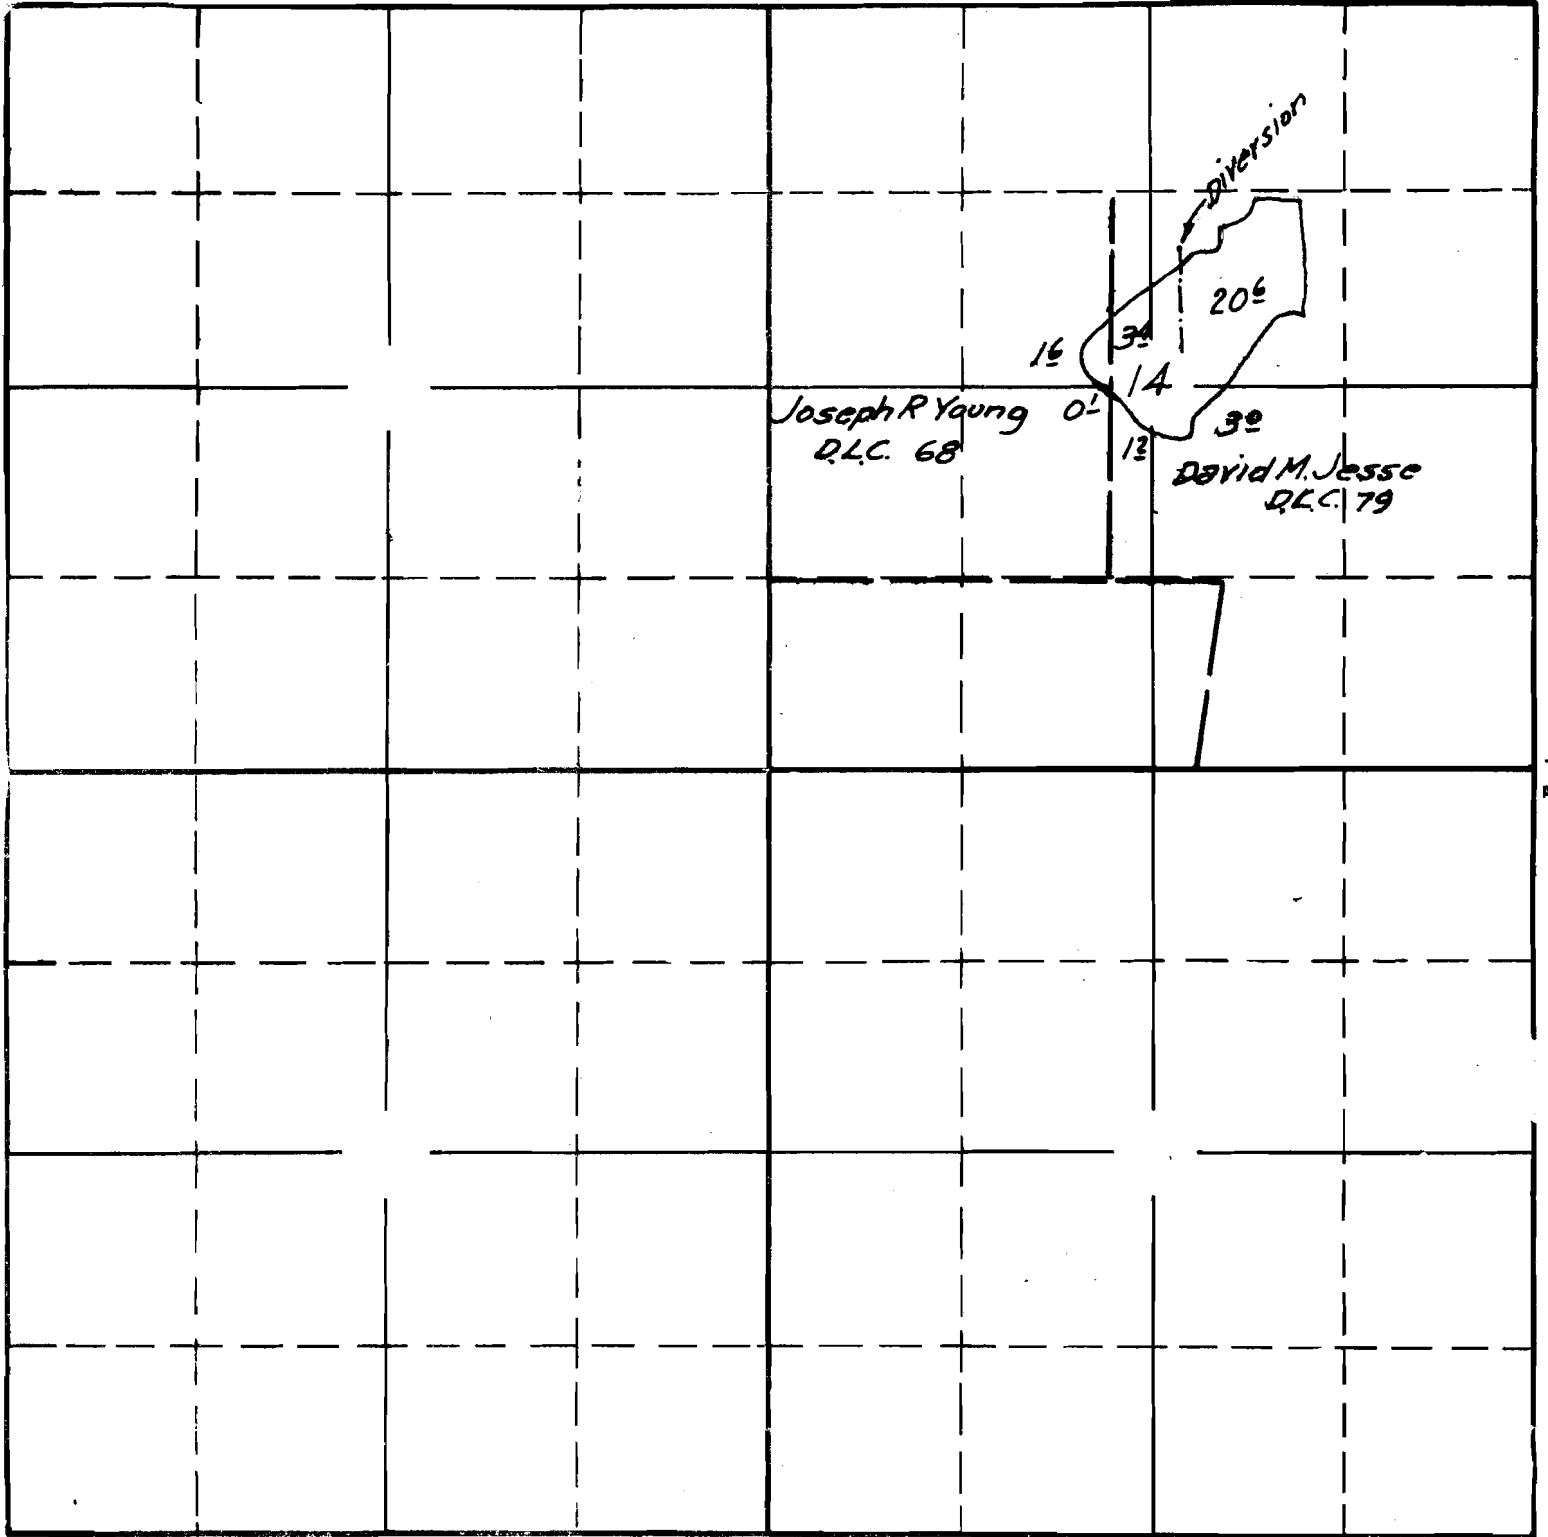

South

APPLICATION No. 17840
PERMIT No 13529


ION

14

TOWNSHIP 4S, RANGE 4W, W. M.

North

West

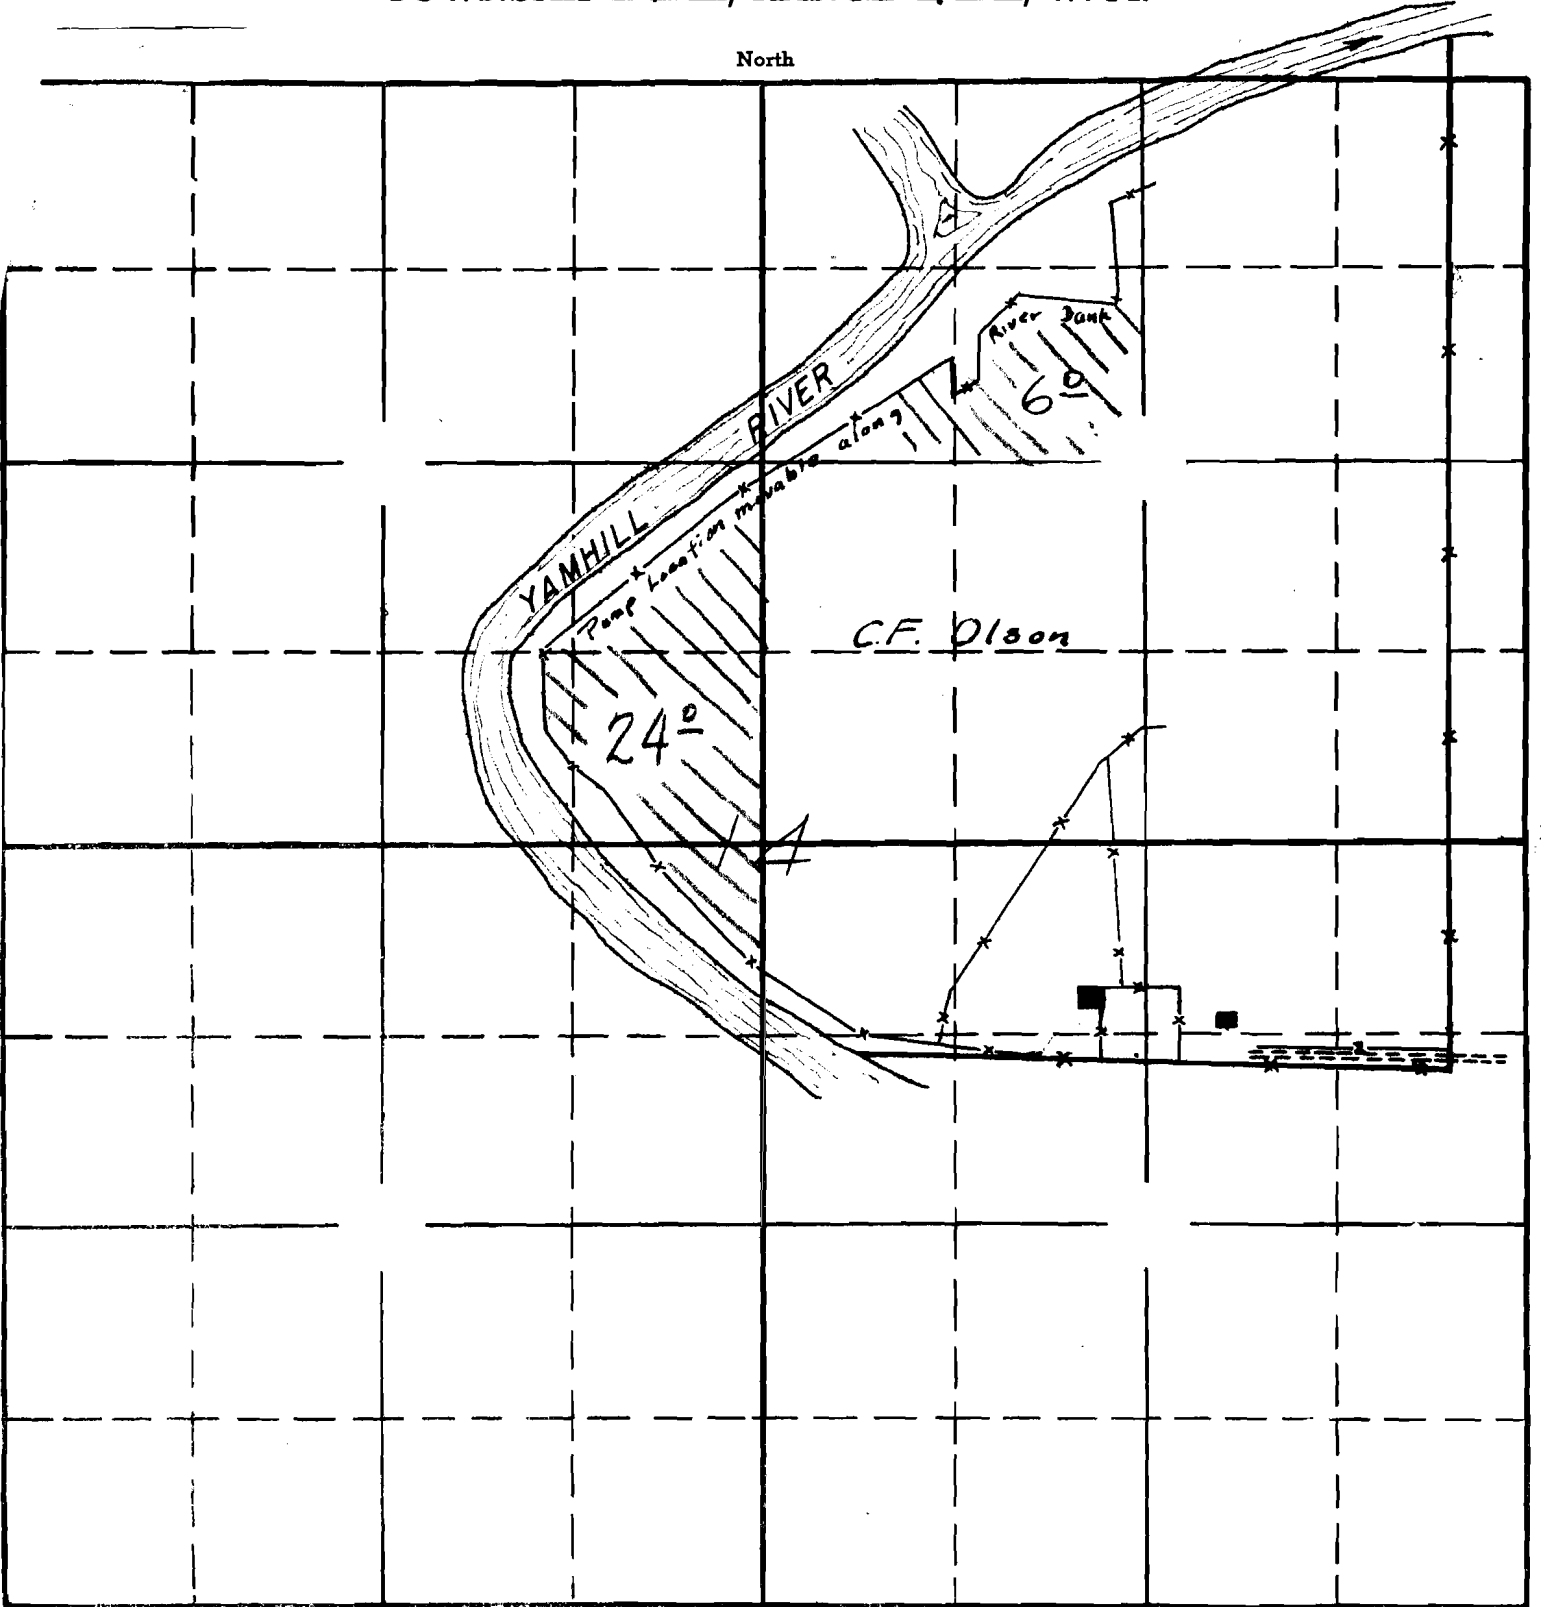

South

17840 etc
90 D

RECEIVED

MAR 19 1939

STATE ENGINEER
SALEM, OREGON

RECEIVED

MAR 21 1939

STATE ENGINEER
SALEM, OREGON

APPLICATION No. 17840

PERMIT No. 13529