


SECTION

34

35

TOWNSHIP 13 S , RANGE 19 E , W. M.

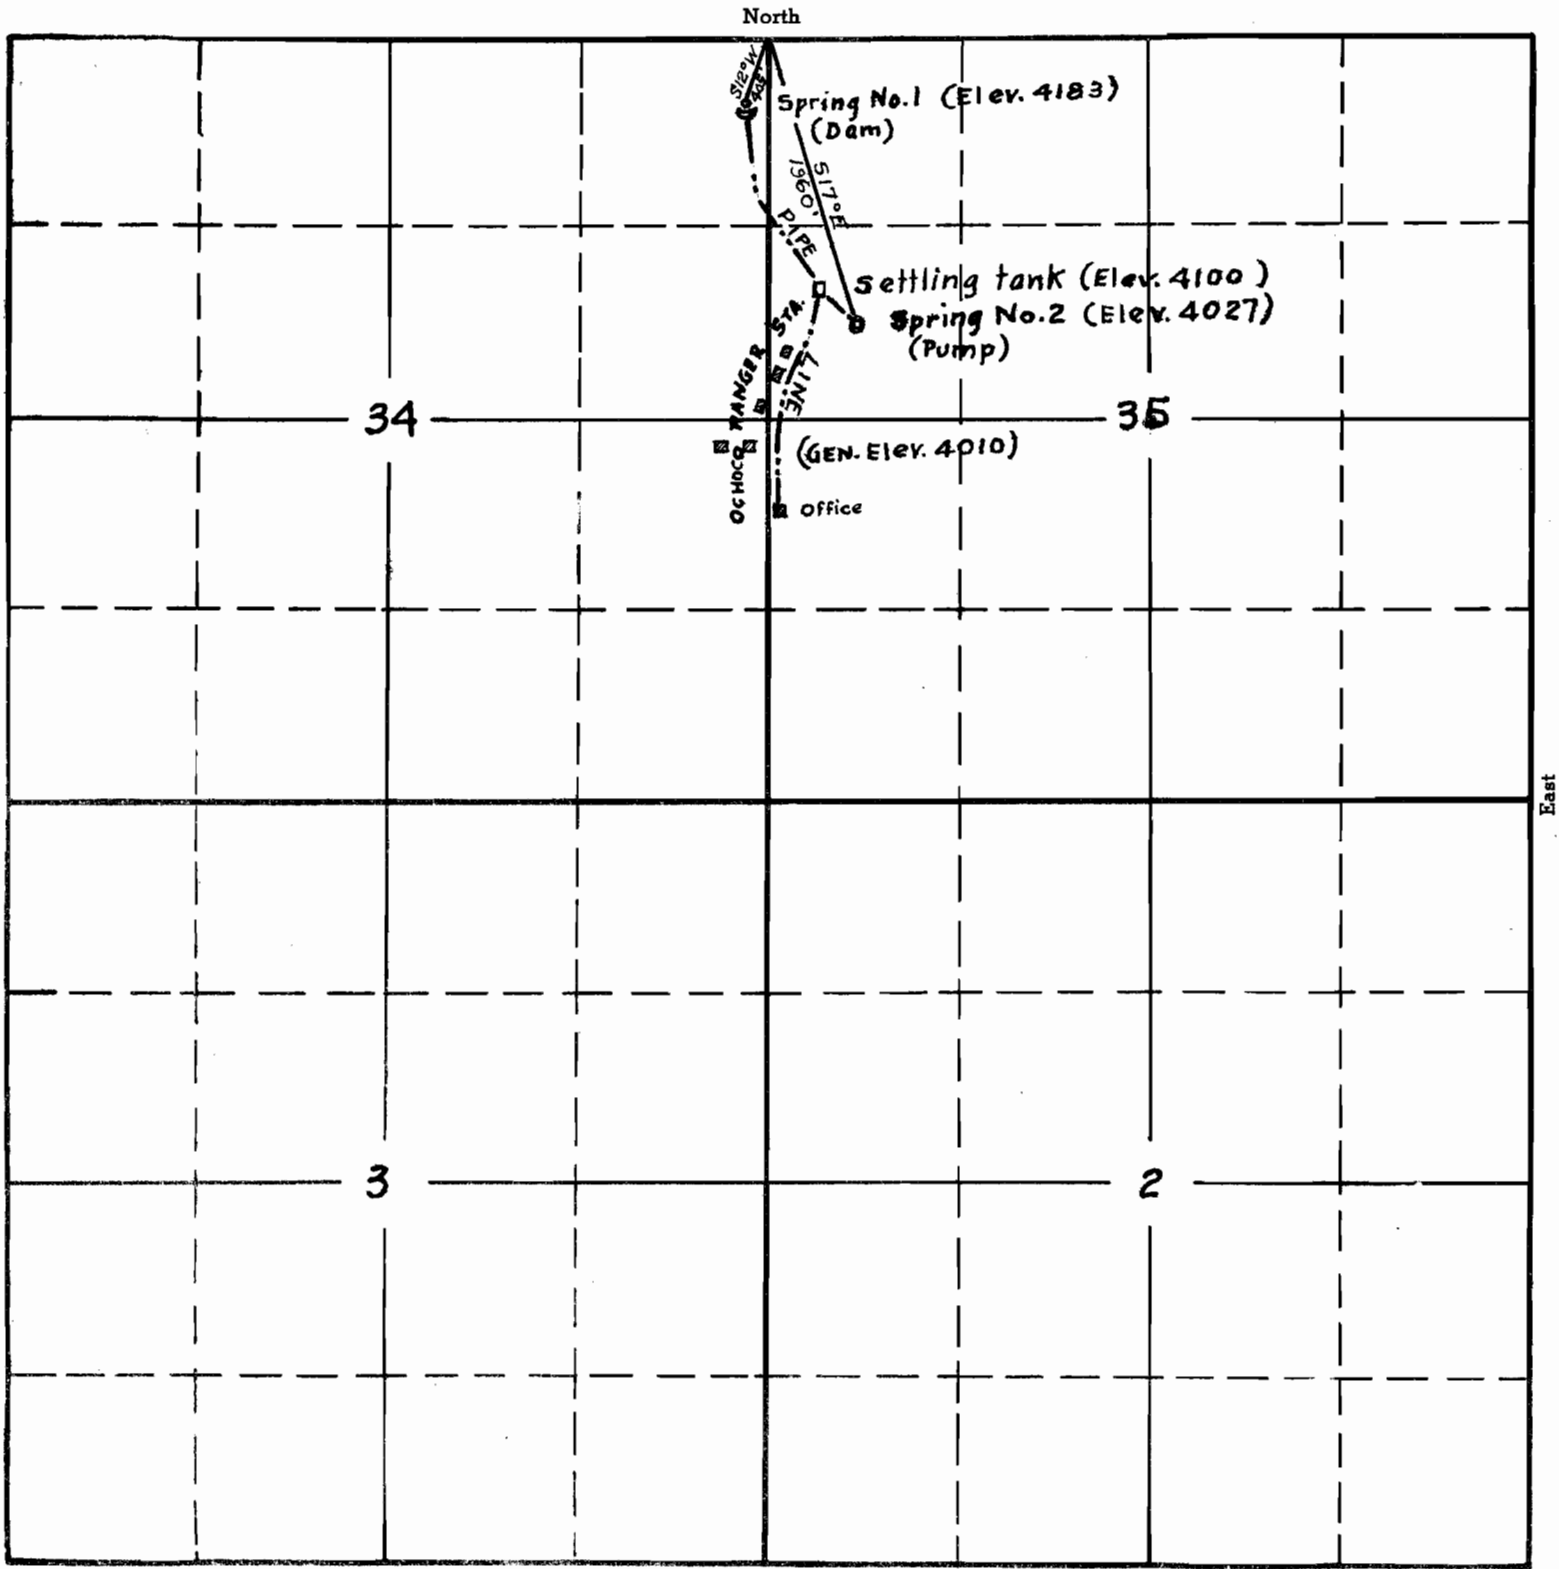

RECEIVED

MAR 31 1933

STATE ENGINEER
SALEM, OREGON

11562 a.
5-26
APPLICATION No. 17868
PERMIT No. 13562