

SECTION	

## TOWNSHIP 3 S, RANGE 45 EW. M.

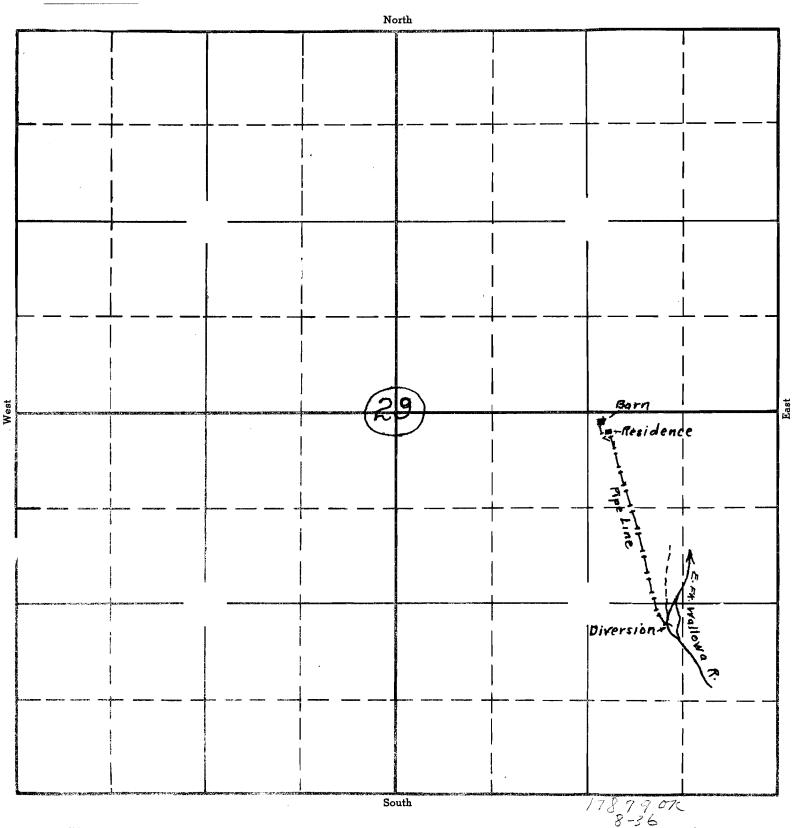

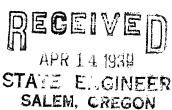

APPLICATION No. / 7899
PERMIT No. / 3587