


# T.5S. R.3W. W.M.

YAMHILL COUNTY

GRAND

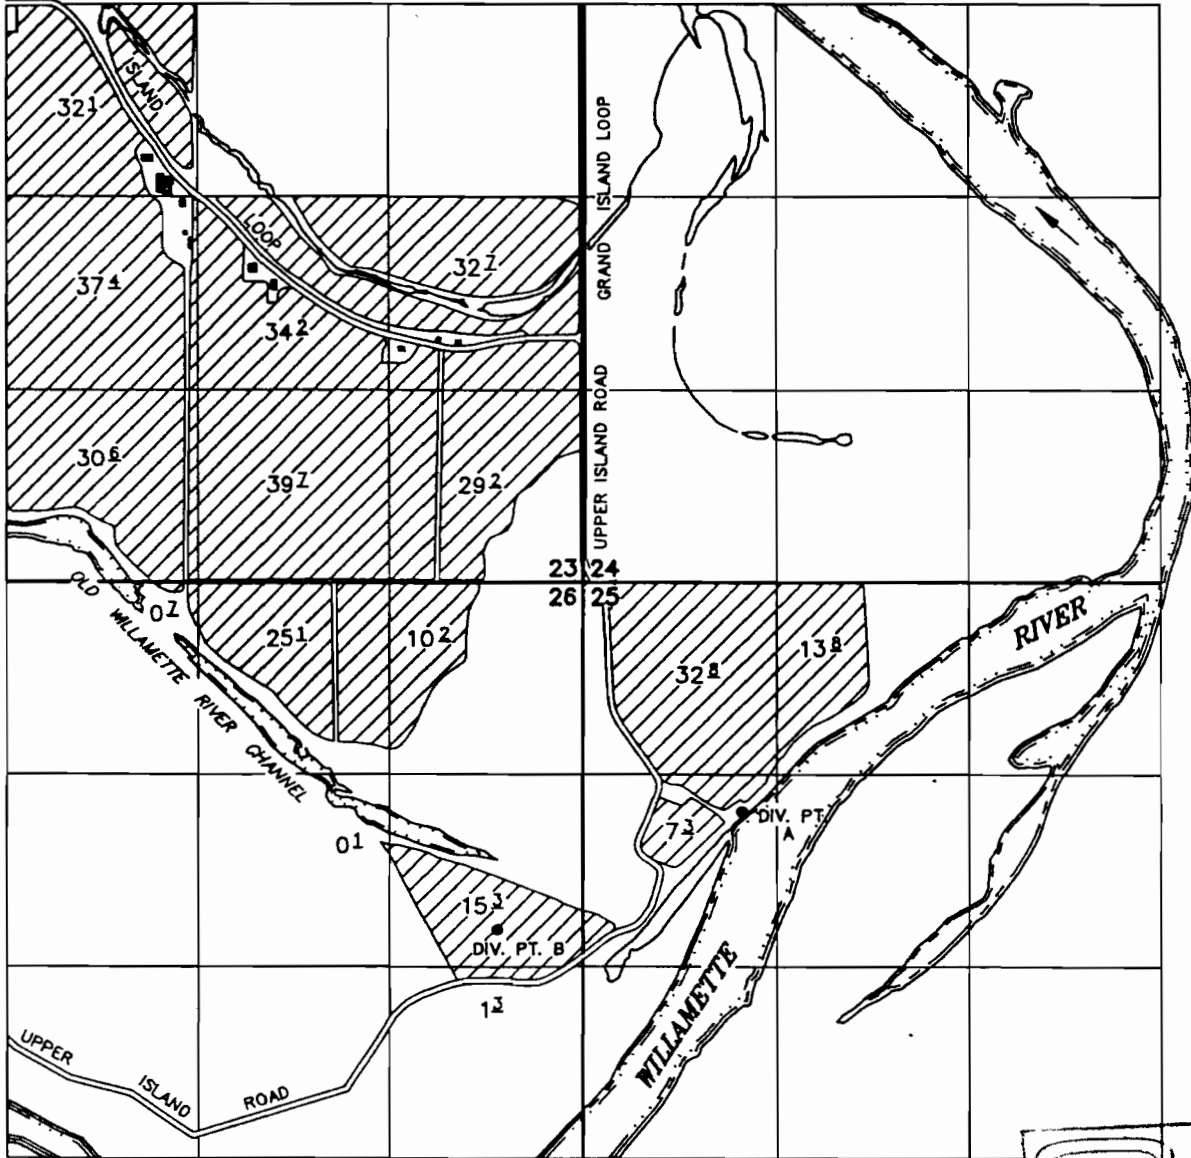

DIV. PT. A: 1585' S AND 1050' E FROM THE NW COR SEC 25  
 DIV. PT. B: 2383' S AND 585' W FROM THE NE COR SEC 26

## FINAL PROOF SURVEY

UNDER

**TAX LOTS:**

053W23 00600  
 053W23 01100  
 053W23 01200  
 053W23 01300  
 053W25 00100  
 053W26 00100  
 053W26 00200  
 053W26 00800

GR-1540  
 GR-1541  
 GR-1542  
 GR-3155  
 GR-3156  
 GR-3276  
 GR-3568  
 G-1476  
 17944  
 17950  
 30616

GR-1483  
 GR-1484  
 GR-1485  
 GR-2961  
 GR-2962  
 GR-3276  
 GR-3277  
 G-1354  
 13625  
 13631  
 24121

31301  
 13772  
 13774

Application No. S-72039 Permit No. 52060 Certificate No. \_\_\_\_\_

### A & R SPADA FARMS

NOTE: This map is for the purpose of identifying the location of water rights and has no intent to dimension or locate property ownership lines.

SEPTEMBER 14, 1999

SCALE: 1" = 1320'

