


Township 9 S., Range 6 W.

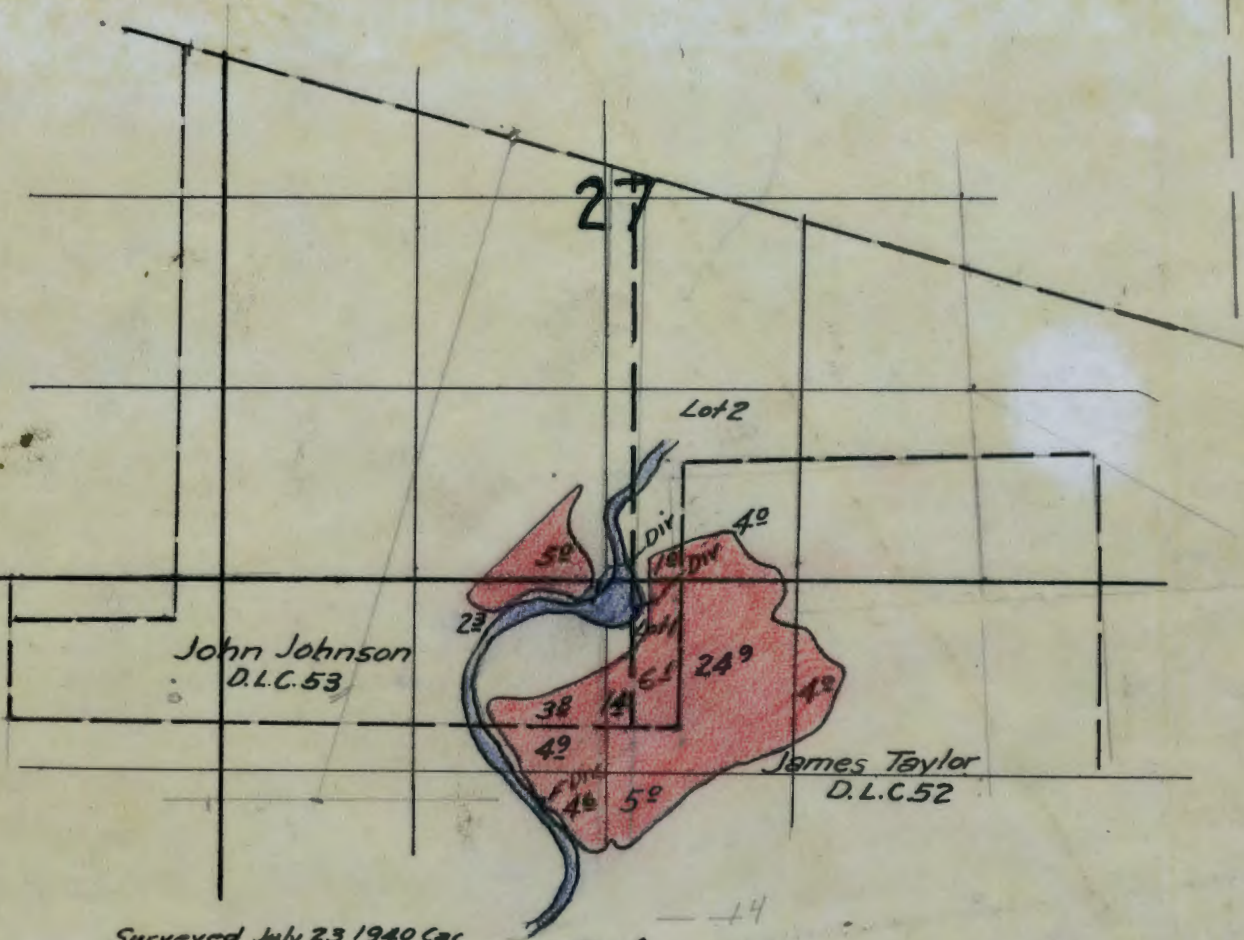

John Johnson
D.L.C. 53

James Taylor
D.L.C. 52

Surveyed July 23 1940 Cal

34

Application 17998
Permit 13671

14
61
249
324

05