


SECTION

11

TOWNSHIP 8 S , RANGE 11 W , W. M.

North

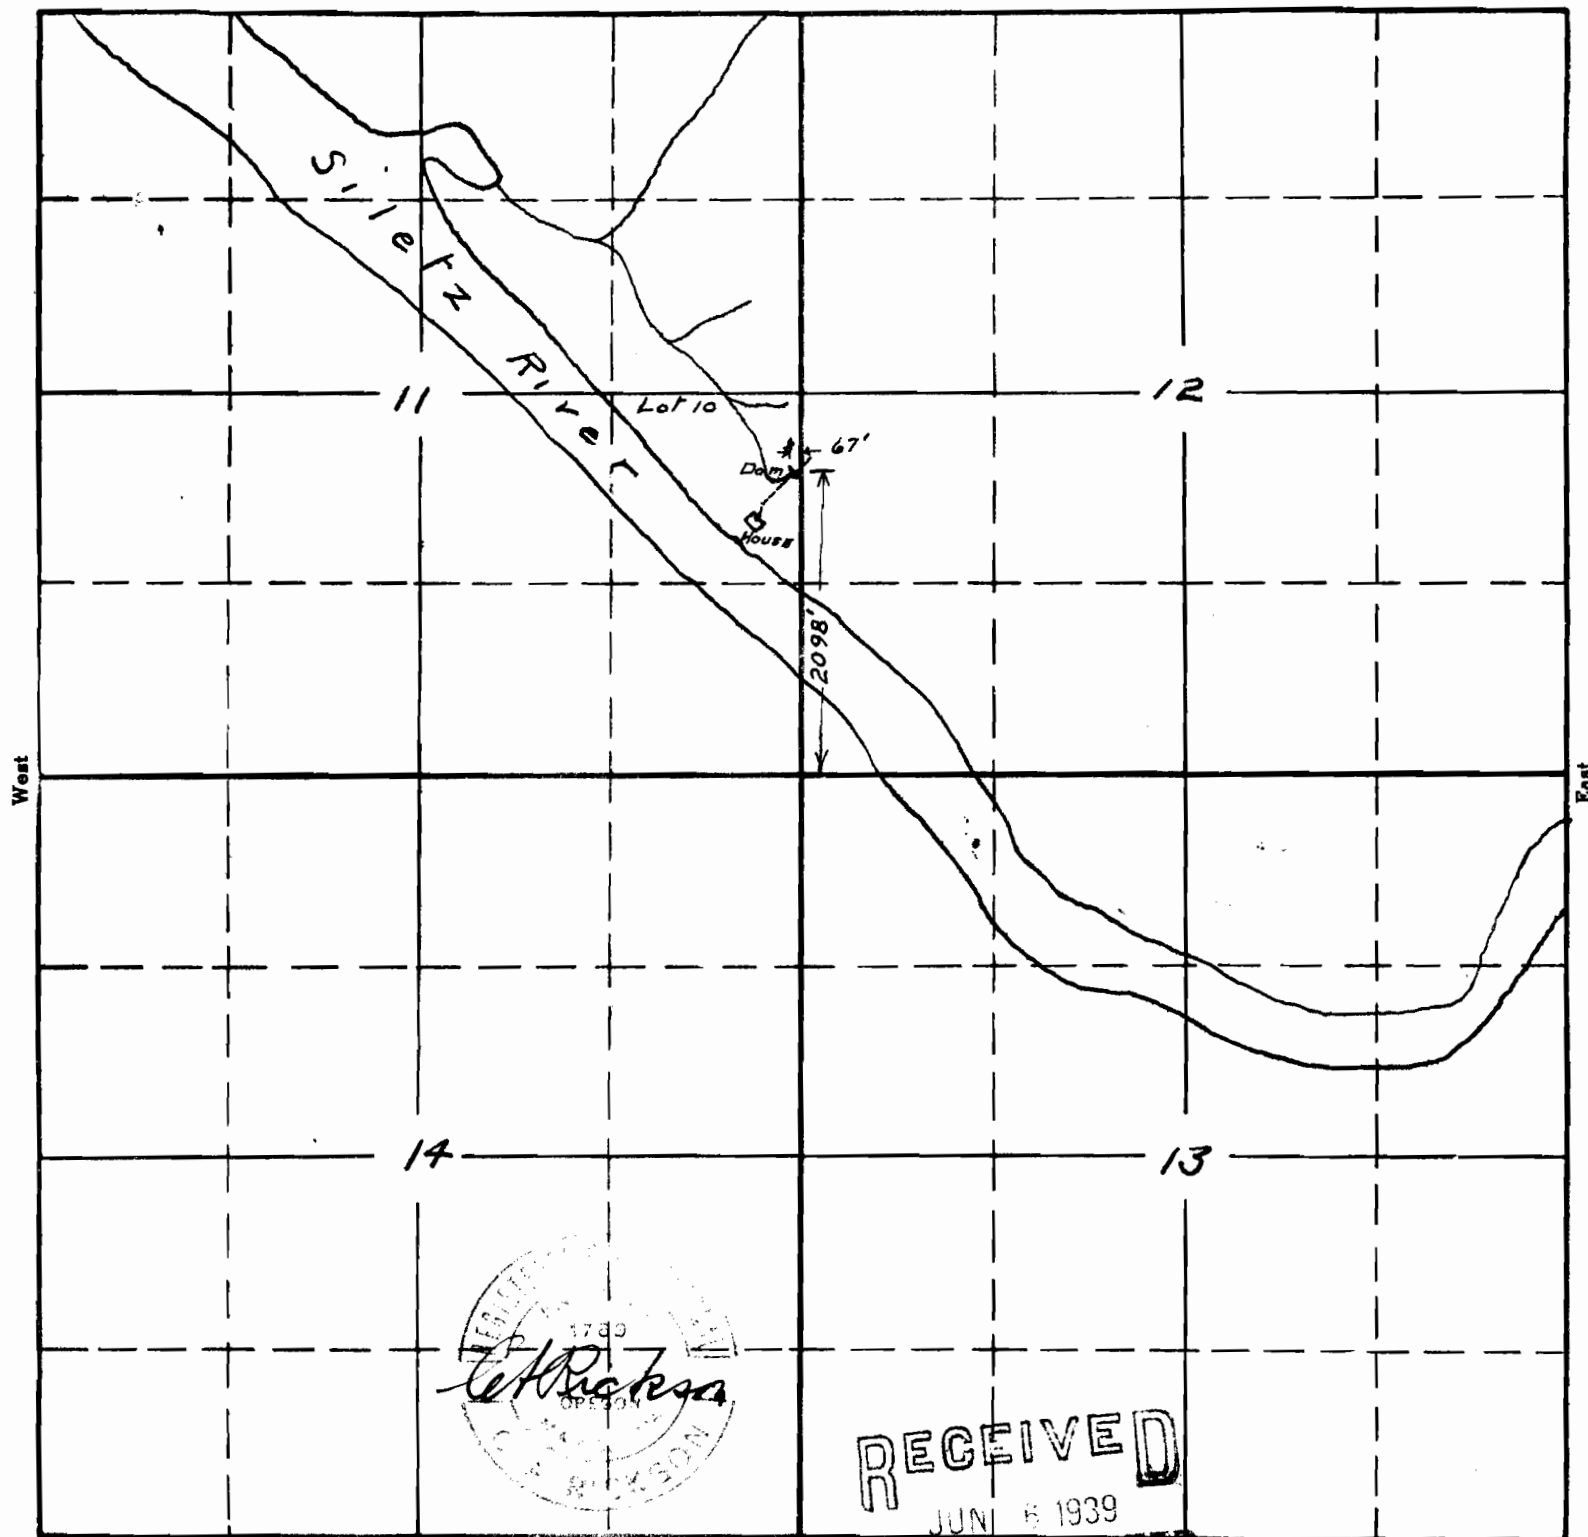

RECEIVED

JUN 6 1939

STATE ENGINEER  
SALEM, OREGON

APPLICATION No. 18162

PERMIT No. 13803